
PART VII

APPENDICES

PART VII – APPENDIX A

Example Tier III Right of Way Plan Set



[PROJECT NAME]
[MONTH, YEAR]
[CITY PROJECT OR FILE NUMBER]
CITY OF BEND, DESCHUTES COUNTY, OREGON

OWNER:
[NAME]
[ADDRESS]
[CITY, STATE & ZIP]
[PHONE NUMBER]

SCHEDULE OF IMPROVEMENTS:

CITY OF BEND:	
# LF FULL STREET IMPROVEMENT	# STORM CATCH BASINS
# LF SIDEWALK	# DRYWELLS
# LF #\" CURB	# LF #\" STORM PIPE
# CURB RAMPS	# LF #\" DI WATER MAIN
# STREET LIGHTS	# LF #\" DI WATER MAIN
# LF #\" PVC-3034 SEWER MAIN	# FIRE HYDRANTS
# MANHOLES	#- #\" WATER SERVICES
#-4\" SEWER SERVICES	

PRIVATE:
LF # DI WATER MAIN
LF # DI WATER MAIN
FIRE HYDRANTS
#- # WATER SERVICES

VICINITY MAP
SCALE:



	BENCHMARK (FOUND)		BANK (BOTTOM)
	BENCHMARK (SET)		BANK (TOP)
	CATCH BASIN		CABLE TV CATV
	CLEANOUT		CANAL
	CONCRETE		CENTERLINE
	CONIFEROUS TREE		DITCH (CENTER)
	CONTROL MON CULVERT		EDGE OF CONCRETE EC
	DECIDUOUS TREE		EDGE OF GRAVEL EG
	DITCH INLET		EDGE OF PAVEMENT EP
	DRYWELL		EASEMENT
	GAS METER		FENCE (OTHER)
	GAS VALVE		FENCE (SILT)
	GRAVEL		FENCE (STEEL)
	GUY WIRE		FENCE (WOOD)
	HANDICAP		FIBER OPTICS FO
	MAILBOX		FORCE MAIN FM
	MONUMENT (FOUND)		GAS
	MONUMENT (SET)		GRADE BREAK GB
	RAILROAD CROSSING ARM		GUARDRAIL GR
	SANITARY MANHOLE		IRRIGATION IRR
	SIGN		JERSEY BARRIER JB
	STORM MANHOLE		PAVEMENT REPAIR
	TELEPHONE RISER		PROPERTY BOUNDARY
	TELEPHONE MANHOLE		PROPERTY SETBACKS
	TRAFFIC SIGNAL CONTROL BOX		POWER
	TRAFFIC SIGNAL W/ MAST ARM		POWER (OVERHEAD) P OH
	UTILITY POLE		RAILROAD
	UTILITY POLE/LIGHT		RIVER
	UTILITY VAULT W/ MANHOLE		SANITARY SEWER SS
	WATER AIR RELEASE VALVE		STORM DRAIN SD
	WATER BELL JOINT		TELEPHONE T
	WATER BLIND FLANGE		
	WATER BLOW OFF VALVE		
	WATER BUTTERFLY VALVE		
	WATER CHECK VALVE		
	WATER COMBINATION AIR RELEASE VALVE		
	WATER DOUBLE DETECTOR CHECK VALVE		
	WATER FIRE DEPT CONNECTION		
	WATER FIRE HYDRANT		
	WATER FLANGED GATE VALVE		
	WATER FLANGED BY MECHANICAL JOINT GATE VALVE		
	WATER GATE VALVE		
	WATER MECHANICAL JOINT		
	WATER METER		
	WATER PRESSURE REDUCING VALVE		
	WATER PRESSURE REGULATOR/SUSTAINING		
	WATER PRESSURE RELIEF VALVE		
	WATER RESTRAINED MECHANICAL JOINT		
	WATER SAMPLE STATION		
	WATER SINGLE DETECTOR CHECK VALVE		
	WATER THRUST BLOCK (STRADDLE)		
	WATER THRUST BLOCK		

FADED BACK FEATURES ARE EXISTING (EXCEPT FOR FOUND MONUMENTS)

APPROVALS:

CITY OF BEND ENGINEER: _____
NOTE: SIGNATURE DOES NOT GRANT APPROVAL TO COMMENCE CONSTRUCTION.

BEND FIRE DEPARTMENT: _____

[REQUIRED UTILITY:_____]

[REQUIRED UTILITY:_____]

[REQUIRED UTILITY:_____]

[REQUIRED UTILITY: _____]

PERMANENT BENCH MARKS USED:

IDENTIFICATION	DESCRIPTION

SHEET INDEX:

SHEET 1	COVER SHEET
SHEET 2	CONSTRUCTION NOTES
SHEET 3	EXISTING CONDITIONS
SHEET 4	EROSION CONTROL
SHEET 5	SITE PLAN & PROFILE
SHEET 6	GRADING PLAN & PROFILE
SHEET 7	DETAILS

SITE PLAN
SCALE:

STAMP]
[ENGINEERS

[PROJECT NAME]
[PROJECT NAME 2ND LINE]



CITY OF BEND

1
REVISIONS:

800

2.

[COMPANY NAME]

[COMPANY ADDRESS]

DRAWN BY:

SCALE: _____

FILE: _____

DATE: _____

VERIFY SCALES
0 1"
BAR EQUALS ONE INCH
IN ORIGINAL DRAWING

SHEET:

17

COB #

	1	2	3	4	5	6	
A	GENERAL NOTES:		STREET NOTES:		GRADING AND ESC NOTES:		A
	<div><div>1. NO CONSTRUCTION SHALL BE STARTED WITHOUT A NOTICE TO PROCEED BY THE CITY ENGINEERING DEPARTMENT. THE CITY ENGINEERING DEPARTMENT AND THE DESIGN ENGINEER SHALL BE NOTIFIED AT LEAST 24 HOURS PRIOR TO THE START OF CONSTRUCTION. ANY CONSTRUCTION WORK DONE PRIOR TO NOTICE TO PROCEED BEING ISSUED OR WITHOUT INSPECTION WILL BE REJECTED.</div><div>2. CONTRACTOR SHALL VERIFY ALL CONDITIONS ON THE JOB SITE INCLUDING BUT NOT LIMITED TO, ALL DIMENSIONS, GRADES, ELEVATIONS, EXTENT AND COMPATIBILITY TO THE EXISTING SITE CONDITIONS, AND WITH THE WORK DESCRIBED ON THE ENGINEER'S DRAWINGS. ANY DISCREPANCIES OR UNEXPECTED CONDITIONS THAT AFFECT OR CHANGE THE WORK DESCRIBED IN THE CONTRACT DOCUMENTS SHALL BE BROUGHT TO THE ENGINEER'S ATTENTION IMMEDIATELY. CONTRACTOR SHALL NOT PROCEED WITH ANY OF THE WORK IN THE AREA OF DISCREPANCIES UNTIL ALL SUCH DISCREPANCIES ARE RESOLVED. IF THE CONTRACTOR CHOOSES TO DO SO, THEN IT IS UNDERSTOOD THAT THE CONTRACTOR IS CHOOSING TO PROCEED AT THE CONTRACTOR'S OWN RISK AND SHALL INCUR ALL COSTS, IF ANY TO RESOLVE THE ISSUES TO THE SATISFACTION OF THE ENGINEER.</div><div>3. A CITY INSPECTOR ACTING ON BEHALF OF THE CITY MAY REQUIRE REVISIONS IN PLANS TO SOLVE UNFORESEEN PROBLEMS THAT MAY ARISE IN THE FIELD.</div><div>4. ALL CONSTRUCTION WORK AND INSTALLATIONS SHALL CONFORM TO THE CITY STANDARDS AND SPECIFICATIONS, AND ALL WORK SHALL BE SUBJECT TO THE APPROVAL OF THE CITY.</div><div>5. IT SHALL BE THE RESPONSIBILITY OF THE CONTRACTOR TO CONTACT "UNDERGROUND LOCATE SERVICE" AT 1-800-332-2344 AT LEAST 48 BUSINESS-DAY HOURS PRIOR TO THE START OF CONSTRUCTION FOR THE LOCATION OF POWER, GAS, CABLE TV AND TELEPHONE UNDERGROUND FACILITIES. THE CONTRACTOR WILL ALSO BE RESPONSIBLE FOR CONTACTING THE APPROPRIATE PUBLIC AGENCY FOR THE LOCATION OF UNDERGROUND FACILITIES.</div><div>6. ALL UTILITIES SHOWN ARE ACCURATE TO THE EXTENT OF AVAILABLE RECORDS AND KNOWLEDGE. NO POTHOLING TO VERIFY LOCATIONS AND ELEVATIONS WAS AUTHORIZED BY THE OWNER. THE CONTRACTOR HAS THE TOTAL RESPONSIBILITY TO VERIFY THE LOCATION OF EXISTING UNDERGROUND UTILITIES AND TO NOTIFY THE UTILITY COMPANIES WHEN WORKING IN THEIR PROXIMITY. CONTRACTOR TO VERIFY LOCATION OF EXISTING UTILITIES PRIOR TO CONSTRUCTION. OREGON LAW REQUIRES YOU TO FOLLOW RULES ADOPTED BY THE OREGON UTILITY NOTIFICATION CENTER. THOSE RULES ARE SET FORTH IN OAR 952-001-0010 THROUGH 952-001-0090. YOU MAY OBTAIN COPIES OF THE RULES BY CALLING THE CENTER. THE TELEPHONE NUMBER FOR THE OREGON UTILITY NOTIFICATION CENTER IS (503)232-2987.</div><div>7. ALL GRADING SHALL BE IN CONFORMANCE WITH THE CURRENT CITY STANDARDS AND SPECIFICATIONS AND CURRENT GRADING ORDINANCE. ALL SUBGRADE MATERIAL SHALL BE CONSIDERED CLASS A AND COMPACTED TO 95% OF OPTIMUM DENSITY. AS SPECIFIED IN THESE PLANS, ALL FILL MATERIAL SHALL BE COMPACTED TO 95% RELATIVE COMPACTION PER THE CITY TESTING REQUIREMENTS.</div><div>8. ALL FINAL CUT AND FILL SLOPES SHALL NOT EXCEED A GRADE OF 2 HORIZONTAL TO 1 VERTICAL UNLESS OTHERWISE APPROVED.</div><div>9. ALL UNSUITABLE SOILS MATERIALS, RUBBISH AND DEBRIS RESULTING FROM GRADING OPERATIONS SHALL BE REMOVED FROM THE JOB SITE AND DISPOSED OF PROPERLY.</div><div>10. THE CONTRACTOR SHALL EMPLOY ALL LABOR, EQUIPMENT, AND METHODS REQUIRED TO PREVENT DUST IN AMOUNTS DAMAGING TO PROPERTY, CULTIVATED VEGETATION AND DOMESTIC ANIMALS OR CAUSING A NUISANCE TO PERSONS OCCUPYING BUILDINGS IN THE VICINITY OF THE JOB SITE. THE CONTRACTOR SHALL BE RESPONSIBLE FOR ANY DAMAGE CAUSED BY DUST RESULTING FROM CONSTRUCTION.</div><div>11. THE CONTRACTOR SHALL FOLLOW ALL APPLICABLE INDUSTRIAL SAFETY REGULATIONS. THE CITY AND DESCHUTES COUNTY AND THEIR OFFICIALS, THE ENGINEER, AND THE OWNER SHALL NOT BE RESPONSIBLE FOR ENFORCING SAFETY REGULATIONS.</div><div>12. MATERIAL QUANTITIES USED, NOTED, OR PROVIDED IN A SEPARATE ITEMIZED QUANTITY TAKE-OFF ARE AN ENGINEER'S OPINION OF PROBABLE MATERIAL REQUIREMENTS, AND IS AN ESTIMATE ONLY. CONTRACTORS HAVE THE SOLE RESPONSIBILITY OF MAKING THEIR OWN QUANTITY TAKE-OFF AND COST ESTIMATE.</div><div>13. ALL WORK IN THE PUBLIC RIGHT OF WAY SHALL BE PERFORMED BY A CITY APPROVED CONTRACTOR (INCLUDING SUBCONTRACTORS).</div><div>14. UTILITIES SHALL HAVE THE RIGHT TO INSTALL, MAINTAIN, AND OPERATE THEIR EQUIPMENT ABOVE AND BELOW GROUND AND ALL OTHER RELATED FACILITIES WITHIN THE PUBLIC UTILITY EASEMENTS (PUE) IDENTIFIED ON THIS PLAT MAP AS MAY BE NECESSARY OR DESIRABLE IN SERVING THE LOTS IDENTIFIED HEREIN, INCLUDING THE RIGHT OF ACCESS TO SUCH FACILITIES AND THE RIGHT TO REQUIRE THE REMOVAL OF ANY OBSTRUCTIONS INCLUDING TREES AND VEGETATION THAT MAY BE PLACED WITH IN THE PUE AT THE LOT OWNERS EXPENSE. AT NO TIME MAY ANY PERMANENT STRUCTURES BE PLACED WITHIN THE PUE OR ANY OTHER OBSTRUCTION WHICH INTERFERES WITH THE USE OF THE PUE WITHOUT PRIOR WRITTEN APPROVAL OF THE UTILITIES AND FACILITIES IN THE PUE.</div><div>15. CITY ENGINEER'S SIGNATURE DOES NOT CONSTITUTE APPROVAL OF FACILITIES PROPOSED ON PRIVATE PROPERTY. SEPARATE PERMITS ISSUED BY THE BUILDING DEPARTMENT ARE REQUIRED AND SHALL BE OBTAINED BY THE DEVELOPER FOR FACILITIES LOCATED OUTSIDE OF THE PUBLIC RIGHT-OF-WAY.</div><div>16. ANY WORK WITHIN EXISTING PUBLIC RIGHT-OF-WAY OR DEDICATED CITY EASEMENTS REQUIRES A SEPARATE RIGHT-OF-WAY EXCAVATION PERMIT OBTAINED FROM THE CITY ENGINEERING DIVISION.</div><div>17. ALL WATER MAIN CONNECTION TO BE DESIGNED AND CONSTRUCTED WITH CROSS CONNECTION PROTECTION.</div><div>18. CONTRACTOR SHALL OBTAIN HYDRANT METER PERMIT FOR USE OF TESTING WATER MAIN. A MINIMUM OF 48 HOURS ADVANCED NOTICE IS REQUIRED TO THE CITY OF BEND UTILITIES DEPARTMENT.</div><div>19. ALL RESTORATION TO BE COMPLETED AS SOON AS POSSIBLE UPON COMPLETION AND APPROVAL FROM THE INSPECTOR FOR ON-SITE WORK AND UNDERGROUND WORK.</div><div>20. ALL RESTORATION SHALL COMPLY WITH CITY OF BEND STANDARDS AND SPECIFICATIONS AND FOLLOW THE BMP PAVING GUIDELINES ESTABLISHED BY STREET DEPARTMENT.</div><div>21. PRIOR TO IMPLEMENTING ANY TRAFFIC CONTROL PLANS, NOTIFICATION AND APPROVAL IS REQUIRED BY THE CITY OF BEND PRIVATE DEVELOPMENT ENGINEERING DEPARTMENT.</div><div>22. THESE PLANS WILL EXPIRE ONE YEAR FROM THE "CITY OF BEND ENGINEER" SIGNATURE DATE ON THE COVER.</div><div>23. PRIVATE INSPECTIONS WILL BE REQUIRED PER PART V OF THE CITY OF BEND STANDARDS AND SPECIFICATIONS UNLESS SPECIFIED OTHERWISE.</div></div> <td colspan="2"><div><div>1. IF ANY WORK (NEW CONSTRUCTION OR RECONSTRUCTION) IMPACTS A CURB WHERE THERE IS A PEDESTRIAN WALKWAY (E.G. A SIDEWALK OR TRAIL/PATH) INTERSECTING A ROADWAY THEN A NEW RAMP OR REPLACEMENT OF AN EXISTING NON-COMPLIANT CURB RAMP MUST BE CONSTRUCTED.</div><div>2. IF ANY NEW WORK INCLUDES RESURFACING THROUGH A STREET LEVEL PEDESTRIAN WALKWAY (E.G. MARKED OR UNMARKED CROSSWALK), EVEN IF THE WORK IS NOT THE FULL WIDTH OF THE ROADWAY, CURB RAMPS MUST BE BUILT OR RECONSTRUCTED ON BOTH ENDS OF THE CROSSWALK.</div><div>3. IF ANY NEW SIDEWALK WORK CONNECTING TO AN EXISTING NON-COMPLIANT RAMP THAT REQUIRES ANY MODIFICATION TO ANY PORTION OF THE RAMP TO MEET CURRENT SIDEWALK DESIGN STANDARDS, THEN THE ENTIRE RAMP SHALL BE RECONSTRUCTED TO CURRENT STANDARDS.</div><div>4. IF ANY UTILITY TRENCH WORK IMPACTS A CURB AT A CROSS WALK, WITH OR WITHOUT A RAMP, THE REPLACEMENT OF AN EXISTING NON-COMPLIANT CURB RAMP MUST BE CONSTRUCTED.</div><div>5. IF UTILITY TRENCH WORK DOES NOT IMPACT A CURB RAMP BUT IS "LIMITED TO A PORTION OF THE PAVEMENT, INCLUDING A PORTION OF THE CROSS WALK" REPLACEMENT OF AN EXISTING NON-COMPLIANT CURB RAMP MAY NOT BE REQUIRED (DEPENDENT ON OVERALL PROJECT SCOPE AND REQUIRED PAVEMENT RESTORATION LIMITS).</div><div>6. ANY WORK WITHIN THE PUBLIC RIGHT-OF-WAY THAT DISTURBS A PEDESTRIAN SIDEWALK OR TRAIL REQUIRES THE REPLACEMENT OF THAT FACILITY TO CURRENT CITY AND PROWAG STANDARDS. THIS INCLUDES BUT IS NOT LIMITED TO ALL ADA RAMPS, CONCRETE SIDEWALKS, ASPHALT TRAILS, DRIVEPADS, CROSSWALKS, AND SIGNAGE.</div><div>7. IF ANY ADA RAMPS ARE IDENTIFIED TO BE CONSTRUCTED, THE CONTRACTOR SHALL CONSTRUCT PERPENDICULAR RAMPS PER CITY STANDARDS. DIAGONAL OR PARALLEL RAMPS SHALL ONLY BE USED IF THERE ARE UNIQUE SITE CONSTRAINTS THAT PROHIBIT CONSTRUCTION OF PERPENDICULAR RAMPS. ALL VARIATIONS FROM PERPENDICULAR RAMPS ARE AT THE DISCRETION OF THE CITY ENGINEER.</div><div>8. THE CITY PREFERS THAT VECTOR EXCAVATION AND ASPHALT CORE SAW BE USED TO POTHOLE UTILITIES. ALTERNATE METHODS MAY BE ALLOWED, BUT REQUIRE APPROVAL AS A CONDITION OF THE PERMIT.</div><div>9. ASPHALT RESTORATION LIMITS WILL BE DETERMINED AFTER PERMIT SCOPE IS COMPLETED.</div></div></td> <td colspan="2"><div><div>1. THE ENGINEER OF RECORD CAN PROVIDE ADDITIONAL BEST MANAGEMENT PRACTICES (BMP) FROM SECTION 9.4.3 IN THE CENTRAL OREGON STORMWATER MANUAL (COSM) THAT APPLY TO THE PROJECT.</div><div>2. HOLD A PRE-CONSTRUCTION MEETING THAT INCLUDES THE CITY OF BEND INSPECTOR, EOR AND CONTRACTOR TO DISCUSS EROSION AND SEDIMENT CONTROL MEASURES AND CONSTRUCTION LIMITS.</div><div>3. THE EROSION AND SEDIMENT CONTROL (ESC) PLAN MUST BE KEPT ONSITE AT ALL TIMES WHEN WORK IS OCCURRING.</div><div>4. THE ESC MEASURES SHOWN ON THIS PLAN ARE MINIMUM REQUIREMENTS FOR ANTICIPATED SITE CONDITIONS. DURING THE CONSTRUCTIONS PERIOD, THE MEASURES MUST BE UPGRADED AS NEEDED TO COMPLY WITH ALL APPLICABLE LOCAL, STATE, AND FEDERAL EROSION AND SEDIMENT CONTROL REGULATIONS.</div><div>5. THE FOLLOWING CONSTRUCTION SEQUENCE SHALL BE FOLLOWED IN ORDER TO BEST MINIMIZE THE POTENTIAL FOR EROSION AND SEDIMENTATION CONTROL PROBLEMS:<div><div>a. FENCE OR FLAG AREAS TO BE PROTECTED OR LEFT UNDISTURBED DURING CONSTRUCTION</div><div>b. INSTALL GRAVELED OR PAVED CONSTRUCTION ENTRANCES, EXITS, AND PARKING AREAS TO REDUCE THE TRACKING OF SEDIMENT ONTO PUBLIC AND PRIVATE ROADS</div><div>c. CLEAR AND GRUB SUFFICIENTLY FOR INSTALLATION OF TEMPORARY ESC BMPS</div><div>d. INSTALL TEMPORARY ESC BMPS, CONSTRUCTING SEDIMENT TRAPPING BMPS AS ONE OF THE FIRST STEPS PRIOR TO GRADING</div><div>e. CLEAR, GRUB AND GRADE INDIVIDUAL AND ROUGH GRADE FOR ROADS AND UTILITY LOCATIONS</div><div>f. CLEAR, GRUB AND GRADE INDIVIDUAL LOTS OR GROUPS OF LOTS</div><div>g. TEMPORARILY STABILIZE A LOT OR GROUPS OF LOTS, THROUGH RE-VEGETATION OR OTHER APPROPRIATE BMPS, WHERE SUBSTANTIAL CUT OR FILL SLOPES ARE RESULT OF SITE GRADING</div><div>h. CONSTRUCT ROADS, BUILDINGS, PERMANENT STORMWATER FACILITIES (I.E. INLETS, PONDS, UIC FACILITIES, ETC.)</div><div>i. PROTECT ALL PERMANENT STORMWATER FACILITIES UTILIZING THE APPROPRIATE BMPS</div><div>j. REMOVE TEMPORARY ESC CONTROLS WHEN PERMANENT STORMWATER FACILITIES HAVE BEEN INSTALLED, ALL LAND-DISTURBING ACTIVITIES HAVE CEASED, AND VEGETATION HAS BEEN ESTABLISHED IN THE AREAS NOTED ON THE ACCEPTED ESC PLAN(S)</div></div></div><div>6. RETAIN THE DUFF LAYER, NATIVE TOPSOIL, AND NATURAL VEGETATION IN AN UNDISTURBED STATE TO THE MAXIMUM EXTENT AND DURATION PRACTICAL.</div><div>7. INSPECT ALL ROADWAYS ADJACENT TO THE CONSTRUCTION ACCESS ROUTE AT THE END OF EACH DAY. SIGNIFICANT AMOUNTS OF SEDIMENT THAT LEAVES THE CONSTRUCTION SITE MUST BE CLEANED UP WITHIN 24 HOURS. VACUUMING OR DRY SWEEPING MUST BE USED TO CLEAN UP RELEASED SEDIMENT AND SEDIMENT MUST NOT BE INTENTIONALLY WASHED INTO STORM SEWERS, DRAINAGE WAYS, OR WATER BODIES.</div><div>8. COVER AND SECURE ALL DUMP TRUCK LOADS LEAVING THE CONSTRUCTION SITE TO MINIMIZE SPILLAGE ON ROADS.</div><div>9. RESTORE CONSTRUCTION ACCESS ROUTE EQUAL TO OR BETTER THAN THE PRE-CONSTRUCTION CONDITION. CONTROL FUGITIVE DUST FROM CONSTRUCTION ACTIVITY.</div><div>10. STABILIZE EXPOSED UNWORKED SOILS (INCLUDING STOCKPILES), WHETHER AT FINAL GRADE OR NOT, WITHIN 10 CALENDAR DAYS DURING THE REGIONAL DRY SEASON (JULY 1 THROUGH SEPTEMBER 30) AND WITHIN 5 CALENDAR DAYS DURING THE REGIONAL WET SEASON (OCTOBER 1 THROUGH JUNE 30).</div><div>11. PROTECT INLETS, DRYWELLS, CATCH BASINS AND OTHER STORMWATER MANAGEMENT FACILITIES FROM SEDIMENT, WHETHER OR NOT FACILITIES ARE OPERABLE.</div><div>12. KEEP ROADS ADJACENT TO INLETS CLEAN.</div><div>13. INSPECT INLETS WEEKLY AT A MINIMUM AND DAILY DURING STORM EVENTS. CLEAN OR REMOVE AND REPLACE INLET PROTECTION DEVICES BEFORE SIX INCHES OF SEDIMENT CAN ACCUMULATE.</div><div>14. INSTALL SEDIMENT CONTROLS ALONG THE SITE PERIMETER ON ALL DOWN GRADIENT SIDES OF THE CONSTRUCTION SITE BEFORE COMMENCING EARTH DISTURBING ACTIVITIES.</div><div>15. WHENEVER POSSIBLE, CONSTRUCT STORMWATER CONTROL FACILITIES (DETENTION/RETENTION STORAGE POND OR SWALES) BEFORE GRADING BEGINS. THESE FACILITIES SHOULD BE OPERATIONAL BEFORE THE CONSTRUCTION OR IMPERVIOUS SITE IMPROVEMENTS.</div><div>16. STOCKPILE MATERIALS (SUCH AS TOPSOIL) ONSITE MUST BE KEPT OFF OF ROADWAY AND SIDEWALKS.</div><div>17. COVER, CONTAIN AND PROTECT ALL CHEMICALS, LIQUID PRODUCTS, PETROLEUM PRODUCT, AND NON-INERT WASTES PRESENT ONSITE FROM VANDALISM. MAINTAIN A SUPPLY OF MATERIALS ON HAND TO ADDRESS AND CONTAIN SPILLS.</div><div>18. LOCATE DESIGNATED VEHICLE AND EQUIPMENT SERVICE AREAS, FUEL, AND MATERIALS AWAY FROM DRAINAGE INLETS, WATER COURSES, AND CANALS. PROPERLY CONTAIN AREAS USING BERMS, SAND BAGS, OR OTHER BARRIERS.</div><div>19. REGULARLY INSPECT AND MAINTAIN EQUIPMENT, ESPECIALLY FOR DAMAGED HOSES AND LEAKY GASKETS. CONDUCT MAINTENANCE AND REPAIR OF HEAVY EQUIPMENT AND VEHICLES (I.E. OIL CHANGES, FUEL TANK DRAIN DOWN, ETC) THAT MAY RESULT IN DISCHARGE OR SPILLAGE OF POLLUTANTS USING SPILL PREVENTION MEASURES, SUCH AS DRIP PANS. CLEAN ALL CONTAMINATED SURFACES IMMEDIATELY FOLLOWING ANY DISCHARGE OR SPILL INCIDENT. PERFORM REPAIRS ONSITE USING TEMPORARY PLASTIC OR OIL ABSORBING BLANKETS BENEATH THE VEHICLE.</div><div>20. DESIGNATE AN AREA FOR CLEANING PAINTING EQUIPMENT AND TOOLS. NEVER CLEAN BRUSHES OR RINSE CONTAINERS INTO THE STREET, GUTTER, DRAINAGE INLET, OR WATERWAY.</div><div>21. APPLY LANDSCAPING OR AGRICULTURAL CHEMICALS, INCLUDING FERTILIZERS AND PESTICIDES, IN SUCH A MANNER, AND AT APPLICATIONS RATES, THAT INHIBITS THE LOSS OF CHEMICALS INTO STORMWATER RUNOFF FACILITIES.</div><div>22. INSPECT ON A REGULAR BASIS (AT A MINIMUM WEEKLY, AND DAILY DURING/AFTER A RUNOFF PRODUCING STORM EVENT) AND MAINTAIN ALL EROSION AND SEDIMENT CONTROL BMPS TO ENSURE SUCCESSFUL PERFORMANCE OF THE BMPS.</div><div>23. REMOVE TEMPORARY ESC BMPS WITHIN 30 DAYS AFTER THE TEMPORARY BMPS ARE NO LONGER NEEDED. PERMANENTLY STABILIZE AREAS THAT ARE DISTURBED DURING THE REMOVAL PROCESS.</div><div>24. KEEP SEDIMENT ON THE PROJECT SITE, TO THE MAXIMUM EXTENT PRACTICAL.</div><div>25. CONTROL FUGITIVE DUST FROM CONSTRUCTION ACTIVITY. DUST CONTROL MUST BE CONTINUOUS, PARTICULARLY DURING THE DRY SEASON.</div><div>26. DESIGNATE THE LOCATION OF A SLURRY PIT WHERE CONCRETE TRUCKS AND EQUIPMENT CAN BE WASHED OUT. SLURRY PITS ARE NOT TO BE LOCATED IN, OR UPSTREAM OF, A SWALE, DRAINAGE AREA, STORMWATER FACILITY, WATER BODY, OR IN AN AREA WHERE A STORMWATER FACILITY EXISTS OR IS PROPOSED.</div></div></td>		<div><div>1. IF ANY WORK (NEW CONSTRUCTION OR RECONSTRUCTION) IMPACTS A CURB WHERE THERE IS A PEDESTRIAN WALKWAY (E.G. A SIDEWALK OR TRAIL/PATH) INTERSECTING A ROADWAY THEN A NEW RAMP OR REPLACEMENT OF AN EXISTING NON-COMPLIANT CURB RAMP MUST BE CONSTRUCTED.</div><div>2. IF ANY NEW WORK INCLUDES RESURFACING THROUGH A STREET LEVEL PEDESTRIAN WALKWAY (E.G. MARKED OR UNMARKED CROSSWALK), EVEN IF THE WORK IS NOT THE FULL WIDTH OF THE ROADWAY, CURB RAMPS MUST BE BUILT OR RECONSTRUCTED ON BOTH ENDS OF THE CROSSWALK.</div><div>3. IF ANY NEW SIDEWALK WORK CONNECTING TO AN EXISTING NON-COMPLIANT RAMP THAT REQUIRES ANY MODIFICATION TO ANY PORTION OF THE RAMP TO MEET CURRENT SIDEWALK DESIGN STANDARDS, THEN THE ENTIRE RAMP SHALL BE RECONSTRUCTED TO CURRENT STANDARDS.</div><div>4. IF ANY UTILITY TRENCH WORK IMPACTS A CURB AT A CROSS WALK, WITH OR WITHOUT A RAMP, THE REPLACEMENT OF AN EXISTING NON-COMPLIANT CURB RAMP MUST BE CONSTRUCTED.</div><div>5. IF UTILITY TRENCH WORK DOES NOT IMPACT A CURB RAMP BUT IS "LIMITED TO A PORTION OF THE PAVEMENT, INCLUDING A PORTION OF THE CROSS WALK" REPLACEMENT OF AN EXISTING NON-COMPLIANT CURB RAMP MAY NOT BE REQUIRED (DEPENDENT ON OVERALL PROJECT SCOPE AND REQUIRED PAVEMENT RESTORATION LIMITS).</div><div>6. ANY WORK WITHIN THE PUBLIC RIGHT-OF-WAY THAT DISTURBS A PEDESTRIAN SIDEWALK OR TRAIL REQUIRES THE REPLACEMENT OF THAT FACILITY TO CURRENT CITY AND PROWAG STANDARDS. THIS INCLUDES BUT IS NOT LIMITED TO ALL ADA RAMPS, CONCRETE SIDEWALKS, ASPHALT TRAILS, DRIVEPADS, CROSSWALKS, AND SIGNAGE.</div><div>7. IF ANY ADA RAMPS ARE IDENTIFIED TO BE CONSTRUCTED, THE CONTRACTOR SHALL CONSTRUCT PERPENDICULAR RAMPS PER CITY STANDARDS. DIAGONAL OR PARALLEL RAMPS SHALL ONLY BE USED IF THERE ARE UNIQUE SITE CONSTRAINTS THAT PROHIBIT CONSTRUCTION OF PERPENDICULAR RAMPS. ALL VARIATIONS FROM PERPENDICULAR RAMPS ARE AT THE DISCRETION OF THE CITY ENGINEER.</div><div>8. THE CITY PREFERS THAT VECTOR EXCAVATION AND ASPHALT CORE SAW BE USED TO POTHOLE UTILITIES. ALTERNATE METHODS MAY BE ALLOWED, BUT REQUIRE APPROVAL AS A CONDITION OF THE PERMIT.</div><div>9. ASPHALT RESTORATION LIMITS WILL BE DETERMINED AFTER PERMIT SCOPE IS COMPLETED.</div></div>		<div><div>1. THE ENGINEER OF RECORD CAN PROVIDE ADDITIONAL BEST MANAGEMENT PRACTICES (BMP) FROM SECTION 9.4.3 IN THE CENTRAL OREGON STORMWATER MANUAL (COSM) THAT APPLY TO THE PROJECT.</div><div>2. HOLD A PRE-CONSTRUCTION MEETING THAT INCLUDES THE CITY OF BEND INSPECTOR, EOR AND CONTRACTOR TO DISCUSS EROSION AND SEDIMENT CONTROL MEASURES AND CONSTRUCTION LIMITS.</div><div>3. THE EROSION AND SEDIMENT CONTROL (ESC) PLAN MUST BE KEPT ONSITE AT ALL TIMES WHEN WORK IS OCCURRING.</div><div>4. THE ESC MEASURES SHOWN ON THIS PLAN ARE MINIMUM REQUIREMENTS FOR ANTICIPATED SITE CONDITIONS. DURING THE CONSTRUCTIONS PERIOD, THE MEASURES MUST BE UPGRADED AS NEEDED TO COMPLY WITH ALL APPLICABLE LOCAL, STATE, AND FEDERAL EROSION AND SEDIMENT CONTROL REGULATIONS.</div><div>5. THE FOLLOWING CONSTRUCTION SEQUENCE SHALL BE FOLLOWED IN ORDER TO BEST MINIMIZE THE POTENTIAL FOR EROSION AND SEDIMENTATION CONTROL PROBLEMS:<div><div>a. FENCE OR FLAG AREAS TO BE PROTECTED OR LEFT UNDISTURBED DURING CONSTRUCTION</div><div>b. INSTALL GRAVELED OR PAVED CONSTRUCTION ENTRANCES, EXITS, AND PARKING AREAS TO REDUCE THE TRACKING OF SEDIMENT ONTO PUBLIC AND PRIVATE ROADS</div><div>c. CLEAR AND GRUB SUFFICIENTLY FOR INSTALLATION OF TEMPORARY ESC BMPS</div><div>d. INSTALL TEMPORARY ESC BMPS, CONSTRUCTING SEDIMENT TRAPPING BMPS AS ONE OF THE FIRST STEPS PRIOR TO GRADING</div><div>e. CLEAR, GRUB AND GRADE INDIVIDUAL AND ROUGH GRADE FOR ROADS AND UTILITY LOCATIONS</div><div>f. CLEAR, GRUB AND GRADE INDIVIDUAL LOTS OR GROUPS OF LOTS</div><div>g. TEMPORARILY STABILIZE A LOT OR GROUPS OF LOTS, THROUGH RE-VEGETATION OR OTHER APPROPRIATE BMPS, WHERE SUBSTANTIAL CUT OR FILL SLOPES ARE RESULT OF SITE GRADING</div><div>h. CONSTRUCT ROADS, BUILDINGS, PERMANENT STORMWATER FACILITIES (I.E. INLETS, PONDS, UIC FACILITIES, ETC.)</div><div>i. PROTECT ALL PERMANENT STORMWATER FACILITIES UTILIZING THE APPROPRIATE BMPS</div><div>j. REMOVE TEMPORARY ESC CONTROLS WHEN PERMANENT STORMWATER FACILITIES HAVE BEEN INSTALLED, ALL LAND-DISTURBING ACTIVITIES HAVE CEASED, AND VEGETATION HAS BEEN ESTABLISHED IN THE AREAS NOTED ON THE ACCEPTED ESC PLAN(S)</div></div></div><div>6. RETAIN THE DUFF LAYER, NATIVE TOPSOIL, AND NATURAL VEGETATION IN AN UNDISTURBED STATE TO THE MAXIMUM EXTENT AND DURATION PRACTICAL.</div><div>7. INSPECT ALL ROADWAYS ADJACENT TO THE CONSTRUCTION ACCESS ROUTE AT THE END OF EACH DAY. SIGNIFICANT AMOUNTS OF SEDIMENT THAT LEAVES THE CONSTRUCTION SITE MUST BE CLEANED UP WITHIN 24 HOURS. VACUUMING OR DRY SWEEPING MUST BE USED TO CLEAN UP RELEASED SEDIMENT AND SEDIMENT MUST NOT BE INTENTIONALLY WASHED INTO STORM SEWERS, DRAINAGE WAYS, OR WATER BODIES.</div><div>8. COVER AND SECURE ALL DUMP TRUCK LOADS LEAVING THE CONSTRUCTION SITE TO MINIMIZE SPILLAGE ON ROADS.</div><div>9. RESTORE CONSTRUCTION ACCESS ROUTE EQUAL TO OR BETTER THAN THE PRE-CONSTRUCTION CONDITION. CONTROL FUGITIVE DUST FROM CONSTRUCTION ACTIVITY.</div><div>10. STABILIZE EXPOSED UNWORKED SOILS (INCLUDING STOCKPILES), WHETHER AT FINAL GRADE OR NOT, WITHIN 10 CALENDAR DAYS DURING THE REGIONAL DRY SEASON (JULY 1 THROUGH SEPTEMBER 30) AND WITHIN 5 CALENDAR DAYS DURING THE REGIONAL WET SEASON (OCTOBER 1 THROUGH JUNE 30).</div><div>11. PROTECT INLETS, DRYWELLS, CATCH BASINS AND OTHER STORMWATER MANAGEMENT FACILITIES FROM SEDIMENT, WHETHER OR NOT FACILITIES ARE OPERABLE.</div><div>12. KEEP ROADS ADJACENT TO INLETS CLEAN.</div><div>13. INSPECT INLETS WEEKLY AT A MINIMUM AND DAILY DURING STORM EVENTS. CLEAN OR REMOVE AND REPLACE INLET PROTECTION DEVICES BEFORE SIX INCHES OF SEDIMENT CAN ACCUMULATE.</div><div>14. INSTALL SEDIMENT CONTROLS ALONG THE SITE PERIMETER ON ALL DOWN GRADIENT SIDES OF THE CONSTRUCTION SITE BEFORE COMMENCING EARTH DISTURBING ACTIVITIES.</div><div>15. WHENEVER POSSIBLE, CONSTRUCT STORMWATER CONTROL FACILITIES (DETENTION/RETENTION STORAGE POND OR SWALES) BEFORE GRADING BEGINS. THESE FACILITIES SHOULD BE OPERATIONAL BEFORE THE CONSTRUCTION OR IMPERVIOUS SITE IMPROVEMENTS.</div><div>16. STOCKPILE MATERIALS (SUCH AS TOPSOIL) ONSITE MUST BE KEPT OFF OF ROADWAY AND SIDEWALKS.</div><div>17. COVER, CONTAIN AND PROTECT ALL CHEMICALS, LIQUID PRODUCTS, PETROLEUM PRODUCT, AND NON-INERT WASTES PRESENT ONSITE FROM VANDALISM. MAINTAIN A SUPPLY OF MATERIALS ON HAND TO ADDRESS AND CONTAIN SPILLS.</div><div>18. LOCATE DESIGNATED VEHICLE AND EQUIPMENT SERVICE AREAS, FUEL, AND MATERIALS AWAY FROM DRAINAGE INLETS, WATER COURSES, AND CANALS. PROPERLY CONTAIN AREAS USING BERMS, SAND BAGS, OR OTHER BARRIERS.</div><div>19. REGULARLY INSPECT AND MAINTAIN EQUIPMENT, ESPECIALLY FOR DAMAGED HOSES AND LEAKY GASKETS. CONDUCT MAINTENANCE AND REPAIR OF HEAVY EQUIPMENT AND VEHICLES (I.E. OIL CHANGES, FUEL TANK DRAIN DOWN, ETC) THAT MAY RESULT IN DISCHARGE OR SPILLAGE OF POLLUTANTS USING SPILL PREVENTION MEASURES, SUCH AS DRIP PANS. CLEAN ALL CONTAMINATED SURFACES IMMEDIATELY FOLLOWING ANY DISCHARGE OR SPILL INCIDENT. PERFORM REPAIRS ONSITE USING TEMPORARY PLASTIC OR OIL ABSORBING BLANKETS BENEATH THE VEHICLE.</div><div>20. DESIGNATE AN AREA FOR CLEANING PAINTING EQUIPMENT AND TOOLS. NEVER CLEAN BRUSHES OR RINSE CONTAINERS INTO THE STREET, GUTTER, DRAINAGE INLET, OR WATERWAY.</div><div>21. APPLY LANDSCAPING OR AGRICULTURAL CHEMICALS, INCLUDING FERTILIZERS AND PESTICIDES, IN SUCH A MANNER, AND AT APPLICATIONS RATES, THAT INHIBITS THE LOSS OF CHEMICALS INTO STORMWATER RUNOFF FACILITIES.</div><div>22. INSPECT ON A REGULAR BASIS (AT A MINIMUM WEEKLY, AND DAILY DURING/AFTER A RUNOFF PRODUCING STORM EVENT) AND MAINTAIN ALL EROSION AND SEDIMENT CONTROL BMPS TO ENSURE SUCCESSFUL PERFORMANCE OF THE BMPS.</div><div>23. REMOVE TEMPORARY ESC BMPS WITHIN 30 DAYS AFTER THE TEMPORARY BMPS ARE NO LONGER NEEDED. PERMANENTLY STABILIZE AREAS THAT ARE DISTURBED DURING THE REMOVAL PROCESS.</div><div>24. KEEP SEDIMENT ON THE PROJECT SITE, TO THE MAXIMUM EXTENT PRACTICAL.</div><div>25. CONTROL FUGITIVE DUST FROM CONSTRUCTION ACTIVITY. DUST CONTROL MUST BE CONTINUOUS, PARTICULARLY DURING THE DRY SEASON.</div><div>26. DESIGNATE THE LOCATION OF A SLURRY PIT WHERE CONCRETE TRUCKS AND EQUIPMENT CAN BE WASHED OUT. SLURRY PITS ARE NOT TO BE LOCATED IN, OR UPSTREAM OF, A SWALE, DRAINAGE AREA, STORMWATER FACILITY, WATER BODY, OR IN AN AREA WHERE A STORMWATER FACILITY EXISTS OR IS PROPOSED.</div></div>		
	B						
C	TRAFFIC CONTROL NOTES:						C
	<div><div>1. THE CONTRACTOR IS RESPONSIBLE FOR IMPLEMENTING THE APPROVED TRAFFIC CONTROL PLAN (TCP) TO PROVIDE SAFE AND EFFICIENT VEHICULAR, BICYCLE AND PEDESTRIAN MOVEMENT IN AND AROUND THE WORK ZONES. CERTIFIED TRAFFIC CONTROL FLAGGERS AND PROFESSIONALS MAY BE REQUIRED PER THE CONDITIONS OF THE PERMIT. THE CITY OF BEND RESERVES THE RIGHT TO MODIFY THE TCP AT ANY TIME BASED ON FIELD CONDITIONS.</div><div>2. THE CONTRACTOR SHALL COMPLY WITH ALL PERMIT REQUIREMENTS INCLUDING THE MANUAL OF UNIFORM TRAFFIC CONTROL DEVICES (MUTCD) AND THE OREGON TEMPORARY TRAFFIC CONTROL HANDBOOK FOR OPERATIONS OF THREE DAYS OR LESS, DATED DECEMBER 2011 AND PREPARED BY ODOT (ORANGE BOOK).</div><div>3. UNLESS APPROVED BY THE CITY ENGINEER, ARTERIAL ROADS SHALL HAVE NO LANE RESTRICTIONS FROM 6:30 TO 9:00 AM AND FROM 3:30 TO 6:30 PM. COLLECTORS AND LOCAL NEIGHBORHOOD MAIN ROUTES SHALL HAVE NO LANE RESTRICTIONS FROM 7:00 AM TO 8:30 AM AND FROM 4:00 PM TO 6:00 PM.</div><div>4. TCP SHALL BE SUBMITTED TO THE CITY OF BEND A MINIMUM OF 14 DAYS PRIOR TO IMPLEMENTATION FOR REVIEW, 48 HOURS PRIOR TO IMPLANTATION THE CITY OF BEND SHALL BE NOTIFIED IN ORDER TO PROVIDE ADEQUATE PUBLIC NOTIFICATION.</div></div>						
D	UTILITIES NOTES:						D
	<div><div>1. UTILITIES CROSSING SHALL BE PERPENDICULAR (90 DEGREES) TO THE CITY WATER, STORM, AND SEWER LINES.</div><div>2. UTILITY CROSSINGS SHALL MAINTAIN A MINIMUM VERTICAL SEPARATION OF 12 INCHES FROM ALL WATER AND SEWER MAIN LINES.</div><div>3. ANY UTILITY THAT IS LOCATED PARALLEL TO A CITY WATER OR SEWER MAIN LINE SHALL MAINTAIN A MINIMUM OF 10-FT OF HORIZONTAL SEPARATION.</div><div>4. THE CITY REQUIRES VISUAL INSPECTION (POT HOLING) OF ALL UTILITY CROSSINGS OF CITY WATER, STORM, AND SEWER LINES. SEWER LINES MAY BE INSPECTED BY CLOSED CIRCUIT CAMERA AT THE APPROVAL OF THE CITY ENGINEER.</div><div>5. EXCAVATION AND DIRECTIONAL DRILLING REQUIRES POT HOLING PRIOR TO ANY WORK BEING CONDUCTED AND DURING DRILLING</div><div>6. DIRECTIONAL DRILLING REQUIRES ADVANCED PROFILING OF THE CROSSING BEFORE WORK CAN BE PERMITTED.</div><div>7. NO EXCAVATION IS PERMITTED WITHIN 10 FT BEHIND A FORCE MAINS, PRESSURE MAINS, FIRE HYDRANT OR WATER MAINS THRUST BLOCK.</div><div>8. UTILITY CROSSINGS SHALL MAINTAIN 2 FT CLEARANCE HORIZONTALLY FROM CITY UTILITIES SUCH AS MANHOLES, VALVE CANS, INLETS, CATCH BASINS, ETC.</div><div>9. UTILITY LINES SHALL NOT BE PLACED IN THE ROOT AREAS OF TREES AND SHALL MAINTAIN 5 FT CLEARANCE FROM THE DRIPLINE OF TREES OR AS DIRECTED BY THE CITY ENGINEER. ANY TREES DAMAGED ARE TO BE REPLACED</div><div>10. COMPACTION IS REQUIRED AND TESTING PER SECTION 09405.46 (C) OR AT THE DISCRETION OF THE CITY ENGINEER. ALL LIFTS MUST BE MECHANICALLY COMPACTED WITH ADEQUATE COMPACTION EQUIPMENT, WITH A MINIMUM OF 5 PASSES FOR EACH LIFT OR AS DIRECTED BY THE CITY.</div></div>						
	1	2	3	4	5	6	

STAMP
[ENGINEERS]

[PROJECT NAME]

[PROJECT NAME 2ND LINE]

CONSTRUCTION NOTES

DESCHUTES COUNTY, OREGON

CITY OF BEND

REVISIONS:

1.

2.

3.

[COMPANY NAME]

[COMPANY ADDRESS]

DESIGNED BY:

DRAWN BY:

SCALE:

FILE

DATE: / /

VERIFY SCALES

01"BAR EQUALS ONE INCH ON ORIGINAL DRAWING

SHEET:

2/7

COB #

	1	2	3	4	5	6	
A	<div>[NORTH ARROW]</div>						
B							
C							
D							
	1	2	3	4	5	6	

EXISTING SITE CONDITIONS PLAN

SCALE:

STAMP


[ENGINEERS]

[PROJECT NAME]

[PROJECT NAME 2ND LINE]

EXISTING CONDITIONS

DESCHUTES COUNTY, OREGON



CITY OF BEND

DESIGNED BY:

DRAWN BY:

SCALE:

FILE:

DATE: / /

VERIFY SCALES

0 1"

BAR EQUALS ONE INCH ON ORIGINAL DRAWING

SHEET:

3/7

COB #

REVISIONS:
1.
2.
3.

[COMPANY NAME]	[COMPANY ADDRESS]
----------------	-------------------

	1	2	3	4	5	6	
A	<div>[NORTH ARROW]</div>						
B							
C							
D							
	1	2	3	4	5	6	

STAMP
[ENGINEERS]

[PROJECT NAME]

[PROJECT NAME 2ND LINE]

EROSION CONTROL

DESCHUTES COUNTY, OREGON



REVISIONS:							
1.							
2.							
3.							

[COMPANY NAME]

[COMPANY ADDRESS]

DESIGNED BY: _____

DRAWN BY: _____

SCALE: _____

FILE: _____

DATE: ____/____/____

VERIFY SCALES

0 1"

BAR EQUALS ONE INCH ON ORIGINAL DRAWING

SHEET:

4/7

COB #

	1	2	3	4	5	6	
A	<div>[NORTH ARROW]</div>						
B							
C	<div>SITE PLAN</div> <div>SCALE:</div>						
D							
	1	2	3	4	5	6	

STAMP


[ENGINEERS]

[PROJECT NAME]

[PROJECT NAME 2ND LINE]

SITE PLAN & PROFILE

DESCHUTES COUNTY, OREGON



CITY OF BEND

REVISIONS:

1.

2.

3.

[COMPANY NAME]

[COMPANY ADDRESS]

DESIGNED BY:

DRAWN BY:

SCALE:


FILE:

DATE:

/

/

VERIFY SCALES

01" 


BAR EQUALS ONE INCH ON ORIGINAL DRAWING

SHEET:

5/7

COB #

	1	2	3	4	5	6	
A							[NORTH ARROW]
B							
C							
D							
DRAINAGE PLAN SCALE:							
	1	2	3	4	5	6	

STAMP [ENGINEERS]	[PROJECT NAME] [PROJECT NAME 2ND LINE] GRADING PLAN & PROFILE DESCHUTES COUNTY, OREGON	 CITY OF BEND	REVISIONS: 1. 2. 3.	[COMPANY NAME] [COMPANY ADDRESS]	DESIGNED BY: DRAWN BY: SCALE: FILE: DATE: / /	VERIFY SCALES 0 1" BAR EQUALS ONE INCH ON ORIGINAL DRAWING	SHEET: 6/7	COB #
----------------------	---	---	------------------------------	-------------------------------------	---	---	-------------------	-------

	1	2	3	4	5	6		
A						SPECIAL DETAIL		A
B						DETAIL TITLE NOT TO SCALE ① 5		B
						SPECIAL DETAIL		
C						SPECIAL DETAIL		C
						DETAIL TITLE NOT TO SCALE ② 5		
D						SPECIAL DETAIL		D
						DETAIL TITLE NOT TO SCALE ③ 5		
	1	2	3	4	5	6		

DRAWN

REV

DATE

APPR

WAT/SEW/STORM

CITY OF BEND

STANDARDS AND SPECIFICATIONS

710 NW WALL ST., BEND, OREGON 97701

SCALE NTS

DATE 6/5/2009

APPR

DRW NO

DETAIL TITLE

DESIGNED BY:

DRAWN BY:

SCALE:

FILE:

DATE: / /

VERIFY SCALES

0 1"

BAR EQUALS ONE INCH ON ORIGINAL DRAWING

SHEET:

7/7

COB #

REVISIONS:

1

2

3

[PROJECT NAME]

[PROJECT NAME 2ND LINE]

DETAILS

DESCHUTES COUNTY, OREGON


STAMP

[ENGINEERS]

CITY OF BEND

PART VII – APPENDIX B

Example Lift Station Plan Set

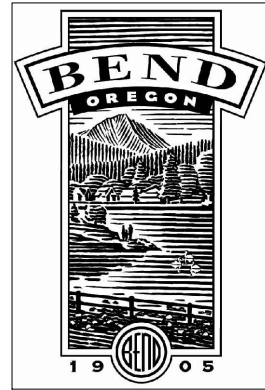

SITE ADDRESS: (ADDRESS HERE)
DATE: (DATE HERE)
CITY PROJECT NUMBER: (IF APPLICABLE)
CITY OF BEND, DESCHUTES COUNTY, OREGON

OWNER:
CITY OF BEND
UTILITY'S DEPARTMENT
62975 BOYD ACRES ROAD
BEND, OR 97701



IDENTIFICATION	DESCRIPTION
NOT APPLICABLE	

COVER
DESCHUTES COUNTY, OREGON

DESIGNED BY: _____
DRAWN BY: _____
SCALE: _____
FILE: _____
DATE: _____

VERIFY SCALES
1"
EQUALS ONE INCH
ORIGINAL DRAWING

SHEET:

G-000

DB # (XXXXXX)

FOR SAMPLE ONLY

RECORD DRAWINGS

REVISIONS DRAWN BY: XX

DATE: XX/XX/XX

THESE RECORD DRAWINGS HAVE BEEN PREPARED, IN PART, ON THE BASIS OF INFORMATION COMPILED BY OTHERS. THEY ARE NOT INTENDED TO REPRESENT IN DETAIL THE EXACT LOCATION, TYPE OF COMPONENT NOR MANNER OF CONSTRUCTION. THE ENGINEER WILL NOT BE RESPONSIBLE FOR ANY ERRORS OR OMISSIONS WHICH HAVE BEEN INCORPORATED INTO THE RECORD DRAWINGS.

	1	2	3	4	5	6	
A	DRAWING INDEX		<div>SECTION AND DETAIL DESIGNATION</div> <div>SECTION LETTER DESIGNATION</div> <div>DRAWING NUMBER WHERE SHOWN</div> <div>SECTION LETTER DESIGNATION</div> <div>SECTION</div> <div>SCALE</div> <div>DRAWING NUMBER WHERE SHOWN</div> <div>DETAIL NUMBER DESIGNATION</div> <div>DETAIL</div> <div>SCALE</div> <div>DRAWING NUMBER WHERE SHOWN</div> <div>SECTION (LETTER) OR DETAIL (NUMBER) DESIGNATION</div> <div>DRAWING NUMBER WHERE SHOWN OR (LINE) IF SHOWN ON THE SAME PAGE</div> <div>DESIGN DETAIL DESIGNATION</div> <div>DESIGN DETAIL DESIGNATION (SHOWN IN DESIGN DETAIL DOCUMENTATION)</div> <div>NOTES:</div> <div>1. ALL DESIGN DETAILS ARE TYPICAL AND MUST BE USED IF DESIGN DETAIL DESIGNATION IS NOT SHOWN.</div> <div>2. THE TERM STANDARD DETAIL, OR A FORM OF IT, IS SYNONYMOUS WITH DESIGN DETAIL AND REFERS TO THE DESIGN DETAILS FOUND IN THIS SET OF CONTRACT DOCUMENTS.</div> <div>3. THE DESIGN DETAILS REPRESENT THE CHARACTER AND NATURE OF THE WORK REQUIRED THROUGHOUT THE PROJECT. ALL ASSOCIATED WORK SHALL BE IN ACCORDANCE WITH THE DESIGN DETAILS SHOWN WHETHER THE DETAILS ARE SPECIFICALLY REFERENCED OR NOT.</div>		CONSTRUCTION NOTES: <div>1. NO CONSTRUCTION SHALL BE STARTED WITHOUT A NOTICE TO PROCEED BY THE CITY ENGINEERING DEPARTMENT. THE CITY ENGINEERING DEPARTMENT AND THE DESIGN ENGINEER SHALL BE NOTIFIED AT LEAST 24 HOURS PRIOR TO THE START OF CONSTRUCTION. ANY CONSTRUCTION WORK DONE PRIOR TO NOTICE TO PROCEED BEING ISSUED OR WITHOUT INSPECTION WILL BE REJECTED.</div> <div>2. CONTRACTOR SHALL VERIFY ALL CONDITIONS ON THE JOB SITE INCLUDING BUT NOT LIMITED TO, ALL DIMENSIONS, GRADES, ELEVATIONS, EXTENT AND COMPATIBILITY TO THE EXISTING SITE CONDITIONS, AND WITH THE WORK DESCRIBED ON THE ENGINEER'S DRAWINGS. ANY DISCREPANCIES OR UNEXPECTED CONDITIONS THAT AFFECT OR CHANGE THE WORK DESCRIBED IN THE CONTRACT DOCUMENTS SHALL BE BROUGHT TO THE ENGINEER'S ATTENTION IMMEDIATELY. CONTRACTOR SHALL NOT PROCEED WITH ANY OF THE WORK IN THE AREA OF DISCREPANCIES UNTIL ALL SUCH DISCREPANCIES ARE RESOLVED. IF THE CONTRACTOR CHOOSES TO DO SO, THEN IT IS UNDERSTOOD THAT THE CONTRACTOR IS CHOOSING TO PROCEED AT THE CONTRACTOR'S OWN RISK AND SHALL INCUR ALL COSTS, IF ANY TO RESOLVE THE ISSUES TO THE SATISFACTION OF THE ENGINEER.</div> <div>3. A CITY INSPECTOR ACTING ON BEHALF OF THE CITY MAY REQUIRE REVISIONS IN PLANS TO SOLVE UNFORESEEN PROBLEMS THAT MAY ARISE IN THE FIELD.</div> <div>4. ALL CONSTRUCTION WORK AND INSTALLATIONS SHALL CONFORM TO THE CITY STANDARDS AND SPECIFICATIONS, AND ALL WORK SHALL BE SUBJECT TO THE APPROVAL OF THE CITY.</div> <div>5. IT SHALL BE THE RESPONSIBILITY OF THE CONTRACTOR TO CONTACT "UNDERGROUND LOCATE SERVICE" AT 1-800-332-2344 AT LEAST 48 BUSINESS-DAY HOURS PRIOR TO THE START OF CONSTRUCTION FOR THE LOCATION OF POWER, GAS, CABLE TV AND TELEPHONE UNDERGROUND FACILITIES. THE CONTRACTOR WILL ALSO BE RESPONSIBLE FOR CONTACTING THE APPROPRIATE PUBLIC AGENCY FOR THE LOCATION OF UNDERGROUND FACILITIES.</div> <div>6. ALL UTILITIES SHOWN ARE ACCURATE TO THE EXTENT OF AVAILABLE RECORDS AND KNOWLEDGE. NO POTHOLES TO VERIFY LOCATIONS AND ELEVATIONS WAS AUTHORIZED BY THE OWNER. THE CONTRACTOR HAS THE TOTAL RESPONSIBILITY TO VERIFY THE LOCATION OF EXISTING UNDERGROUND UTILITIES AND TO NOTIFY THE UTILITY COMPANIES WHEN WORKING IN THEIR PROXIMITY. CONTRACTOR TO VERIFY LOCATION OF EXISTING UTILITIES PRIOR TO CONSTRUCTION. OREGON LAW REQUIRES YOU TO FOLLOW RULES ADOPTED BY THE OREGON UTILITY NOTIFICATION CENTER. THOSE RULES ARE SET FORTH IN OAR 952-001-0010 THROUGH 952-001-0090. YOU MAY OBTAIN COPIES OF THE RULES BY CALLING THE CENTER. THE TELEPHONE NUMBER FOR THE OREGON UTILITY NOTIFICATION CENTER IS (503)232-2987.</div> <div>7. ALL GRADING SHALL BE IN CONFORMANCE WITH THE CURRENT CITY STANDARDS AND SPECIFICATIONS AND CURRENT GRADING ORDINANCE. ALL SUBGRADE MATERIAL SHALL BE CONSIDERED CLASS A AND COMPACTED TO 95% OF OPTIMUM DENSITY. AS SPECIFIED IN THESE PLANS, ALL FILL MATERIAL SHALL BE COMPACTED TO 95% RELATIVE COMPACTION PER THE CITY TESTING REQUIREMENTS.</div> <div>8. ALL FINAL CUT SLOPES SHALL NOT EXCEED A GRADE OF 3 TO 1 VERTICAL UNLESS OTHERWISE APPROVED. FILL SLOPES SHALL NOT EXCEED A GRADE OF 2 HORIZONTAL TO 1 VERTICAL UNLESS OTHERWISE APPROVED BY THE ENGINEER.</div> <div>9. ALL UNSUITABLE SOILS MATERIALS, RUBBISH AND DEBRIS RESULTING FROM GRADING OPERATIONS SHALL BE REMOVED FROM THE JOB SITE AND DISPOSED OF PROPERLY.</div> <div>10. THE CONTRACTOR SHALL EMPLOY ALL LABOR, EQUIPMENT, AND METHODS REQUIRED TO PREVENT DUST IN AMOUNTS DAMAGING TO PROPERTY, CULTIVATED VEGETATION AND DOMESTIC ANIMALS OR CAUSING A NUISANCE TO PERSONS OCCUPYING BUILDINGS IN THE VICINITY OF THE JOB SITE. THE CONTRACTOR SHALL BE RESPONSIBLE FOR ANY DAMAGE CAUSED BY DUST RESULTING FROM CONSTRUCTION.</div> <div>11. THE CONTRACTOR SHALL FOLLOW ALL APPLICABLE INDUSTRIAL SAFETY REGULATIONS. THE CITY AND DESCHUTES COUNTY AND THEIR OFFICIALS, THE ENGINEER, AND THE OWNER SHALL NOT BE RESPONSIBLE FOR ENFORCING SAFETY REGULATIONS.</div> <div>12. MATERIAL QUANTITIES USED, NOTED, OR PROVIDED IN A SEPARATE ITEMIZED QUANTITY TAKE-OFF ARE AN ENGINEER'S OPINION OF PROBABLE MATERIAL REQUIREMENTS, AND IS AN ESTIMATE ONLY. CONTRACTOR'S HAVE THE SOLE RESPONSIBILITY OF MAKING THEIR OWN QUANTITY TAKE-OFF AND COST ESTIMATE.</div> <div>13. ALL WORK SHALL BE PERFORMED BY A CITY APPROVED CONTRACTOR.</div> <div>14. UTILITIES SHALL HAVE THE RIGHT TO INSTALL, MAINTAIN, AND OPERATE THEIR EQUIPMENT ABOVE AND BELOW GROUND AND ALL OTHER RELATED FACILITIES WITHIN THE PUBLIC UTILITY EASEMENTS (PUE) IDENTIFIED ON THIS PLAT MAP AS MAY BE NECESSARY OR DESIRABLE IN SERVING THE LOTS IDENTIFIED HEREIN, INCLUDING THE RIGHT OF ACCESS TO SUCH FACILITIES AND THE RIGHT TO REQUIRE THE REMOVAL OF ANY OBSTRUCTIONS INCLUDING TREES AND VEGETATION THAT MAY BE PLACED WITH IN THE PUE AT THE LOT OWNERS EXPENSE. AT NO TIME MAY ANY PERMANENT STRUCTURES BE PLACED WITHIN THE PUE OR ANY OTHER OBSTRUCTION WHICH INTERFERES WITH THE USE OF THE PUE WITHOUT PRIOR WRITTEN APPROVAL OF THE UTILITIES AND FACILITIES IN THE PUE.</div> <div>15. CITY ENGINEER'S SIGNATURE DOES NOT CONSTITUTE APPROVAL OF FACILITIES PROPOSED ON PRIVATE PROPERTY. SEPARATE PERMITS ISSUED BY THE BUILDING DEPARTMENT ARE REQUIRED AND SHALL BE OBTAINED BY THE DEVELOPER FOR FACILITIES LOCATED OUTSIDE OF THE PUBLIC RIGHT-OF-WAY.</div> <div>16. ANY WORK WITHIN EXISTING PUBLIC RIGHT-OF-WAY OR DEDICATED CITY EASEMENTS REQUIRES A SEPARATE RIGHT-OF-WAY EXCAVATION PERMIT OBTAINED FROM THE CITY ENGINEERING DIVISION.</div>		
B	DRAWING INDEX						
C	DRAWING INDEX						
D	DRAWING INDEX						

FOR SEALS AND SIGNATURES

(PROJECT NAME)
GENERAL
INDEX, NOTES, AND SIGNATURE BLOCK
DESCHUTES COUNTY, OREGON

DESIGNED BY:
DRAWN BY:
SCALE:
FILE:
DATE:

VERIFY SCALES
0 1"
BAR EQUALS ONE INCH ON ORIGINAL DRAWING

SHEET:
G-001
COB # (XXXXXX)

ABBREVIATIONS												INSTRUMENTATION EQUIPMENT ABBREVIATIONS LIST											
A	⊙	AT	FA	FIRST AID KIT	OC	ON CENTER	TG	TEMPERD GLASS	ACV	ANALYZER CONTROL VALVE	PCU	PROCESS CONTROL UNIT											
	A/B	AERATION BASIN	FAB	FABRICATION	OD	OUTSIDE DIAMETER, OVERFLOW DRAIN	THK	THICK	AE	ANALYZER ELEMENT	PCV	PRESSURE CONTROL VALVE											
	AB	ANCHOR BOLT	FFE	FINISHED FLOOR ELEVATION	O.F.	OUTSIDE FACE	THRD	THREADED	AI	ANALYZER INDICATOR	PDI	PRESSURE DIFFERENTIAL INDICATOR											
	ABDN	ABANDONED	FACIL	FACILITY	OFE	OWNER-FURNISHED EQUIPMENT	T.O.	TOP OF	AIC	ANALYZER INDICATING CONTROLLER	PDIC	PRESSURE DIFF. INDICATING CONTROLLER											
	ACBD	ACOUSTICAL BOARD	FCA	FLANGED COUPLING ADAPTER	OVHD	OVERHEAD	TOG	TOP OF GROUT	AIT	ANALYZER INDICATING TRANSMITTER	PDIT	PRESSURE DIFF. INDICATING TRANSMITTER											
	ACST	ACOUSTICAL TILE	FCTY	FACTORY	O TO O	OUT TO OUT	TPD	TONS PER DAY	ANT	ANTENNA	PDS	PRESSURE DIFFERENTIAL SWITCH											
	AD	AREA DRAIN	FD	FLOOR DRAIN	O TO O	OUT TO OUT	TPI	TURNOUT POINT OF INTERSECTION	AR	ANALYZER RECORDER	PDSH	PRESSURE DIFFERENTIAL SWITCH HIGH											
	ADDL	ADDITIONAL	FDN	FLOOR DRAIN	OPNG	OPENING	TRANSV	TRANSVERSE	ARC	ANALYZER RECORDING CONTROLLER	PDSL	PRESSURE DIFFERENTIAL SWITCH LOW											
	ADJ	ADJACENT	FEXT	FIRE EXTINGUISHER	OPP	OPPOSITE	TRD	TREAD	ASH	ANALYZER SWITCH HIGH	PDT	PRESSURE DIFFERENTIAL TRANSMITTER											
	AFF	ABOVE FINISH FLOOR	FFL	FINISHED FLOOR	PC	POINT OF CURVATURE	TSS	TOTAL SUSPENDED SOLIDS	ASHH	ANALYZER SWITCH HIGH HIGH	PE	PRESSURE ELEMENT											
B	AHR	ANCHOR	FLL	FLOW LINE ELEVATION	PCV	PRESSURE CONTROL VALVE	TST	TOP OF STEEL	ASL	ANALYZER SWITCH LOW	PH	pH ELEMENT											
	AL	ALUMINUM	FLEX	FLEXIBLE	P/C	PRIMARY CLARIFIERS	TTD	TOILET TISSUE DISPENSER	ASLL	ANALYZER SWITCH LOW LOW	PHR	pH RECORDER											
	ALTN	ALTERNATE	FLG	FLANGE	PD	PEAK DAY	TW	TOP OF WALL	ARIC	ANALYTICAL RATIO INDICATING CONTROLLER	PI	PRESSURE INDICATOR											
	APPROX	APPROXIMATE	FL	FLOOR	PHF	PEAK HOUR FLOW	TYP	TYPICAL	AT	ANALYZER TRANSMITTER	PIC	PRESSURE INDICATING CONTROLLER											
	APVD	APPROVED	FNHSH	FINISH	PI	POINT OF INTERSECTION	UBC	UNIFORM BUILDING CODE	CAB	CABINET	PIT	PRESSURE INDICATING TRANSMITTER											
	ARCH.	ARCHITECTURAL	FOT	FLAT ON TOP	P&ID	PROCESS AND INSTRUMENTATION DIAGRAM	UH	UNIT HEATER	EXI	VOLTS/MILLIVOLTS TO CURRENT TRANSDUCER	PR	PRESSURE RECORDER											
	ASSY	ASSEMBLY			PJF	PREMOLDED JOINT FILLER	UON	UNLESS OTHERWISE NOTED	EXP	VOLTS TO PRESSURE TRANSDUCER	PRN	PRINTER											
	AVG	AVERAGE	GA	GAUGE, GAGE	PL	PLATE	UNO	UNLESS NOTED OTHERWISE			PSH	PRESSURE SWITCH HIGH											
	BD	BOARD	GB	GRAB BAR	PLAM	PLASTIC LAMINATE	UR	URINAL			PSHH	PRESSURE SWITCH HIGH HIGH											
	BETW	BETWEEN	GAL	GALLON	PLYWD	PLYWOOD					PSHL	PRESSURE SWITCH HIGH LOW											
C	BF	BOTTOM FACE	GALV	GALVANIZED	POC	POINT ON CURVE	V	VENT, VOLT	FCV	FLOW CONTROL VALVE	PSL	PRESSURE SWITCH LOW											
	BLDG	BUILDING	GALVS	GALVANIZED STEEL	POT	POINT ON TANGENT	VAC	VACUUM	FE	FLOW ELEMENT	PSLL	PRESSURE SWITCH LOW LOW											
	BM	BEAM	GPD	GALLONS PER DAY	PR	PAIR	V.A.T.	VINYL ASBESTOS TILE	FI	FLOW INDICATOR	PT	PRESSURE TRANSMITTER											
	BOD	BOTTOM OF DUCT	GRD	GROUND	PRV	PRESSURE REDUCING VALVE	VC	VERTICAL	FIC	FLOW INDICATING CONTROLLER	PXI	PRESSURE TO CURRENT TRANSDUCER											
	BOT	BOTTOM	GRTG	GRATING	PS	PUMP STATION	VERT	VERTICAL	FIR	FLOW INDICATING RECORDER	PXP	PRESSURE TO PRESSURE TRANSDUCER											
	BRG	BEARING	GVL	GRAVEL	PSF	POUNDS PER SQUARE FOOT	VCP	VITRIFIED CLAY PIPE	FIT	FLOW INDICATING TRANSMITTER	PY	PRESSURE CONVERTER (SIGNAL BOOST)											
	BST	BOTTOM OF STEEL	GWB	GYP SUM WALLBOARD	PSI	POUNDS PER SQUARE INCH	VTR	VENT THRU ROOF	FQ	FLOW TOTALIZER/INTEGRATOR	PZ	PRESSURE POSITIONER (ADJUST FOR PRESSURE CONTROL VALVE)											
			GYP PLAS	GYP SUM PLASTER	PT	POINT OF TANGENCY	VWC	VINYL WALL COVERING	FQI	FLOW TOTALIZER INDICATOR													
					PTD	PAPER TOWEL DISPENSER			FQIT	FLOW TOTALIZER INDICATING TRANSMITTER	RIO	REMOTE INPUT/OUTPUT PROCESSOR											
					PTD/R	PAPER TOWEL DISPENSER/RECPTACLE			FR	FLOW RECORDER	SAMP	SAMPLER											
D	CAB.	CABINET	H.A.S	HEADED ANCHOR STUD	PTRD	PRESSURE TREATED	W	WEST, WIDE FLANGE (BEAM)	FSH	FLOW SWITCH HIGH	SE	SPEED ELEMENT											
	CCP	CONCRETE CYLINDER PIPE	HD	HUB DRAIN	PTRD	PRESSURE TREATED	W/	WITH	FSHH	FLOW SWITCH HIGH HIGH	SI	SPEED INDICATOR (TACHOMETER)											
	C/C	CHLORINE CONTACT	HDR	HARDNER	PVC	POINT OF VERTICAL CURVATURE	WAS	WASTE ACTIVATED SLUDGE	FSHL	FLOW SWITCH HIGH LOW	ST	SPEED TRANSMITTER											
	CEM PLAS	CEMENT PLASTER	HDR	HEADER	PVC	POLYVINYL CHLORIDE	WC	WATER CLOSET	FSLL	FLOW SWITCH LOW LOW	SV	SOLENOID VALVE											
	CHEM	CHEMICAL	HGT	HEIGHT	PVI	POINT OF VERTICAL INTERSECTION	WD	WOOD	FT	FLOW TRANSMITTER	SWR	SWITCHER											
	CHKD PL	CHECKERED PLATE	HM	HOLLOW METAL	PVM	PAVEMENT	WG	WIRE GLASS			SY	SPEED CONVERTER (TRANSDUCER)											
	CFM	CUBIC FEET PER MINUTE	HORIZ	HORIZONTAL	PVT	POINT OF VERTICAL TANGENCY	WH	WATER HEATER			SZ	SPEED ACTUATOR (ENGINE)											
	CI	CAST IRON	HPT	HIGH POINT			WK	WEEK			TC	TEMPERATURE CONTROLLER											
	CIP	CAST IN PLACE	HR	HANDRAIL	QDRNT	QUADRANT	WP	WORKING POINT			TCV	TEMPERATURE CONTROL VALVE											
	CJ	CONSTRUCTION JOINT	HS	HIGH STRENGTH	QTY	QUANTITY	WR	WATER RESISTANT GYPSUM			TE	TEMPERATURE ELEMENT											
E	CL 2	CHLORINE			R	R-VALUE (INSULATION)	WR GBW	WATER RESISTANT GYPSUM WALLBOARD	HC	HAND CONTROLLER	TI	TEMPERATURE INDICATOR											
	CLG	CEILING	I&C	INSTRUMENTATION AND CONTROL	R OR RAD	RADIUS			HIC	HAND INDICATING CONTROLLER	TIC	TEMPERATURE INDICATING CONTROL											
	CLR	CLEAR	ID	INSIDE DIAMETER	R	RISER			HOA	HAND-OFF-AUTO SWITCH	TIS	TEMPERATURE INDICATING SWITCH											
	CMP	CORRUGATED METAL PIPE	IE	INVERT ELEVATION	RC	REINFORCED CONCRETE	WS	WASTE RECEPTACLE	ICI	INFINET TO COMPUTER INTERFACE	TIIT	TEMPERATURE INDICATING TRANSMITTER											
	CMU	CONCRETE MASONARY UNITS	I.F.	INSIDE FACE	RCP	REINFORCED CONCRETE PIPE	WTR	WATER	KY	TIME RELAY	TQI	TORQUE INDICATOR											
	COB	CITY OF BEND	INFL	INFLUENT	RD	ROOF DRAIN	WWM	WELDED WIRE MESH			TQIC	TORQUE INDICATING CONTROL											
	COL	COLUMN	INSTL	INSTALL	RDR	REDUCER					TQIT	TORQUE INDICATING TRANSMITTER											
	CONC	CONCRETE	INSUL	INSULATION	REHAB	REHABILITATE					TQR	TORQUE RECORDER											
	CONN	CONNECTION	INTR	INTERIOR	REINF	REINFORCE, REINFORCED, REINFORCING	XFMR	TRANSFORMER			TQS	TORQUE SWITCH											
	CONST	CONSTRUCTION	INVT	INVERT	REQD	REQUIRED					TQSH	TORQUE SWITCH HIGH											
F	CONT	CONTINUOUS	ITG	INSULATED TEMPERED GLASS	RESIL	RESILIENT	YD	YARD	L/R	LOCAL/REMOTE SWITCH	TQT	TORQUE TRANSMITTER											
	COR	CORNER			RM	ROOM	YR	YEAR	LCV	LEVEL CONTROL VALVE	TR	TEMPERATURE RECORDER											
	CPLG	COUPLING	JT	JOINT	RO	ROUGH OPENING			LE	LEVEL ELEMENT	TSH	TEMPERATURE SWITCH HIGH											
	CPVC	CHLORINATED POLYVINYL CHLORIDE			RST	REINFORCING STEEL			LG	LEVEL GAUGE	TSHH	TEMPERATURE SWITCH HIGH HIGH											
	C TO C	CENTER TO CENTER	L	LENGTH OF CURVE	S	SOUTH			LI	LEVEL INDICATOR	TSL	TEMPERATURE SWITCH LOW											
	CTR	CENTER	LB	POUNDS	S.A.T.	SUSPENDED ACOUSTICAL TILE			LIC	LEVEL INDICATING CONTROLLER	TSLL	TEMPERATURE SWITCH LOW LOW											
	CTRD	CENTERED	LB/D	POUNDS PER DAY	S/C	SECONDARY CLARIFIERS			LISH	LEVEL INDICATING SWITCH HIGH	TT	TEMPERATURE TRANSMITTER											
	CU FT	CUBIC FEET	LG	LONG	SCBA	SELF CONTAINED BREATHING APPARATUS			LR	LEVEL INDICATING TRANSMITTER	TW	THERMAL WELL											
	∟	CENTRAL ANGLE	LLV	LONG LEG VERTICAL	SCHED	SCHEDULE			LR	LEVEL RECORDER	TY	TEMPERATURE SELECT											
	DAFT	DISSOLVED AERATION FLOTATION THICKENING	LNTL	LINTEL	SD	SOAP DISPENSER, STORM DRAIN			LRC	LEVEL RATIO CONTROLLER													
G	DBA	DEFORMED BAR ANCHOR	LONG.	LONGITUDINAL	SECT	SECTION			LSH	LEVEL SWITCH HIGH	UI	MULTIVARIABLE INDICATOR											
	DBL	DOUBLE	LPT	LOW POINT	SG	SAFETY GLASS			LSHH	LEVEL SWITCH HIGH HIGH	UR	MULTIVARIABLE RECORDER											
	DET	DETAIL	LT	LIGHT	SH	SHEET			LSL	LEVEL SWITCH LOW	USH	MULTIVARIABLE SWITCH HIGH											
	DIA	DIAMETER			SHTG	SHEETING			LSLL	LEVEL SWITCH LOW LOW													
	DIAG	DIAGONAL	MATL	MATERIAL	SIM	SIMILAR			LSM	LEVEL SWITCH MIDDLE	VDT	VIDEO DISPLAY											
	DIM	DIMENSION	MAX	MAXIMUM	SLV	SHORT LEG VERTICAL			LT	LEVEL TRANSMITTER	WI	WEIGHT INDICATOR											
	DIP.	DUCTILE IRON PIPE	MB	MACHINE BOLT	S.O.	SHUTOFF					WIT	WEIGHT INDICATING TRANSMITTER											
	DIR	DIRECTION	MCC	MOTOR CONTROL CENTER	SPEC	SPECIFIED																	
	DISCH	DISCHARGE	MECH	MECHANICAL	SPECS	SPECIFICATIONS																	
	DN	DOWN	MFR	MANUFACTURER	SPG	SPACING																	
H	DS	DOWN SPOUT	MGD	MILLION GALLONS PER DAY	SO	SQUARE			MCD	MOTORIZED CONTROL DAMPER	XV	REMOTELY CONTROLLED ON-OFF VALVE											
	DWG	DRAWING	MG/L	MILLIGRAMS PER LITRE	SST	STAINLESS STEEL			MPA	ANALOG MARSHALLING PANEL													
	DWL	DOWEL	MH	MANHOLE	STA	STATION			MPC	MARSHALLING PANEL CONTROL	ZI	POSITION INDICATOR											
	E	EAST	MIN	MINIMM	STD	STANDARD			MPD	DIGITAL MARSHALLING PANEL	ZIS	POSITION INDICATING SWITCH											
	EA	EACH	MISC	MISCELLANEOUS	STIF	STIFFENER			MSL	MOTION SWITCH	ZIT	POSITION INDICATING TRANSMITTER											
	ECC	ECCENTRIC	MLSS	MIXED LIQUOR SUSPENDED SOLIDS	STOR	STORAGE					ZS	POSITION SWITCH											
	EF	EACH FACE	MLVSS	MIXED LIQUOR VOLATILE SUSPENDED SOLIDS	STR	STRAIGHT			NE	MOISTURE PROBE	ZSC	POSITION SWITCH CLOSED											
	EFL	EFFLUENT	MO	MASONARY OPENING	STRUCT	STRUCTURAL, STRUCTURE			NI	MOISTURE INDICATOR	ZSO	POSITION SWITCH OPEN											
	EL	ELEVATION	MON	MONUMENT	STL	STEEL			NSH	MOISTURE SWITCH HIGH	ZT	POSITION TRANSMITTER											
	ELB	ELBOW	MTG	MOUNTING	SWD	SIDE WATER DEPTH																	
I	ELEC	ELECTRICAL	MTL	METAL	SYMM	SYMMETRICAL			QJB	OPTICAL JUNCTION BOX													
	EP	EDGE OF PAVEMENT	MTR	METERING																			
	EQL	EQUAL			T	TINTED																	
	EQL SP	EQUALLY SPACED	N	NORTH	T	TANGENT LENGTH																	
	EQPT	EQUIPMENT	NIC	NOT IN CONTRACT	T&B	TOP AND BOTTOM																	
	EW	EACH WAY	NO.	NUMBER	TAS	THREADED ANCHOR STUD																	
	EXP JT	EXPANSION JOINT	NOM	NOMINAL	TC	TOP OF CONCRETE, TOP OF CURB																	
	EXT	EXTERIOR, EXTERNAL, EXTENSION	NORM	NORMAL	TEMP	TEMPERED, TEMPERATURE																	
	EXST	EXISTING	NTS	NOT TO SCALE	TF	TOP FACE																	

FOR SEALS AND SIGNATURES

(PROJECT NAME)
GENERAL
GENERAL LEGEND AND PIPING SYMBOLS
DESCHUTES COUNTY, OREGON

REVISIONS:

DESIGNED BY:
DRAWN BY:
SCALE:
FILE:
DATE:

VERIFY SCALES
0 1"
BAR EQUALS ONE INCH ON ORIGINAL DRAWING

SHEET:
G-002
COB # (XXXXXX)

PIPE IDENTIFICATION

EQUIPMENT NUMBERING CONVENTION

GENERAL NOTES

FOR SAMPLE ONLY



REVISIONS:


--	--	--	--	--	--	--	--	--	--

(CONSULTANT ENGINEER NAME, ADDRESS & PHONE NUMBER)

DESIGNED BY: _____
DRAWN BY: _____
SCALE: _____
FILE: _____
DATE: _____

VERIFY SCALES
0 1"
BAR EQUALS ONE INCH ON ORIGINAL DRAWING

SHEET: **G-002**
COB # (XXXXXX)

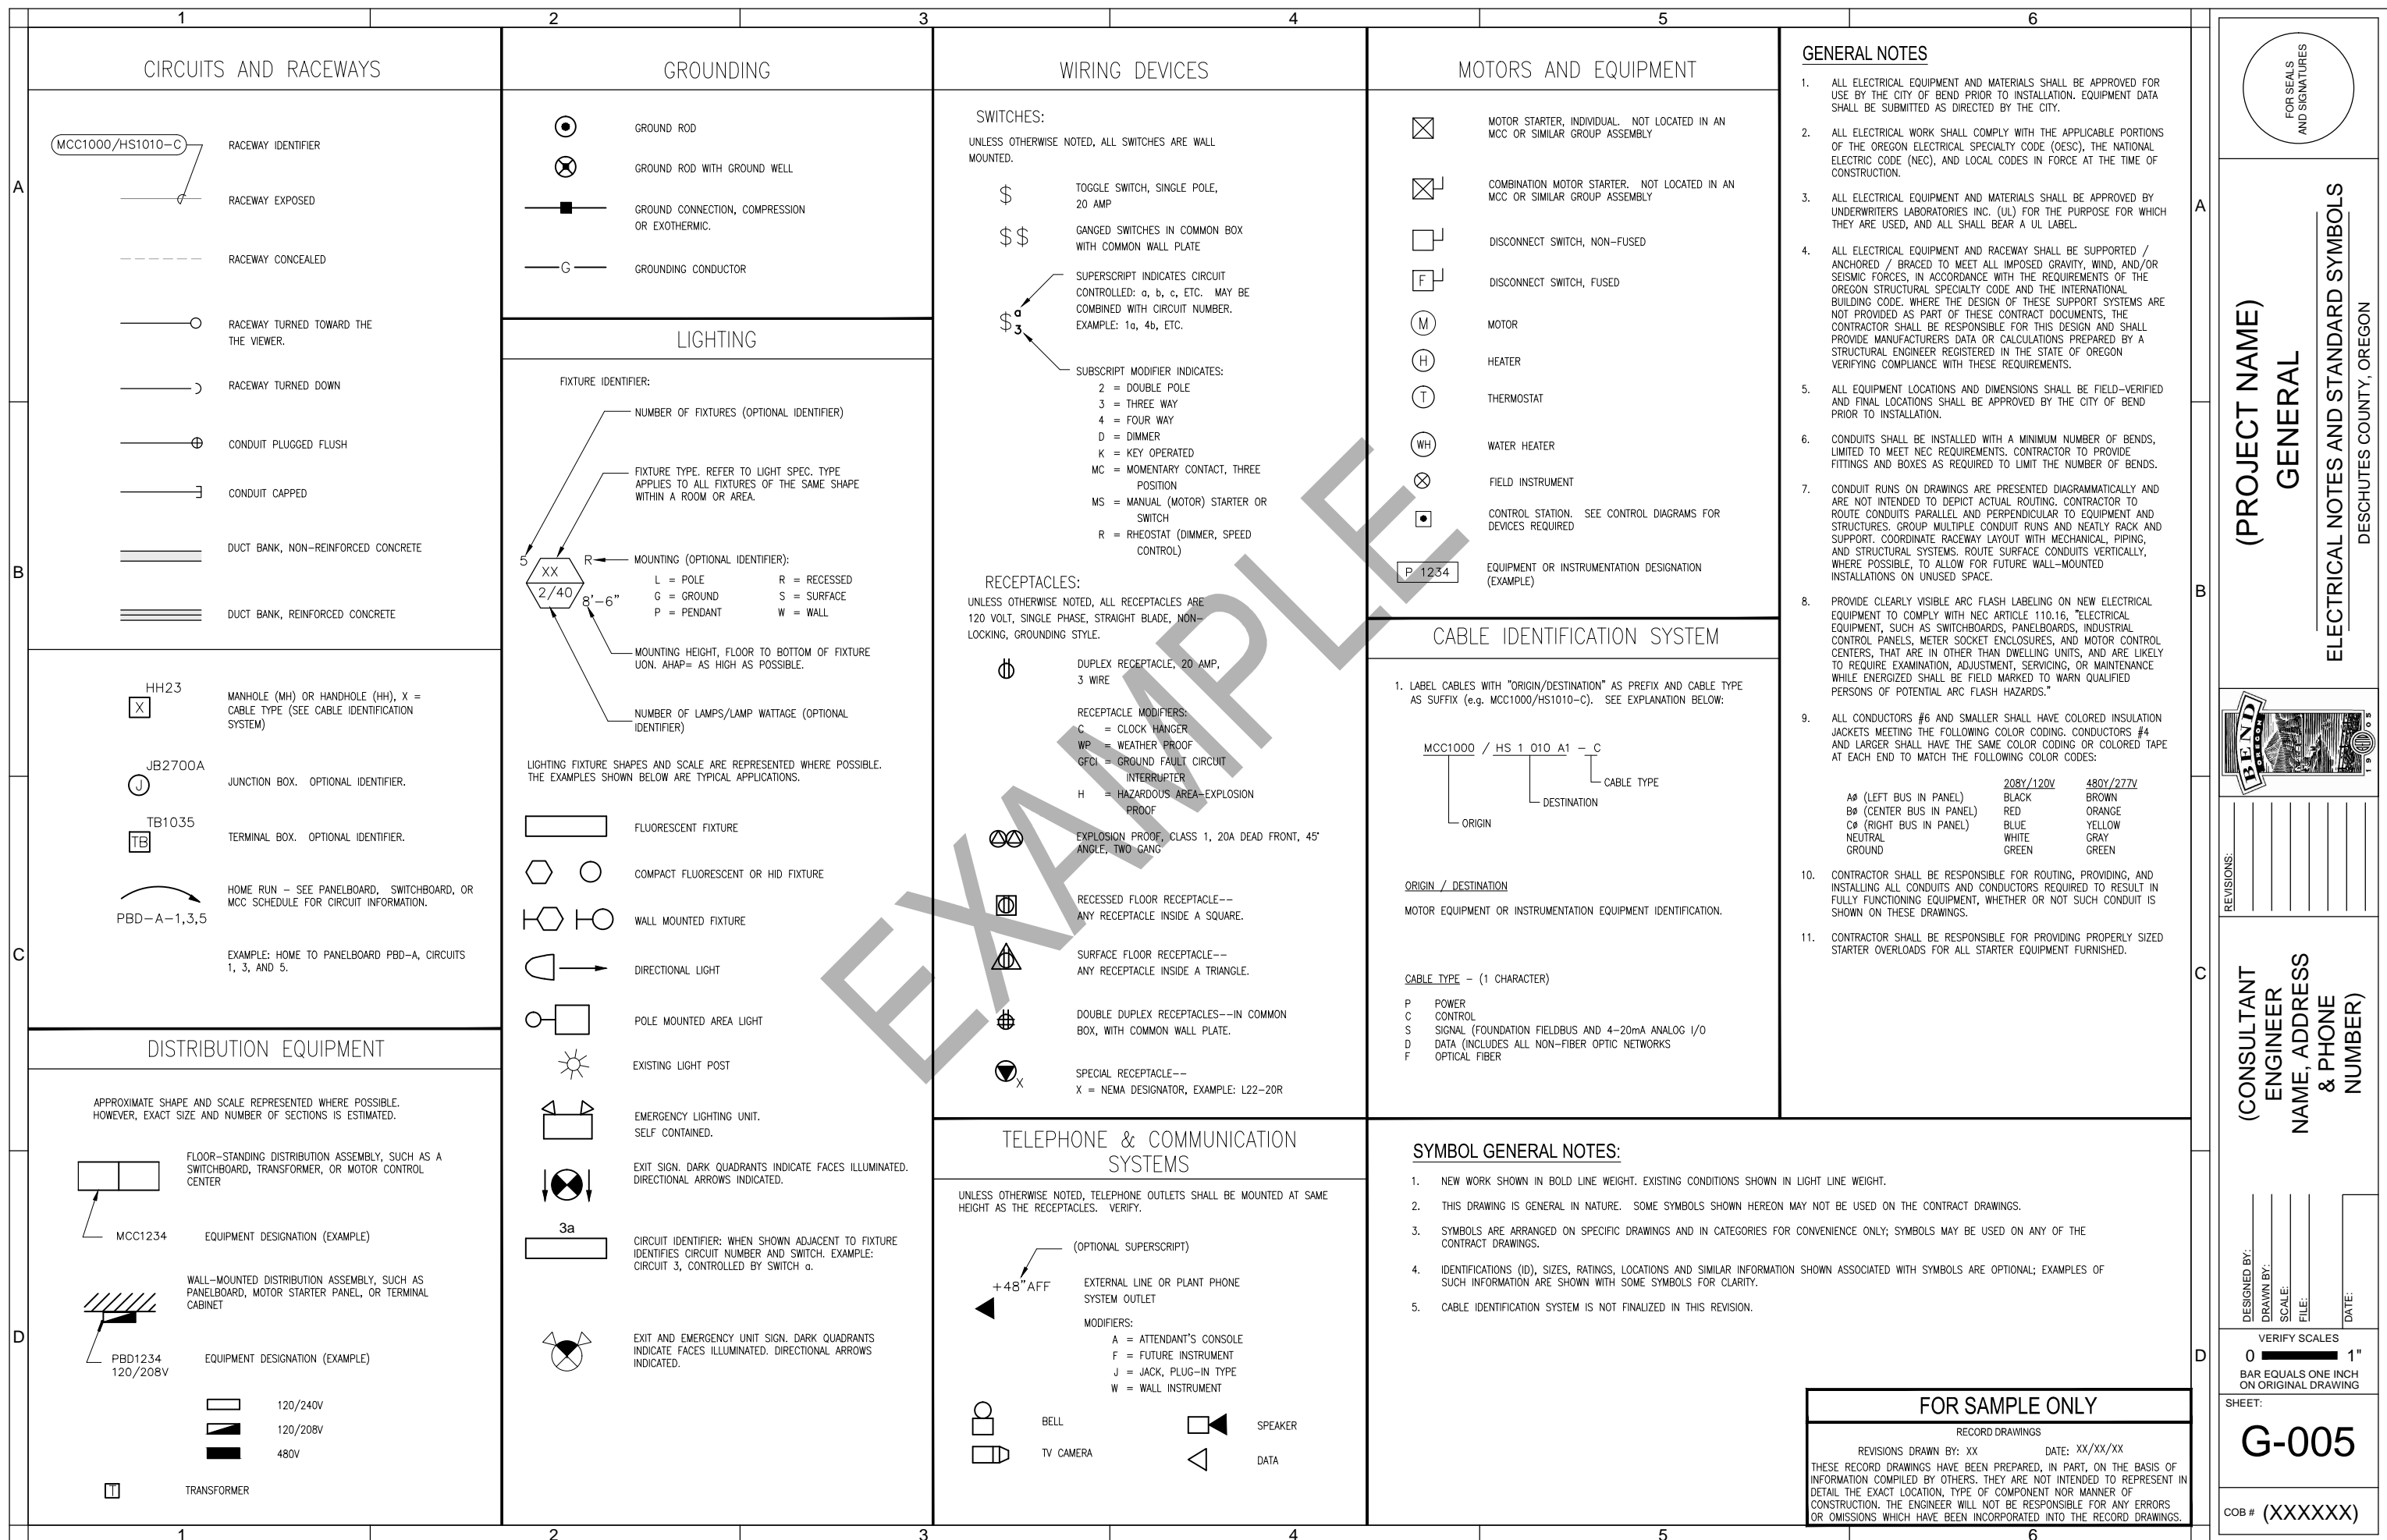

1		2		3		4		5		6																													
CONTROL DIAGRAM SYMBOLS												ONE LINE DIAGRAM SYMBOLS																											
GENERAL				PUSHBUTTONS				CONTROL RELAYS				INDICATING LIGHTS				TRANSFORMERS				MISCELLANEOUS																			
<div><div><div><div></div><div></div></div><div>ENCLOSURE BOUNDARY, EXISTING</div></div><div><div><div></div><div></div></div><div>ENCLOSURE BOUNDARY, NEW</div></div><div><div><div></div><div></div></div><div>CONDUCTORS CONNECTED</div></div><div><div><div></div><div></div></div><div>CONDUCTORS NOT CONNECTED</div></div><div><div><div></div><div></div></div><div>TERMINAL POINT FOR EXTERNAL CONNECTIONS</div></div><div><div><div></div><div></div></div><div>EXISTING EQUIPMENT</div></div></div>				<div><div><div><div><div>ID</div><div>LOCATION</div></div><div></div><div>PUSH BUTTON, MOMENTARY CONTACT, NORMALLY OPEN</div></div><div><div><div>ID</div><div>LOCATION</div></div><div></div><div>PUSH BUTTON, MOMENTARY CONTACT, NORMALLY CLOSED</div></div><div><div><div>ID</div><div>LOCATION</div></div><div></div><div>PUSH BUTTON WITH MUSHROOM HEAD, EMERGENCY STOP, MOMENTARY CONTACT</div></div></div></div>				<div><div><div><div><div>CR 2</div><div>FUNCTION</div></div><div></div><div>OPERATING COIL</div></div><div><div><div>CR 2</div><div>FUNCTION</div></div><div></div><div>CR = CONTROL RELAY U = UNLATCH L = LATCH</div></div><div><div><div>OL</div><div>FUNCTION</div></div><div></div><div>THERMAL OVERLOAD RELAY</div></div><div><div><div>CR2</div><div>CR2</div><div>(LINE) (LINE)</div></div><div></div><div>OUTPUT CONTACTS. LINE NUMBER OF RELAY COIL SHOWN (OPTIONAL)</div></div></div></div>				<div><div><div><div><div></div><div>INDICATING LIGHTS</div></div><div><div>L = LENS COLOR:</div><div>A = AMBER B = BLUE G = GREEN R = RED W = WHITE</div></div></div><div><div></div><div>PUSH TO TEST. TEST VOLTAGE TERMINAL SHOWN</div></div></div></div>												DISCONNECTS AND OVERCURRENT DEVICES				INPUT SWITCHES				TIMING RELAYS				MAIN CONTACTS			
<div><div><div><div><div>MCP</div><div></div></div><div>MOTOR CIRCUIT PROTECTOR</div></div><div><div><div><div></div><div></div></div><div>CIRCUIT BREAKER, THERMAL- MAGNETIC, 3 POLE, UON.</div></div><div><div>MODIFIERS:</div><div>/M MAGNETIC ONLY /2P POLES, IF OTHER THAN 3</div></div><div><div><div><div>FUSE SIZE</div><div></div></div><div>FUSE</div></div><div><div>MODIFIERS:</div><div>CLF = CURRENT LIMITING FUSE DE = DUAL ELEMENT F = CLASS F</div></div><div><div><div><div></div><div></div></div><div>NEON BLOWN FUSE INDICATOR</div></div></div></div></div></div></div>				SELECTOR SWITCHES				CONTACTORS				OUTPUT LOADS AND DEVICES																											
<div><div><div><div><div><div>ID</div><div>1</div><div>2</div></div><div></div><div>2 POSITION MAINTAINED CONTACT</div></div><div><div><div><div></div><div></div></div><div>CLOSED IN POSITION 1</div></div><div><div><div><div></div><div></div></div><div>CLOSED IN POSITION 2</div></div></div></div></div></div></div>				<div><div><div><div><div><div>ID</div><div>1</div><div>2</div></div><div></div><div>2-POSITION SPRING RETURNED TO RIGHT</div></div><div><div><div><div></div><div></div></div><div>CLOSED IN POSITION 1</div></div><div><div><div><div></div><div></div></div><div>CLOSED IN POSITION 2</div></div></div></div></div></div></div>				<div><div><div><div><div><div>ID</div><div>1</div><div>2</div><div>3</div></div><div></div><div>3-POSITION MAINTAINED CONTACT</div></div><div><div><div><div></div><div></div></div><div>CLOSED IN POSITION 1</div></div><div><div><div><div></div><div></div></div><div>CLOSED IN POSITION 2</div></div></div><div><div><div><div></div><div></div></div><div>CLOSED IN POSITION 3</div></div></div></div></div></div></div>				<div><div><div><div><div><div>ID</div><div>SIZE</div></div><div></div><div>OPERATING COILS</div></div><div><div><div>C = CONTACTOR, LIGHTING OR GENERAL USE F = FAST OR FORWARD M = MAIN OR LINE 1M = FIRST MAIN OR WYE 2M = SECOND MAIN OR DELTA R = RUN OR REVERSE S = SLOW OR START</div></div></div><div><div><div><div>ID</div><div>SIZE</div></div><div></div><div>MAIN CONTACTS</div></div></div></div></div></div>				<div><div><div><div><div><div>M</div><div></div></div><div>MOTOR</div></div><div><div><div><div></div><div></div></div><div>SPACE HEATER. WATTAGE SHOWN</div></div><div><div><div><div></div><div></div></div><div>MAGNETIC COIL</div></div><div><div><div><div>SV</div><div></div></div><div>SOLENOID</div></div><div><div><div><div>ETM</div><div></div></div><div>HOUR METER (ELAPSED TIME)</div></div><div><div><div><div>KIC</div><div></div></div><div>TIME CONTROLLER</div></div></div></div></div></div></div></div></div></div>				<div><div><div><div><div><div>POTHEAD</div><div></div></div><div>POTHEAD</div></div><div><div><div><div></div><div></div></div><div>STRESS CONE</div></div><div><div><div><div></div><div></div></div><div>INCOMING LINE</div></div><div><div><div><div></div><div></div></div><div>INDICATES THAT ALL OR PART OF CONDUIT MAY BE ROUTED IN DUCT BANK OR UNDERGROUND.</div></div></div><div><div><div><div></div><div></div></div><div>SIGNAL</div></div><div><div><div><div></div><div></div></div><div>PORTABLE CABLE</div></div><div><div><div><div></div><div></div></div><div>BUS CONDUCTOR</div></div><div><div><div><div></div><div></div></div><div>CABLE CONDUCTOR</div></div><div><div><div><div></div><div></div></div><div>SURGE PROTECTOR</div></div><div><div><div><div></div><div></div></div><div>LIGHTNING ARRESTOR AND GROUND</div></div><div><div><div><div></div><div></div></div><div>TEST DEVICE</div></div><div><div><div><div></div><div></div></div><div>METERING SWITCH</div></div><div><div><div><div></div><div></div></div><div>METERS:</div></div><div><div>A = AMPERES F = FREQUENCY KW = KILOWATTS, DEMAND PF = POWER FACTOR V = VOLTS VA = VOLT-AMPERES VAR = VOLTAMPERES REACTIVE WH = WATTHOURS</div></div></div><div><div><div><div><div>XS</div><div></div></div><div>METER SWITCH</div></div><div><div>AS = AMMETER SWITCH VS = VOLTMETER SWITCH</div></div></div><div><div><div><div></div><div></div></div><div>RECEPTACLE/PLUG CONNECTION/BUS CONNECTION</div></div><div><div><div><div></div><div></div></div><div>MOTOR, HORSEPOWER SHOWN</div></div><div><div><div><div></div><div></div></div><div>HEATER, 5KW SIZE SHOWN</div></div><div><div><div><div></div><div></div></div><div>DISCONNECT OR ISOLATING SWITCH. 200 AMP SHOWN</div></div></div></div></div></div></div></div></div></div></div></div></div></div></div></div></div></div></div></div>				<div><div><div><div><div><div>100F</div><div></div></div><div>FUSE. 100 AMP CLASS "F" SHOWN</div></div><div><div><div><div><div>100 KVA</div><div>13.2 KV</div></div><div></div><div>POWER TRANSFORMER. VOLTAGES, SIZE, IMPEDANCE SHOWN</div></div><div><div><div><div><div>5.75% Z</div><div>480/277 V</div></div><div></div><div>ISOLATION TRANSFORMER. VOLTAGES, SIZE, IMPEDANCE SHOWN</div></div><div><div><div><div><div>1.5 KVA</div><div>120 V</div></div><div></div><div>ISOLATION TRANSFORMER. VOLTAGES, SIZE, IMPEDANCE SHOWN</div></div><div><div><div><div><div>2.5% Z</div><div>240/120 V</div></div><div></div><div>POTENTIAL TRANSFORMER. PT QUANTITY (3), VOLTAGES, WYE-DELTA CONFIGURATION SHOWN</div></div><div><div><div><div><div>4.16 KV</div><div>120 V</div></div><div></div><div>POTENTIAL TRANSFORMER. PT QUANTITY (3), VOLTAGES, WYE-DELTA CONFIGURATION SHOWN</div></div><div><div><div><div><div>400:5</div><div>3</div></div><div></div><div>CURRENT TRANSFORMER. CT QUANTITY (3) AND 400:5 TURNS RATIO SHOWN. WINDING CONFIGURATIONS:</div></div><div><div><div><div><div></div><div></div></div><div>DELTA</div></div><div><div><div><div></div><div></div></div><div>WYE (GROUNDED)</div></div></div></div></div></div></div></div></div></div></div></div></div></div></div></div></div></div></div></div>				<div><div><div><div><div><div>600KW</div><div>60HZ</div></div><div></div><div>GENERATOR. POWER RATING, FREQUENCY, VOLTAGE, POWER FACTOR, GROUNDED WYE WINDING SHOWN.</div></div><div><div><div><div><div>480V</div><div>3ø, 4W</div><div>PF 0.8</div></div><div></div><div>NEUTRAL GROUNDING RESISTOR. AMPS/TIME RATING SHOWN</div></div><div><div><div><div></div><div></div></div><div>50 AMP/10 SEC</div></div><div><div><div><div></div><div></div></div><div>KIRK KEY INTERLOCK</div></div><div><div><div><div></div><div></div></div><div>CIRCUIT BREAKER</div></div></div></div></div></div></div></div></div></div>				<div><div><div><div><div><div>200A</div><div></div></div><div>DISCONNECT OR ISOLATING SWITCH. 200 AMP SHOWN</div></div></div></div></div>				<div><div><div><div><div><div>0</div><div>1"</div></div><div>BAR EQUALS ONE INCH ON ORIGINAL DRAWING</div></div><div><div><div><div>DESIGNED BY:</div><div>DRAWN BY:</div><div>SCALE:</div><div>FILE:</div><div>DATE:</div></div></div><div><div><div><div>G-006</div><div>COB # (XXXXXX)</div></div></div></div></div></div></div></div>			
1		2		3		4		5		6																													

FOR SEALS AND SIGNATURES

(PROJECT NAME)
GENERAL

ELECTRICAL NOTES AND STANDARD SYMBOLS
DESCHUTES COUNTY, OREGON

REVISIONS:

DESIGNED BY:

DRAWN BY:

SCALE:

FILE:

DATE:

VERIFY SCALES
0 1"
BAR EQUALS ONE INCH ON ORIGINAL DRAWING

SHEET:
G-006

COB # (XXXXXX)

	1	2	3	4	5	6
A	WASTEWATER PUMP STATION AND FORCE MAIN DESIGN DATA SUMMARY TABLE 1					
	BASIN CHARACTERISTICS					
	LOCATION	ADDRESS AND CROSS STREET				
	BASIN AREA	XXX ACRES				
	EQUIVALENT DWELLING UNITS (EDU) PER ACRE	X.X				
	PERSON PER EDU	X.X				
	POPULATION EQUIVALENT	XXXX				
	AVERAGE PER CAPITA FLOW	XX GPD				
	INFILTRATION AND INFLOW, PEAK WET WEATHER FLOW (PWWF)	XXX,XXX GPD				
	AVERAGE DAILY FLOW	XXX,XXX GPD				
	PEAK HOURLY FLOW	XXX GPM				
	PUMP STATION					
	TYPE	DUPLIX SUBMERSIBLE, NON-CLOG, VARIABLE SPEED PUMPS				
	CAPACITY (PER PUMP)	XXX GPM @ XX FEET TDH (STATIC HEAD = XX FT)				
	HORSEPOWER, HP	XX HP EACH WITH VARIABLE FREQUENCY DRIVES				
	MOTOR DATA	Xxx VOLT X PHASE XX CYCLE				
	FIRM CAPACITY OF PUMP STATION	X.XX MGD (XXX GPM)				
	MAXIMUM PUMP STARTS PER HOUR	X - SEE NOTE 4				
	WET WELL VOLUME	XXXX GALLONS (PUMPS OFF TO LEAD PUMP)				
	LEVEL CONTROL TYPE	PRESSURE SENSORS LEVEL CONTROL				
	OVERFLOW POINT	MANHOLE NUMBER AND ELEVATION				
	OVERFLOW LOCATION	DESCRIPTION				
	AVERAGE TIME TO OVERFLOW	TIME AND DESCRIPTION, XX HOURS AT XX GPM DESIGN AVERAGE INFILTRANT FLOW - SEE NOTE 1				
	TELEMETRY	BY CITY				
	TRANSFER SWITCH	AUTOMATIC				
	STANDBY POWER TYPE	XXX KW STATIONARY DIESEL POWERED STANDBY GENERATOR				
	FUEL TANK CAPACITY	XX HRS/DAYS (XXX GALLONS)				
	EPA RELIABILITY CLASS	1				
	FLOW METER	"X" MAGNETIC (DESCRIPTION)				
	CONTROL	CONSTANT SPEED OR VFD - PER CITY APPROVAL				
	FORCE MAIN					
	TYPE AND LENGTH	XXXX FEET, TYPE				
	FORCEMAIN VELOCITY	X.X FEET PER SECOND				
	PROFILE	DESCRIPTION				
	AIR RELEASE VALVE	QUANTITY, DESCRIPTION				
	DISCHARGE LOCATION	MANHOLE NUMBER AND ELEVATION				
	AVERAGE DETENTION TIME	XX HOURS				
	ODOR CONTROL SYSTEM	DESCRIPTION				
	OPERATING LEVELS					
	GROUND ELEVATION	XXXX.XX				
	OVERFLOW ALARM ELEVATION	FLOAT CONTROL SYSTEM? (BACKUP)				
	LAG PUMP ON/HIGH WATER ALARM ELEVATION XXXX.XX	PRESSURE PROBE (PROVIDE DISTANCE FROM WET WELL FLOOR IN FEET) SAME AS LEVEL INDICATOR DIGITAL DISPLAY				
	LEAD PUMP ON ELEVATION XXXX.XX	PRESSURE PROBE (PROVIDE DISTANCE FROM WET WELL FLOOR IN FEET) SAME AS LEVEL INDICATOR DIGITAL DISPLAY				
	ALL PUMPS OFF ELEVATION XXXX.XX	PRESSURE PROBE (PROVIDE DISTANCE FROM WET WELL FLOOR IN FEET) SAME AS LEVEL INDICATOR DIGITAL DISPLAY				
	WETWELL FLOOR ELEVATION XXXX.XX	PRESSURE PROBE (0.00 FEET)				
	LANDSCAPING					
	LANDSCAPING AREA	SQUARE FEET AND DESCRIPTION				
	IRRIGATION SYSTEM	TYPE				
	CONTROL VALVES	NUMBER AND TYPE				
	BACKFLOW DEVICE	SIZE AND TYPE				
B						
C						
D						
	PUMP STATION SCHEMATIC					
	EXAMPLE PUMP PERFORMANCE CURVE					
	PUMP STATION SCHEMATIC					
	FOR SAMPLE ONLY					

DESIGNED BY: _____

DRAWN BY: _____

SCALE: _____

FILE: _____

DATE: _____

VERIFY SCALES

0 1" BAR EQUALS ONE INCH ON ORIGINAL DRAWING

SHEET: G-008

COB # (XXXXXX)

REVISIONS:

1	DESIGN ENGINEER TO FILL IN DESIGN INFORMATION IN THE TABLE FOR APPROVAL BY CITY OF BEND. PUMP STATION WETWELL SHALL CONFORM TO ANSI/HYDRAULIC INSTITUTE STANDARD 9.8.
2	RESERVED FOR FUTURE THIRD PUMP IN PUMP STATION.
3	PUMP SELECTION DESIGN POINT SHALL CONFORM TO HYDRAULIC INSTITUTE STANDARDS 9.6.3
4	PUMP STATION WETWELL STORAGE VOLUME PER HYDRAULIC INSTITUTE STANDARD 9.8 BASED ON THE MAXIMUM PUMP CYCLE TIME, LESS THAN EIGHT (8) STARTS PER HOUR.

LEGEND

- 6" PUMPER PORT
- CHECK VALVE
- PLUG VALVE
- FLOW METER
- FORCE MAIN
- GRAVITY SEWER

PERFORMANCE CURVE

PRODUCT: NP3102.090

CURVE NO: 83-256-00-5206

TYPE: SH

DATE: 2007-06-07

PROJECT: Bend - Shadow Glen

IMPELLER DIAMETER: 135 mm

MOTOR # 18-10-2AL

380 V

12 POLES

80 Hz

480 V

2

1

2

3

FOR SEALS
AND SIGNATURES

(PROJECT NAME)
GENERAL
BASIS OF DESIGN
DESCHUTES COUNTY, OREGON



(CONSULTANT
ENGINEER
NAME, ADDRESS
& PHONE
NUMBER)

DESIGNED BY: _____

DRAWN BY: _____

SCALE: _____

FILE: _____



DATE: _____

VERIFY SCALES

0 1" BAR EQUALS ONE INCH ON ORIGINAL DRAWING

SHEET: G-008

COB # (XXXXXX)

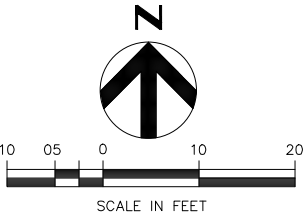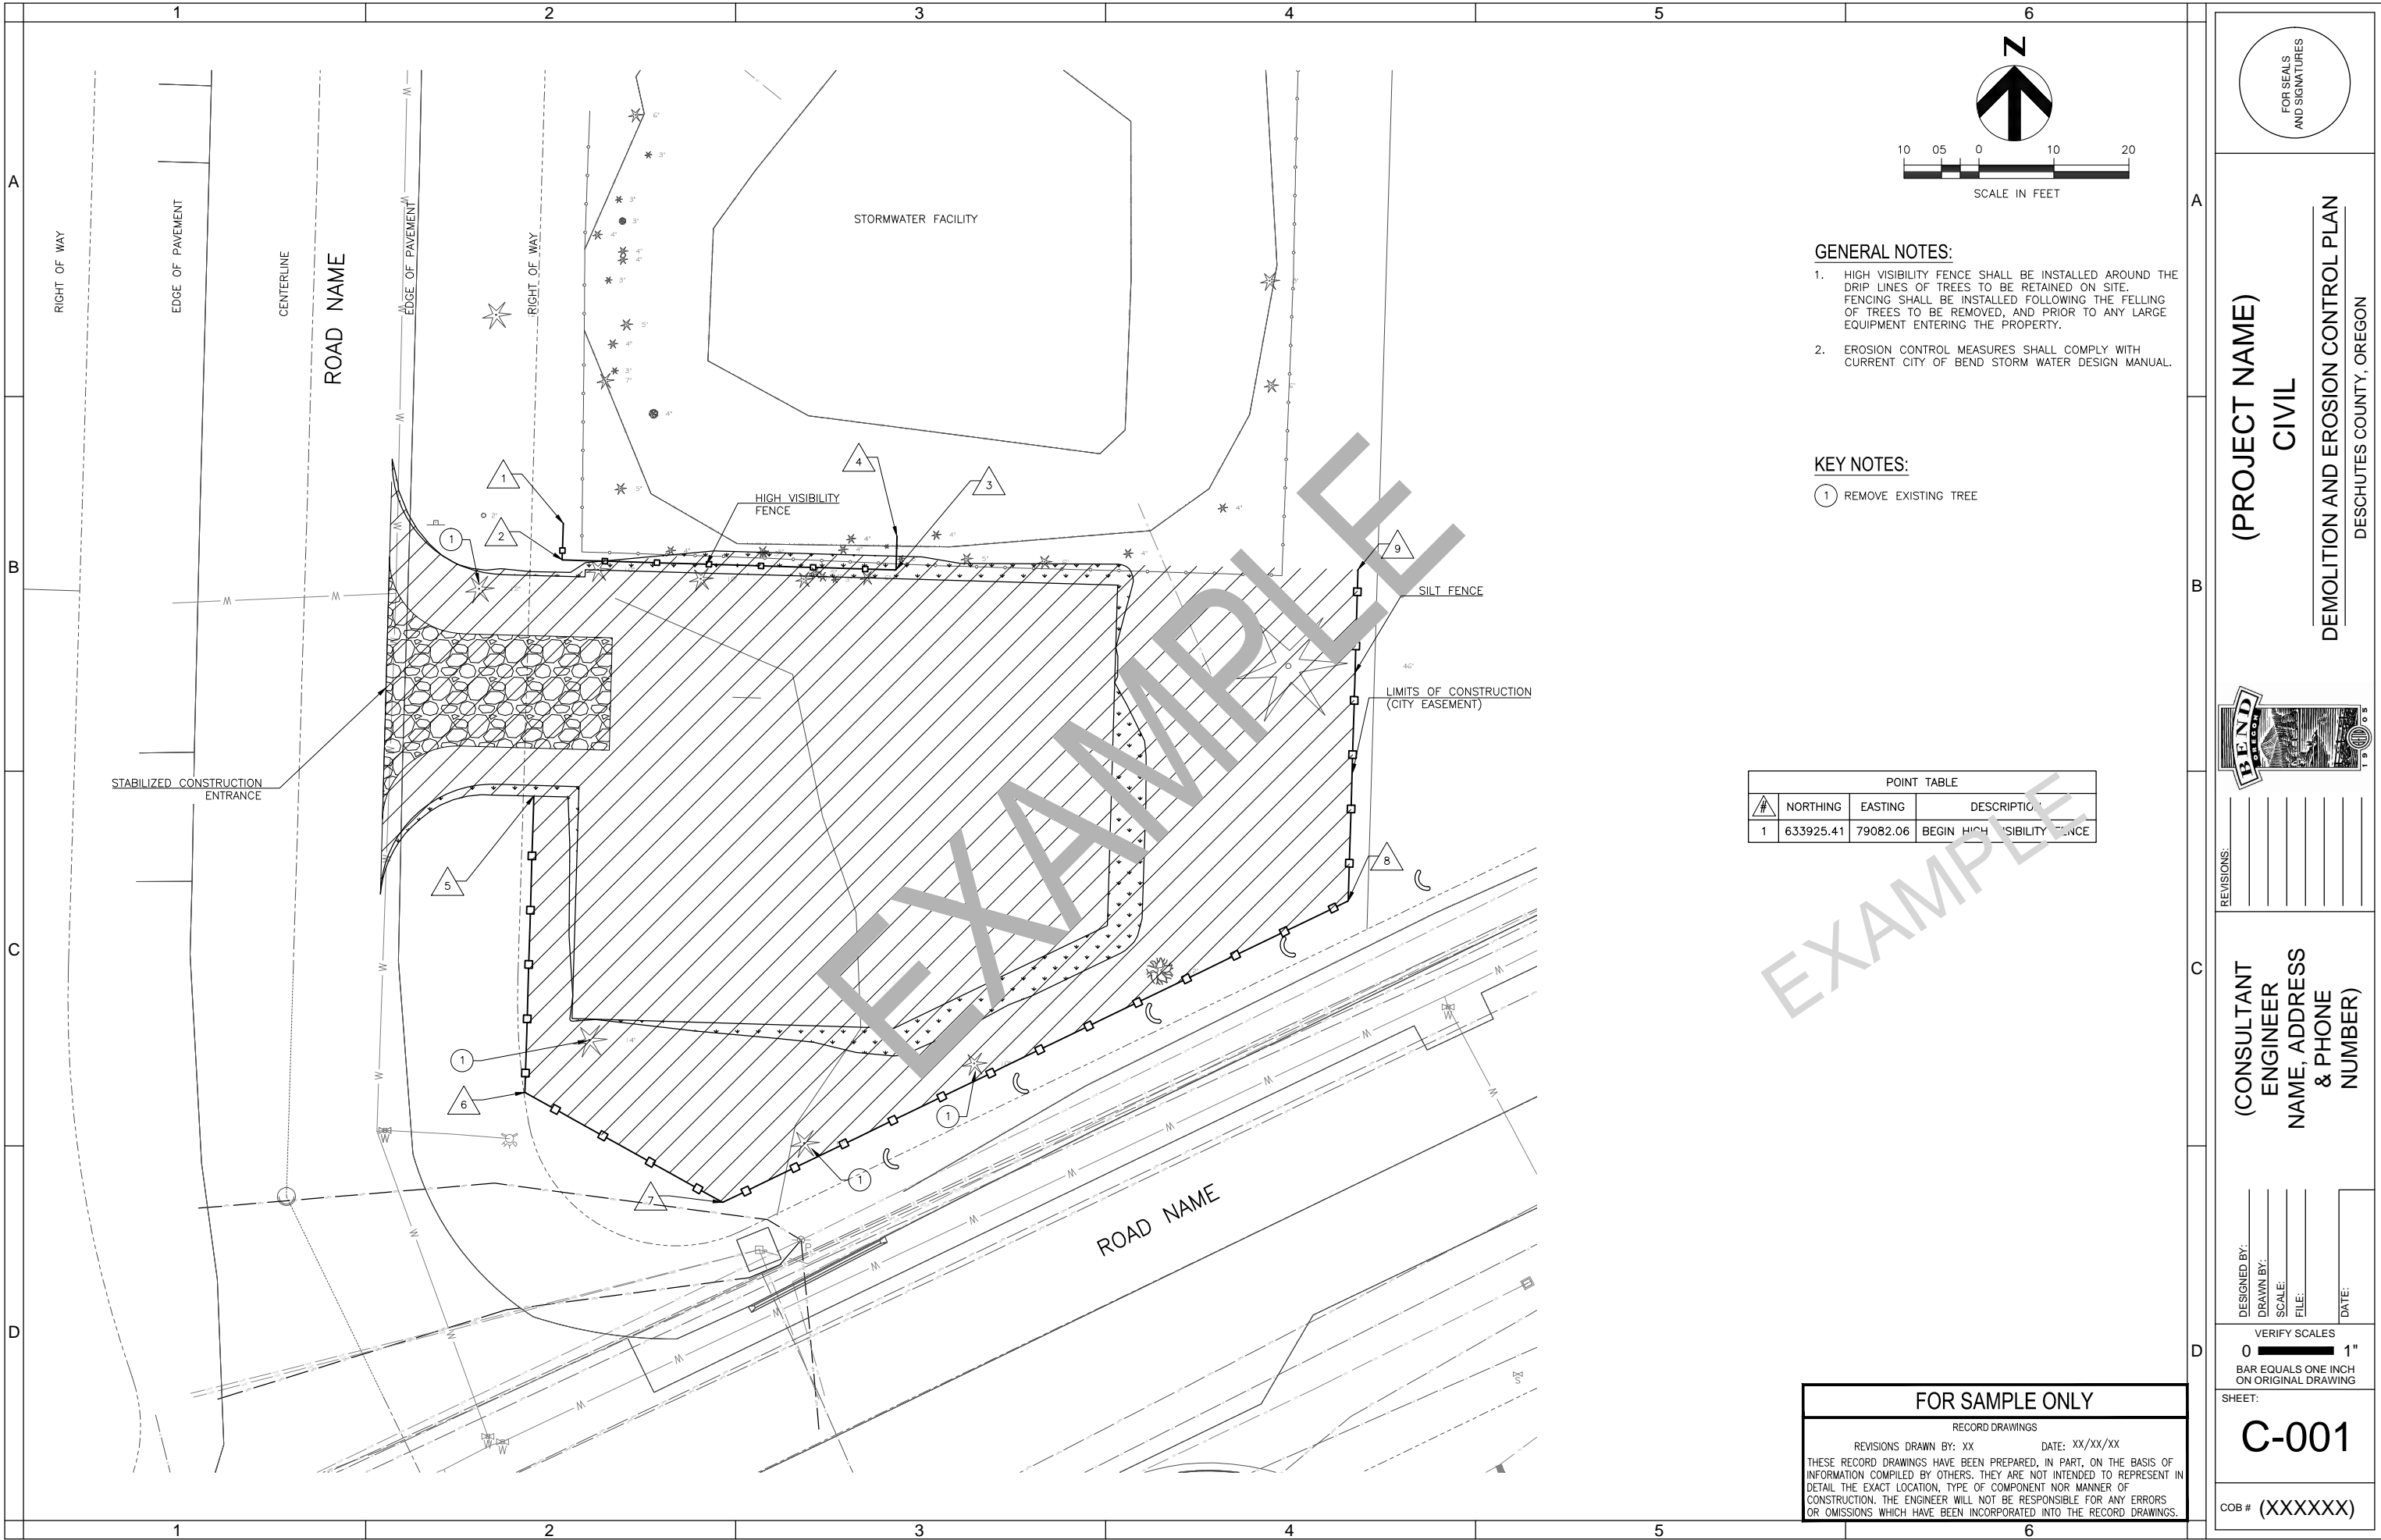

GENERAL NOTES:

- 1. HIGH VISIBILITY FENCE SHALL BE INSTALLED AROUND THE DRIP LINES OF TREES TO BE RETAINED ON SITE. FENCING SHALL BE INSTALLED FOLLOWING THE FELLING OF TREES TO BE REMOVED, AND PRIOR TO ANY LARGE EQUIPMENT ENTERING THE PROPERTY.
- 2. EROSION CONTROL MEASURES SHALL COMPLY WITH CURRENT CITY OF BEND STORM WATER DESIGN MANUAL.

KEY NOTES:

- ① REMOVE EXISTING TREE

POINT TABLE			
#	NORTHING	EASTING	DESCRIPTION
1	633925.41	79082.06	BEGIN HIGH VISIBILITY FENCE



REVISIONS:	


(CONSULTANT
ENGINEER
NAME, ADDRESS
& PHONE
NUMBER)

DESIGNED BY: _____
DRAWN BY: _____
SCALE: _____
FILE: _____
DATE: _____

VERIFY SCALES
0 1"
BAR EQUALS ONE INCH
ON ORIGINAL DRAWING

SHEET:
C-001

COB # (XXXXXX)

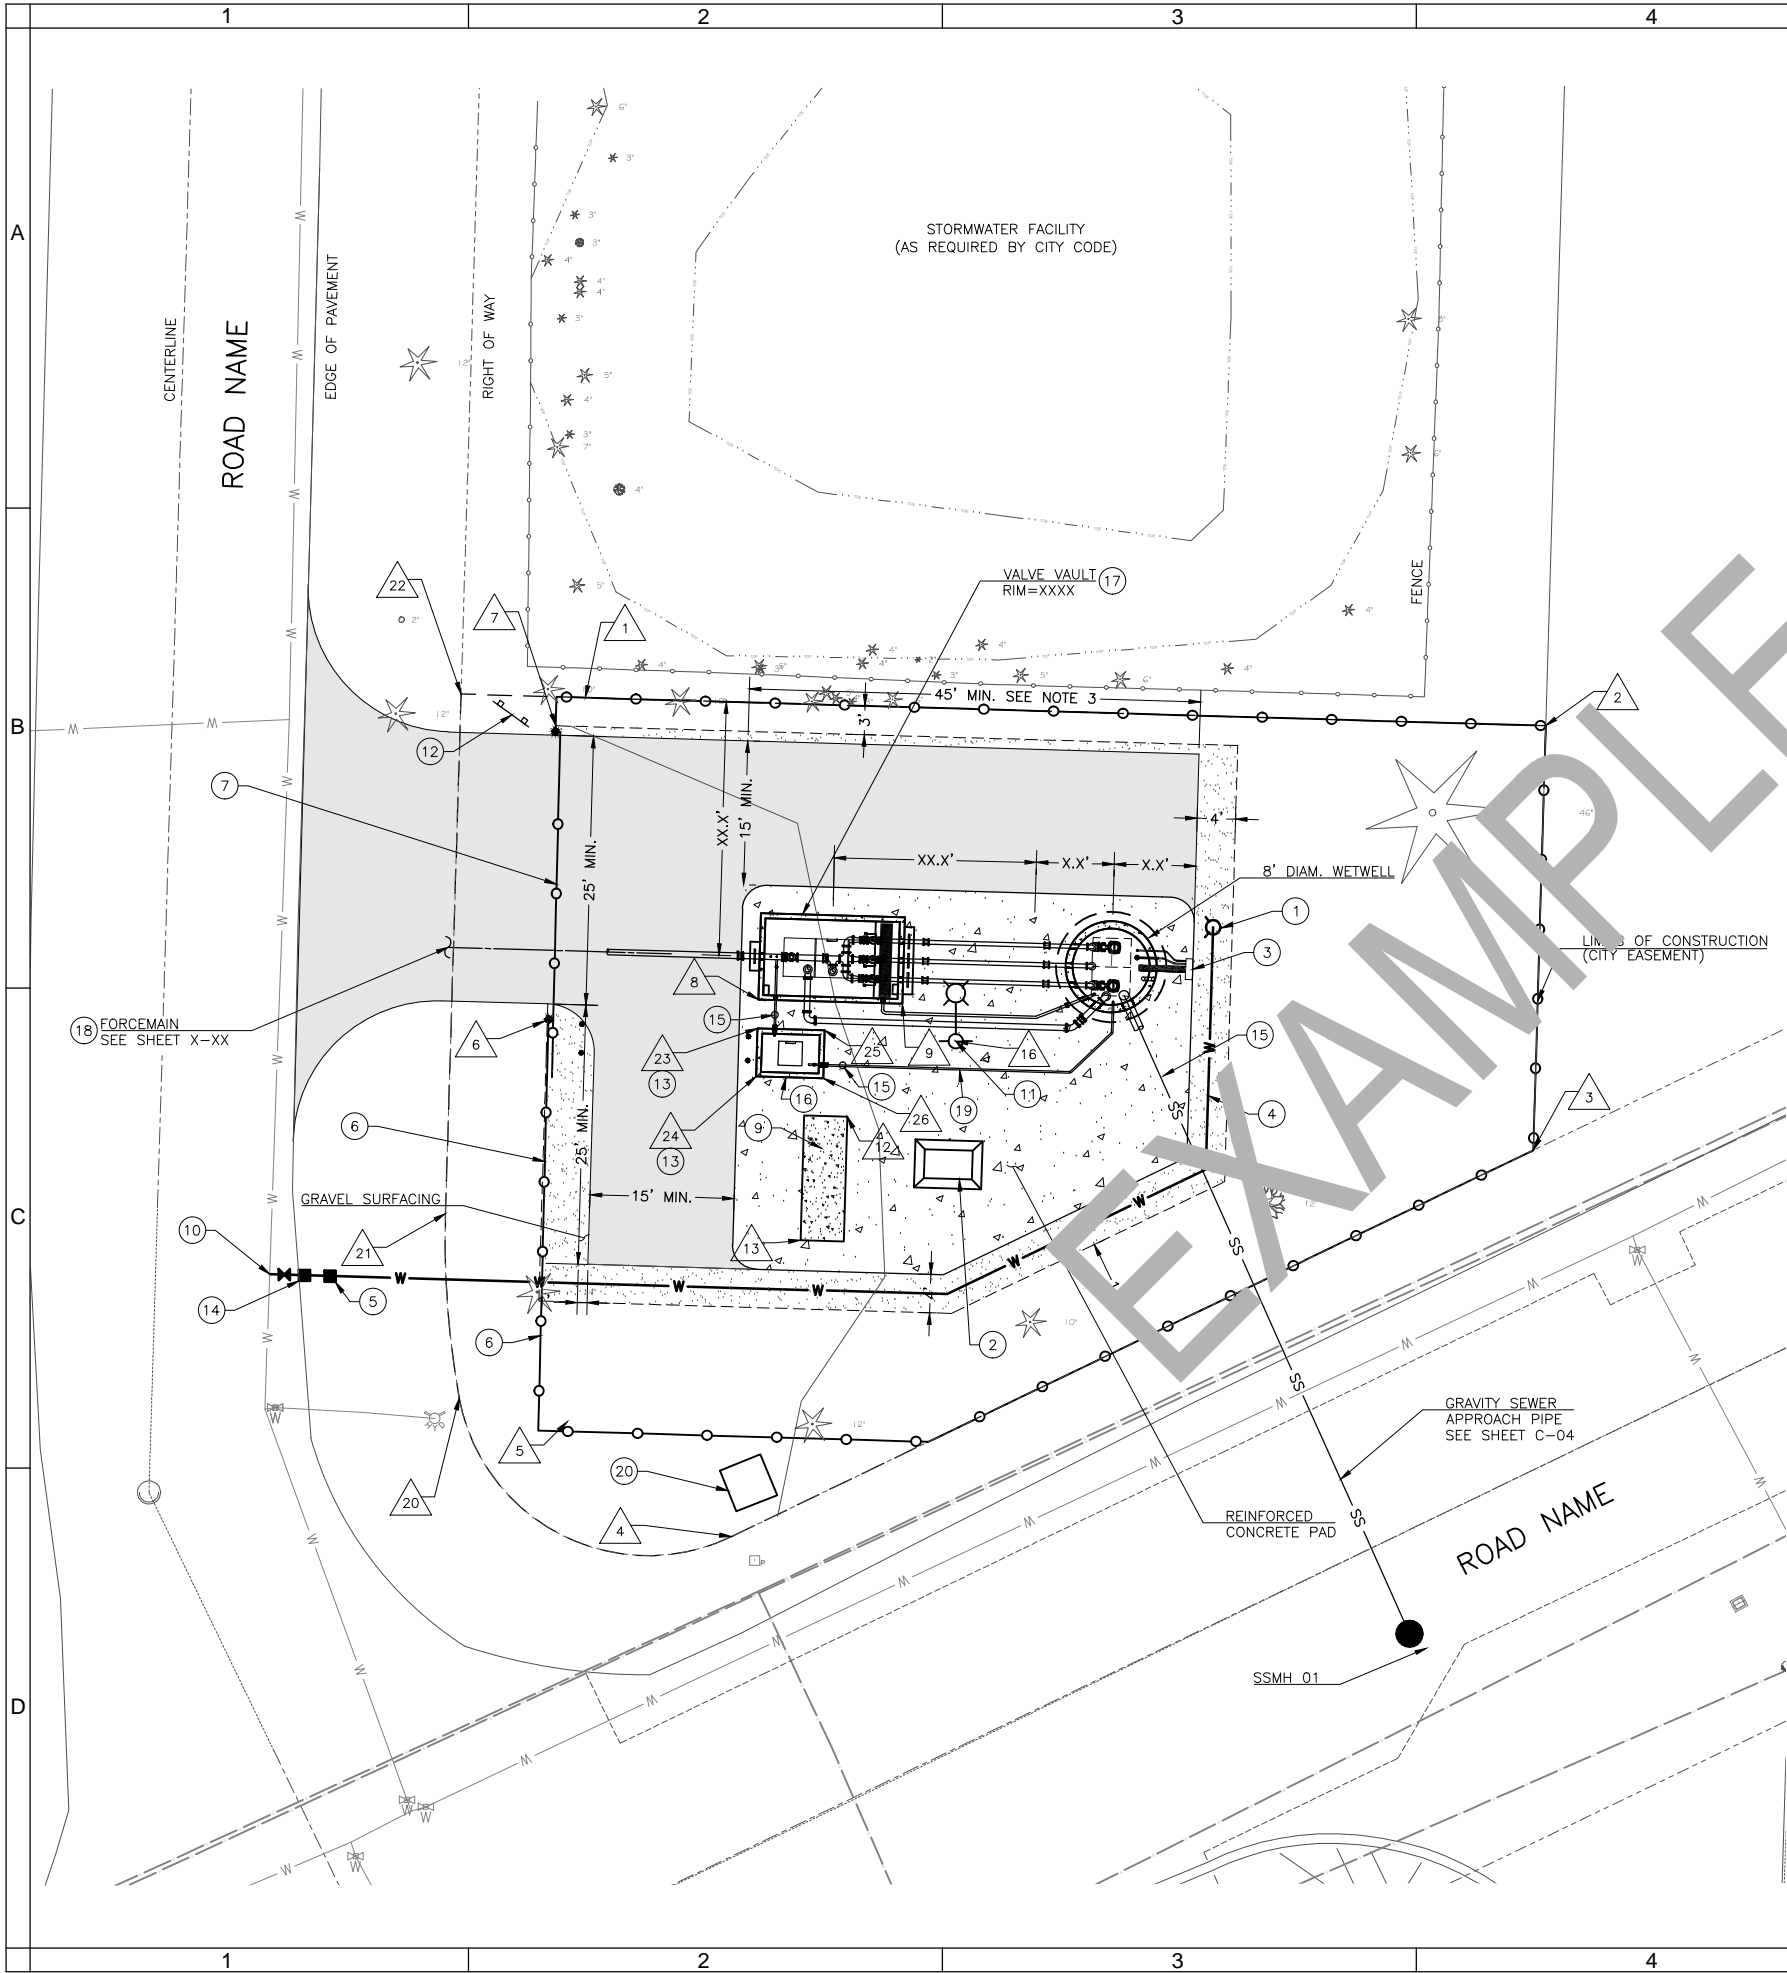

POINT TABLE		
#	NORTHING	EASTING
1	633922.15	79088.07
2	633919.22	79188.12
3	633875.01	79186.83
4	633834.76	79103.32
5	633846.73	79086.21
6	633888.55	79087.24
7	633918.54	79087.98
8	633890.69	79106.11
9	633890.25	79121.10
12	633880.50	79115.45
13	633867.51	79115.01
16	633886.36	79126.67
20	633849.21	79074.76
21	633868.41	79077.72
22	633922.13	79175.14
23	633867.51	79106.19
24	633885.19	79106.12
25	633887.77	79110.19
26	633863.07	79110.11
DESCRIPTION		
FENCE		
FENCE / EASEMENT AP		
FENCE / EASEMENT AP		
FENCE / EASEMENT PC		
FENCE		
FENCE / SLIDE GATE		
FENCE / SLIDE GATE		
VALVE VAULT		
VALVE VAULT		
GENERATOR PAD		
GENERATOR PAD		
SITE LIGHTING		
EASEMENT PCC		
EASEMENT PT		
EASEMENT AP		
BOLLARD		
BOLLARD		
ODOR CONTROL STATION		
ODOR CONTROL STATION		

- GENERAL NOTES:
- SEE CITY OF BEND STANDARD DETAIL FOR LIFT STATION AIR AND VACUUM RELEASE.
 - SEE CITY OF BEND STANDARD DETAIL FOR STANDARD VALVE BOX INSTALLATION.
 - DIMENSION SHOWN FOR CITY MAINTENANCE AND TRACTOR TRUCK ACCESS, ANY SITE VARIATION TO ACCESS MUST BE REVIEWED AND APPROVED BY THE CITY UTILITY DEPARTMENT.


- KEY NOTES:
- NON-FREEZE TYPE WASH HYDRANT.
 - CONTROL PANEL PER NFPA 820.
 - ISOLATION PEDESTAL.
 - 2" POLYETHYLENE PIPE CLASS 200.
 - REDUCED PRESSURE BACK FLOW ASSEMBLY.
 - COATED CHAIN LINK FENCE.
 - AUTOMATIC 30" SLIDE GATE, VINYL COATED.
 - NOTE NOT USED
 - GENERATOR ON CONCRETE PAD (PROVIDE STRUCTURAL DESIGN).
 - CONNECT TO EXISTING WATER MAIN.
 - LIFT STATION SITE LIGHT.
 - CITY SIGN, SEE DETAIL (8).
 - BOLLARD TYPE 1.
 - 2" WATER SERVICE WITH 2" BALL VALVE (NO METER).
 - CITY OF BEND VALVE BOX.
 - 6'-0" x 4'-0" CONTAINMENT FOR ODOR CONTROL STATION TO BE COORDINATED AS NEEDED BY CITY OF BEND UTILITY DEPARTMENT.
 - SEE VALVE VAULT DETAILS SHEET M-101.
 - ROUTE TO EXISTING FORCE MAIN.
 - 4" SCHEDULE 80 PVC.
 - POWER VAULT TO BE INSTALLED BY XXX.

FOR SAMPLE ONLY

RECORD DRAWINGS

REVISIONS DRAWN BY: XX DATE: XX/XX/XX

THESE RECORD DRAWINGS HAVE BEEN PREPARED, IN PART, ON THE BASIS OF INFORMATION COMPILED BY OTHERS. THEY ARE NOT INTENDED TO REPRESENT IN DETAIL THE EXACT LOCATION, TYPE OF COMPONENT NOR MANNER OF CONSTRUCTION. THE ENGINEER WILL NOT BE RESPONSIBLE FOR ANY ERRORS OR OMISSIONS WHICH HAVE BEEN INCORPORATED INTO THE RECORD DRAWINGS.

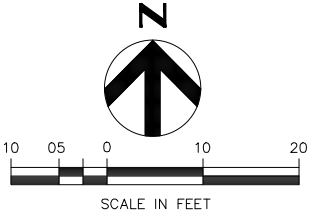

FOR SEALS AND SIGNATURES



(PROJECT NAME)
CIVIL
SITE PLAN
DESCHUTES COUNTY, OREGON

REVISIONS:


DESIGNED BY:
DRAWN BY:
SCALE:
FILE:
DATE:

VERIFY SCALES
0 1"
BAR EQUALS ONE INCH ON ORIGINAL DRAWING

SHEET:
C-002
COB # (XXXXXX)

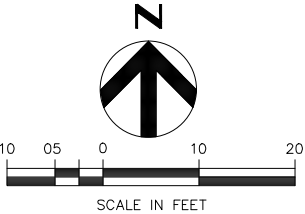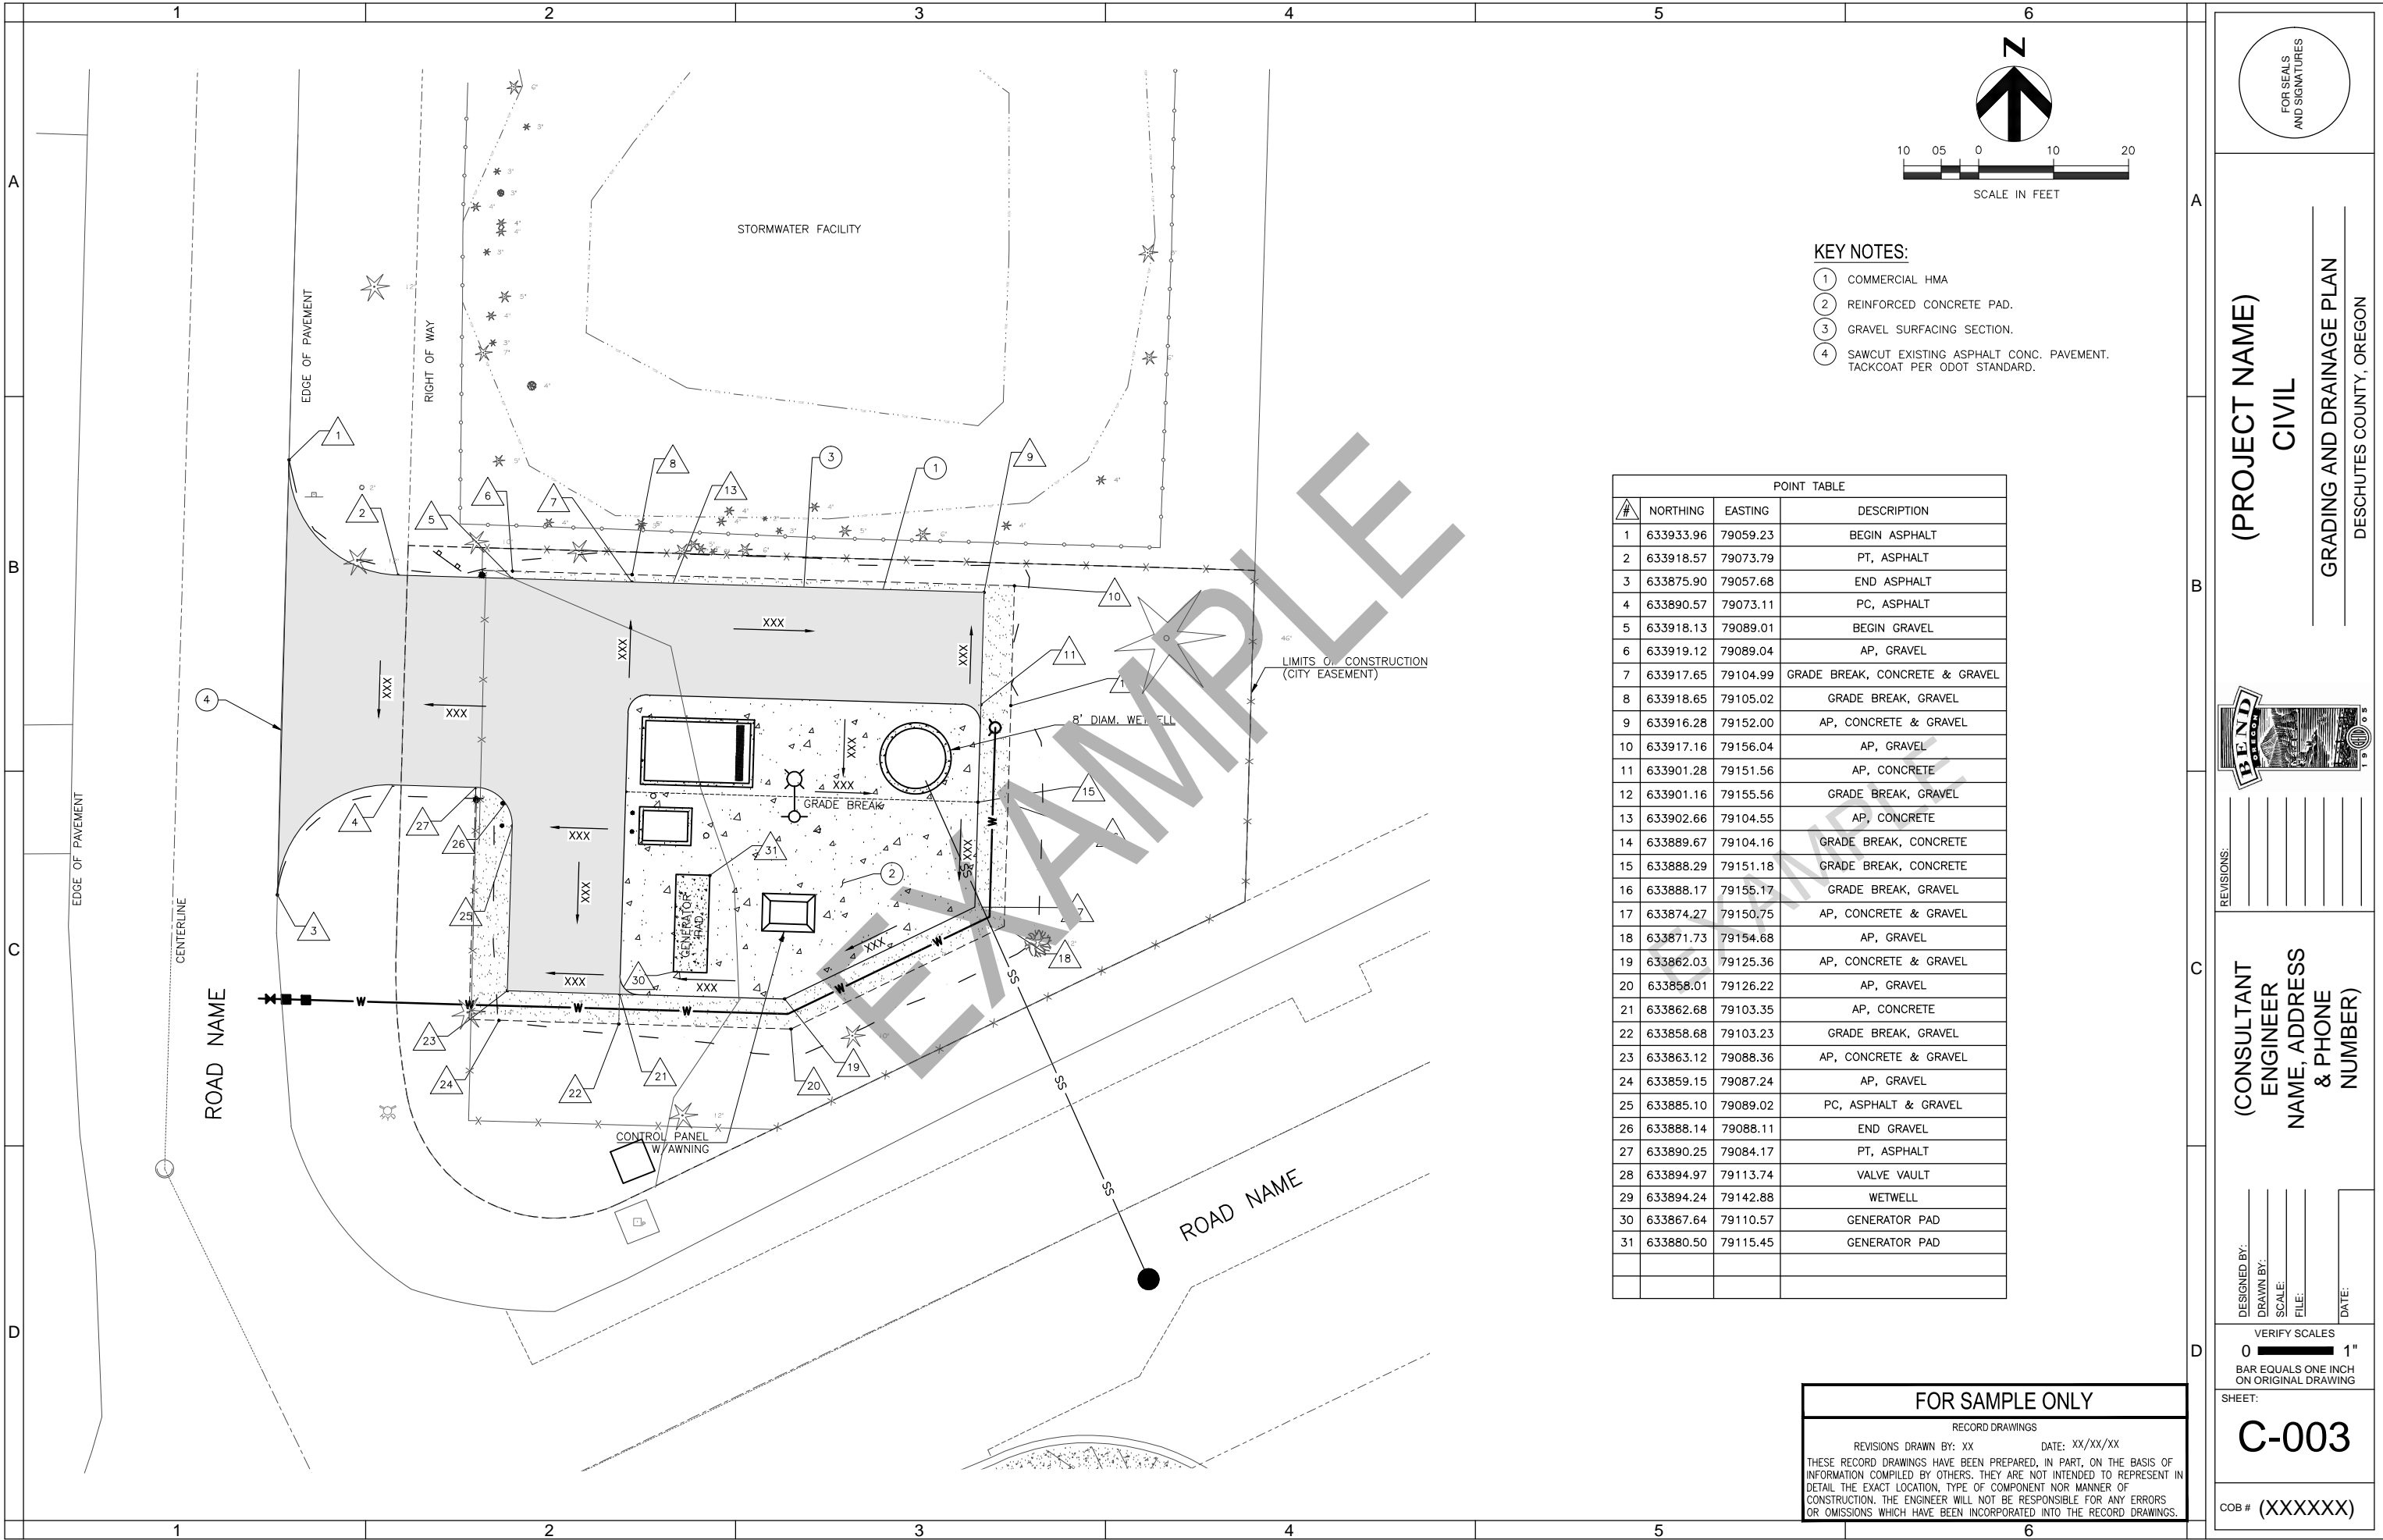

- KEY NOTES:
- 1 COMMERCIAL HMA
 - 2 REINFORCED CONCRETE PAD.
 - 3 GRAVEL SURFACING SECTION.
 - 4 SAWCUT EXISTING ASPHALT CONC. PAVEMENT. TACKCOAT PER ODOT STANDARD.

POINT TABLE			
	NORTHING	EASTING	DESCRIPTION
1	633933.96	79059.23	BEGIN ASPHALT
2	633918.57	79073.79	PT, ASPHALT
3	633875.90	79057.68	END ASPHALT
4	633890.57	79073.11	PC, ASPHALT
5	633918.13	79089.01	BEGIN GRAVEL
6	633919.12	79089.04	AP, GRAVEL
7	633917.65	79104.99	GRADE BREAK, CONCRETE & GRAVEL
8	633918.65	79105.02	GRADE BREAK, GRAVEL
9	633916.28	79152.00	AP, CONCRETE & GRAVEL
10	633917.16	79156.04	AP, GRAVEL
11	633901.28	79151.56	AP, CONCRETE
12	633901.16	79155.56	GRADE BREAK, GRAVEL
13	633902.66	79104.55	AP, CONCRETE
14	633889.67	79104.16	GRADE BREAK, CONCRETE
15	633888.29	79151.18	GRADE BREAK, CONCRETE
16	633888.17	79155.17	GRADE BREAK, GRAVEL
17	633874.27	79150.75	AP, CONCRETE & GRAVEL
18	633871.73	79154.68	AP, GRAVEL
19	633862.03	79125.36	AP, CONCRETE & GRAVEL
20	633858.01	79126.22	AP, GRAVEL
21	633862.68	79103.35	AP, CONCRETE
22	633858.68	79103.23	GRADE BREAK, GRAVEL
23	633863.12	79088.36	AP, CONCRETE & GRAVEL
24	633859.15	79087.24	AP, GRAVEL
25	633885.10	79089.02	PC, ASPHALT & GRAVEL
26	633888.14	79088.11	END GRAVEL
27	633890.25	79084.17	PT, ASPHALT
28	633894.97	79113.74	VALVE VAULT
29	633894.24	79142.88	WETWELL
30	633867.64	79110.57	GENERATOR PAD
31	633880.50	79115.45	GENERATOR PAD

FOR SAMPLE ONLY

RECORD DRAWINGS

REVISIONS DRAWN BY: XX DATE: XX/XX/XX

THESE RECORD DRAWINGS HAVE BEEN PREPARED, IN PART, ON THE BASIS OF INFORMATION COMPILED BY OTHERS. THEY ARE NOT INTENDED TO REPRESENT IN DETAIL THE EXACT LOCATION, TYPE OF COMPONENT NOR MANNER OF CONSTRUCTION. THE ENGINEER WILL NOT BE RESPONSIBLE FOR ANY ERRORS OR OMISSIONS WHICH HAVE BEEN INCORPORATED INTO THE RECORD DRAWINGS.

FOR SEALS AND SIGNATURES

(PROJECT NAME)
CIVIL
GRADING AND DRAINAGE PLAN
DESCHUTES COUNTY, OREGON


REVISIONS:


DESIGNED BY: _____
DRAWN BY: _____
SCALE: _____
FILE: _____
DATE: _____


VERIFY SCALES
0 1"
BAR EQUALS ONE INCH ON ORIGINAL DRAWING

SHEET:
C-003

COB # (XXXXXXX)

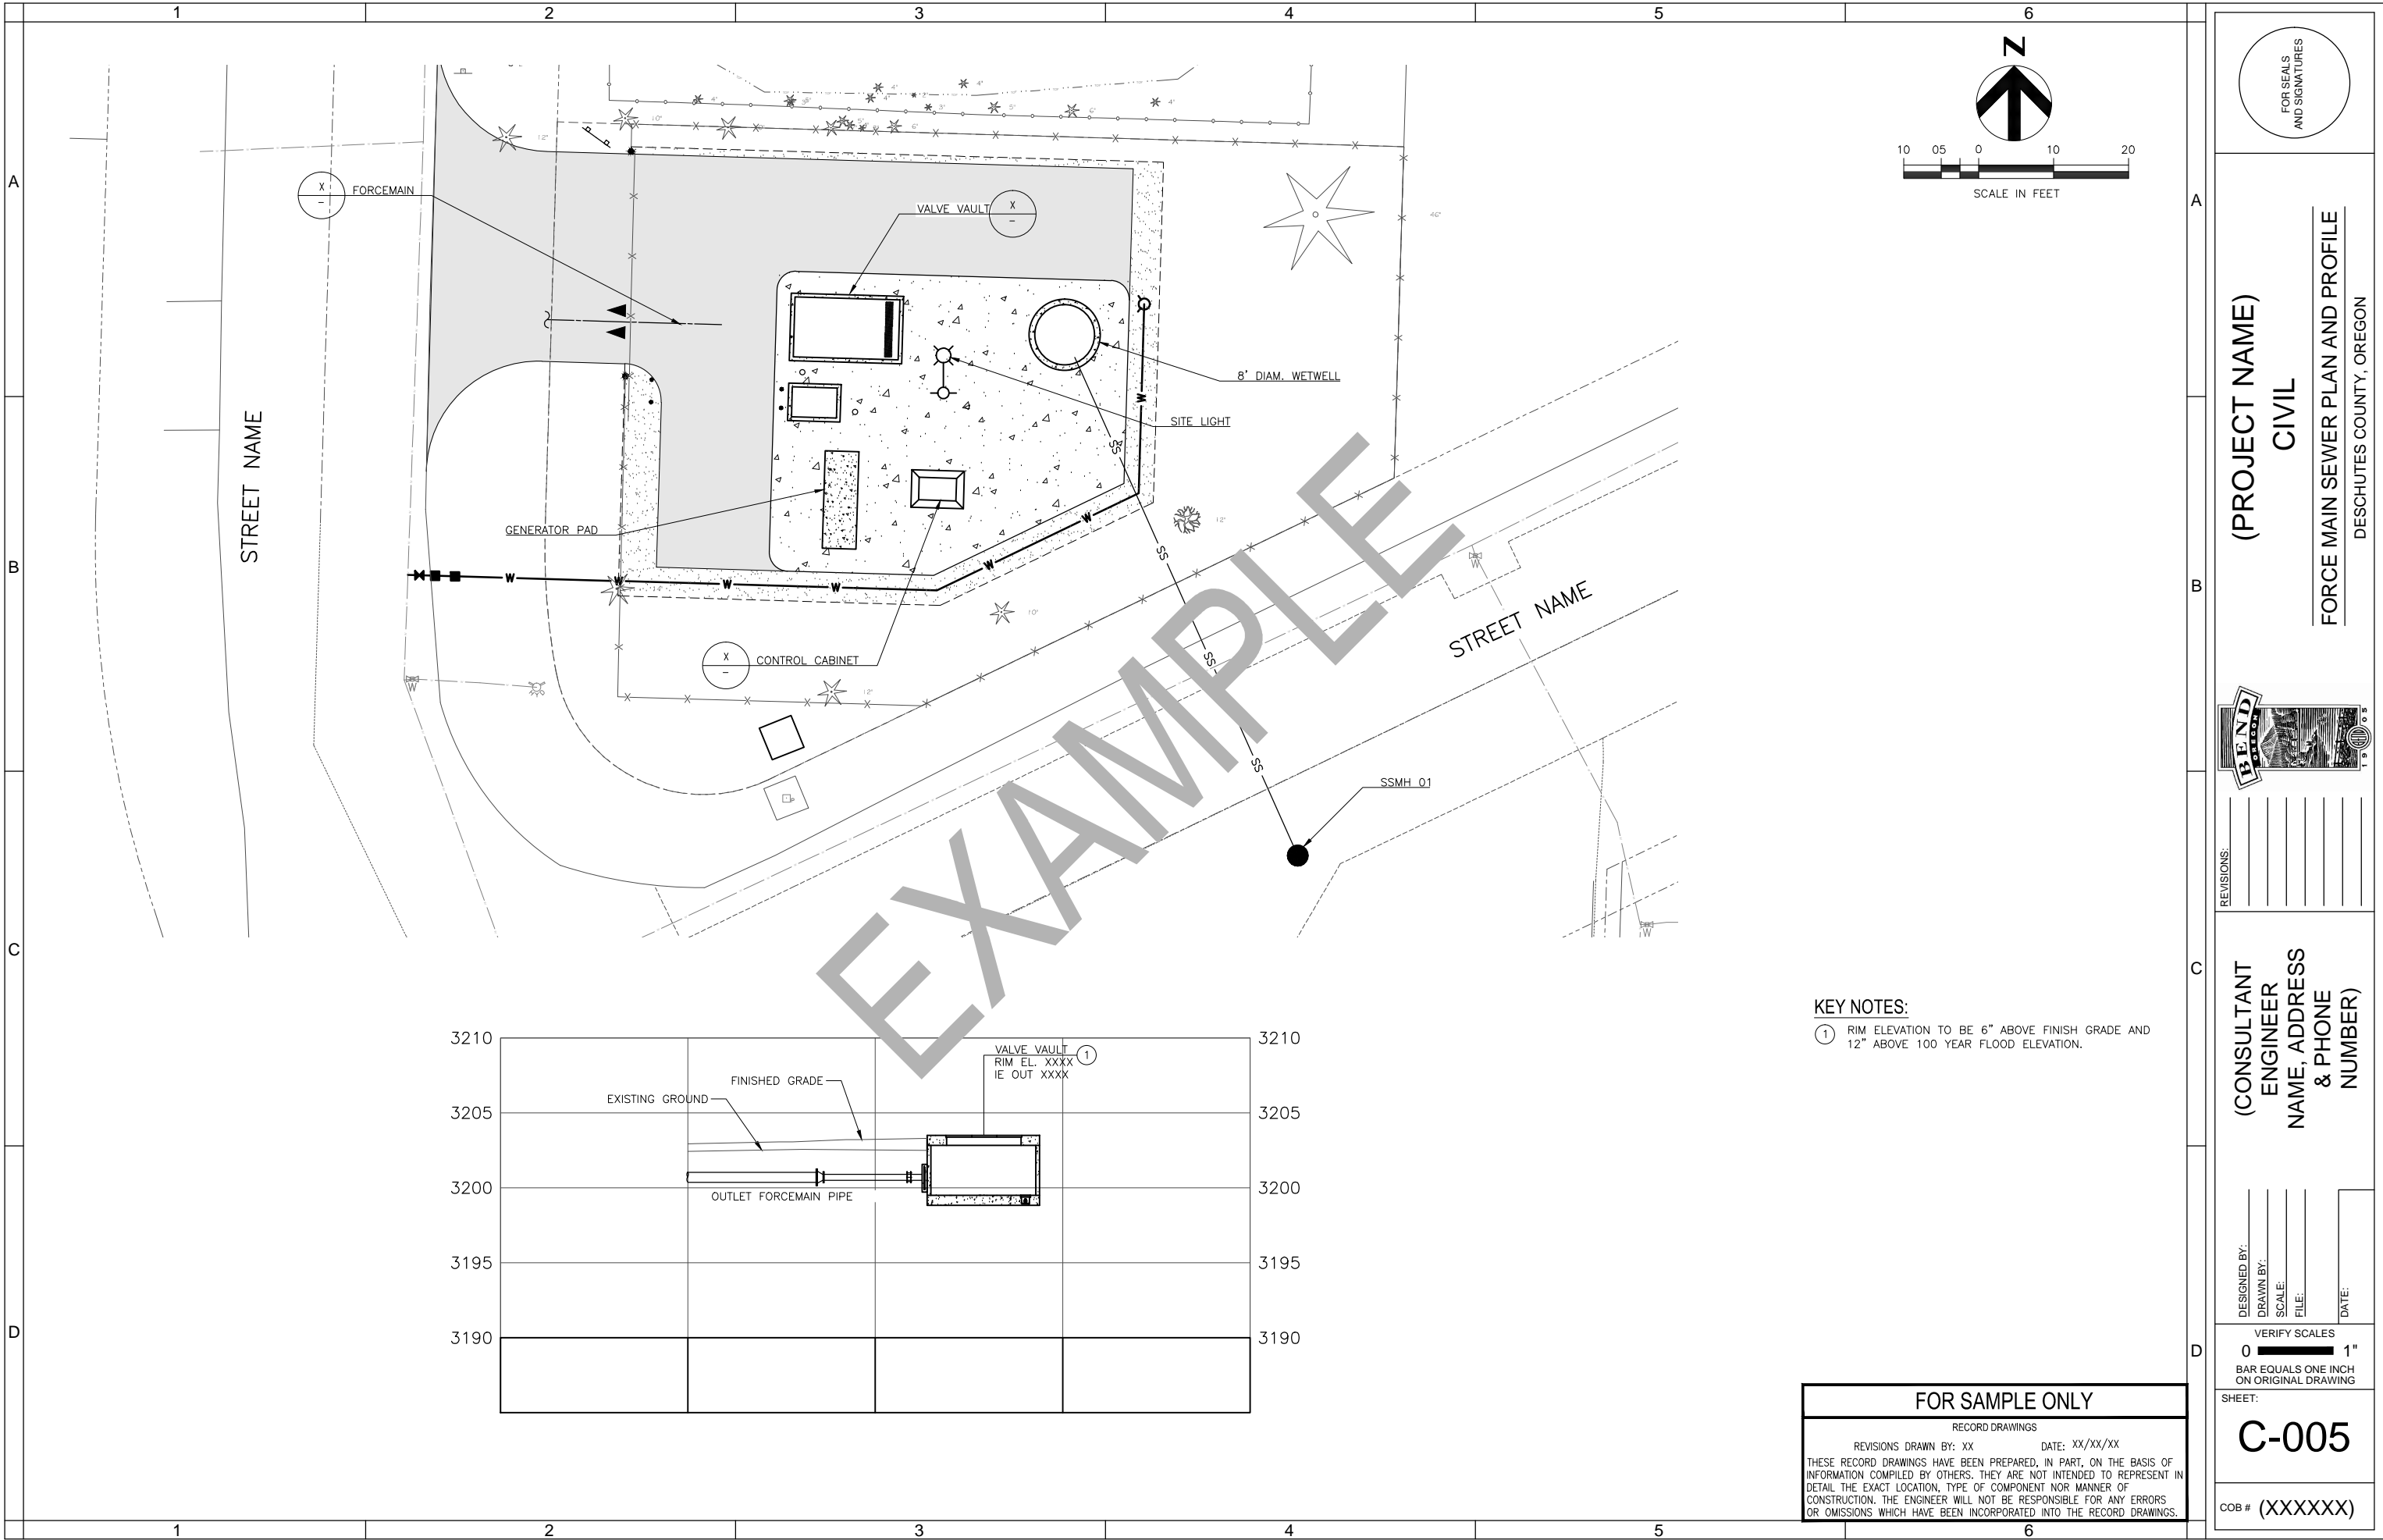

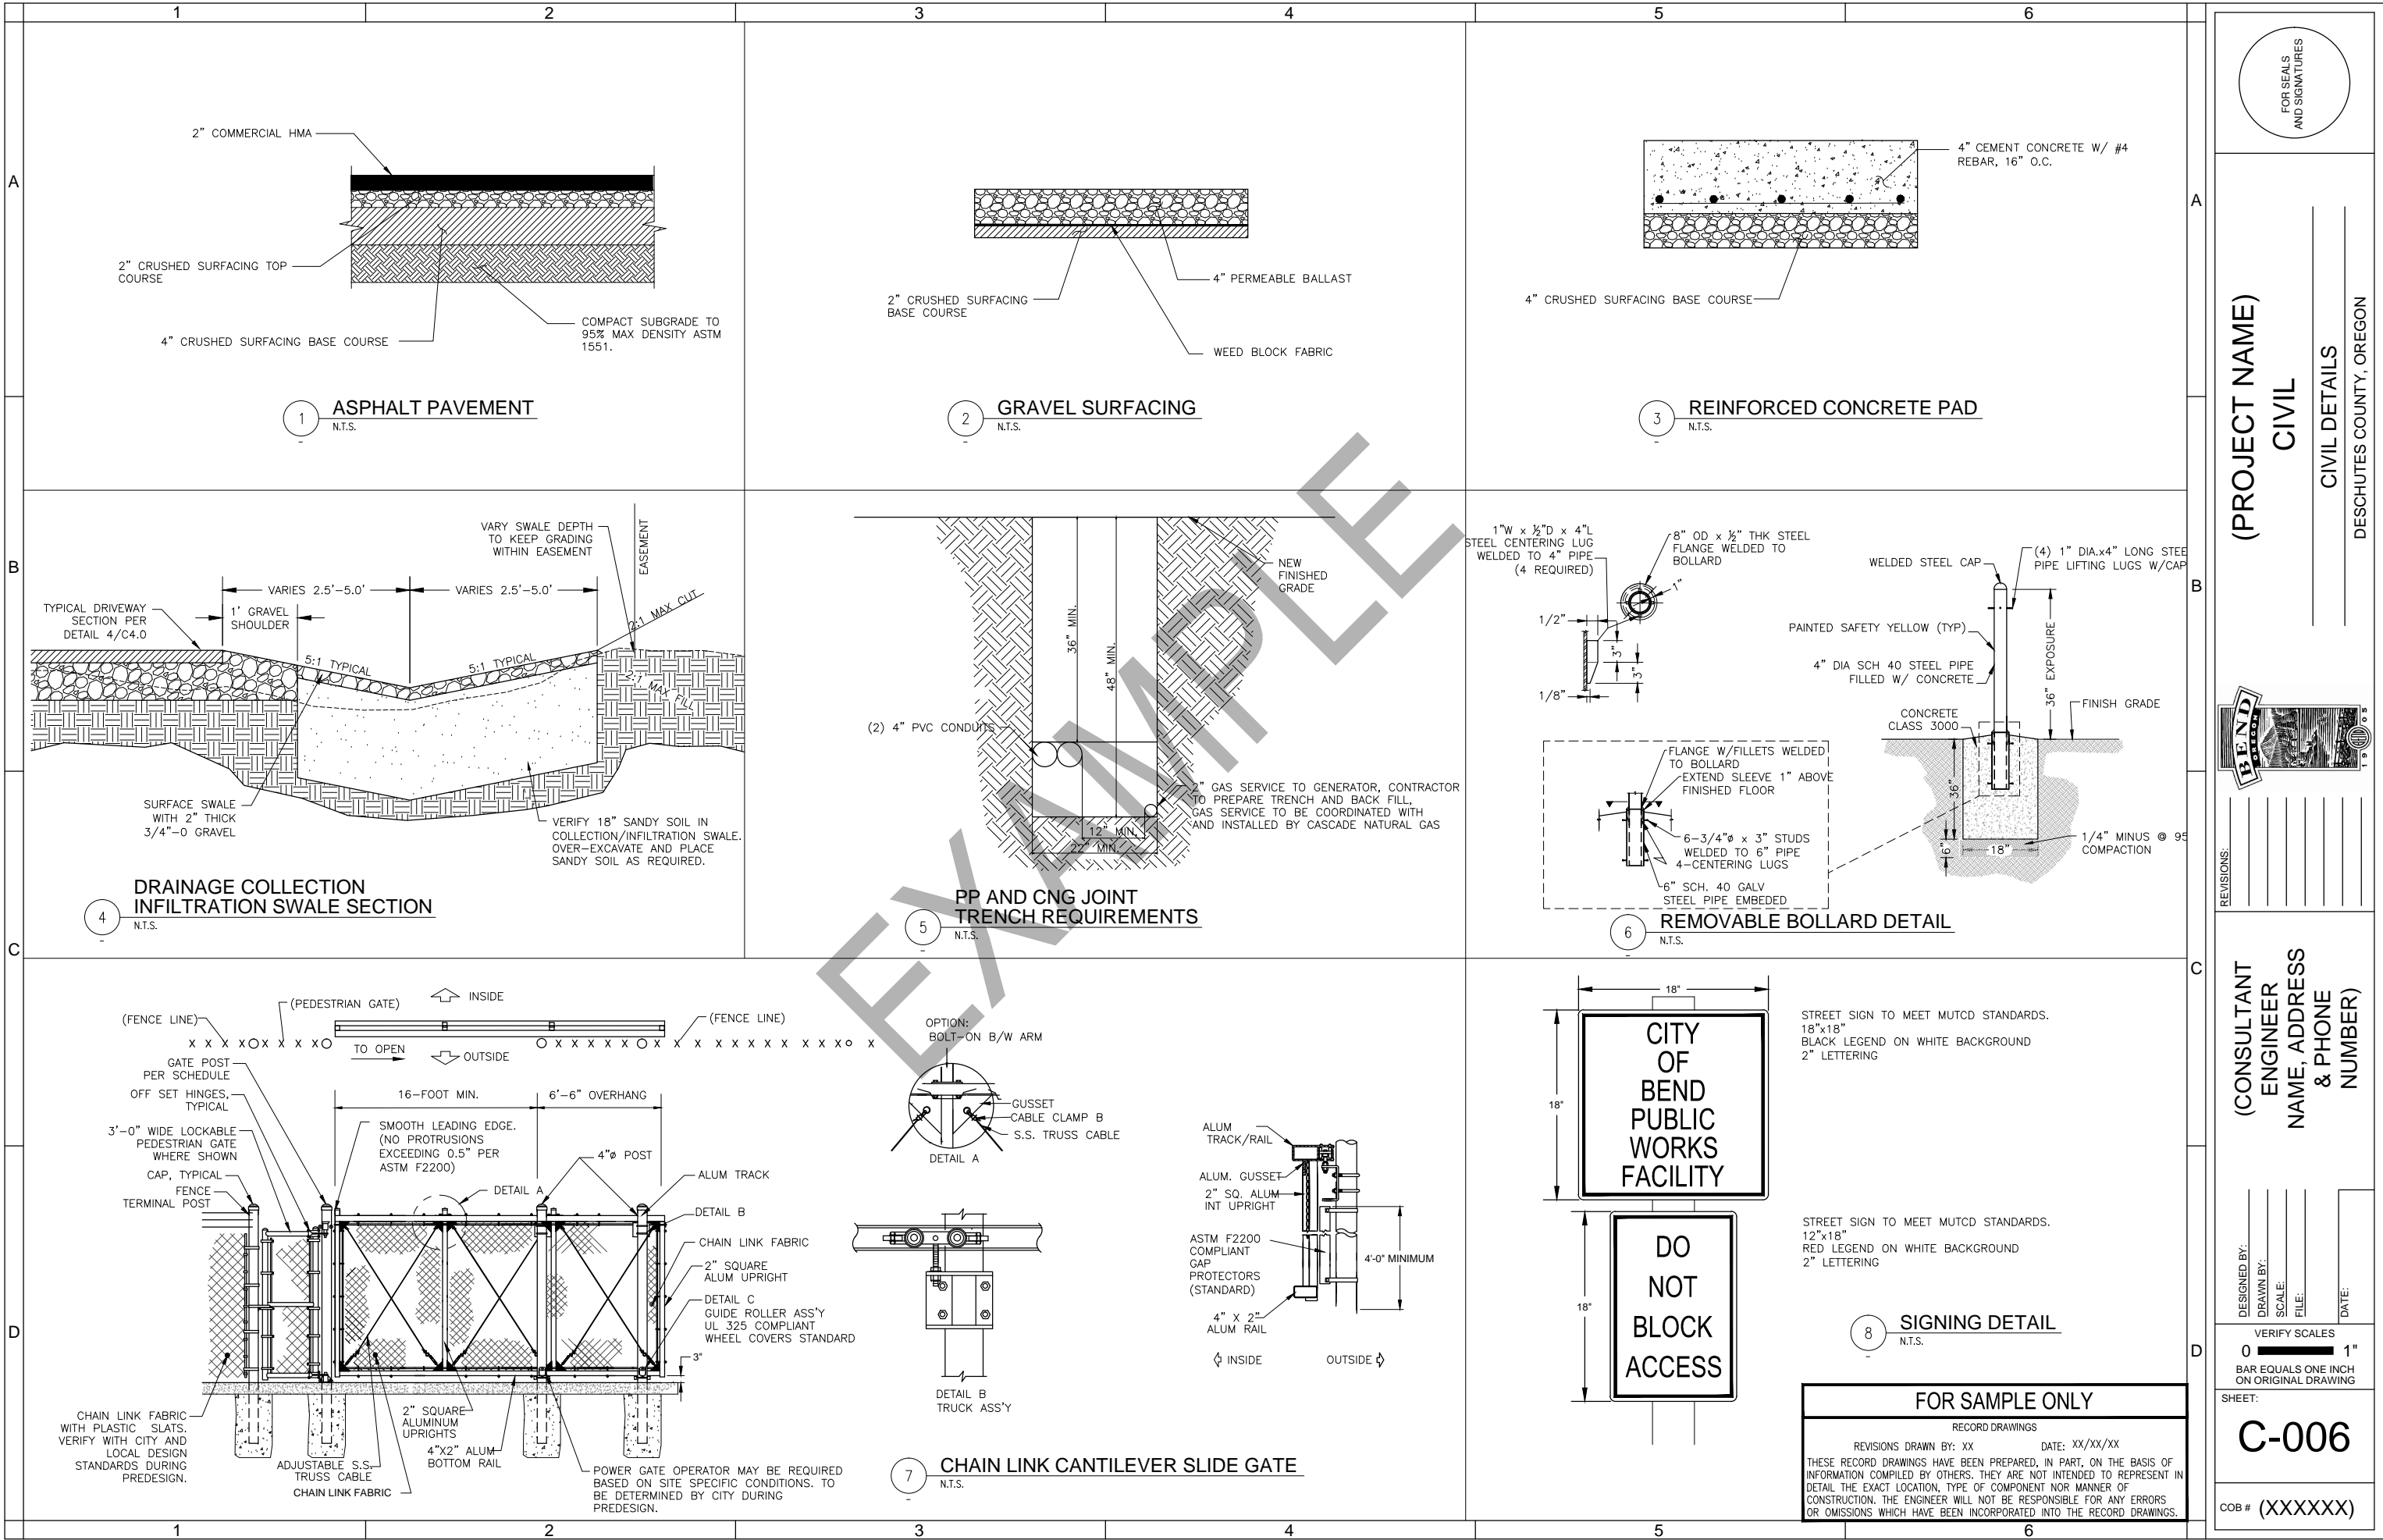

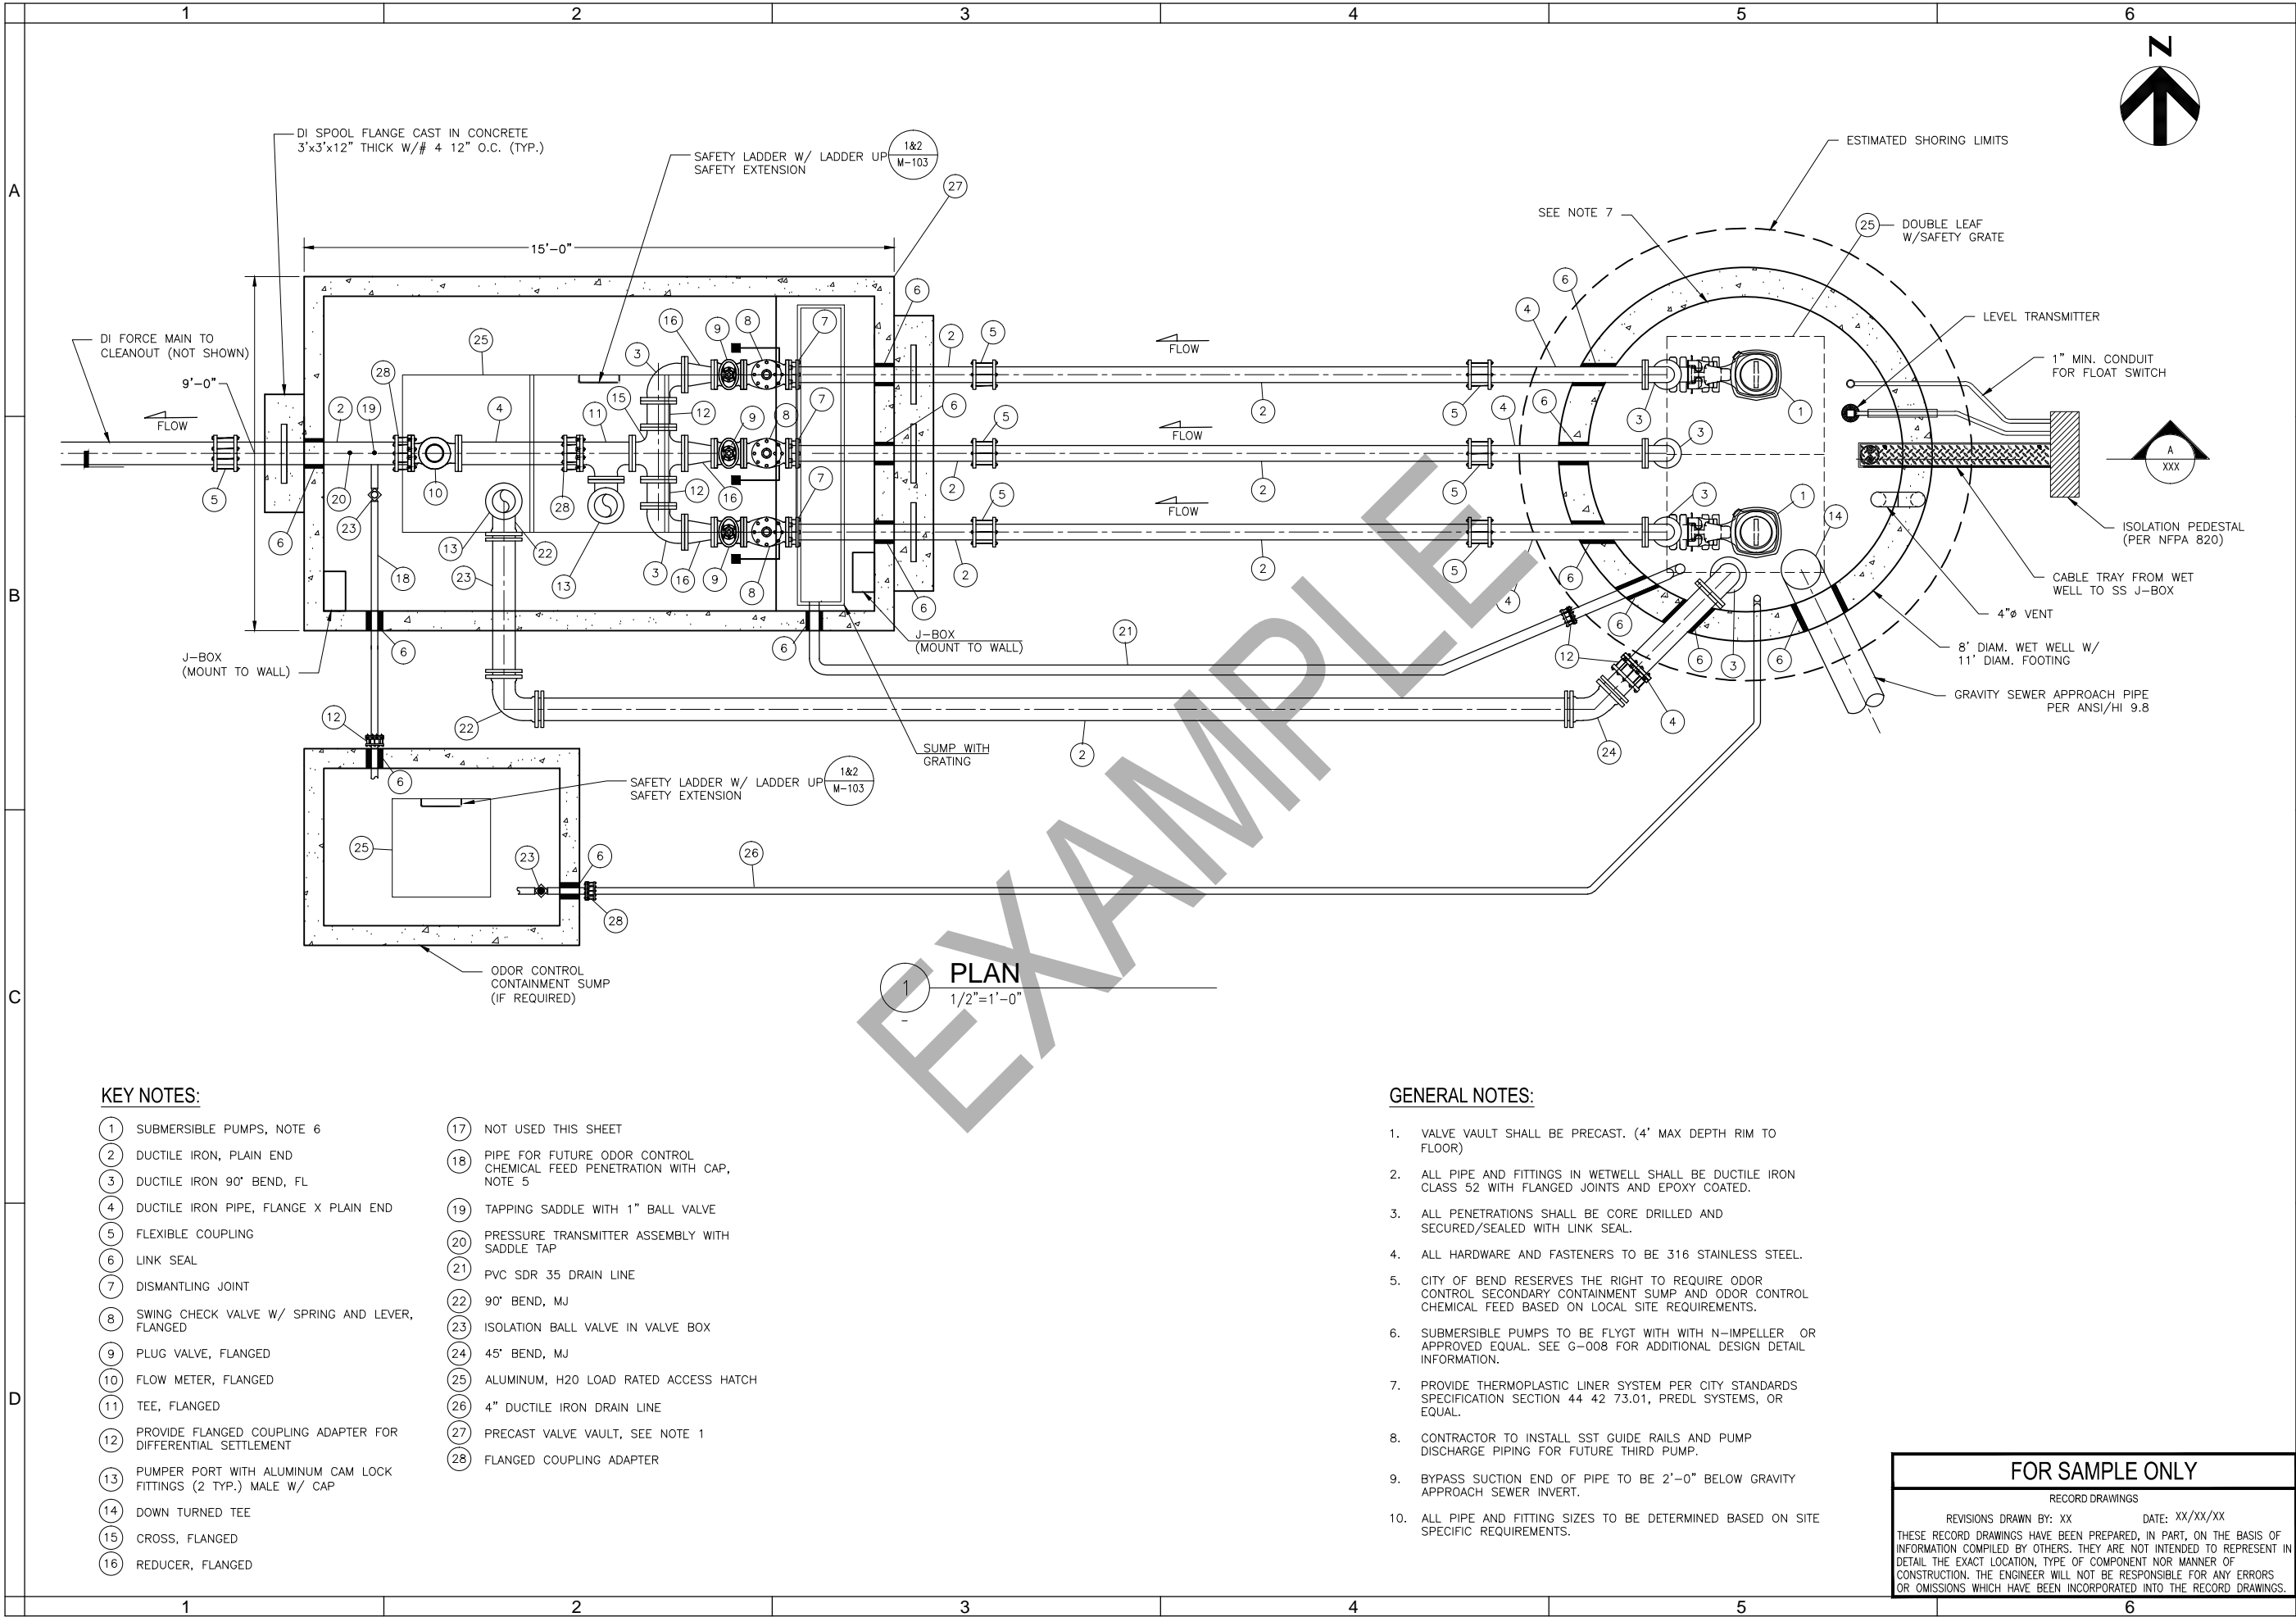

KEY NOTES:

- | | |
|---|--|
| 1 SUBMERSIBLE PUMPS, NOTE 6 | 17 NOT USED THIS SHEET |
| 2 DUCTILE IRON, PLAIN END | 18 PIPE FOR FUTURE ODOR CONTROL CHEMICAL FEED PENETRATION WITH CAP, NOTE 5 |
| 3 DUCTILE IRON 90° BEND, FL | 19 TAPPING SADDLE WITH 1" BALL VALVE |
| 4 DUCTILE IRON PIPE, FLANGE X PLAIN END | 20 PRESSURE TRANSMITTER ASSEMBLY WITH SADDLE TAP |
| 5 FLEXIBLE COUPLING | 21 PVC SDR 35 DRAIN LINE |
| 6 LINK SEAL | 22 90° BEND, MJ |
| 7 DISMANTLING JOINT | 23 ISOLATION BALL VALVE IN VALVE BOX |
| 8 SWING CHECK VALVE W/ SPRING AND LEVER, FLANGED | 24 45° BEND, MJ |
| 9 PLUG VALVE, FLANGED | 25 ALUMINUM, H2O LOAD RATED ACCESS HATCH |
| 10 FLOW METER, FLANGED | 26 4" DUCTILE IRON DRAIN LINE |
| 11 TEE, FLANGED | 27 PRECAST VALVE VAULT, SEE NOTE 1 |
| 12 PROVIDE FLANGED COUPLING ADAPTER FOR DIFFERENTIAL SETTLEMENT | 28 FLANGED COUPLING ADAPTER |
| 13 PUMPER PORT WITH ALUMINUM CAM LOCK FITTINGS (2 TYP.) MALE W/ CAP | |
| 14 DOWN TURNED TEE | |
| 15 CROSS, FLANGED | |
| 16 REDUCER, FLANGED | |

GENERAL NOTES:

- VALVE VAULT SHALL BE PRECAST. (4' MAX DEPTH RIM TO FLOOR)
- ALL PIPE AND FITTINGS IN WETWELL SHALL BE DUCTILE IRON CLASS 52 WITH FLANGED JOINTS AND EPOXY COATED.
- ALL PENETRATIONS SHALL BE CORE DRILLED AND SECURED/SEALED WITH LINK SEAL.
- ALL HARDWARE AND FASTENERS TO BE 316 STAINLESS STEEL.
- CITY OF BEND RESERVES THE RIGHT TO REQUIRE ODOR CONTROL SECONDARY CONTAINMENT SUMP AND ODOR CONTROL CHEMICAL FEED BASED ON LOCAL SITE REQUIREMENTS.
- SUBMERSIBLE PUMPS TO BE FLYGT WITH WITH N-IMPELLER OR APPROVED EQUAL. SEE G-008 FOR ADDITIONAL DESIGN DETAIL INFORMATION.
- PROVIDE THERMOPLASTIC LINER SYSTEM PER CITY STANDARDS SPECIFICATION SECTION 44 42 73.01, PREDL SYSTEMS, OR EQUAL.
- CONTRACTOR TO INSTALL SST GUIDE RAILS AND PUMP DISCHARGE PIPING FOR FUTURE THIRD PUMP.
- BYPASS SUCTION END OF PIPE TO BE 2'-0" BELOW GRAVITY APPROACH SEWER INVERT.
- ALL PIPE AND FITTING SIZES TO BE DETERMINED BASED ON SITE SPECIFIC REQUIREMENTS.

FOR SAMPLE ONLY

RECORD DRAWINGS
REVISIONS DRAWN BY: XX DATE: XX/XX/XX
THESE RECORD DRAWINGS HAVE BEEN PREPARED, IN PART, ON THE BASIS OF INFORMATION COMPILED BY OTHERS. THEY ARE NOT INTENDED TO REPRESENT IN DETAIL THE EXACT LOCATION, TYPE OF COMPONENT NOR MANNER OF CONSTRUCTION. THE ENGINEER WILL NOT BE RESPONSIBLE FOR ANY ERRORS OR OMISSIONS WHICH HAVE BEEN INCORPORATED INTO THE RECORD DRAWINGS.

FOR SEALS AND SIGNATURES

(PROJECT NAME)
MECHANICAL
LIFT STATION MECHANICAL PLAN
DESCHUTES COUNTY, OREGON



REVISIONS:


(CONSULTANT ENGINEER NAME, ADDRESS & PHONE NUMBER)

DESIGNED BY: _____
DRAWN BY: _____
SCALE: _____
FILE: _____
DATE: _____

VERIFY SCALES
0 1"
BAR EQUALS ONE INCH ON ORIGINAL DRAWING

SHEET: M-101

COB # (XXXXXX)

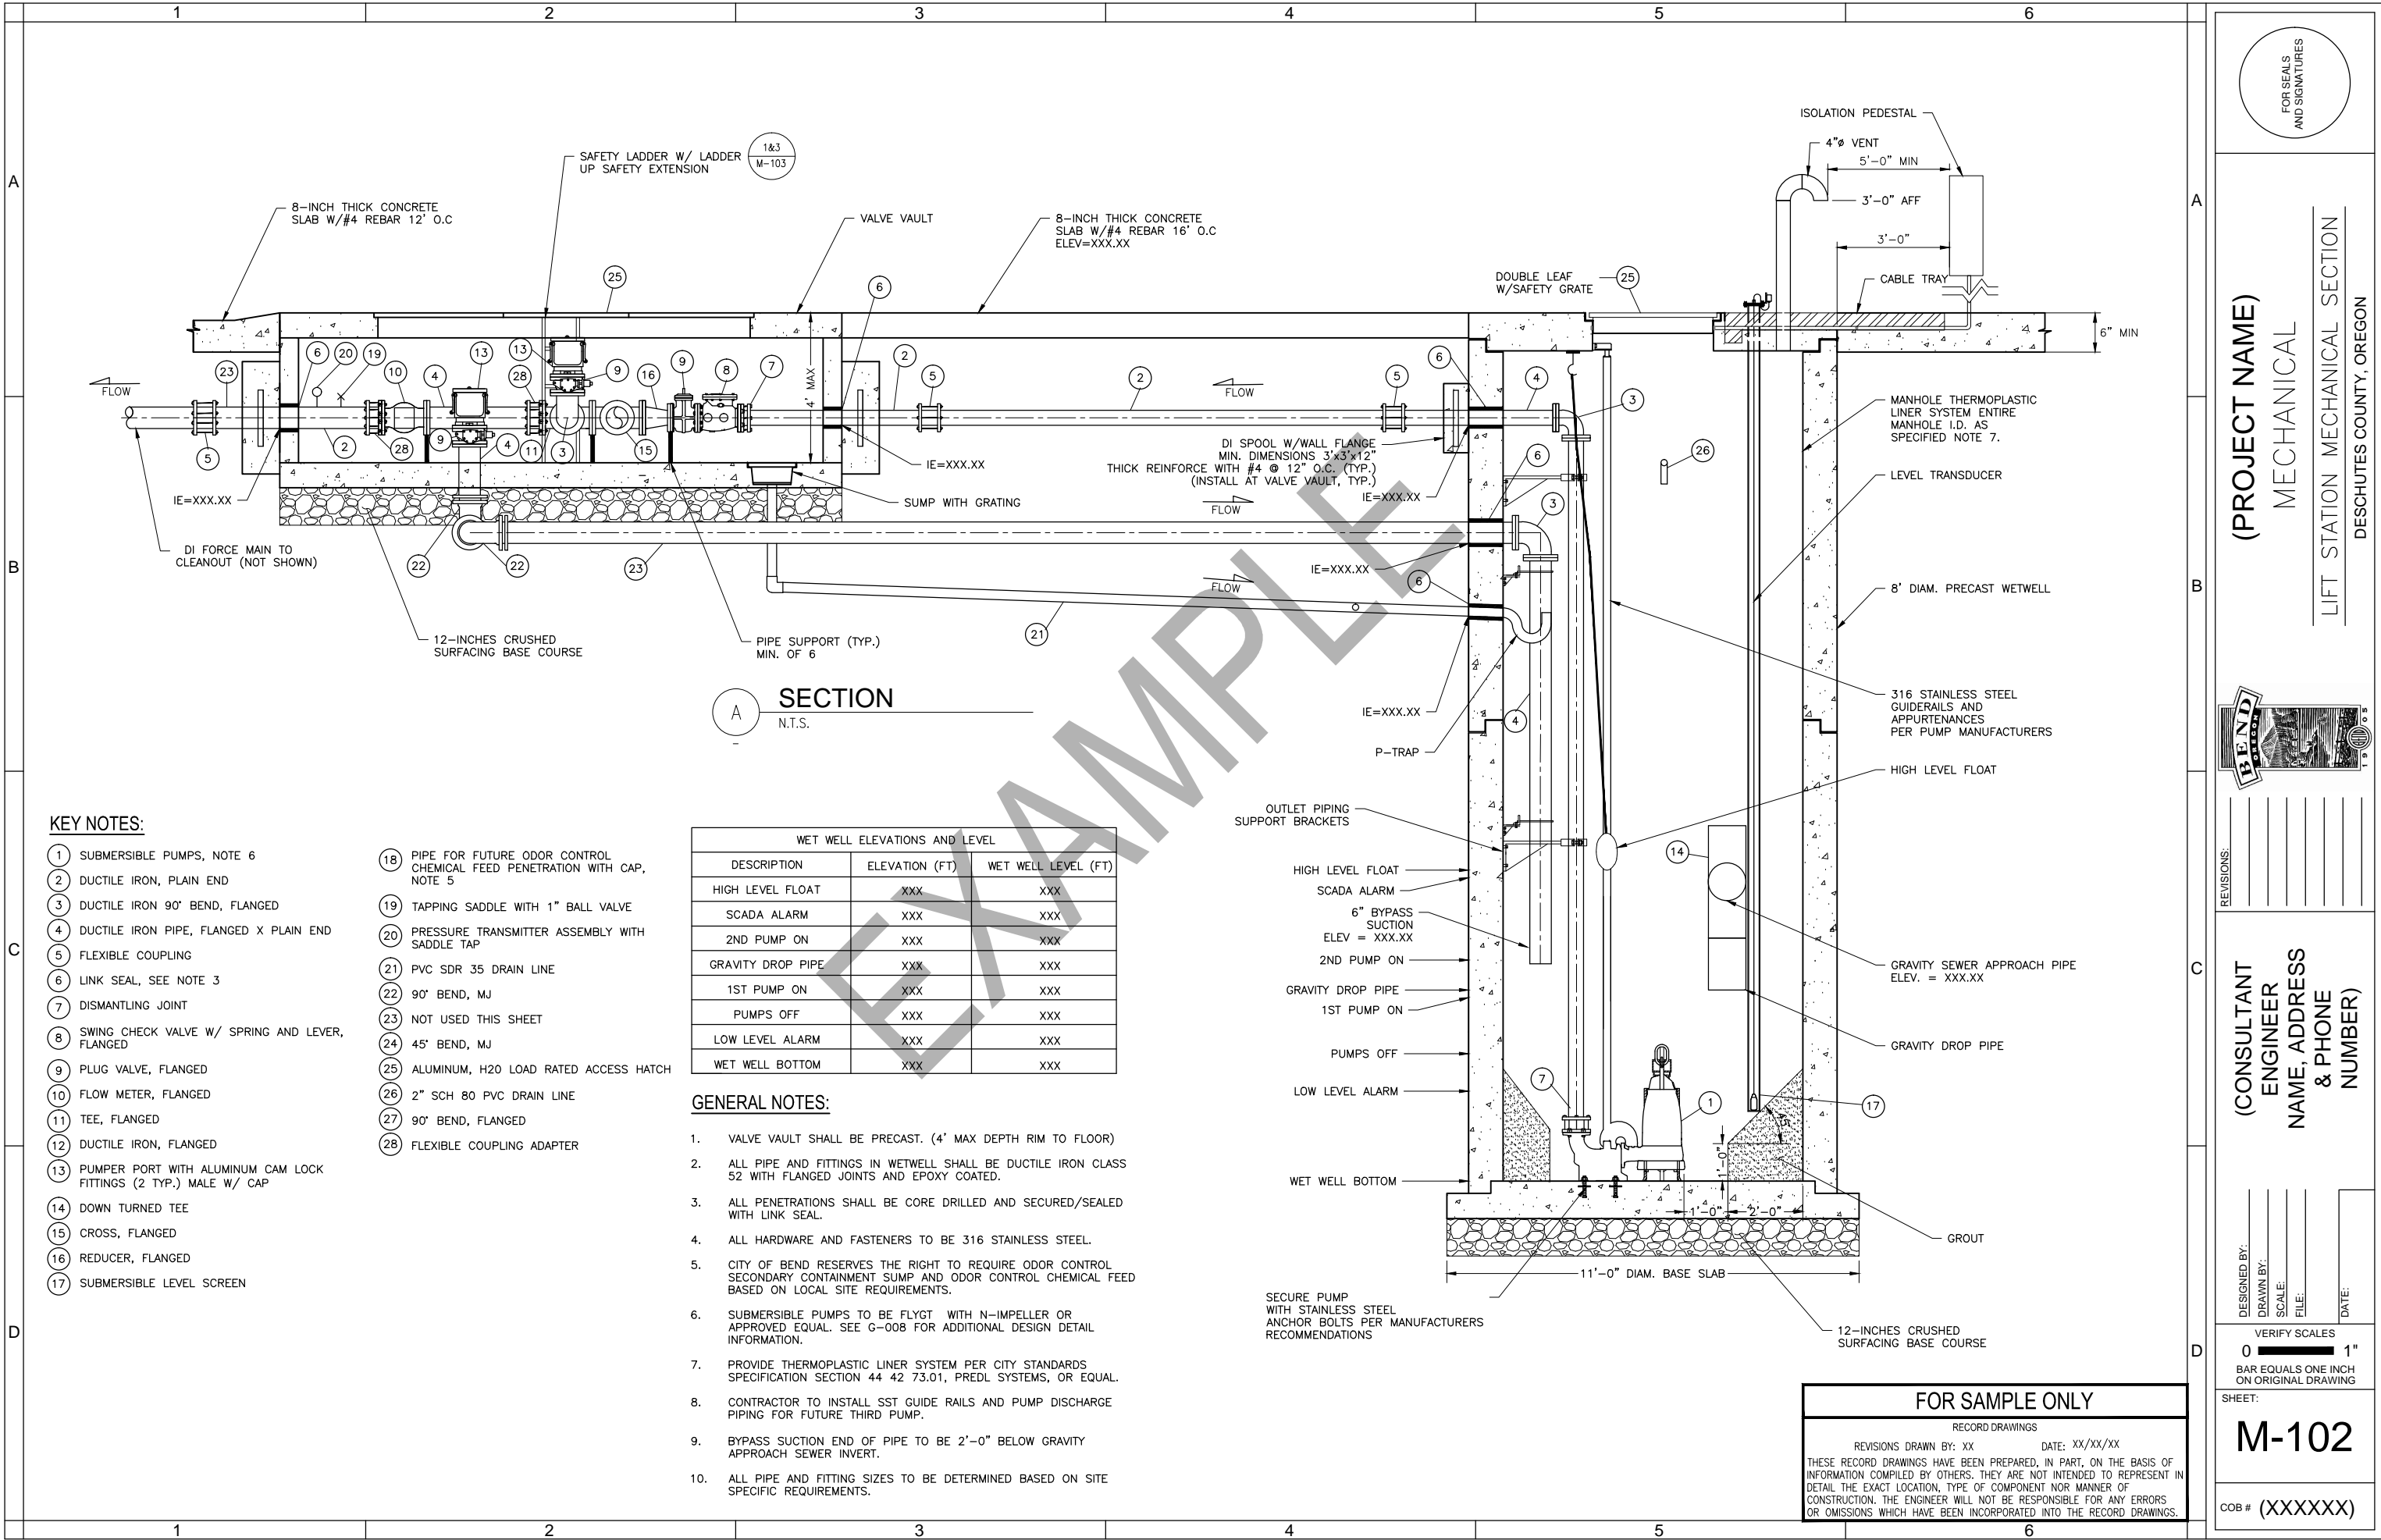

FOR SEALS
AND SIGNATURES

(PROJECT NAME)
MECHANICAL
LIFT STATION MECHANICAL SECTION
DESCHUTES COUNTY, OREGON



REVISIONS:


(CONSULTANT
ENGINEER
NAME, ADDRESS
& PHONE
NUMBER)

DESIGNED BY:
DRAWN BY:
SCALE:
FILE:
DATE:


VERIFY SCALES
0 1"
BAR EQUALS ONE INCH
ON ORIGINAL DRAWING

SHEET:
M-102


COB # (XXXXXX)

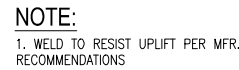

5 PIPE SUPPORT
N.T.S.

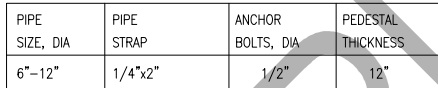

6 CONCRETE PEDESTAL SUPPORT
N.T.S.

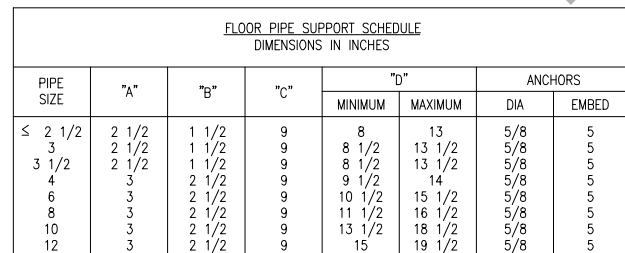

8 FLOOR PIPE SUPPORT
N.T.S.

FOR SAMPLE ONLY

RECORD DRAWINGS

REVISIONS DRAWN BY: XX

DATE: XX/XX/XX

THESE RECORD DRAWINGS HAVE BEEN PREPARED, IN PART, ON THE BASIS OF INFORMATION COMPILED BY OTHERS. THEY ARE NOT INTENDED TO REPRESENT IN DETAIL THE EXACT LOCATION, TYPE OF COMPONENT NOR MANNER OF CONSTRUCTION. THE ENGINEER WILL NOT BE RESPONSIBLE FOR ANY ERRORS OR OMISSIONS WHICH HAVE BEEN INCORPORATED INTO THE RECORD DRAWINGS.

FOR SEALS
AND SIGNATURES

(PROJECT NAME)
MECHANICAL

MECHANICAL DETAILS

DESCHUTES COUNTY, OREGON



REVISIONS:

(CONSULTANT
ENGINEER
NAME, ADDRESS
& PHONE
NUMBER)


DESIGNED BY: _____

DRAWN BY: _____

SCALE: _____

FILE:

DATE: _____

VERIFY SCALES
0  1"
BAR EQUALS ONE INCH
IN ORIGINAL DRAWING

SHEET:

M-104

COB # (XXXXXX)



1 PANEL LAYOUT ELEVATION
N.T.S.

- FOR SEALS
AND SIGNATURES

(PROJECT NAME)

CONTROL PANEL TYPE B

TEMPLATE (50 I/Os) PANEL LAYOUT

DESCHUTES COUNTY, OREGON




REVISIONS:

(CONSULTANT
ENGINEER
NAME, ADDRESS
& PHONE
NUMBER)

DESIGNED BY: XXX
DRAWN BY: XXX
SCALE: NONE
FILE: I-002.dwg

DATE:

VERIFY SCALES
0  1"
BAR EQUALS ONE INCH
ON ORIGINAL DRAWING

SHEET:

I-002

COB # (XXXXXX)

FOR SAMPLE ONLY

RECORD DRAWINGS

REVISIONS DRAWN BY: XX DATE: XX/XX/XX

THESE RECORD DRAWINGS HAVE BEEN PREPARED, IN PART, ON THE BASIS OF INFORMATION COMPILED BY OTHERS. THEY ARE NOT INTENDED TO REPRESENT IN DETAIL THE EXACT LOCATION, TYPE OF COMPONENT NOR MANNER OF CONSTRUCTION. THE ENGINEER WILL NOT BE RESPONSIBLE FOR ANY ERRORS OR OMISSIONS WHICH HAVE BEEN INCORPORATED INTO THE RECORD DRAWINGS.

1

2

3

4

5

6

A

B

C

D

BILL OF MATERIALS					
ITEM	QTY	DESCRIPTION	MANUFACTURE	MODEL/CAT #	SUPPLIER
1	1	ENCLOSURE	HOFFMAN	CSD363010 OR APPROVED EQUAL	PF
2	1	BACK PANEL	HOFFMAN	CP3630	PF
3	1	LIGHTING KIT	HOFFMAN	ALF16D12R	PF
4	AR	MOUNTING ALUMINUM BRACKETS	SHOP SUPPLY	SHOP SUPPLY	PF
5	1	MICROLOGIX 1400 WITH ETHERNET PORT	ALLEN-BRADLEY	1766-L32BXB	PF
6	1	1762 AI MODULE	ALLEN-BRADLEY	1762-IF4	PF
7	-	-	-	-	-
8	-	-	-	-	-
9	-	-	-	-	-
10	-	-	-	-	-
11	-	-	-	-	-
12	1	24VDC POWER SUPPLY	PULS	QS10.241	PF
13	1	24VDC UPS WITH INTEGRATED BATTERY	PULS	UBC10-241	PF
14	2	15A CIRCUIT BREAKER	ALLEN-BRADLEY	1492-SP1C150	PF
15	1	SURGE SUPPRESSOR	CONTROL CONCEPTS	ISLATROL IE-120	PF
16	1	DATA INTERFACE PORT	HOFFMAN	HGF5CN	PF
17	-	-	-	-	-
18	-	-	-	-	-
19	3	ELECTROMECHANICAL HOUR METER	REDINGTON	732-0014	PF
20	AR	10A CB4200 SERIES CIRCUIT BREAKER	WEIDMULLER	910 190 3500	PF
21	AR	0.5A CB4200 SERIES CIRCUIT BREAKER	WEIDMULLER	910 100 3500	PF
22	AR	3A CB4200 SERIES CIRCUIT BREAKER	WEIDMULLER	910 170 3500	PF
23	AR	2A CB4200 SERIES CIRCUIT BREAKER	WEIDMULLER	910 150 3500	PF
24	AR	0.1A CB4200 SERIES CIRCUIT BREAKER	WEIDMULLER	910 417 3500	PF
25	AR	FEED THROUGH TERMINAL WDU 2.5 (BEIGE)	WEIDMULLER	-	PF
26	AR	FEED THROUGH TERMINAL WDU 2.5 BL (BLUE)	WEIDMULLER	-	PF
27	AR	GROUNDING TERMINAL WPE 2.5	WEIDMULLER	-	PF
28	AR	END PLATE WAP 2.5-10 (BEIGE)	WEIDMULLER	-	PF
29	AR	END PLATE WAP 2.5-10 BL (BLUE)	WEIDMULLER	-	PF
30	AR	PARTITION WTW EN (DARK BEIGE)	WEIDMULLER	-	PF
31	AR	END BRACKET WEW 35/2 (DARK BEIGE)	WEIDMULLER	-	PF
32	AR	ZINC PLATED YELLOW-CHROMATE STEEL T-35 DIN RAIL	SHOP SUPPLY	SHOP SUPPLY	PF
33	AR	1.5" W X 3" D WIREWAY W/ COVER	PANDUIT	F1.5X3LG6 & C1.5LG6	PF
34	AR	2" W X 3" D WIREWAY W/ COVER	PANDUIT	F2X3LG6 & C2LG6	PF
35	AR	3" W X 3" D WIREWAY W/ COVER	PANDUIT	F3X3LG6 & C3LG6	PF
36	1	8 PORT NETWORK SWITCH	SIXNET	SLX-8MS	PF
37	1	6FT CAT6 PATCH CABLE	SHOP SUPPLY	SHOP SUPPLY	PF
38	2	GROUND BUS	SHOP SUPPLY	SHOP SUPPLY	PF
39	-	-	-	-	-
40	-	-	-	-	-
41	1	LONG RANGE IP/ETHERNET RADIO	GE MDS	TO BE DETERMINED BY CITY STAFF	PF
42	4	LOUVER WITH FILTER	HOFFMAN	AVK44 / AFLT44	PF
43	1	4-POLE ICE CUBE RELAY / SOCKET	ALLEN-BRADLEY	700-HF34Z24-4 / 700-HN139	PF
44	5	2-POLE ICE CUBE RELAY / SOCKET	ALLEN-BRADLEY	700-HF32Z24-4 / 700-HN116	PF

NOTE: ALL MATERIALS SHOWN ARE THE MINIMUM REQUIREMENTS AND SHALL BE REVIEWED AND APPROVED BY THE CITY OF BEND DURING PRELIMINARY DESIGN

PF

=

PANEL FABRICATOR

COB

=

CITY OF BEND

NAMEPLATE SCHEDULE				
NAMEPLATE	LINE	NAMEPLATE	PLATE SIZE	LETTERING SIZE
1	1	LIFT STATION XX LOCAL CONTROL PANEL		1/2"
	2	WXXX-ICP-XXXX	4" X 10"	1"
	-	-		-
2	1	120VAC POWER		1/4"
	2	FROM PANELS	3" X 6"	1/4"
	3	XXXXXX & XXXXXX		1/4"
3	1	PUMP 1 RTM		3/16"
	-	-	1/2" X 1"	-
	-	-		-
4	1	PUMP 2 RTM		3/16"
	-	-	1/2" X 1"	-
	-	-		-
5	1	PUMP 3 RTM		3/16"
	-	-	1/2" X 1"	-
	-	-		-
6	1	PORTABLE PROGRAMMING		3/16"
	2	TERMINAL POWER	1" X 3"	3/16"
	3	ONLY		3/16"

FOR SAMPLE ONLY

RECORD DRAWINGS

DESIGNED BY: XXX
DRAWN BY: XXX
SCALE: NONE
FILE: I-003.dwg
DATE:

REVISIONS DRAWN BY: XX
DATE: XX/XX/XX

THESE RECORD DRAWINGS HAVE BEEN PREPARED, IN PART, ON THE BASIS OF INFORMATION COMPILED BY OTHERS. THEY ARE NOT INTENDED TO REPRESENT IN DETAIL THE EXACT LOCATION, TYPE OF COMPONENT NOR MANNER OF CONSTRUCTION. THE ENGINEER WILL NOT BE RESPONSIBLE FOR ANY ERRORS OR OMISSIONS WHICH HAVE BEEN INCORPORATED INTO THE RECORD DRAWINGS.

DESIGNED BY: XXX
DRAWN BY: XXX
SCALE: NONE
FILE: I-003.dwg
DATE:

REVISIONS:


VERIFIED SCALES
0 1"
BAR EQUALS ONE INCH
ON ORIGINAL DRAWING

SHEET: I-003

COB # (XXXXXX)

FOR SEALS
AND SIGNATURES

(PROJECT NAME)
CNTR PNL TYPE B TEMPLATE
(50 I/Os) BILL OF MATERIALS
DESCHUTES COUNTY, OREGON



REVISIONS:


(CONSULTANT
ENGINEER
NAME, ADDRESS
& PHONE
NUMBER)

DESIGNED BY: XXX
DRAWN BY: XXX
SCALE: NONE
FILE: I-003.dwg
DATE:

REVISIONS DRAWN BY: XX
DATE: XX/XX/XX

THESE RECORD DRAWINGS HAVE BEEN PREPARED, IN PART, ON THE BASIS OF INFORMATION COMPILED BY OTHERS. THEY ARE NOT INTENDED TO REPRESENT IN DETAIL THE EXACT LOCATION, TYPE OF COMPONENT NOR MANNER OF CONSTRUCTION. THE ENGINEER WILL NOT BE RESPONSIBLE FOR ANY ERRORS OR OMISSIONS WHICH HAVE BEEN INCORPORATED INTO THE RECORD DRAWINGS.

SHEET X OF X

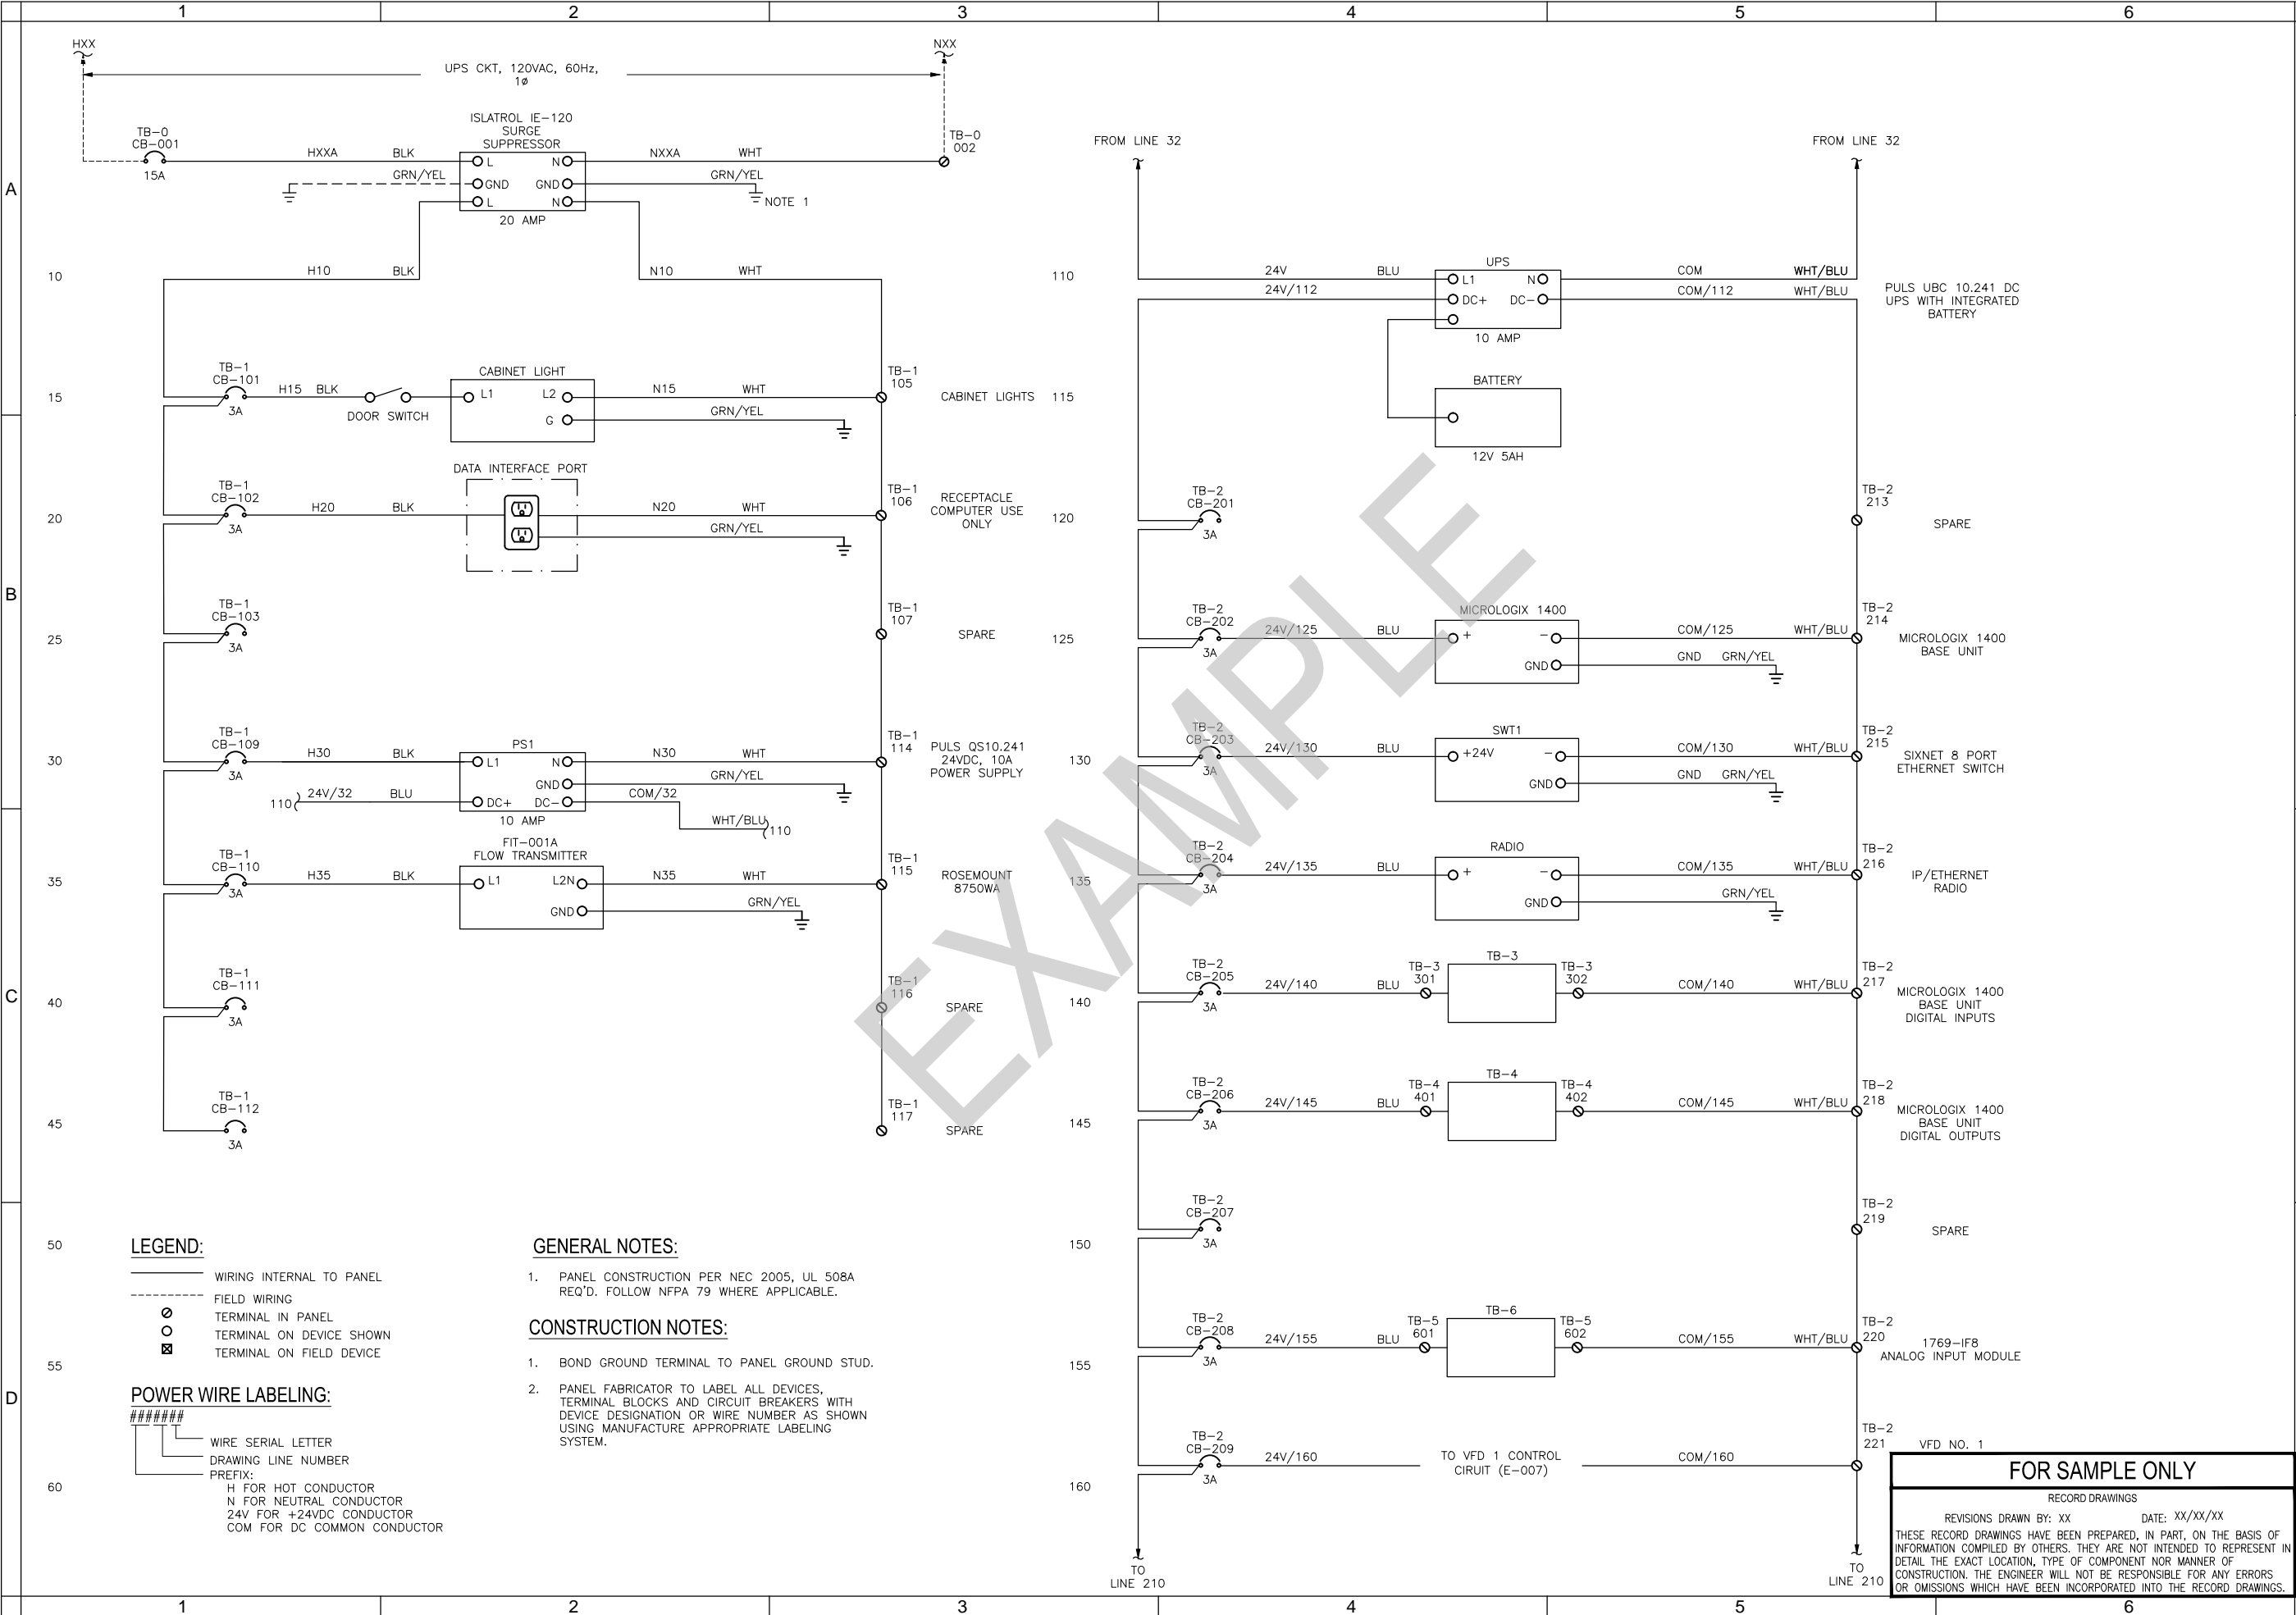

FOR SEALS
AND SIGNATURES

(PROJECT NAME)
CNTR PNL TYPE B TEMPLATE
(50 I/Os) PWR WIRING SCHEMATIC
DESCHUTES COUNTY, OREGON



REVISIONS:

(CONSULTANT
ENGINEER
NAME, ADDRESS
& PHONE
NUMBER)

DESIGNED BY: XXX
DRAWN BY: XXX
SCALE: NONE
FILE: I-004.dwg
DATE:

VERIFY SCALES
0 1"
BAR EQUALS ONE INCH
ON ORIGINAL DRAWING


SHEET:
I-004
COB # (XXXXXX)


FOR SAMPLE ONLY

RECORD DRAWINGS

REVISIONS DRAWN BY: XX DATE: XX/XX/XX


THESE RECORD DRAWINGS HAVE BEEN PREPARED, IN PART, ON THE BASIS OF INFORMATION COMPILED BY OTHERS. THEY ARE NOT INTENDED TO REPRESENT IN DETAIL THE EXACT LOCATION, TYPE OF COMPONENT NOR MANNER OF CONSTRUCTION. THE ENGINEER WILL NOT BE RESPONSIBLE FOR ANY ERRORS OR OMISSIONS WHICH HAVE BEEN INCORPORATED INTO THE RECORD DRAWINGS.

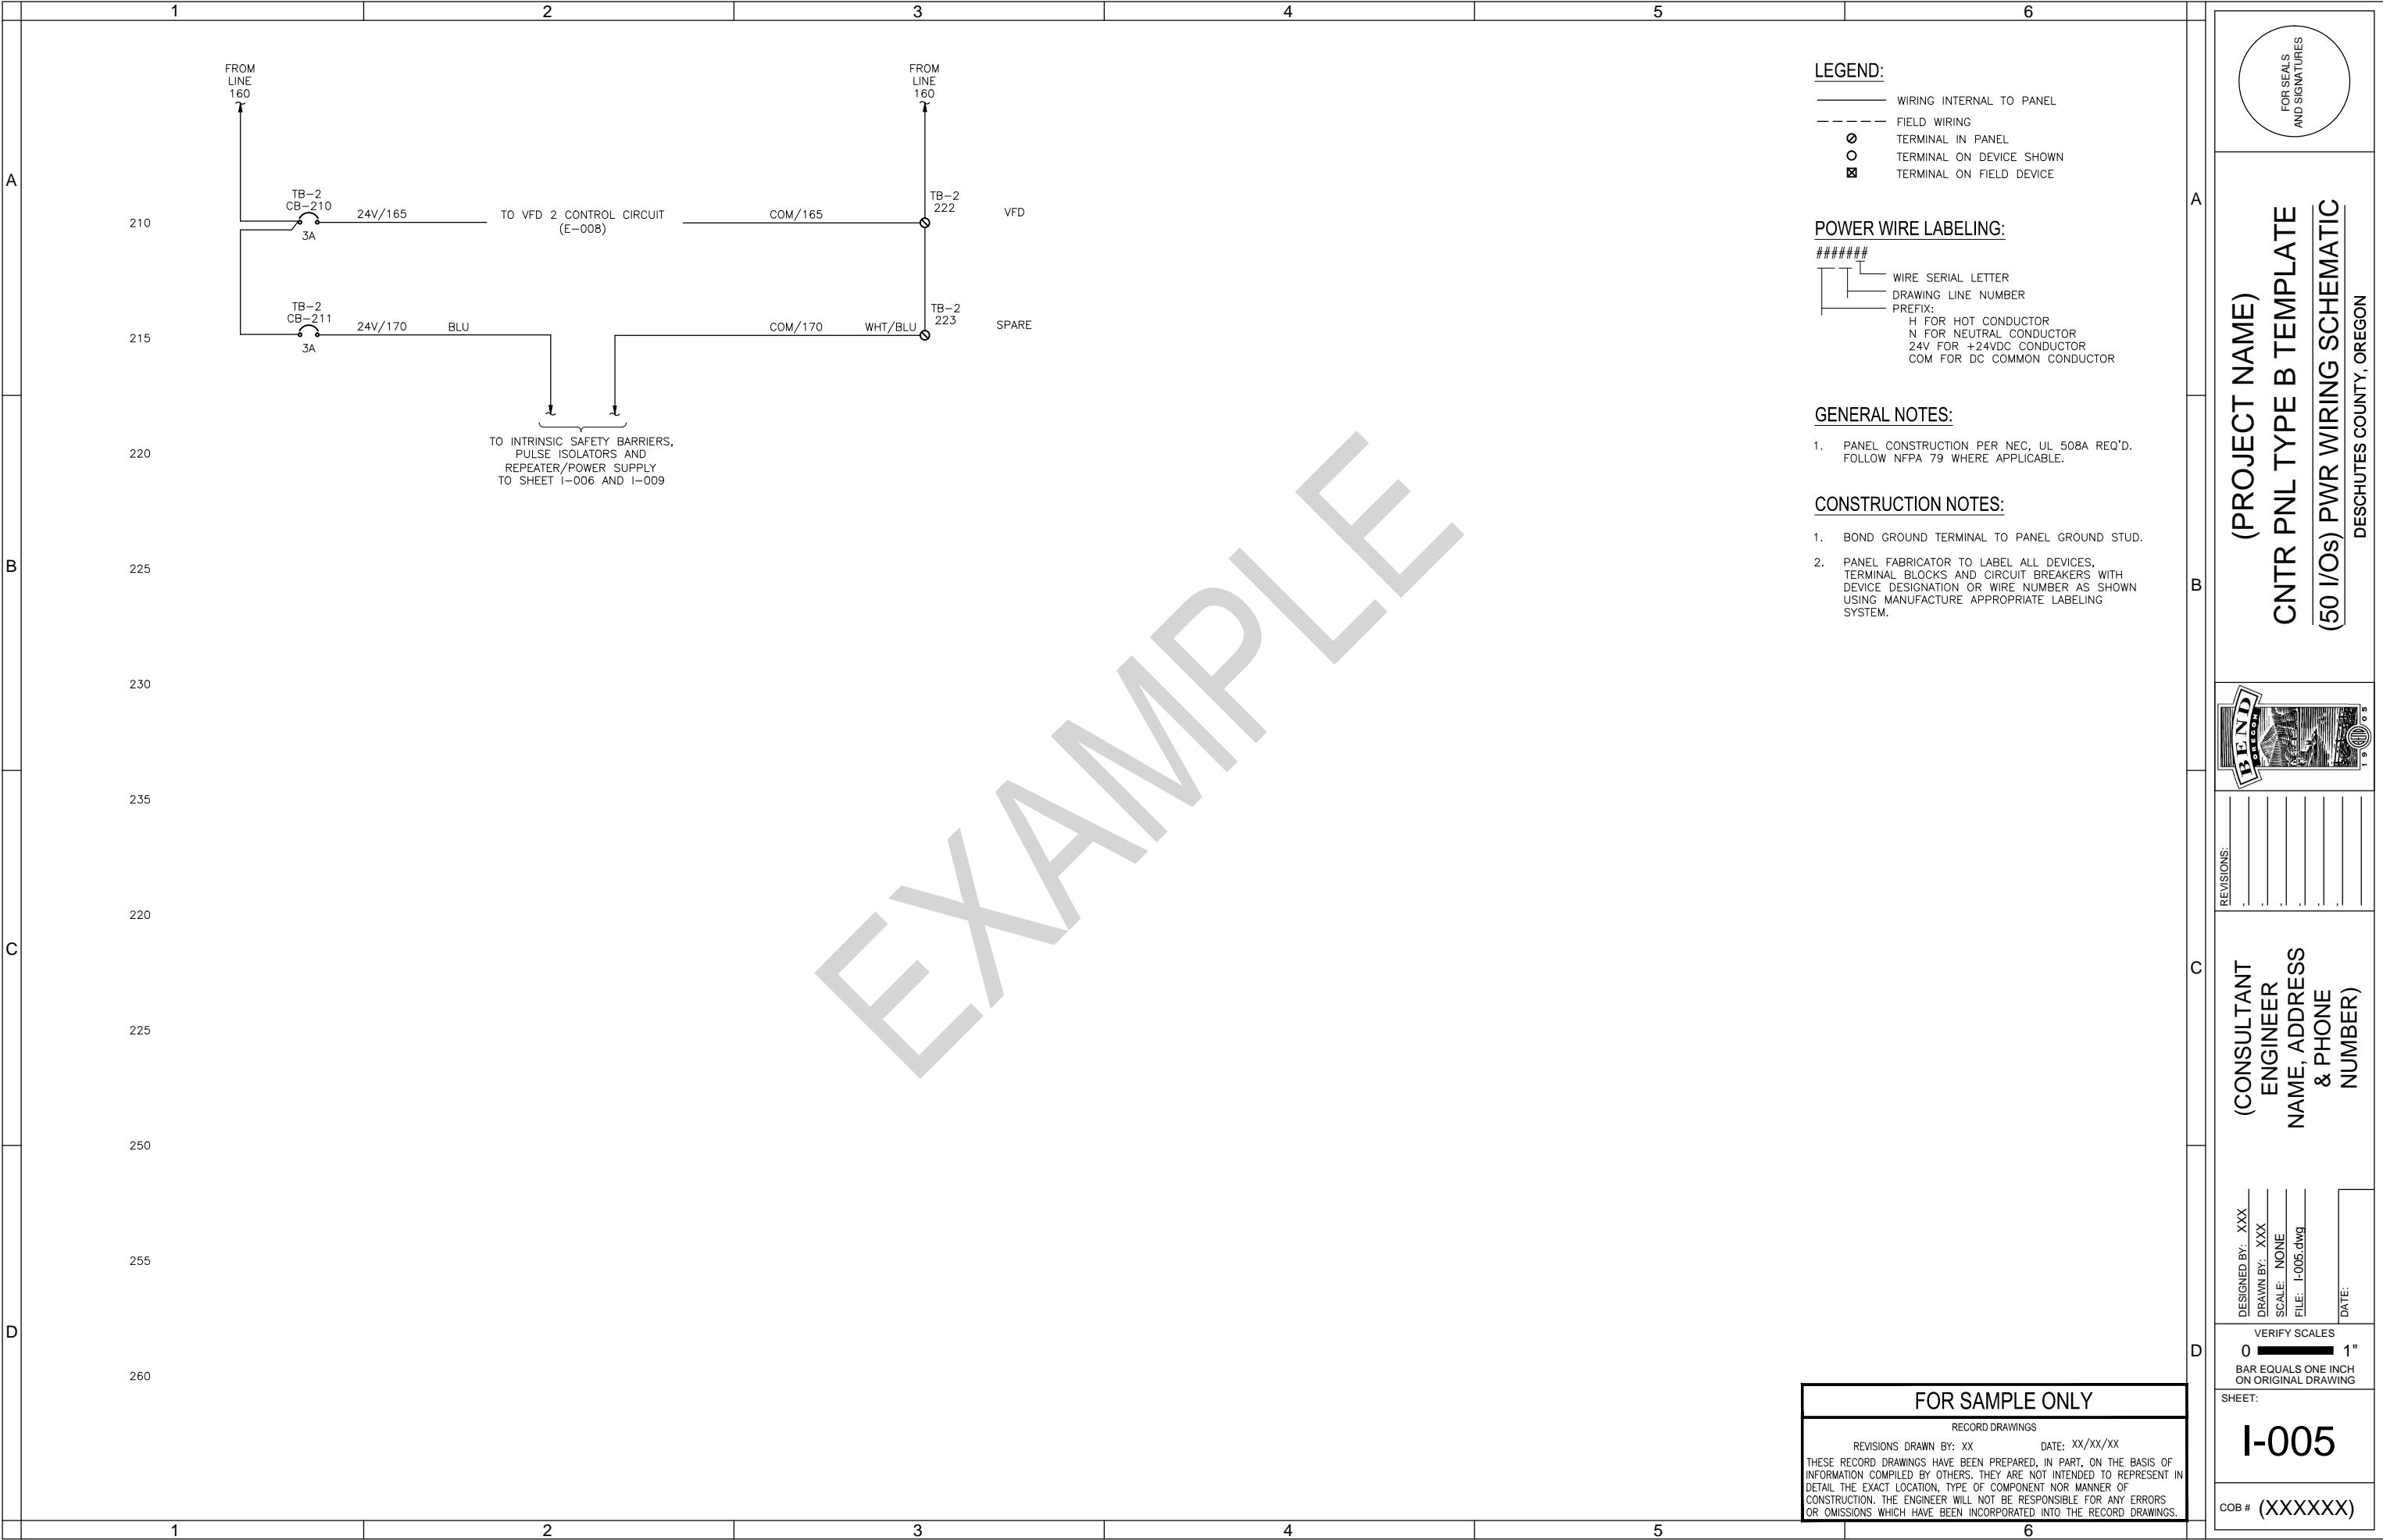

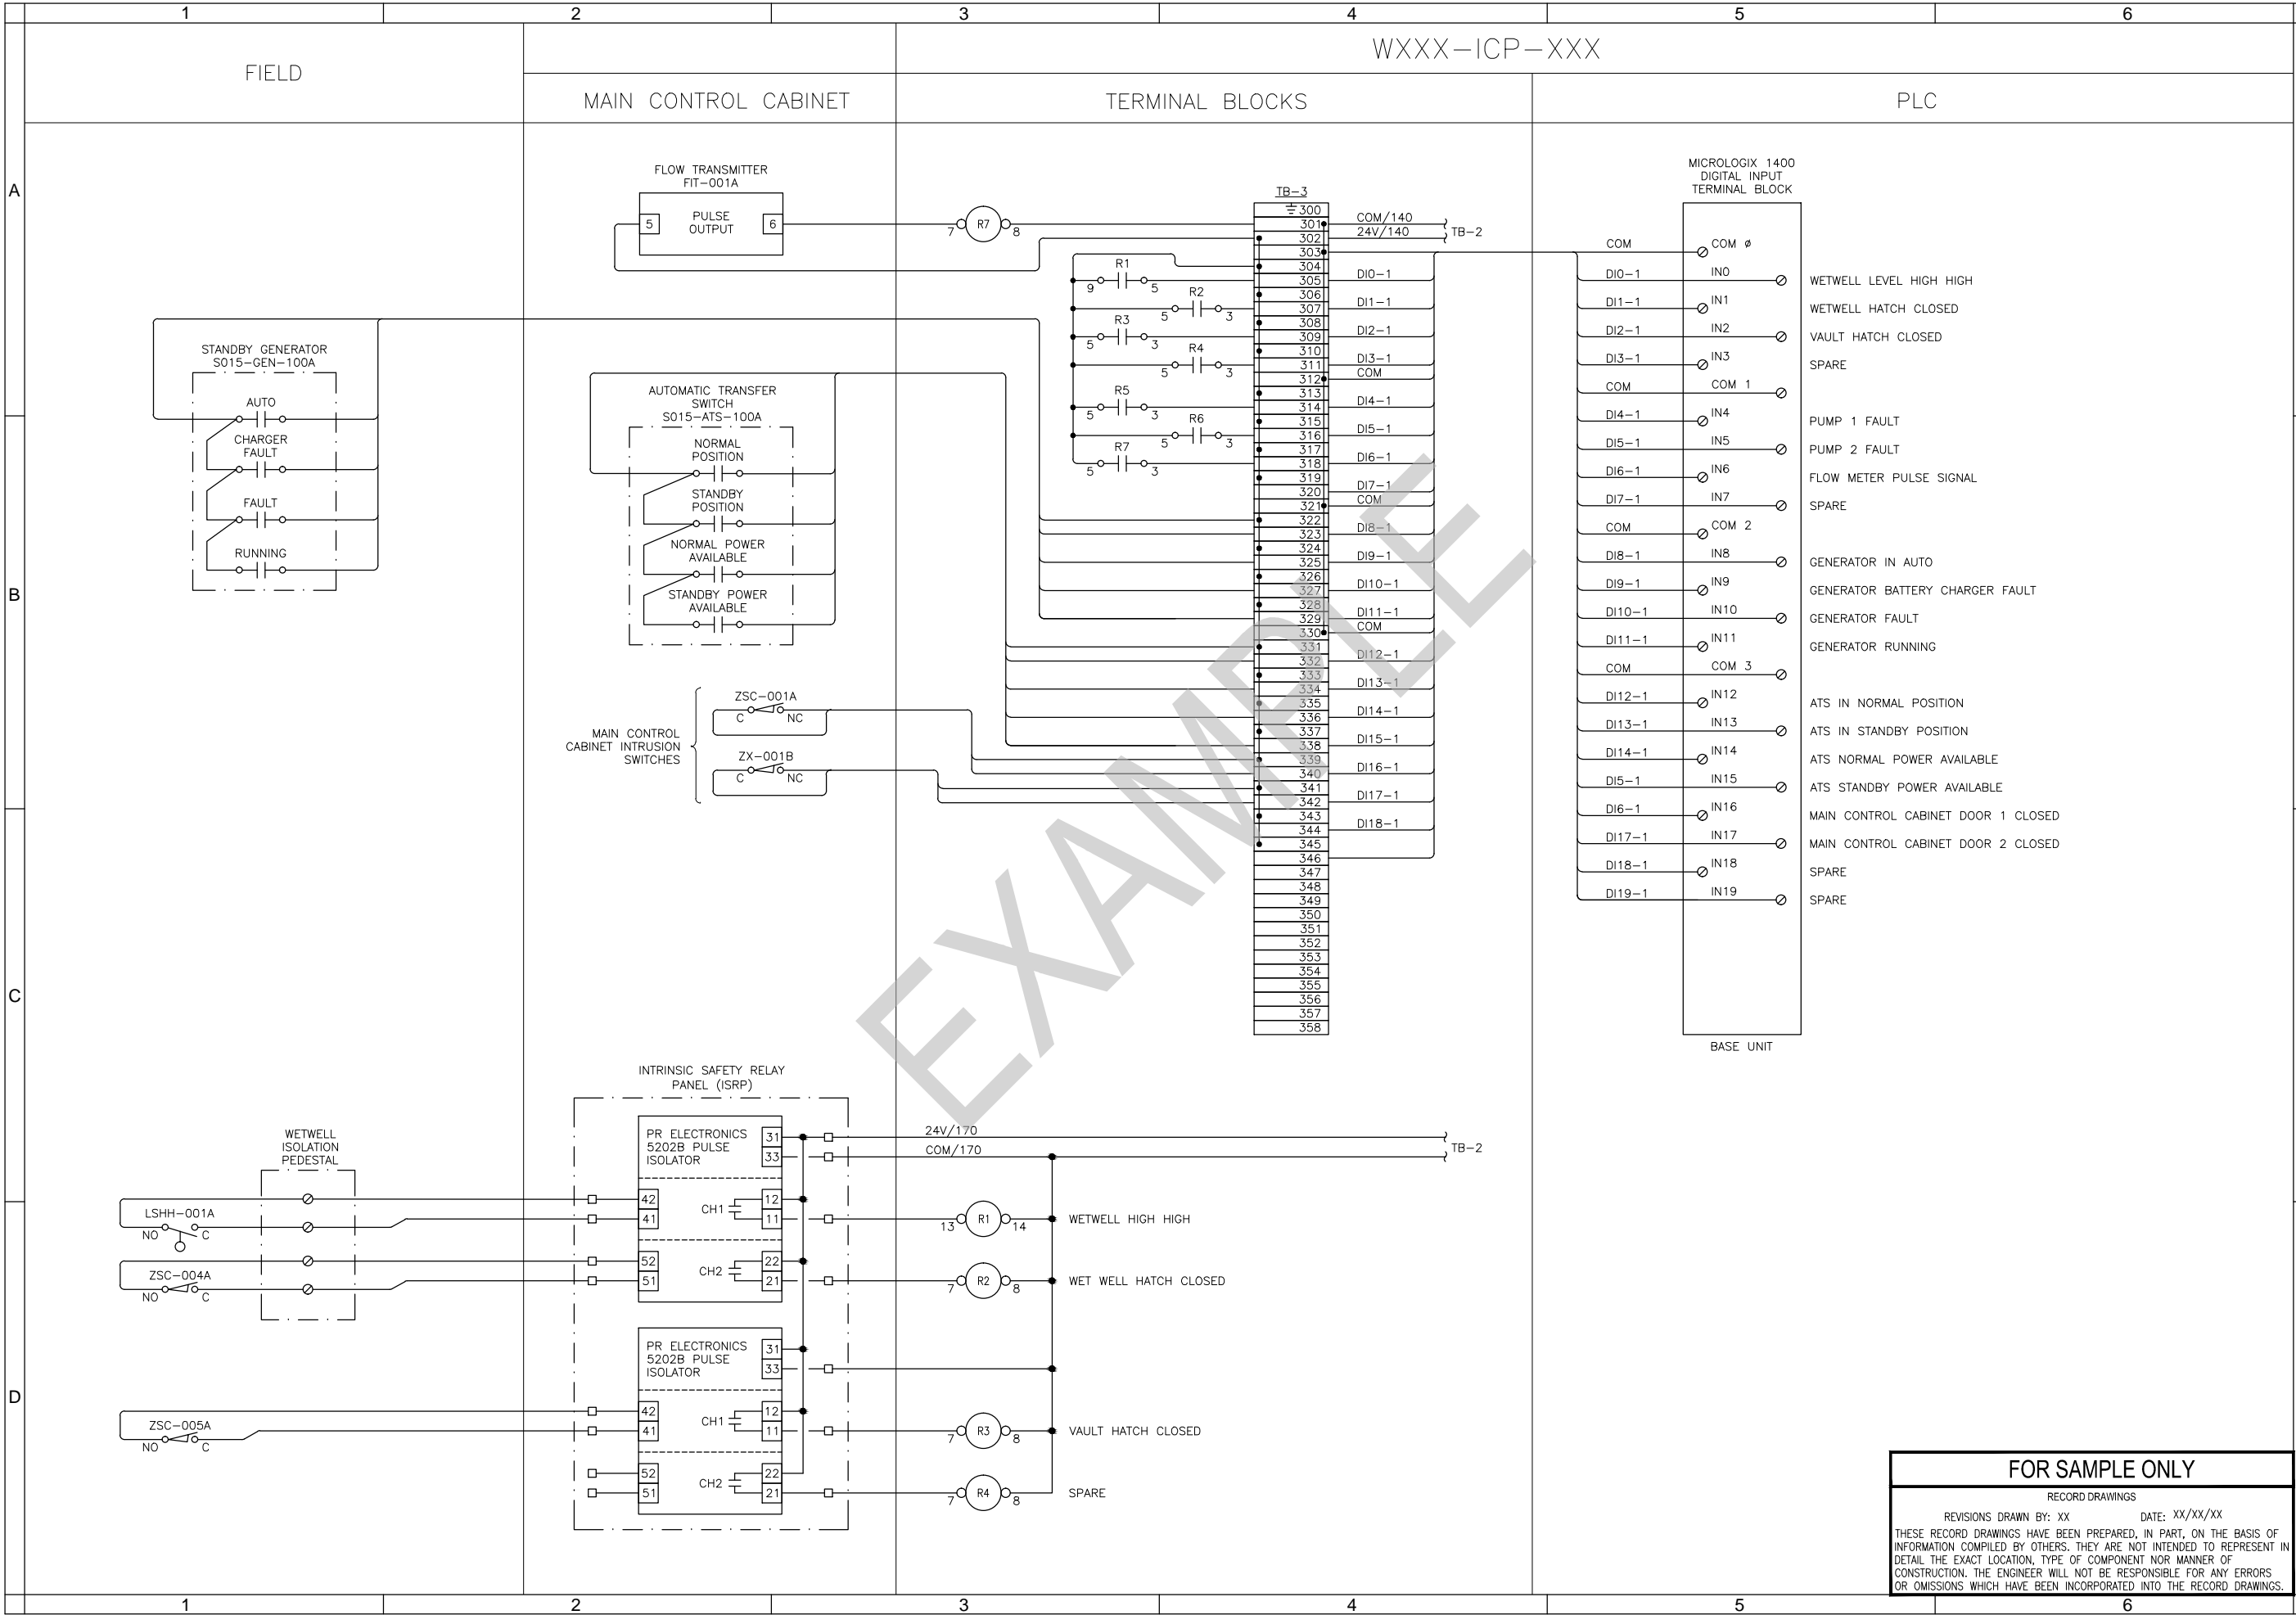

FOR SEALS AND SIGNATURES

(PROJECT NAME)
CNTR PNL TYPE B TEMPLATE
(50 I/Os) DIGITAL INPUT MODULE 1
DESCHUTES COUNTY, OREGON



REVISIONS:

(CONSULTANT ENGINEER NAME, ADDRESS & PHONE NUMBER)

DESIGNED BY: XXX
DRAWN BY: XXX
SCALE: NONE
FILE: I-006.dwg
DATE:


VERIFY SCALES
0 1"
BAR EQUALS ONE INCH ON ORIGINAL DRAWING


SHEET: I-006
COB # (XXXXXX)

FOR SAMPLE ONLY

RECORD DRAWINGS
REVISIONS DRAWN BY: XX DATE: XX/XX/XX
THESE RECORD DRAWINGS HAVE BEEN PREPARED, IN PART, ON THE BASIS OF INFORMATION COMPILED BY OTHERS. THEY ARE NOT INTENDED TO REPRESENT IN DETAIL THE EXACT LOCATION, TYPE OF COMPONENT NOR MANNER OF CONSTRUCTION. THE ENGINEER WILL NOT BE RESPONSIBLE FOR ANY ERRORS OR OMISSIONS WHICH HAVE BEEN INCORPORATED INTO THE RECORD DRAWINGS.

SHEET X OF X

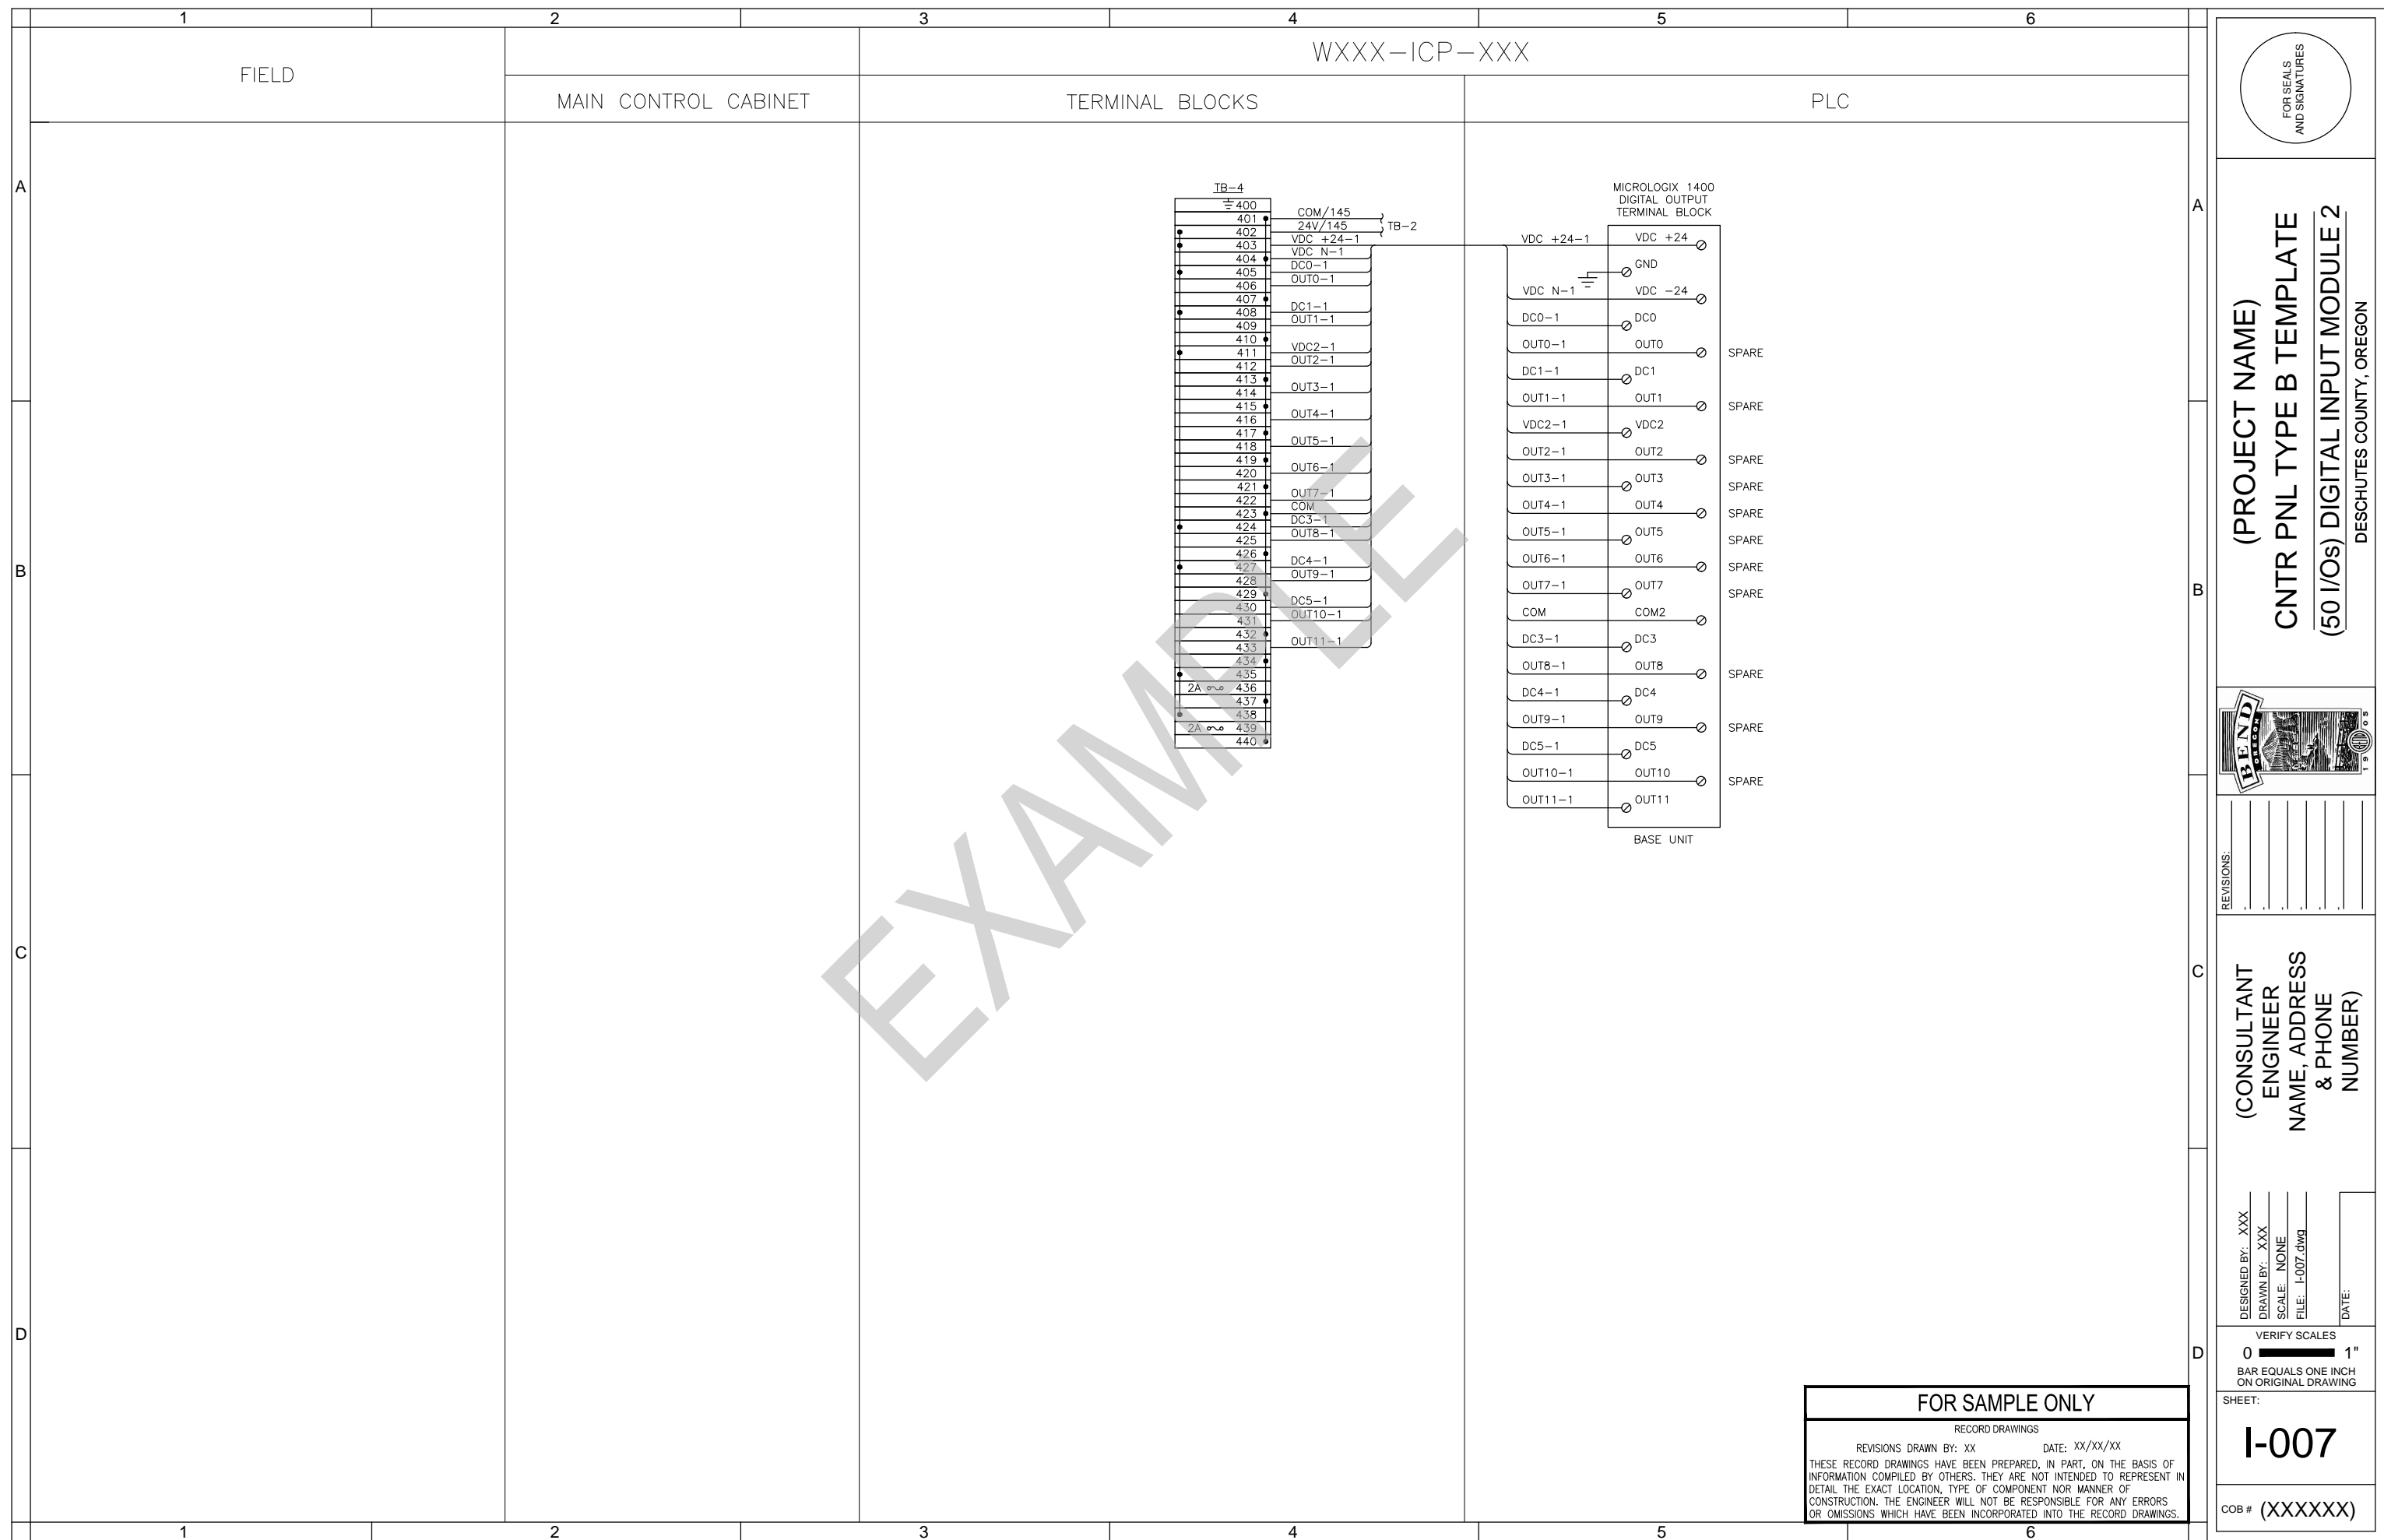

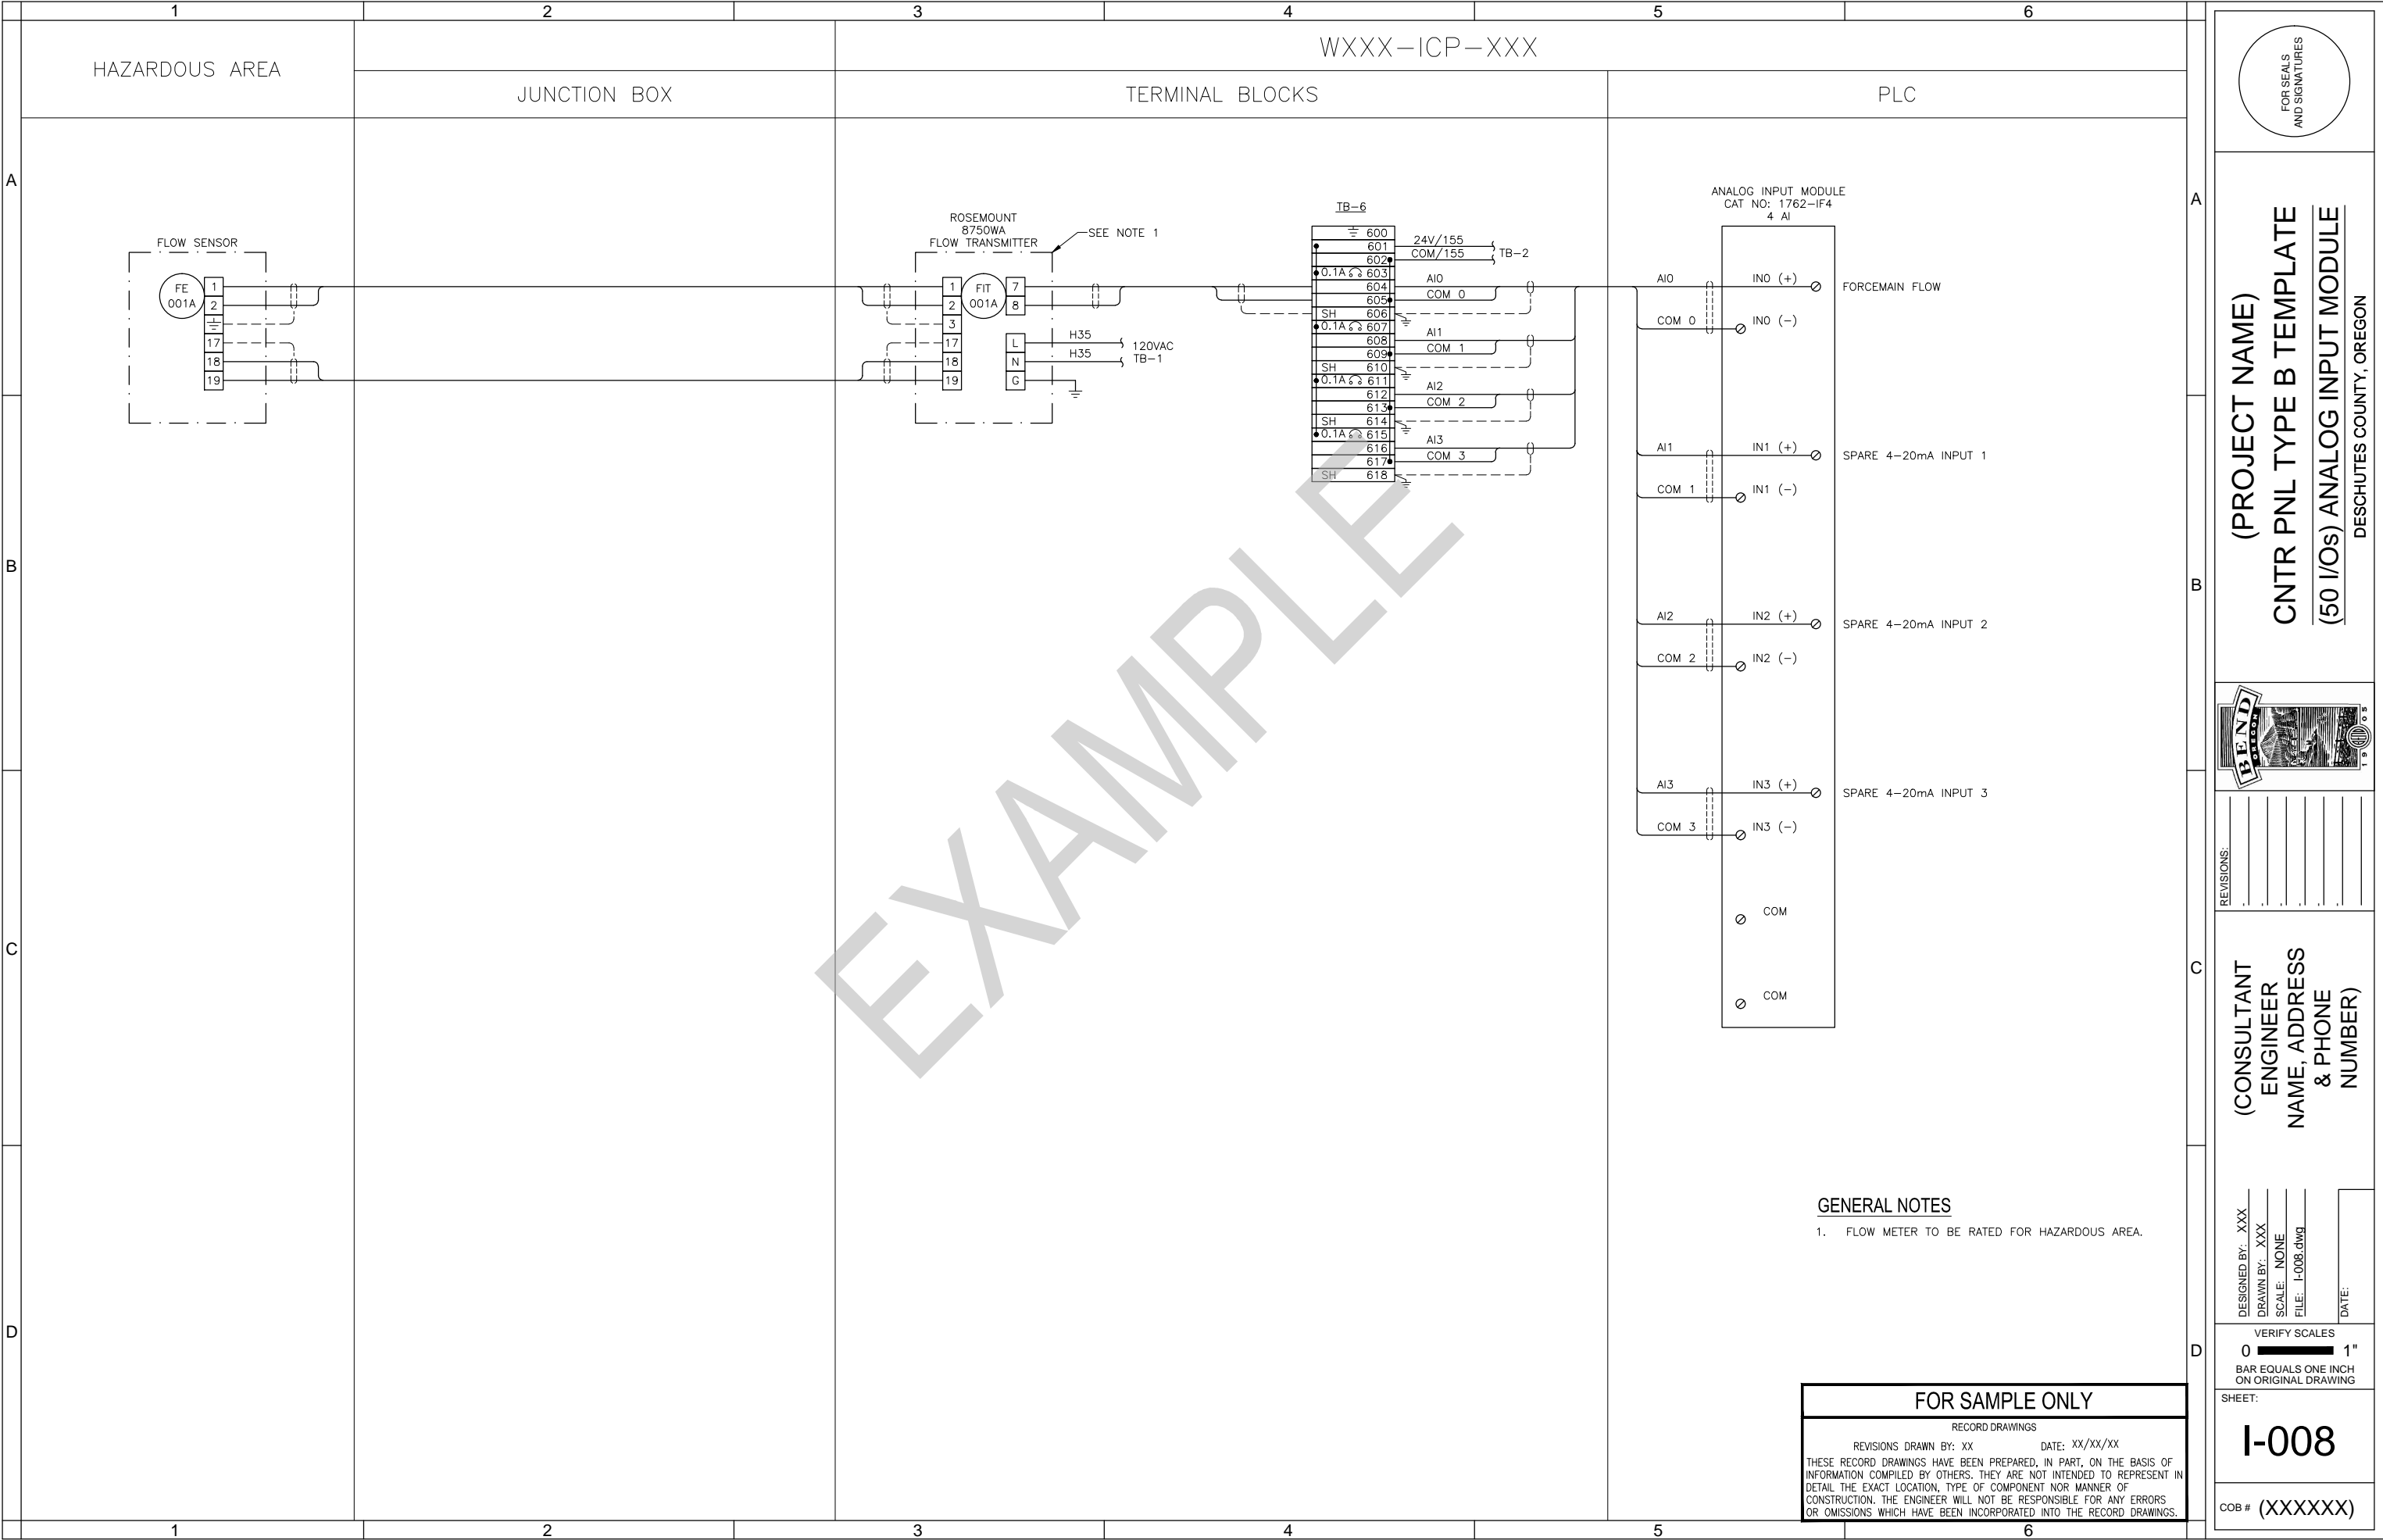

FOR SEALS AND SIGNATURES

(PROJECT NAME)

CNTR PNL TYPE B TEMPLATE

(50 I/Os) ANALOG INPUT MODULE

DESCHUTES COUNTY, OREGON

REVISIONS:

CONSULTANT ENGINEER NAME, ADDRESS & PHONE NUMBER

DESIGNED BY: XXX

DRAWN BY: XXX

SCALE: NONE

FILE: I-008.dwg

DATE:

VERIFY SCALES

0 1"


BAR EQUALS ONE INCH ON ORIGINAL DRAWING

SHEET:

I-008


COB # (XXXXXXX)

SHEET X OF X

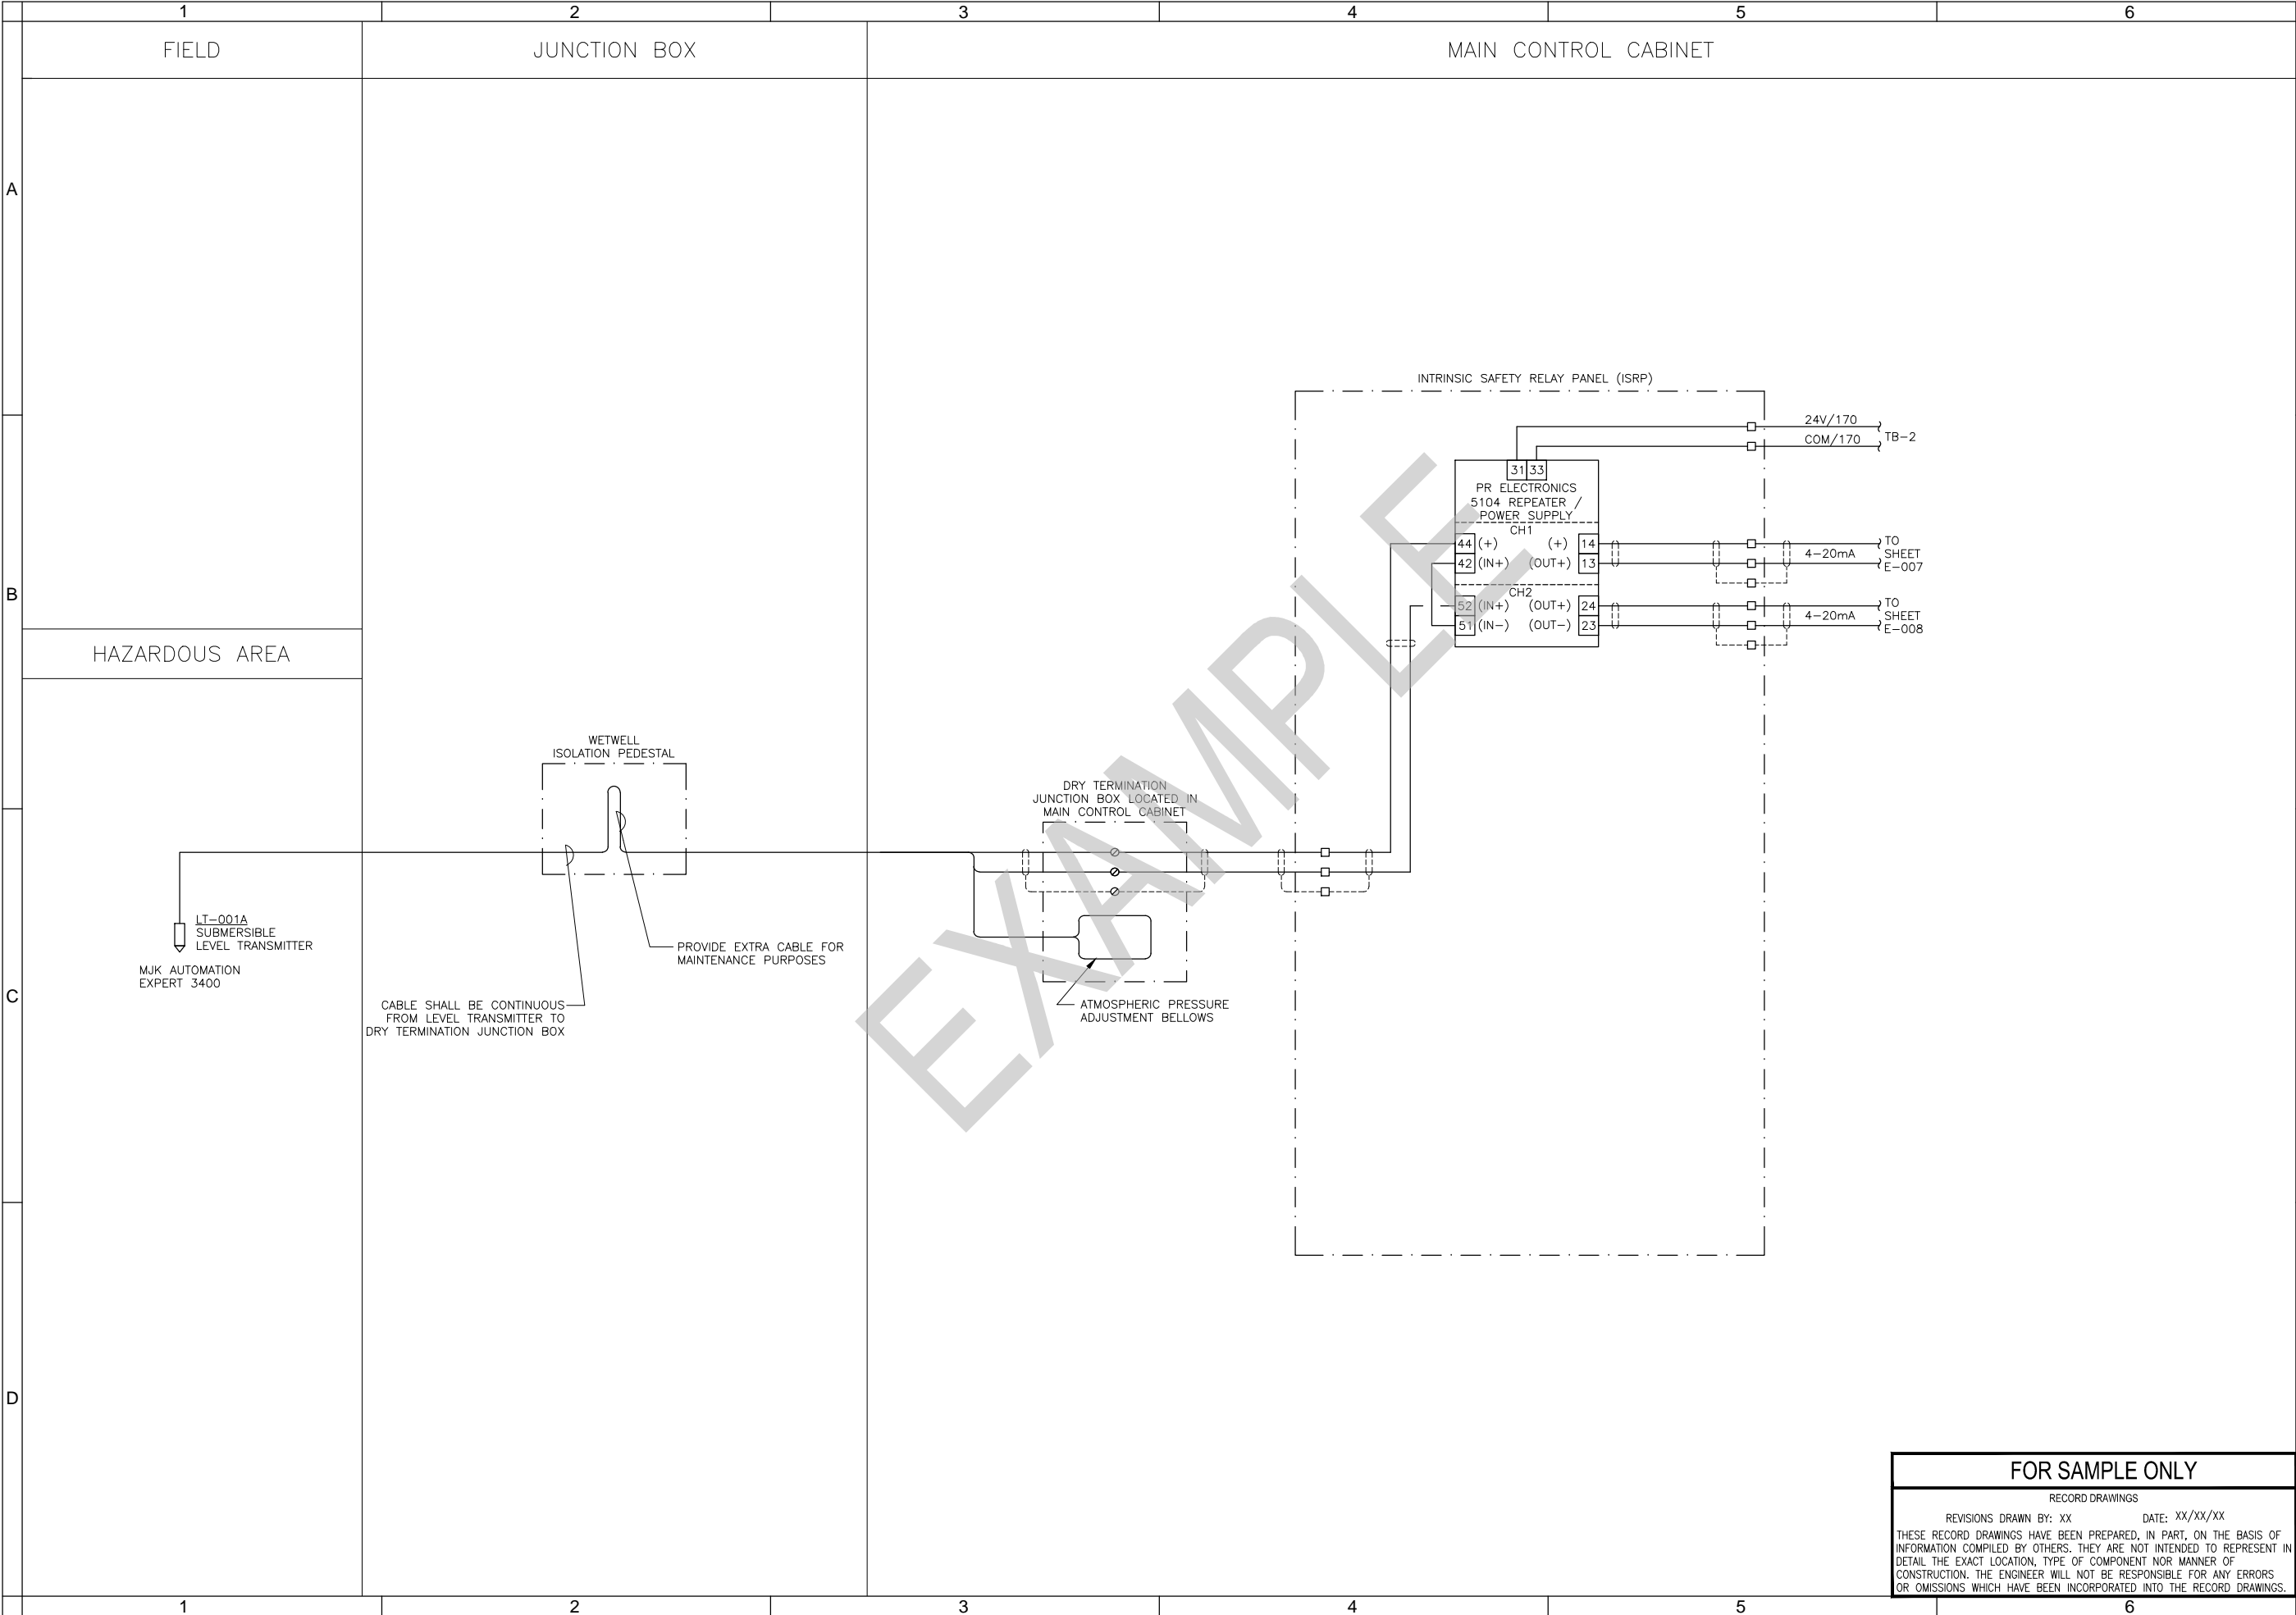

FOR SEALS
AND SIGNATURES


(PROJECT NAME)
INSTRUMENTATION & CONTROLS
INTRINSIC SAFETY RELAY PANEL (ISRP)
DESCHUTES COUNTY, OREGON


REVISIONS:
1.
2.
3.
4.
5.
6.
7.
8.
9.
10.

(CONSULTANT
ENGINEER
NAME, ADDRESS
& PHONE
NUMBER)
DESIGNED BY: XXX
DRAWN BY: XXX
SCALE: NONE
FILE: I-009.dwg
DATE:

VERIFY SCALES
0 1"
BAR EQUALS ONE INCH
ON ORIGINAL DRAWING
SHEET:
I-009
COB # (XXXXXX)

FOR SAMPLE ONLY
RECORD DRAWINGS
REVISIONS DRAWN BY: XX DATE: XX/XX/XX
THESE RECORD DRAWINGS HAVE BEEN PREPARED, IN PART, ON THE BASIS OF
INFORMATION COMPILED BY OTHERS. THEY ARE NOT INTENDED TO REPRESENT IN
DETAIL THE EXACT LOCATION, TYPE OF COMPONENT NOR MANNER OF
CONSTRUCTION. THE ENGINEER WILL NOT BE RESPONSIBLE FOR ANY ERRORS
OR OMISSIONS WHICH HAVE BEEN INCORPORATED INTO THE RECORD DRAWINGS.

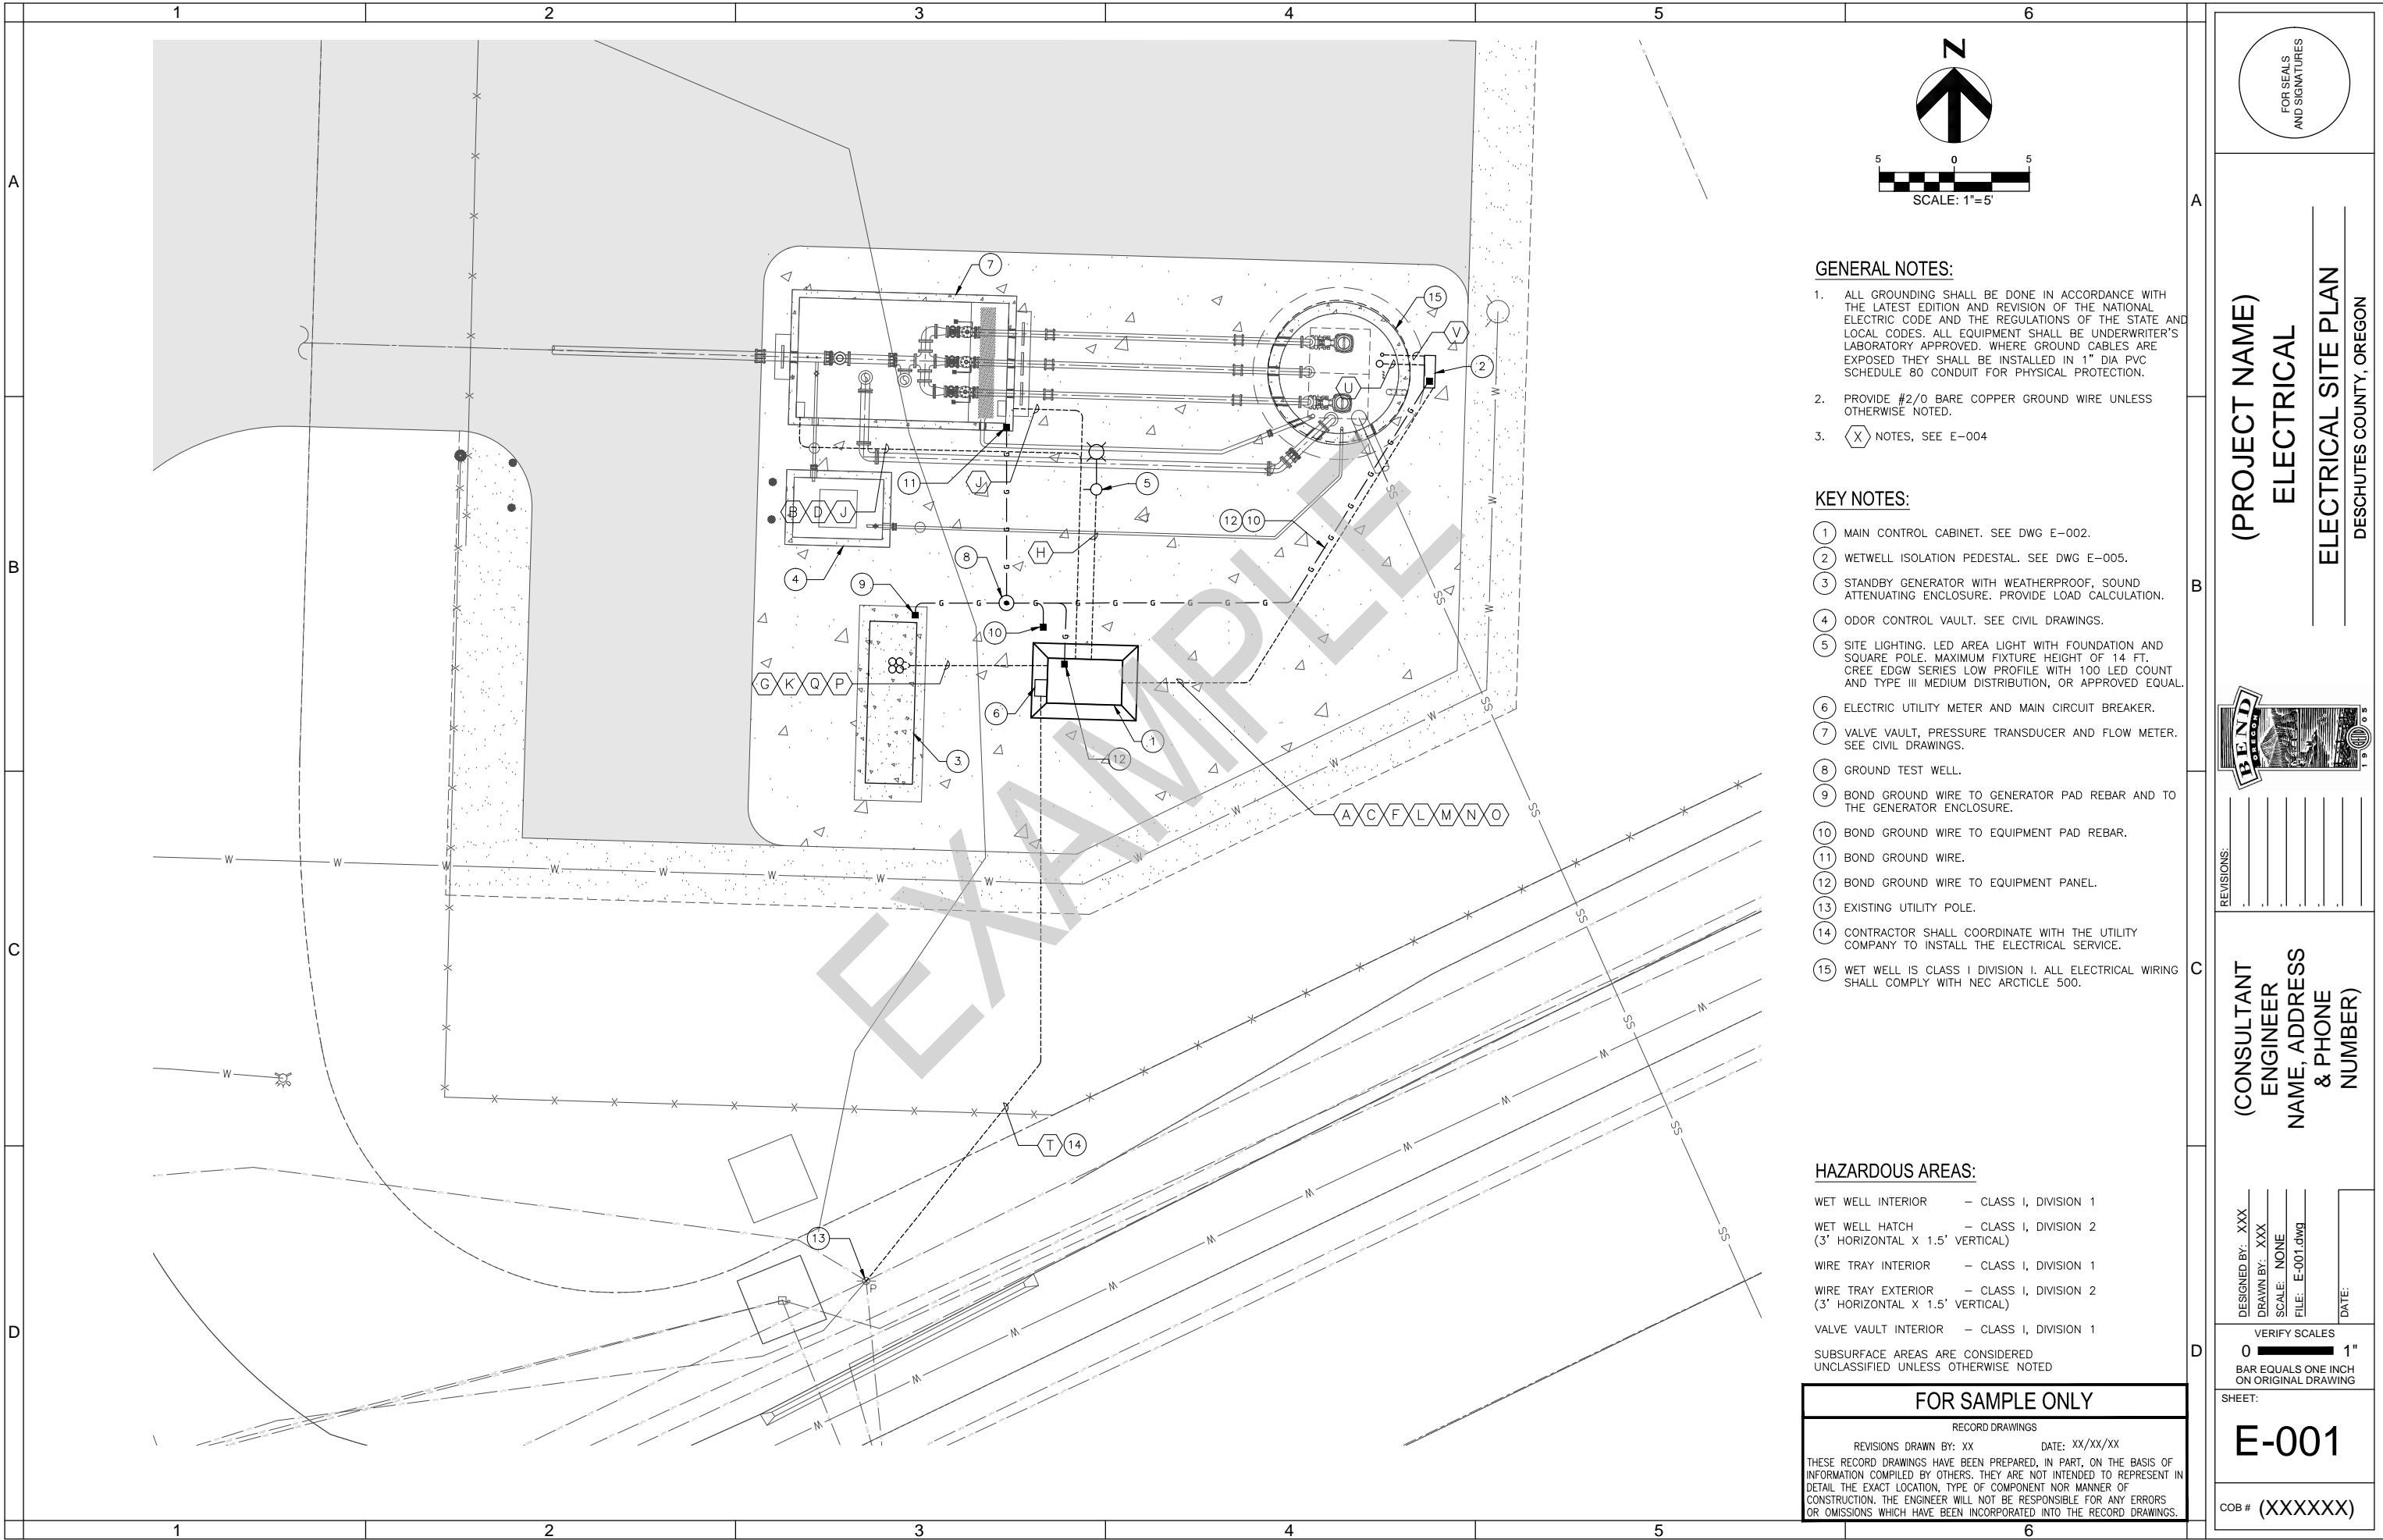

GENERAL NOTES:

- ALL GROUNDING SHALL BE DONE IN ACCORDANCE WITH THE LATEST EDITION AND REVISION OF THE NATIONAL ELECTRIC CODE AND THE REGULATIONS OF THE STATE AND LOCAL CODES. ALL EQUIPMENT SHALL BE UNDERWRITER'S LABORATORY APPROVED. WHERE GROUND CABLES ARE EXPOSED THEY SHALL BE INSTALLED IN 1" DIA PVC SCHEDULE 80 CONDUIT FOR PHYSICAL PROTECTION.
- PROVIDE #2/0 BARE COPPER GROUND WIRE UNLESS OTHERWISE NOTED.
- (X) NOTES, SEE E-004

KEY NOTES:

- MAIN CONTROL CABINET. SEE DWG E-002.
- WETWELL ISOLATION PEDESTAL. SEE DWG E-005.
- STANDBY GENERATOR WITH WEATHERPROOF, SOUND ATTENUATING ENCLOSURE. PROVIDE LOAD CALCULATION.
- ODOR CONTROL VAULT. SEE CIVIL DRAWINGS.
- SITE LIGHTING. LED AREA LIGHT WITH FOUNDATION AND SQUARE POLE. MAXIMUM FIXTURE HEIGHT OF 14 FT. CREE EDGW SERIES LOW PROFILE WITH 100 LED COUNT AND TYPE III MEDIUM DISTRIBUTION, OR APPROVED EQUAL.
- ELECTRIC UTILITY METER AND MAIN CIRCUIT BREAKER.
- VALVE VAULT, PRESSURE TRANSDUCER AND FLOW METER. SEE CIVIL DRAWINGS.
- GROUND TEST WELL.
- BOND GROUND WIRE TO GENERATOR PAD REBAR AND TO THE GENERATOR ENCLOSURE.
- BOND GROUND WIRE TO EQUIPMENT PAD REBAR.
- BOND GROUND WIRE.
- BOND GROUND WIRE TO EQUIPMENT PANEL.
- EXISTING UTILITY POLE.
- CONTRACTOR SHALL COORDINATE WITH THE UTILITY COMPANY TO INSTALL THE ELECTRICAL SERVICE.
- WET WELL IS CLASS I DIVISION I. ALL ELECTRICAL WIRING SHALL COMPLY WITH NEC ARTICLE 500.

HAZARDOUS AREAS:

- WET WELL INTERIOR - CLASS I, DIVISION 1
WET WELL HATCH - CLASS I, DIVISION 2 (3' HORIZONTAL X 1.5' VERTICAL)
WIRE TRAY INTERIOR - CLASS I, DIVISION 1
WIRE TRAY EXTERIOR - CLASS I, DIVISION 2 (3' HORIZONTAL X 1.5' VERTICAL)
VALVE VAULT INTERIOR - CLASS I, DIVISION 1

SUBSURFACE AREAS ARE CONSIDERED UNCLASSIFIED UNLESS OTHERWISE NOTED

FOR SAMPLE ONLY

RECORD DRAWINGS

REVISIONS DRAWN BY: XX DATE: XX/XX/XX
THESE RECORD DRAWINGS HAVE BEEN PREPARED, IN PART, ON THE BASIS OF INFORMATION COMPILED BY OTHERS. THEY ARE NOT INTENDED TO REPRESENT IN DETAIL THE EXACT LOCATION, TYPE OF COMPONENT NOR MANNER OF CONSTRUCTION. THE ENGINEER WILL NOT BE RESPONSIBLE FOR ANY ERRORS OR OMISSIONS WHICH HAVE BEEN INCORPORATED INTO THE RECORD DRAWINGS.

FOR SEALS
AND SIGNATURES

(PROJECT NAME)
ELECTRICAL
ELECTRICAL SITE PLAN
DESCHUTES COUNTY, OREGON



REVISIONS:


(CONSULTANT
ENGINEER
NAME, ADDRESS
& PHONE
NUMBER)

DESIGNED BY: XXX
DRAWN BY: XXX
SCALE: NONE
FILE: E-001.dwg
DATE:

VERIFY SCALES
0 1"
BAR EQUALS ONE INCH
ON ORIGINAL DRAWING

SHEET:
E-001

COB # (XXXXXX)

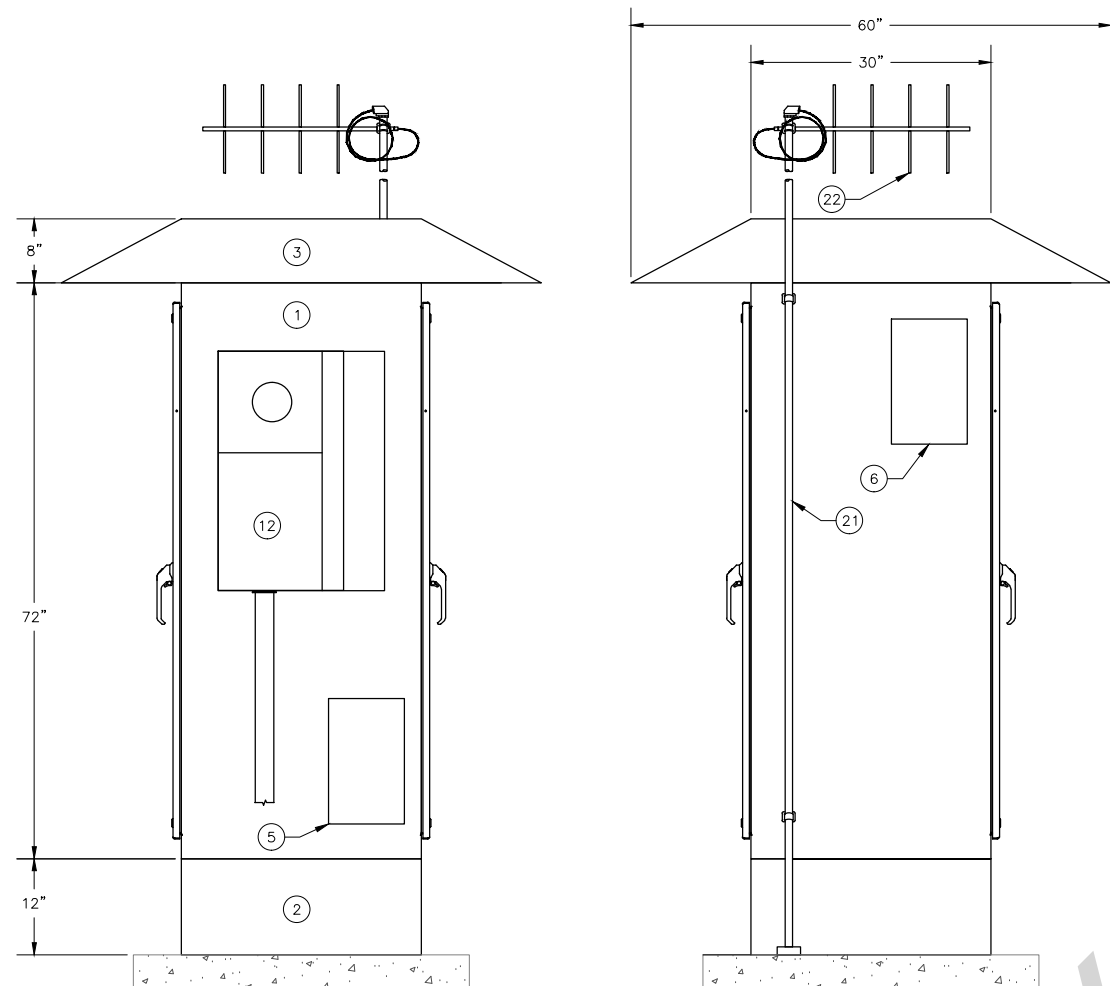


FOR SEALS
AND SIGNATURES



(CONSULTANT
ENGINEER
NAME, ADDRESS
& PHONE
NUMBER)

DESIGNED BY: XXX
DRAWN BY: XXX
SCALE: NONE
FILE: E-002.dwg
DATE:

VERIFY SCALES
0  1"
BAR EQUALS ONE INCH
ON ORIGINAL DRAWING

SHEET: _____

E-002

OB # (XXXXXX)

	1	2	3	4	5	6																																																																																																																																													
A	<div><div>CONDUIT AND WIRE SCHEDULE</div><table><thead><tr><th>CONDUIT USE</th><th>CONDUIT DESIGNATION</th><th>CONDUIT SIZE</th><th>CONDUIT TYPE</th><th>CONDUCTOR SIZE AND NUMBER OF CONDUCTORS</th><th>CONDUIT FROM</th><th>CONDUIT TO</th></tr></thead><tbody><tr><td>FLOAT SWITCH LSHH WETWELL HATCH LIMIT SWITCH</td><td>A</td><td>1 INCH</td><td>PVC</td><td>6#14</td><td>THE MAIN CONTROL CABINET</td><td>THE ISOLATION PEDESTAL</td></tr><tr><td>FLOW SENSOR</td><td>B</td><td>1 INCH</td><td>PVC</td><td>MANUFACTURER CABLE</td><td>THE MAIN CONTROL CABINET</td><td>THE FLOW METER VAULT</td></tr><tr><td>SUBMERSIBLE LEVEL TRANSMITTER</td><td>C</td><td>3/4 INCH</td><td>PVC</td><td>MANUFACTURER CABLE</td><td>THE MAIN CONTROL CABINET</td><td>THE ISOLATION PEDESTAL</td></tr><tr><td>VALVE VAULT HATCH LIMIT SWITCH</td><td>D</td><td>1 INCH</td><td>PVC</td><td>3#14</td><td>THE MAIN CONTROL CABINET</td><td>THE FLOW METER VAULT</td></tr><tr><td>SEAL FAIL / OVER TEMP</td><td>E</td><td>1 INCH</td><td>PVC</td><td>8#14</td><td>THE MAIN CONTROL CABINET</td><td>THE ISOLATION PEDESTAL</td></tr><tr><td>GENERATOR CONTROL SIGNALS (ATS)</td><td>F</td><td>1 INCH</td><td>PVC</td><td>8#14</td><td>THE MAIN CONTROL CABINET</td><td>THE GENERATOR</td></tr><tr><td>OUTSIDE AREA LIGHT</td><td>G</td><td>1 INCH</td><td>PVC</td><td>2#12, 1#12G</td><td>THE MAIN CONTROL CABINET</td><td>THE LIGHT POLE</td></tr><tr><td>VALVE VAULT SPARE</td><td>H</td><td>1 INCH</td><td>PVC</td><td>PULL CORD</td><td>THE MAIN CONTROL CABINET</td><td>THE VALVE VAULT</td></tr><tr><td>GENERATOR BATTERY CHARGER / BLOCK HEATER</td><td>I</td><td>1 INCH</td><td>PVC</td><td>4#10, 2#10G</td><td>THE MAIN CONTROL CABINET</td><td>THE GENERATOR</td></tr><tr><td>ISOLATION PEDESTAL HEATER</td><td>J</td><td>1 INCH</td><td>PVC</td><td>2#12, 1#12G</td><td>THE MAIN CONTROL CABINET</td><td>THE ISOLATION PEDESTAL</td></tr><tr><td>PUMP #1</td><td>K</td><td>1 INCH</td><td>PVC</td><td>3#8, 1#10G</td><td>THE MAIN CONTROL CABINET</td><td>THE ISOLATION PEDESTAL</td></tr><tr><td>PUMP #2</td><td>L</td><td>1 INCH</td><td>PVC</td><td>3#8, 1#10G</td><td>THE MAIN CONTROL CABINET</td><td>THE ISOLATION PEDESTAL</td></tr><tr><td>PUMP #3 (FUTURE)</td><td>M</td><td>1 INCH</td><td>PVC</td><td>3#8, 1#10G</td><td>THE MAIN CONTROL CABINET</td><td>THE ISOLATION PEDESTAL</td></tr><tr><td>GENERATOR MONITORING SIGNALS (PLC)</td><td>N</td><td>1 INCH</td><td>PVC</td><td>8#14</td><td>THE MAIN CONTROL CABINET</td><td>THE GENERATOR</td></tr><tr><td>GENERATOR POWER</td><td>O</td><td>2 INCH</td><td>PVC</td><td>3#1/0, 1#6G</td><td>THE MAIN CONTROL CABINET</td><td>THE GENERATOR</td></tr><tr><td>UNDERGROUND SERVICE</td><td>P</td><td>3 INCH</td><td>PVC</td><td>PULL ROPE</td><td>UNDERGROUND SERVICE</td><td>MAIN CONTROL ENCLOSURE PAD</td></tr><tr><td>SUBMERSIBLE LEVEL TRANSMITTER</td><td>Q</td><td>1 INCH</td><td>PGRC</td><td>MANUFACTURER CABLE</td><td>THE WET WELL</td><td>THE ISOLATION PEDESTAL</td></tr><tr><td>FLOAT SWITCH LSHH</td><td>R</td><td>3/4 INCH</td><td>PGRC</td><td>MANUFACTURER CABLE</td><td>THE WET WELL</td><td>THE ISOLATION PEDESTAL</td></tr><tr><td>ANTENNA SUPPORT</td><td>W</td><td>2 INCH</td><td>PGRC</td><td>MANUFACTURER CABLE</td><td>THE MAIN CONTROL CABINET</td><td>WEATHER HEAD</td></tr></tbody></table></div>						CONDUIT USE	CONDUIT DESIGNATION	CONDUIT SIZE	CONDUIT TYPE	CONDUCTOR SIZE AND NUMBER OF CONDUCTORS	CONDUIT FROM	CONDUIT TO	FLOAT SWITCH LSHH WETWELL HATCH LIMIT SWITCH	A	1 INCH	PVC	6#14	THE MAIN CONTROL CABINET	THE ISOLATION PEDESTAL	FLOW SENSOR	B	1 INCH	PVC	MANUFACTURER CABLE	THE MAIN CONTROL CABINET	THE FLOW METER VAULT	SUBMERSIBLE LEVEL TRANSMITTER	C	3/4 INCH	PVC	MANUFACTURER CABLE	THE MAIN CONTROL CABINET	THE ISOLATION PEDESTAL	VALVE VAULT HATCH LIMIT SWITCH	D	1 INCH	PVC	3#14	THE MAIN CONTROL CABINET	THE FLOW METER VAULT	SEAL FAIL / OVER TEMP	E	1 INCH	PVC	8#14	THE MAIN CONTROL CABINET	THE ISOLATION PEDESTAL	GENERATOR CONTROL SIGNALS (ATS)	F	1 INCH	PVC	8#14	THE MAIN CONTROL CABINET	THE GENERATOR	OUTSIDE AREA LIGHT	G	1 INCH	PVC	2#12, 1#12G	THE MAIN CONTROL CABINET	THE LIGHT POLE	VALVE VAULT SPARE	H	1 INCH	PVC	PULL CORD	THE MAIN CONTROL CABINET	THE VALVE VAULT	GENERATOR BATTERY CHARGER / BLOCK HEATER	I	1 INCH	PVC	4#10, 2#10G	THE MAIN CONTROL CABINET	THE GENERATOR	ISOLATION PEDESTAL HEATER	J	1 INCH	PVC	2#12, 1#12G	THE MAIN CONTROL CABINET	THE ISOLATION PEDESTAL	PUMP #1	K	1 INCH	PVC	3#8, 1#10G	THE MAIN CONTROL CABINET	THE ISOLATION PEDESTAL	PUMP #2	L	1 INCH	PVC	3#8, 1#10G	THE MAIN CONTROL CABINET	THE ISOLATION PEDESTAL	PUMP #3 (FUTURE)	M	1 INCH	PVC	3#8, 1#10G	THE MAIN CONTROL CABINET	THE ISOLATION PEDESTAL	GENERATOR MONITORING SIGNALS (PLC)	N	1 INCH	PVC	8#14	THE MAIN CONTROL CABINET	THE GENERATOR	GENERATOR POWER	O	2 INCH	PVC	3#1/0, 1#6G	THE MAIN CONTROL CABINET	THE GENERATOR	UNDERGROUND SERVICE	P	3 INCH	PVC	PULL ROPE	UNDERGROUND SERVICE	MAIN CONTROL ENCLOSURE PAD	SUBMERSIBLE LEVEL TRANSMITTER	Q	1 INCH	PGRC	MANUFACTURER CABLE	THE WET WELL	THE ISOLATION PEDESTAL	FLOAT SWITCH LSHH	R	3/4 INCH	PGRC	MANUFACTURER CABLE	THE WET WELL	THE ISOLATION PEDESTAL	ANTENNA SUPPORT	W	2 INCH	PGRC	MANUFACTURER CABLE	THE MAIN CONTROL CABINET	WEATHER HEAD	
CONDUIT USE	CONDUIT DESIGNATION	CONDUIT SIZE	CONDUIT TYPE	CONDUCTOR SIZE AND NUMBER OF CONDUCTORS	CONDUIT FROM	CONDUIT TO																																																																																																																																													
FLOAT SWITCH LSHH WETWELL HATCH LIMIT SWITCH	A	1 INCH	PVC	6#14	THE MAIN CONTROL CABINET	THE ISOLATION PEDESTAL																																																																																																																																													
FLOW SENSOR	B	1 INCH	PVC	MANUFACTURER CABLE	THE MAIN CONTROL CABINET	THE FLOW METER VAULT																																																																																																																																													
SUBMERSIBLE LEVEL TRANSMITTER	C	3/4 INCH	PVC	MANUFACTURER CABLE	THE MAIN CONTROL CABINET	THE ISOLATION PEDESTAL																																																																																																																																													
VALVE VAULT HATCH LIMIT SWITCH	D	1 INCH	PVC	3#14	THE MAIN CONTROL CABINET	THE FLOW METER VAULT																																																																																																																																													
SEAL FAIL / OVER TEMP	E	1 INCH	PVC	8#14	THE MAIN CONTROL CABINET	THE ISOLATION PEDESTAL																																																																																																																																													
GENERATOR CONTROL SIGNALS (ATS)	F	1 INCH	PVC	8#14	THE MAIN CONTROL CABINET	THE GENERATOR																																																																																																																																													
OUTSIDE AREA LIGHT	G	1 INCH	PVC	2#12, 1#12G	THE MAIN CONTROL CABINET	THE LIGHT POLE																																																																																																																																													
VALVE VAULT SPARE	H	1 INCH	PVC	PULL CORD	THE MAIN CONTROL CABINET	THE VALVE VAULT																																																																																																																																													
GENERATOR BATTERY CHARGER / BLOCK HEATER	I	1 INCH	PVC	4#10, 2#10G	THE MAIN CONTROL CABINET	THE GENERATOR																																																																																																																																													
ISOLATION PEDESTAL HEATER	J	1 INCH	PVC	2#12, 1#12G	THE MAIN CONTROL CABINET	THE ISOLATION PEDESTAL																																																																																																																																													
PUMP #1	K	1 INCH	PVC	3#8, 1#10G	THE MAIN CONTROL CABINET	THE ISOLATION PEDESTAL																																																																																																																																													
PUMP #2	L	1 INCH	PVC	3#8, 1#10G	THE MAIN CONTROL CABINET	THE ISOLATION PEDESTAL																																																																																																																																													
PUMP #3 (FUTURE)	M	1 INCH	PVC	3#8, 1#10G	THE MAIN CONTROL CABINET	THE ISOLATION PEDESTAL																																																																																																																																													
GENERATOR MONITORING SIGNALS (PLC)	N	1 INCH	PVC	8#14	THE MAIN CONTROL CABINET	THE GENERATOR																																																																																																																																													
GENERATOR POWER	O	2 INCH	PVC	3#1/0, 1#6G	THE MAIN CONTROL CABINET	THE GENERATOR																																																																																																																																													
UNDERGROUND SERVICE	P	3 INCH	PVC	PULL ROPE	UNDERGROUND SERVICE	MAIN CONTROL ENCLOSURE PAD																																																																																																																																													
SUBMERSIBLE LEVEL TRANSMITTER	Q	1 INCH	PGRC	MANUFACTURER CABLE	THE WET WELL	THE ISOLATION PEDESTAL																																																																																																																																													
FLOAT SWITCH LSHH	R	3/4 INCH	PGRC	MANUFACTURER CABLE	THE WET WELL	THE ISOLATION PEDESTAL																																																																																																																																													
ANTENNA SUPPORT	W	2 INCH	PGRC	MANUFACTURER CABLE	THE MAIN CONTROL CABINET	WEATHER HEAD																																																																																																																																													
B																																																																																																																																																			
C																																																																																																																																																			
D																																																																																																																																																			
	1	2	3	4	5	6																																																																																																																																													

GENERAL NOTES: (CONDUIT INSTALLATION)

1. ALL STRUT AND MOUNTING HARDWARE MUST BE STAINLESS STEEL.

2. MYERS HUB FITTING MUST BE USED ON ALL CONDUIT PENETRATIONS.

3. ALL CONDUIT MUST BE SCHEDULE 80 PVC.

4. THE PROPER TOOLS MUST BE USED WHILE CUTTING, THREADING, BENDING, AND TIGHTENING ANY PVC COATED CONDUIT.

5. THE PVE COATING MUST REMAIN INTACT ONLY 1 INCH OF THE COATING MAY BE REMOVED AT THE END OF THE CONDUIT TO ALLOW FOR THE THREAD.

6. ANY CONDUIT WITH THE DAMAGED COATING MUST BE REPLACED.

7. THE COATING TOUCH UP PAINT IS ONLY TO BE USED FOR COSMETIC BLEMISHES.

8. ALL THREADED CONNECTIONS MUST BE COPPER COATED AND TIGHTENED APPROPRIATELY.

9. ALL UNDERGROUND CONDUIT RUNS MUST BE INSPECTED PRIOR TO BACKFILL.

FOR SAMPLE ONLY

RECORD DRAWINGS

REVISIONS DRAWN BY: XX DATE: XX/XX/XX

THESE RECORD DRAWINGS HAVE BEEN PREPARED, IN PART, ON THE BASIS OF INFORMATION COMPILED BY OTHERS. THEY ARE NOT INTENDED TO REPRESENT IN DETAIL THE EXACT LOCATION, TYPE OF COMPONENT NOR MANNER OF CONSTRUCTION. THE ENGINEER WILL NOT BE RESPONSIBLE FOR ANY ERRORS OR OMISSIONS WHICH HAVE BEEN INCORPORATED INTO THE RECORD DRAWINGS.

FOR SEALS AND SIGNATURES

(PROJECT NAME)

INSTRUMENTATION & CONTROLS

CONDUIT AND WIRE SCHEDULE

DESCHUTES COUNTY, OREGON

REVISIONS:

(CONSULTANT ENGINEER NAME, ADDRESS & PHONE NUMBER)

DESIGNED BY: XXX
DRAWN BY: XXX
SCALE: NONE
FILE: E-004.dwg
DATE:

VERIFY SCALES

0 1"


BAR EQUALS ONE INCH ON ORIGINAL DRAWING


SHEET:

E-004

COB # (XXXXXXX)


SHEET X OF X

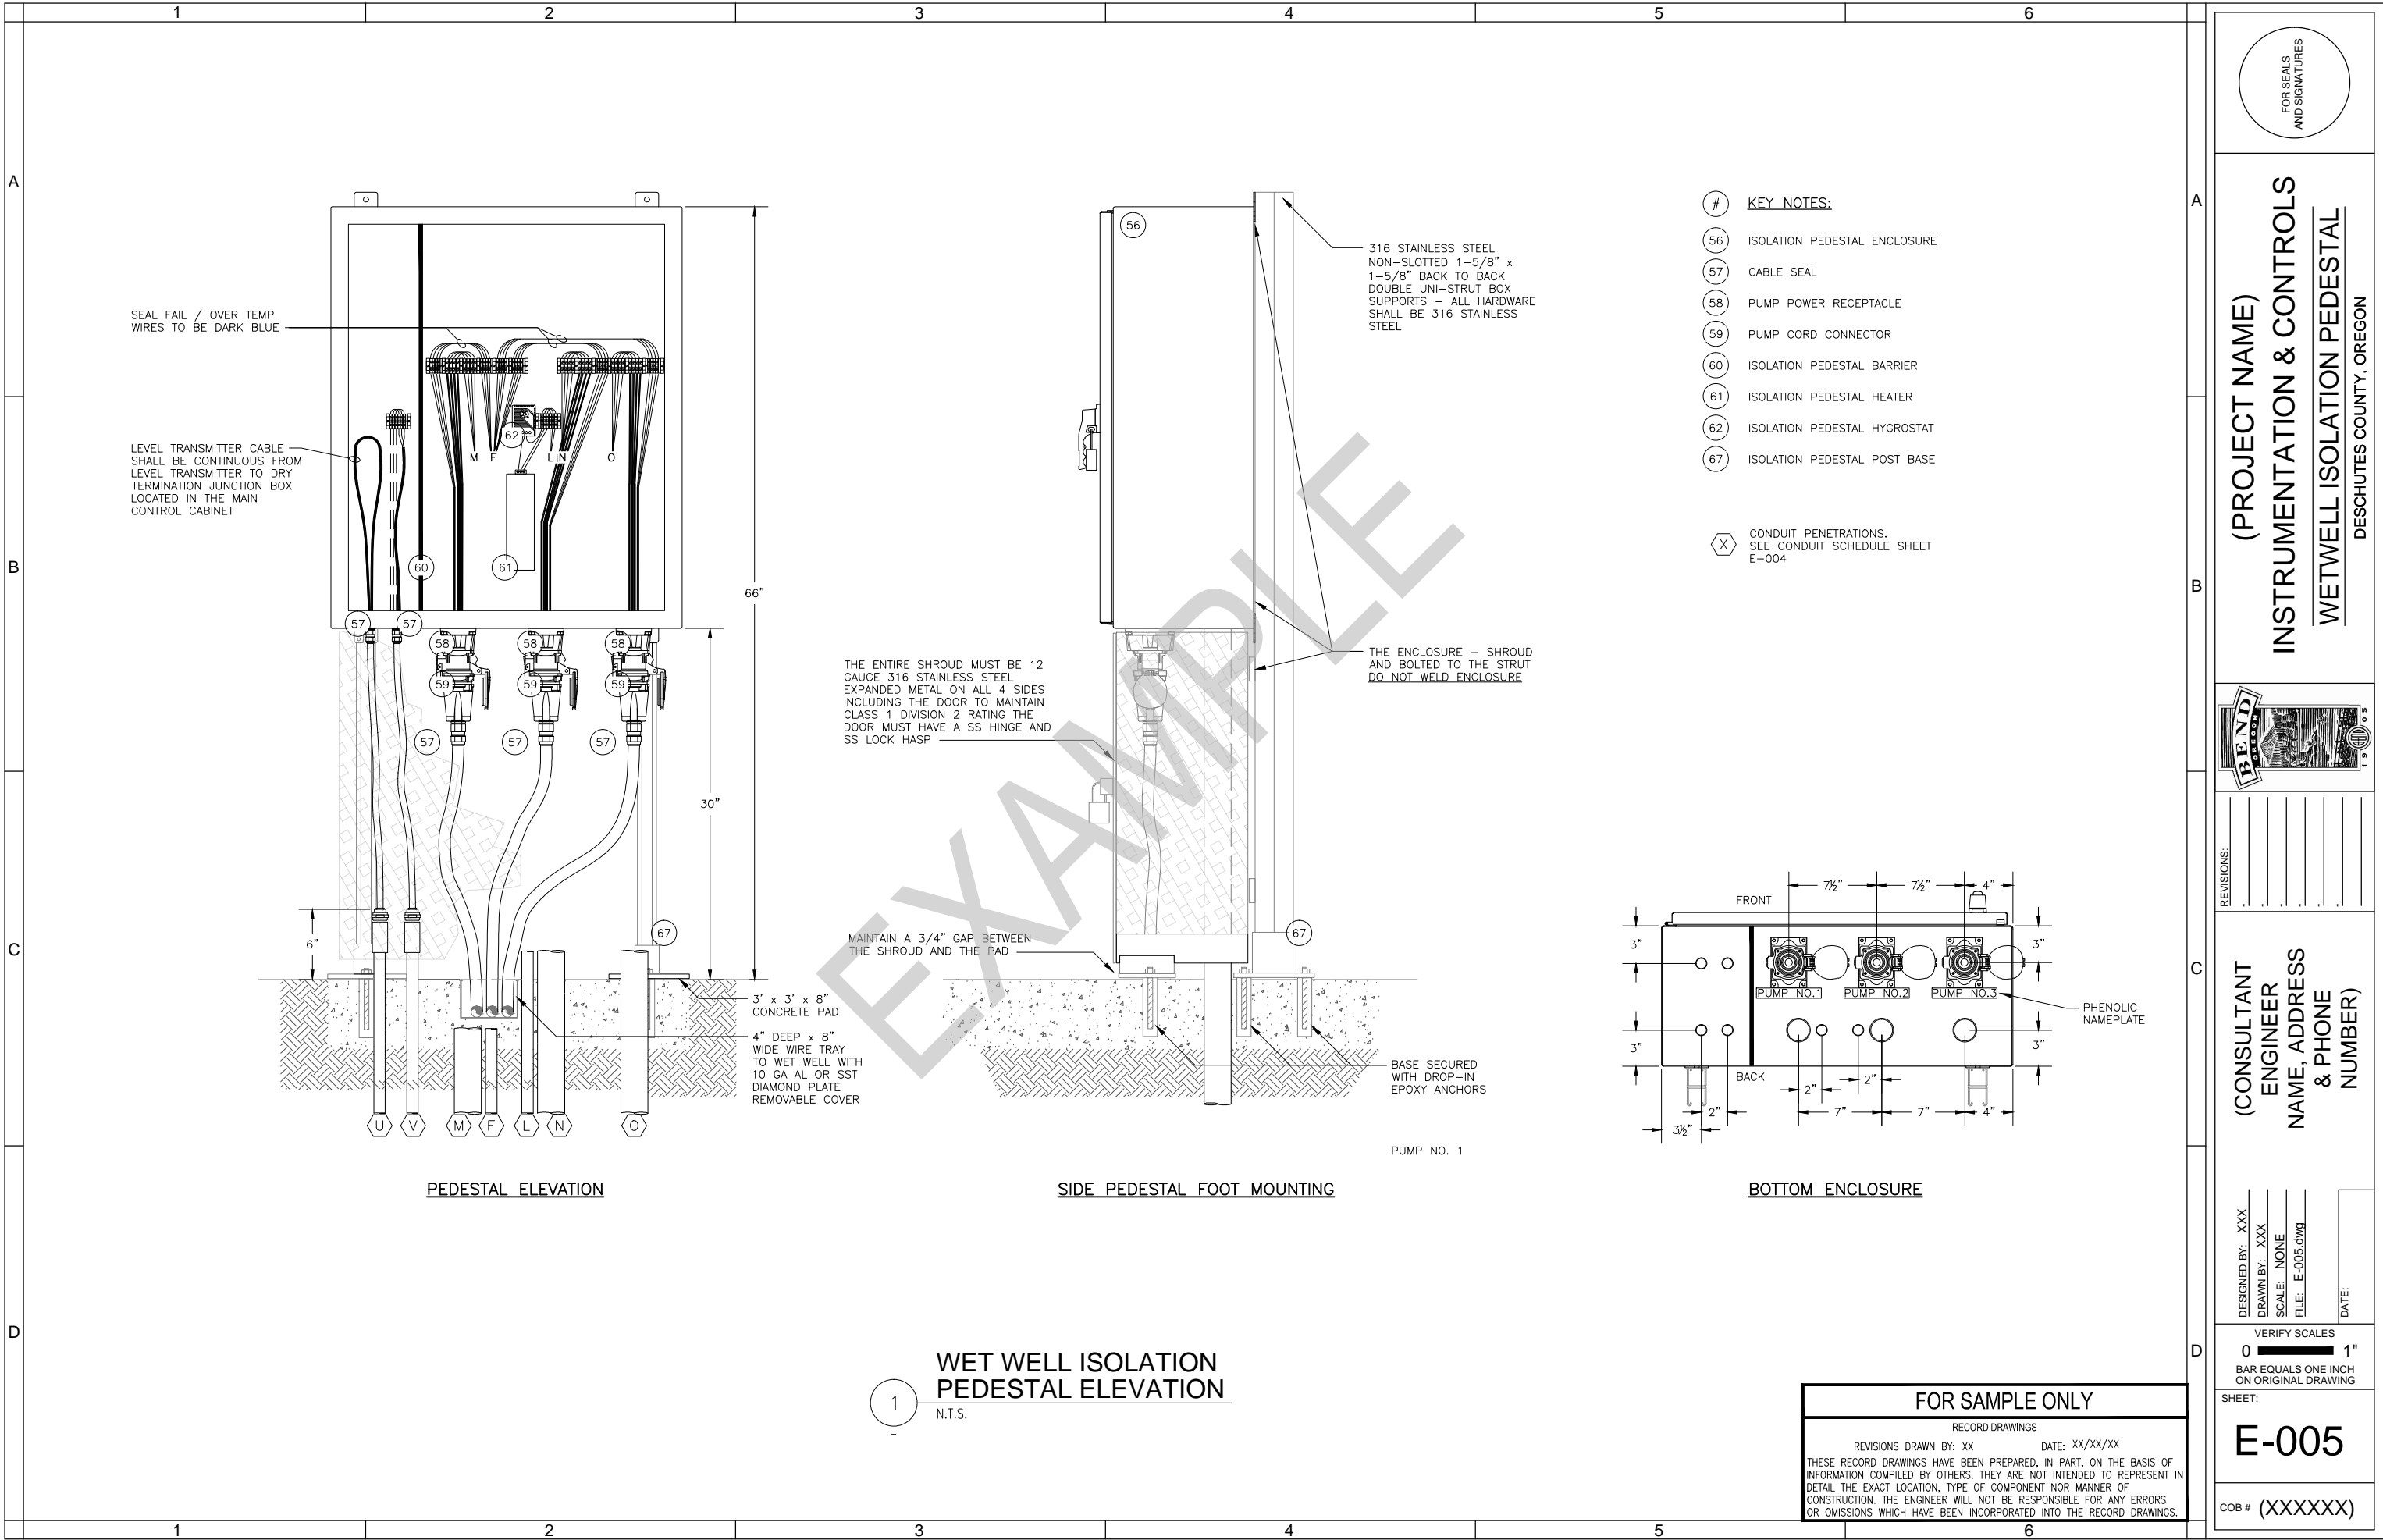

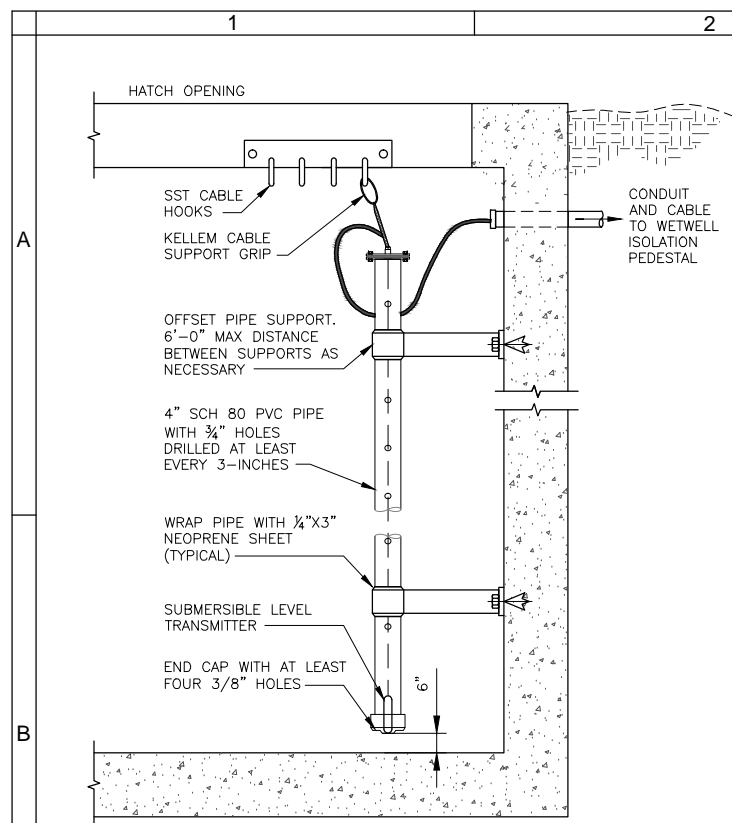


SUBMERSIBLE LEVEL TRANSMITTER

N.T.S.

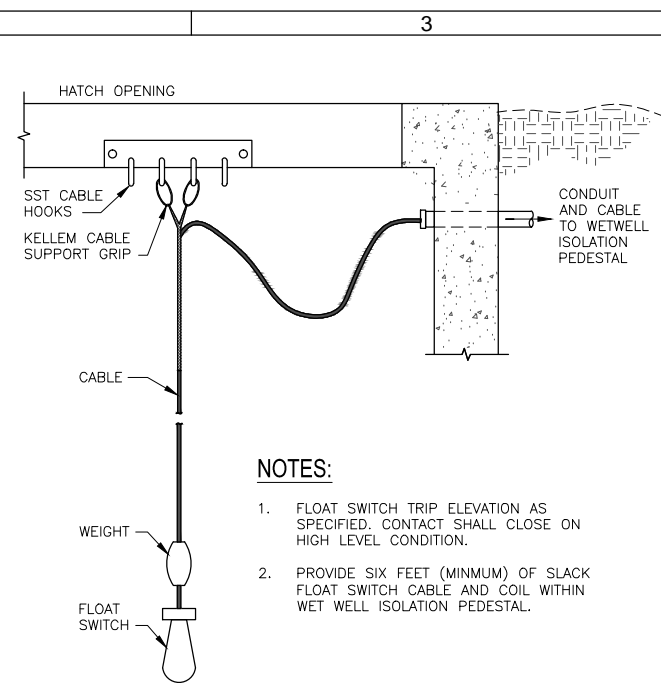


SUSPENDED FLOAT SWITCH

N.T.S.

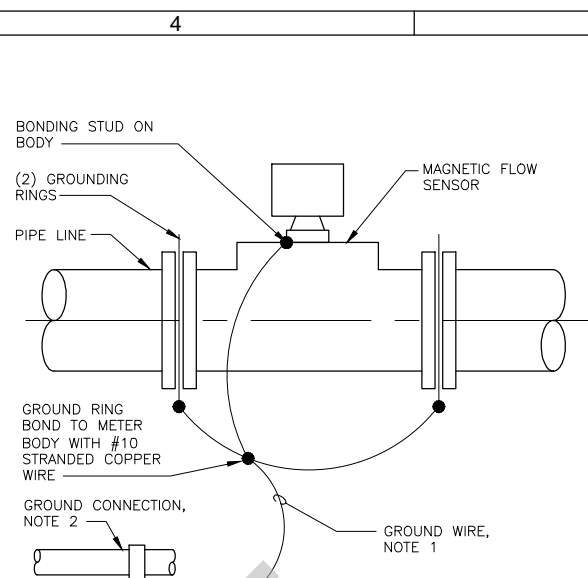

MAGNETIC FLOW METER GROUNDING RING BONDING


N.T.S.

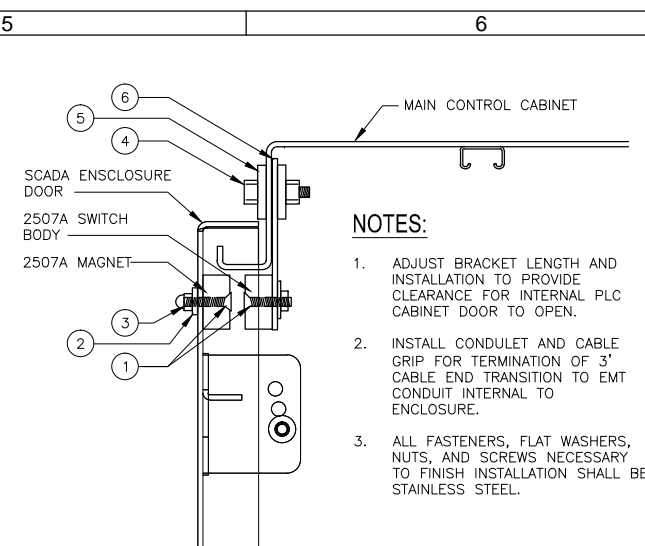

MAIN CONTROL CABINET INTRUSION SWITCH


N.T.S.

BILL OF MATERIALS	
ITEM	DESCRIPTION
1	8-32 $\frac{7}{8}$ " FLATHEAD MACHINE SCREW, STAINLESS STEEL
2	#8 BONDED SEALING WASHER, STAINLESS STEEL
3	8-32 ACORN NUT, STAINLESS STEEL
4	1/4"-28 x 3/4" HEX CAP SCREW, STAINLESS STEEL
5	1/4" BONDED SEALING WASHER, STAINLESS STEEL
6	ALUMINUM BRACKET, SHOP SUPPLIED

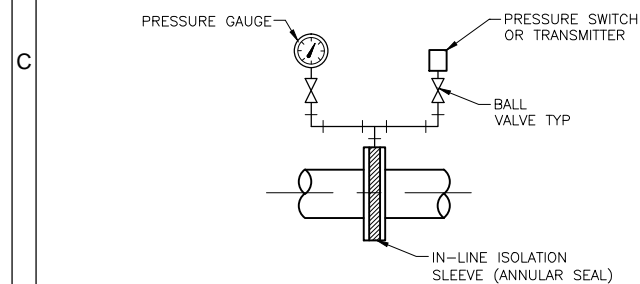


IN-LINE ISOLATION SLEEVE PRESSURE SWITCH/TRANSMITTER

N.T.S.

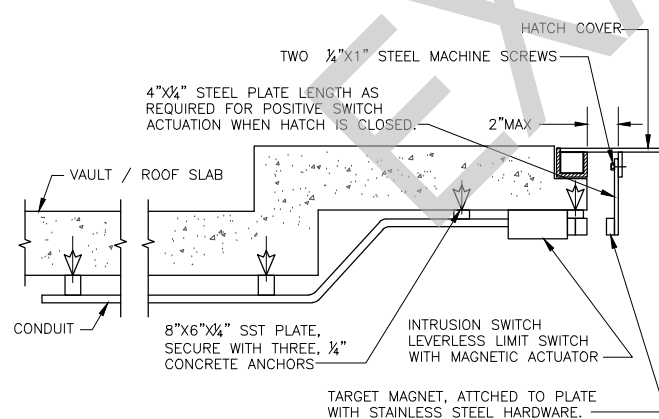

HATCH INTRUSION SWITCH INSTALLATION


N.T.S.

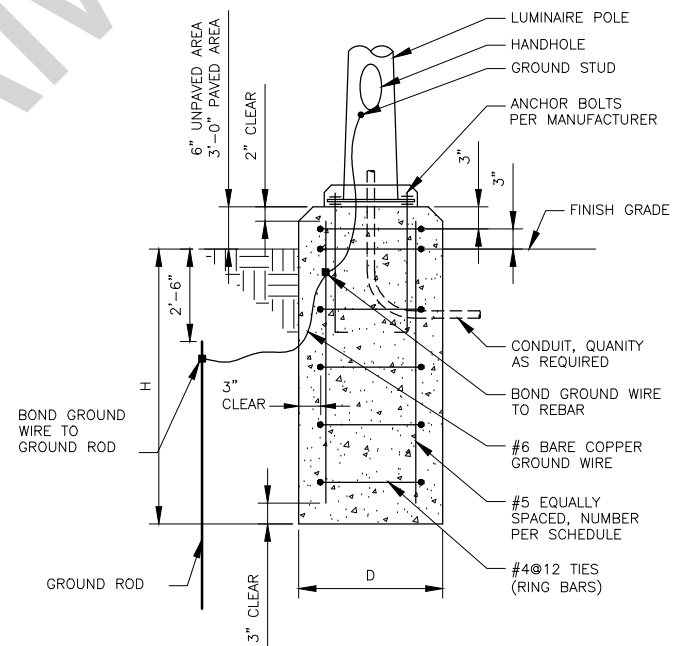

LIGHT STANDARD BASE

N.T.S.

DIMENSION SCHEDULE			
POLE HEIGHT	MINIMUM D	MINIMUM H	VERTICAL REBAR EACH
UP TO 10'	2'-0"	4'-6"	6
11' TO 20'	2'-0"	6'-6"	6

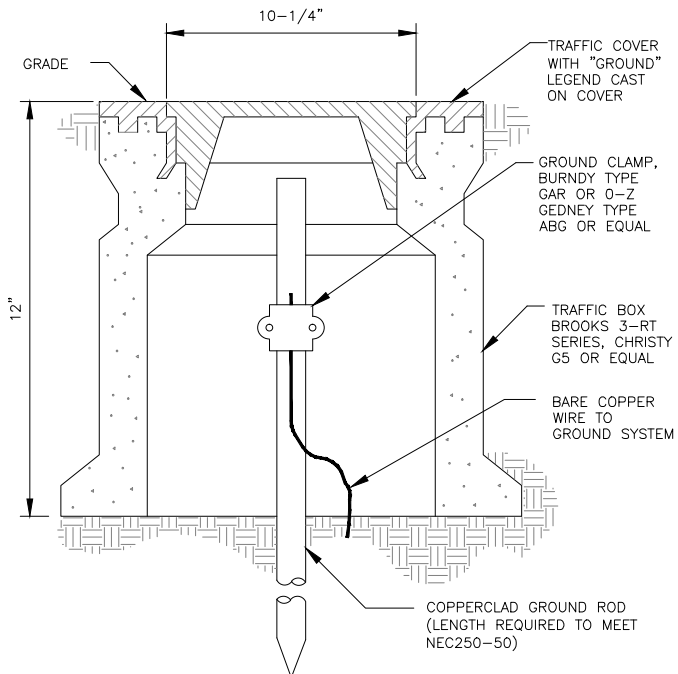

GROUND WELL AND ROD DETAIL

N.T.S.

FOR SAMPLE ONLY

RECORD DRAWINGS

REVISIONS DRAWN BY: XX DATE: XX/XX/XX

THESE RECORD DRAWINGS HAVE BEEN PREPARED, IN PART, ON THE BASIS OF INFORMATION COMPILED BY OTHERS. THEY ARE NOT INTENDED TO REPRESENT IN DETAIL THE EXACT LOCATION, TYPE OF COMPONENT NOR MANNER OF CONSTRUCTION. THE ENGINEER WILL NOT BE RESPONSIBLE FOR ANY ERRORS OR OMISSIONS WHICH HAVE BEEN INCORPORATED INTO THE RECORD DRAWINGS.

FOR SEALS
AND SIGNATURES

(PROJECT NAME)

INSTRUMENTATION & CONTROLS

ELECTRICAL DETAILS

DESCHUTES COUNTY, OREGON



REVISIONS:

(CONSULTANT
ENGINEER
NAME, ADDRESS
& PHONE
NUMBER)

DESIGNED BY: XXX
DRAWN BY: XXX
SCALE: NONE
FILE: E-006.dwg

VERIFY SCALES

0 [REDACTED]


BAR EQUALS ONE IN


BAR EQUALS ONE INCH
ON ORIGINAL DRAWING


SHEET:

E-006

COB # (XXXXXX)

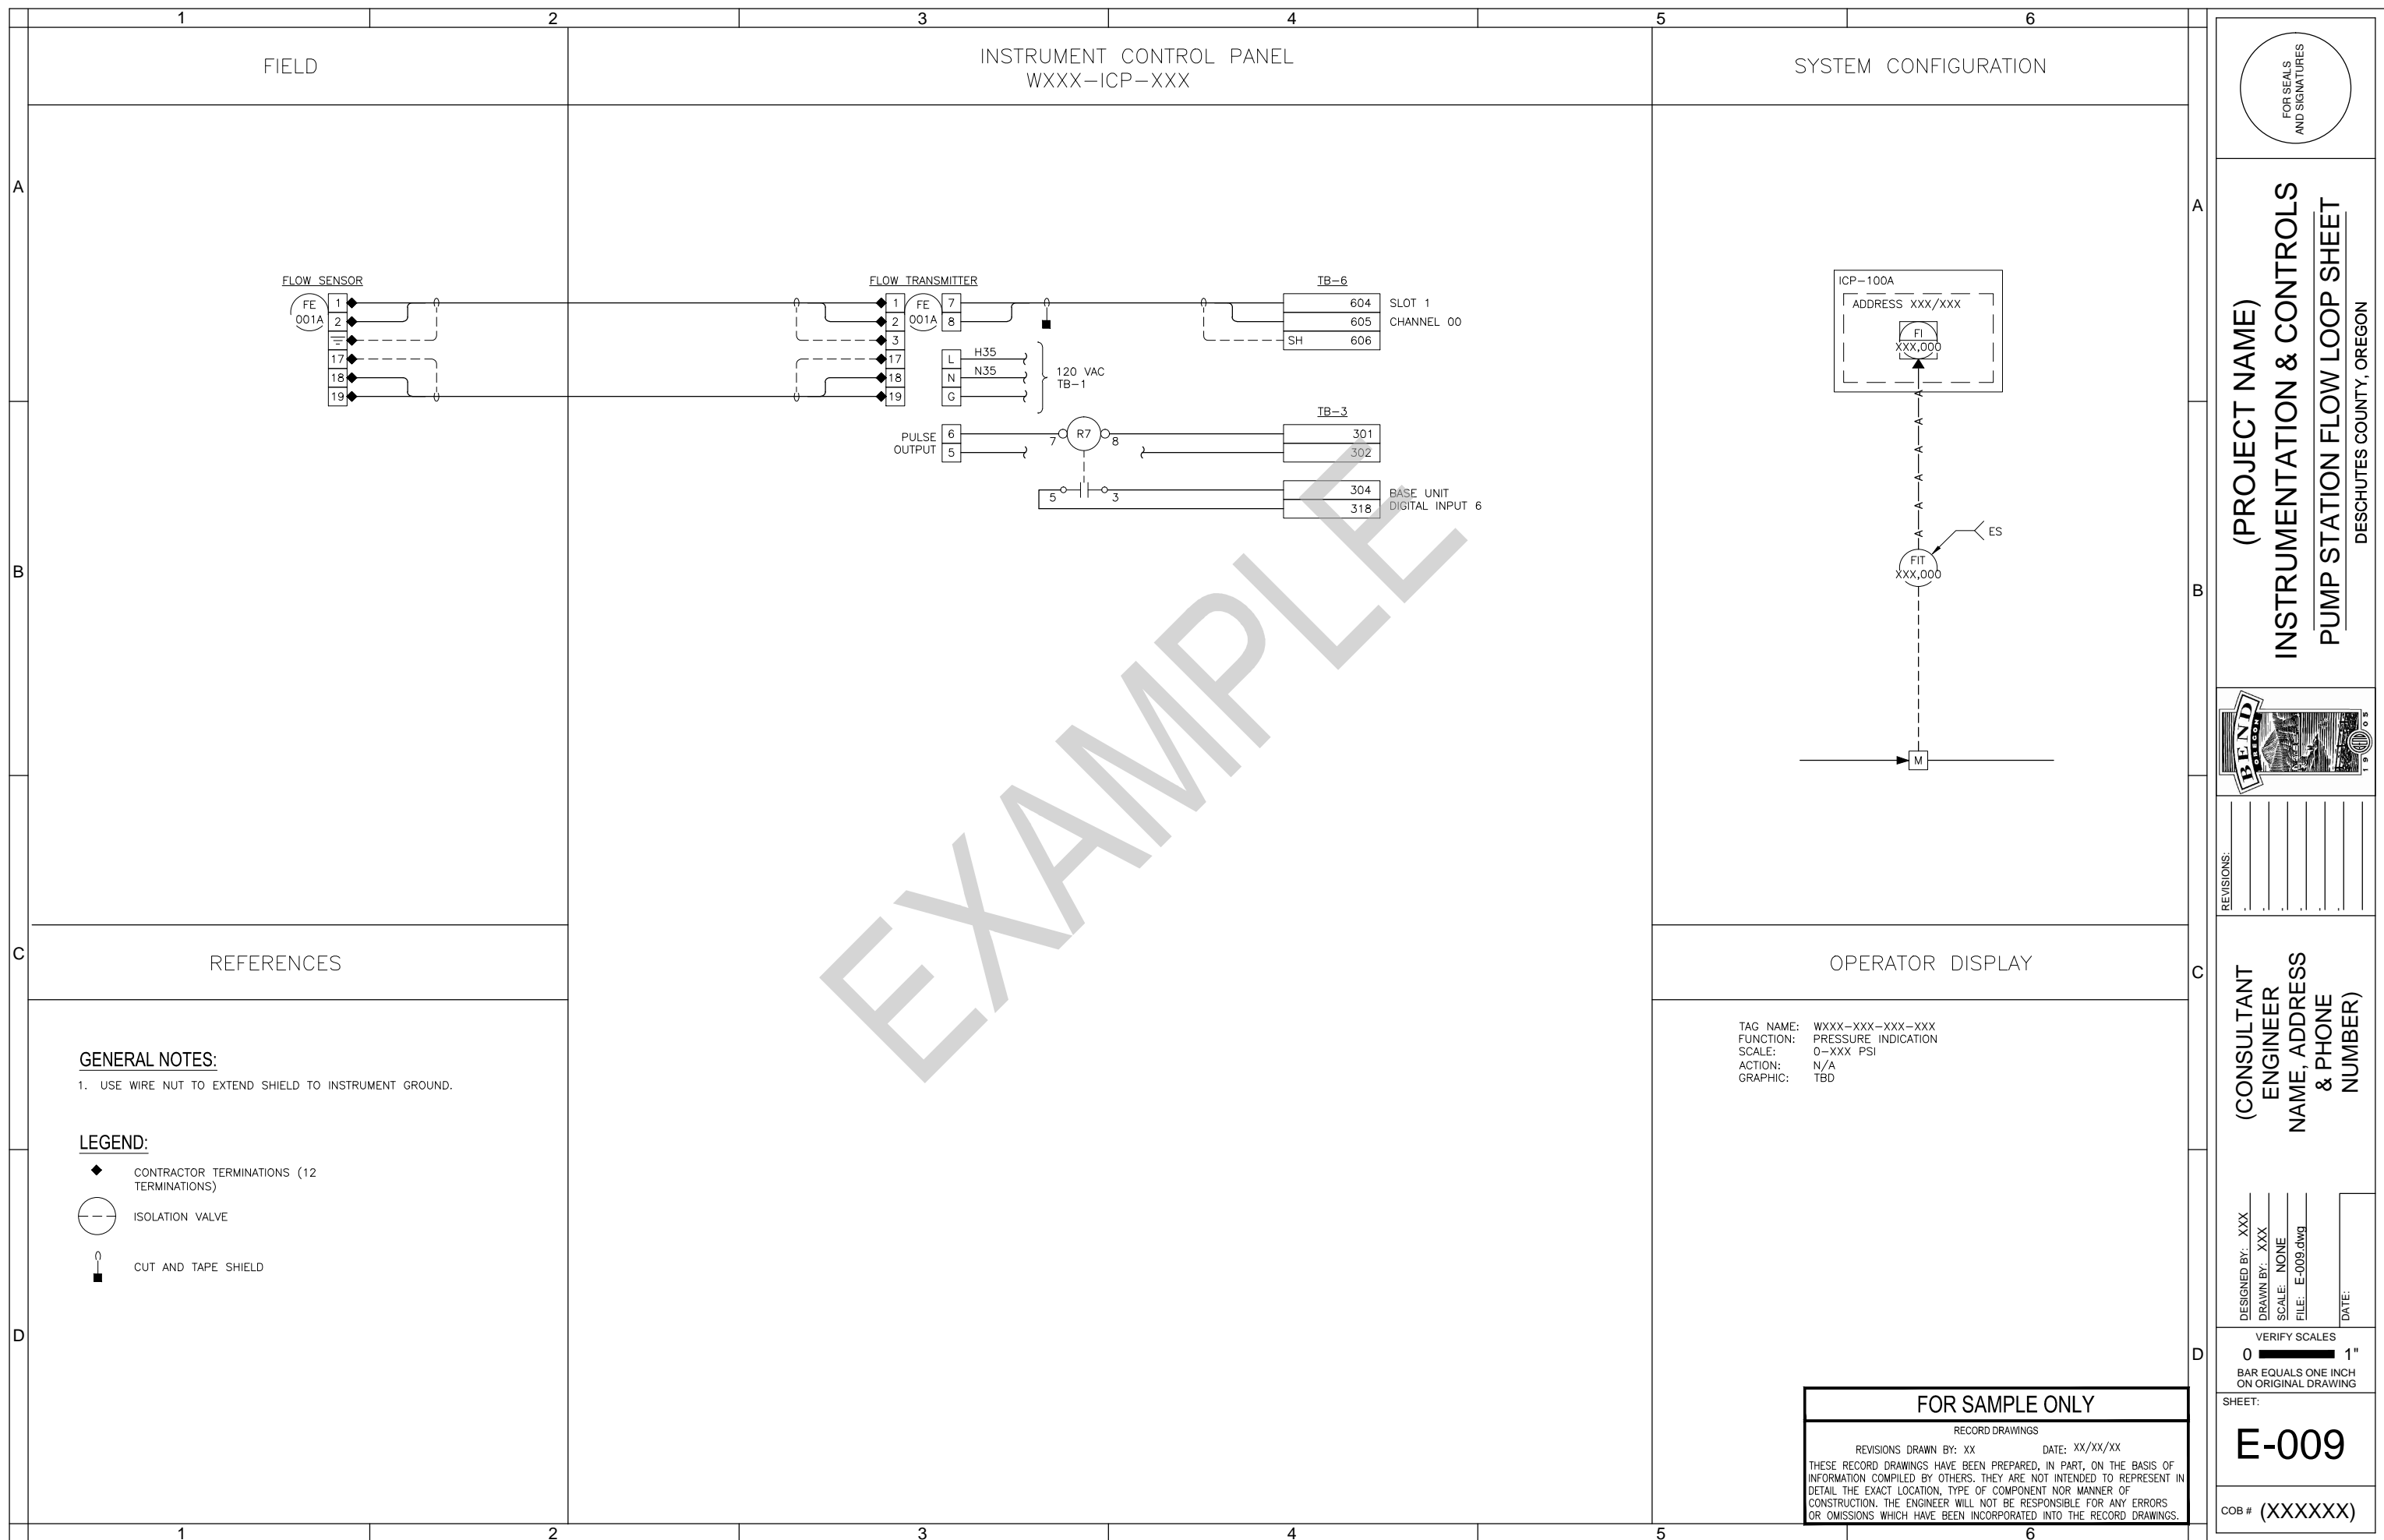

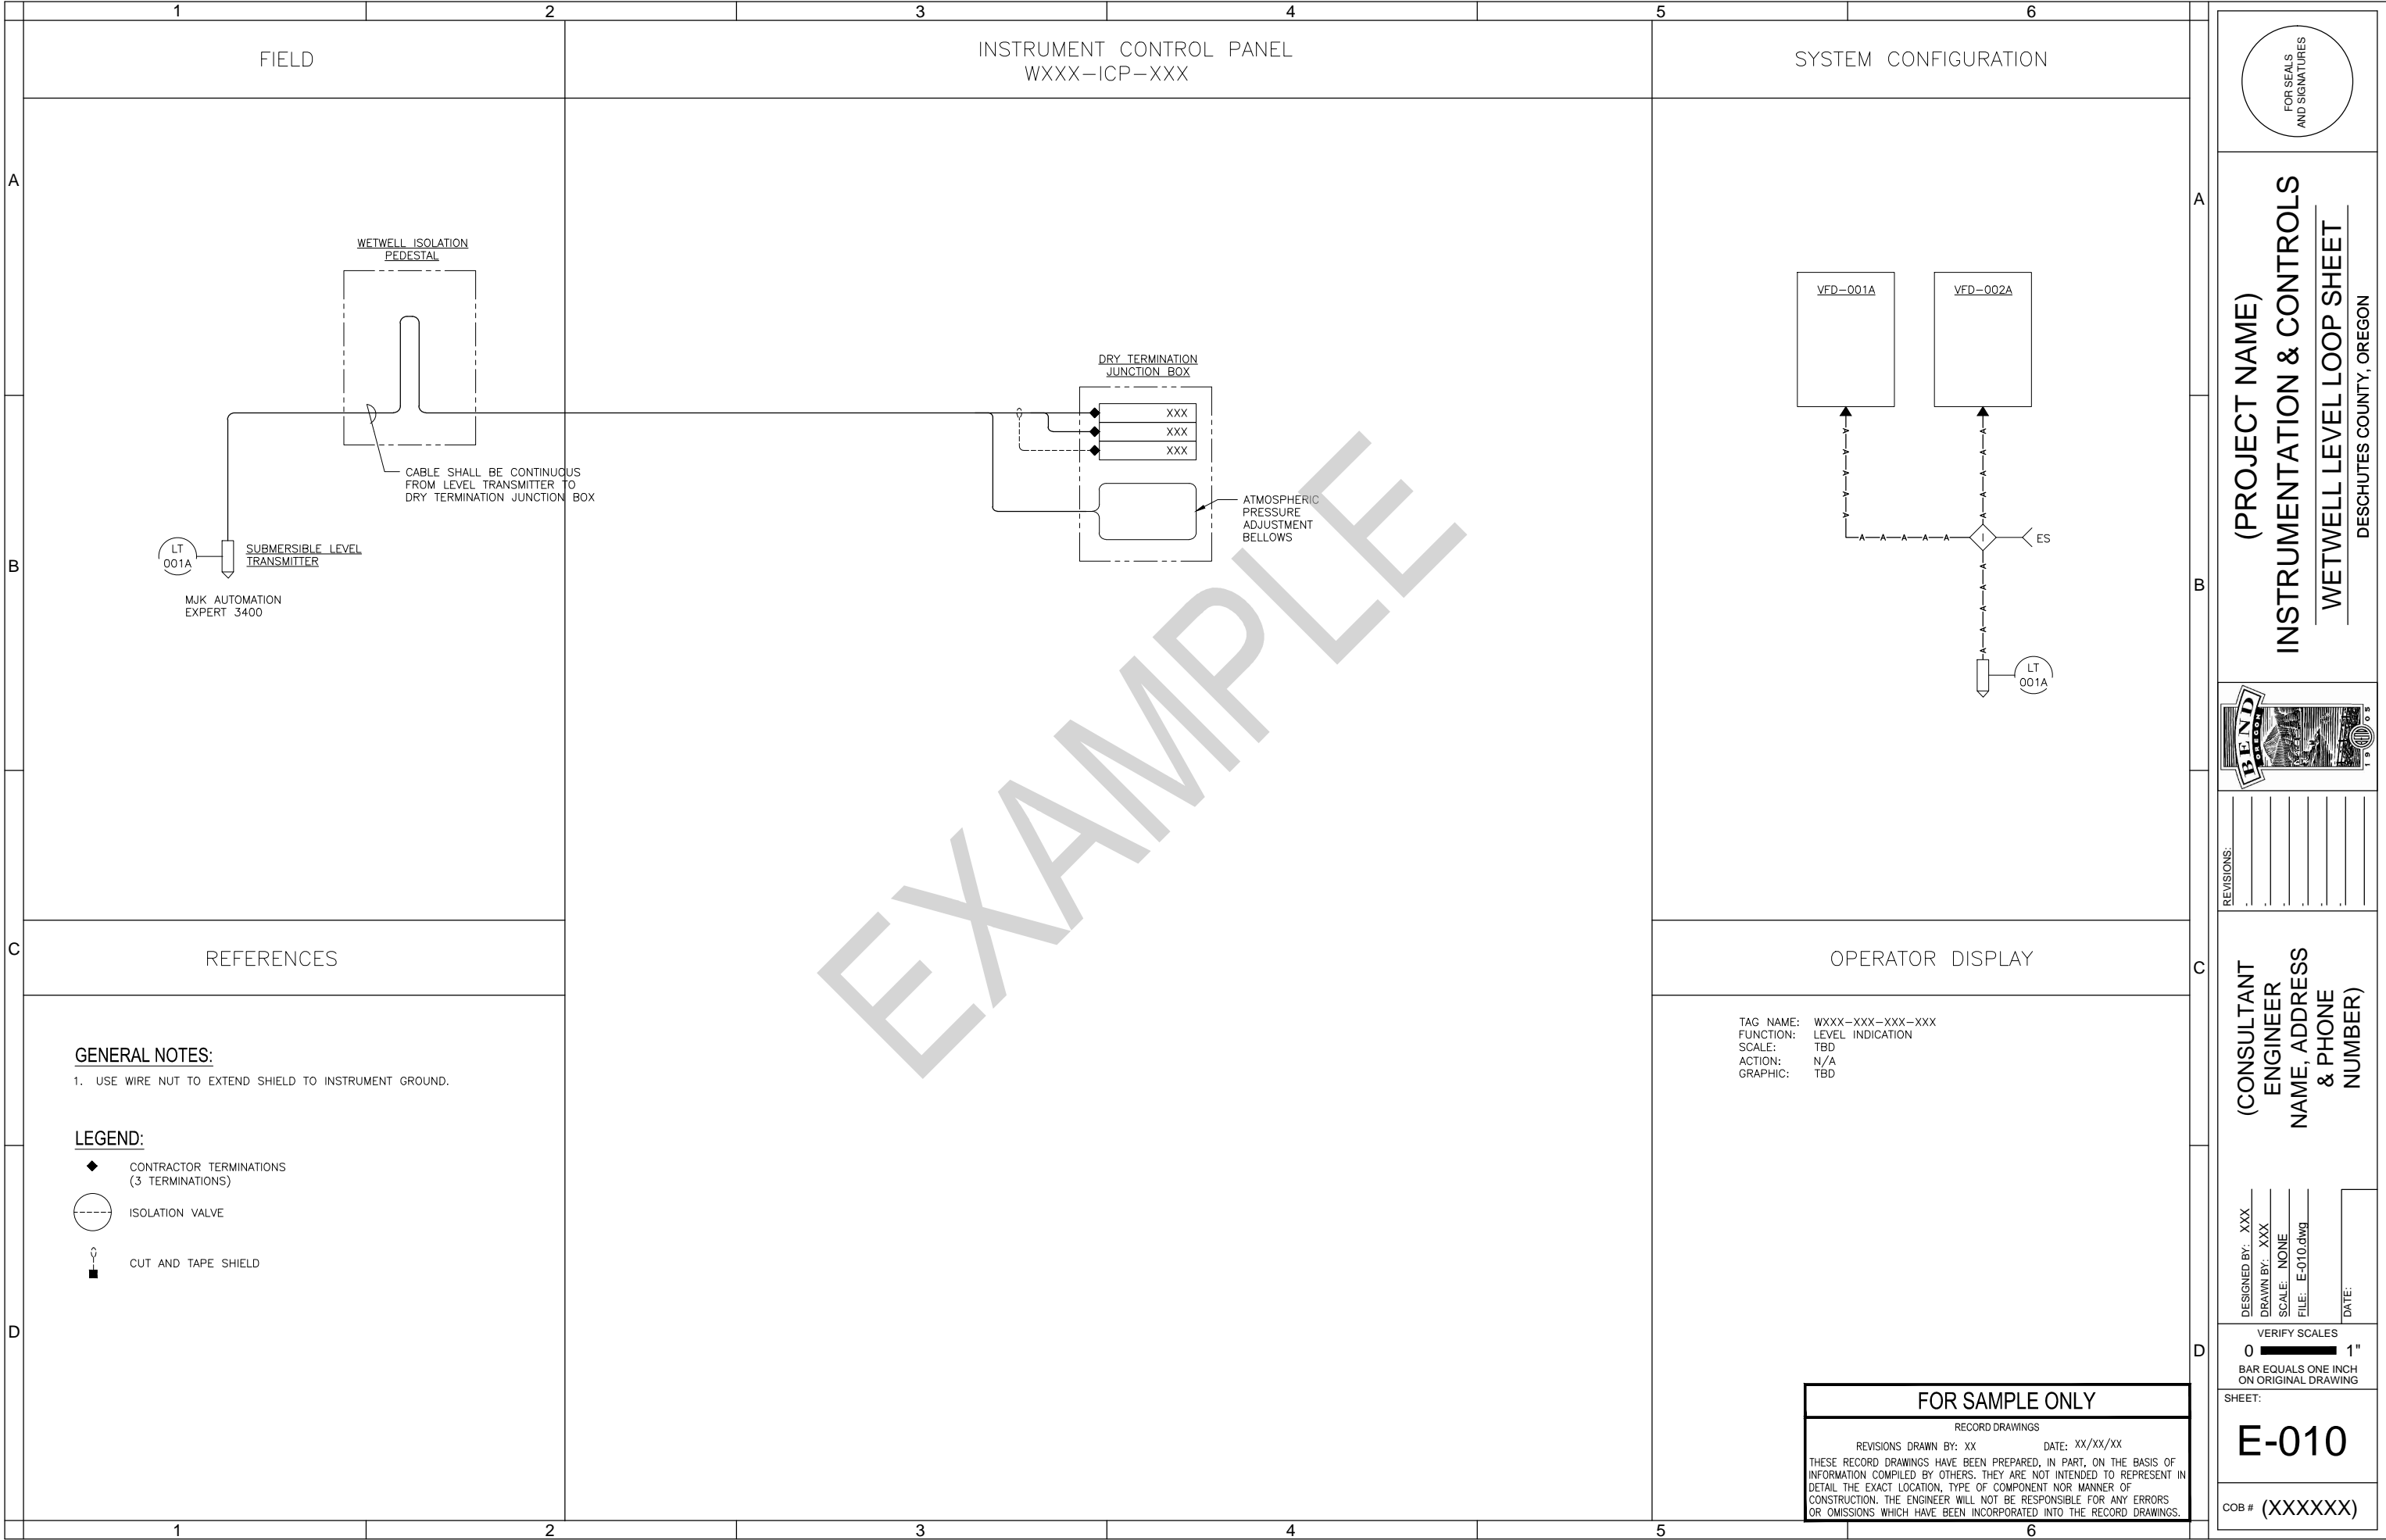

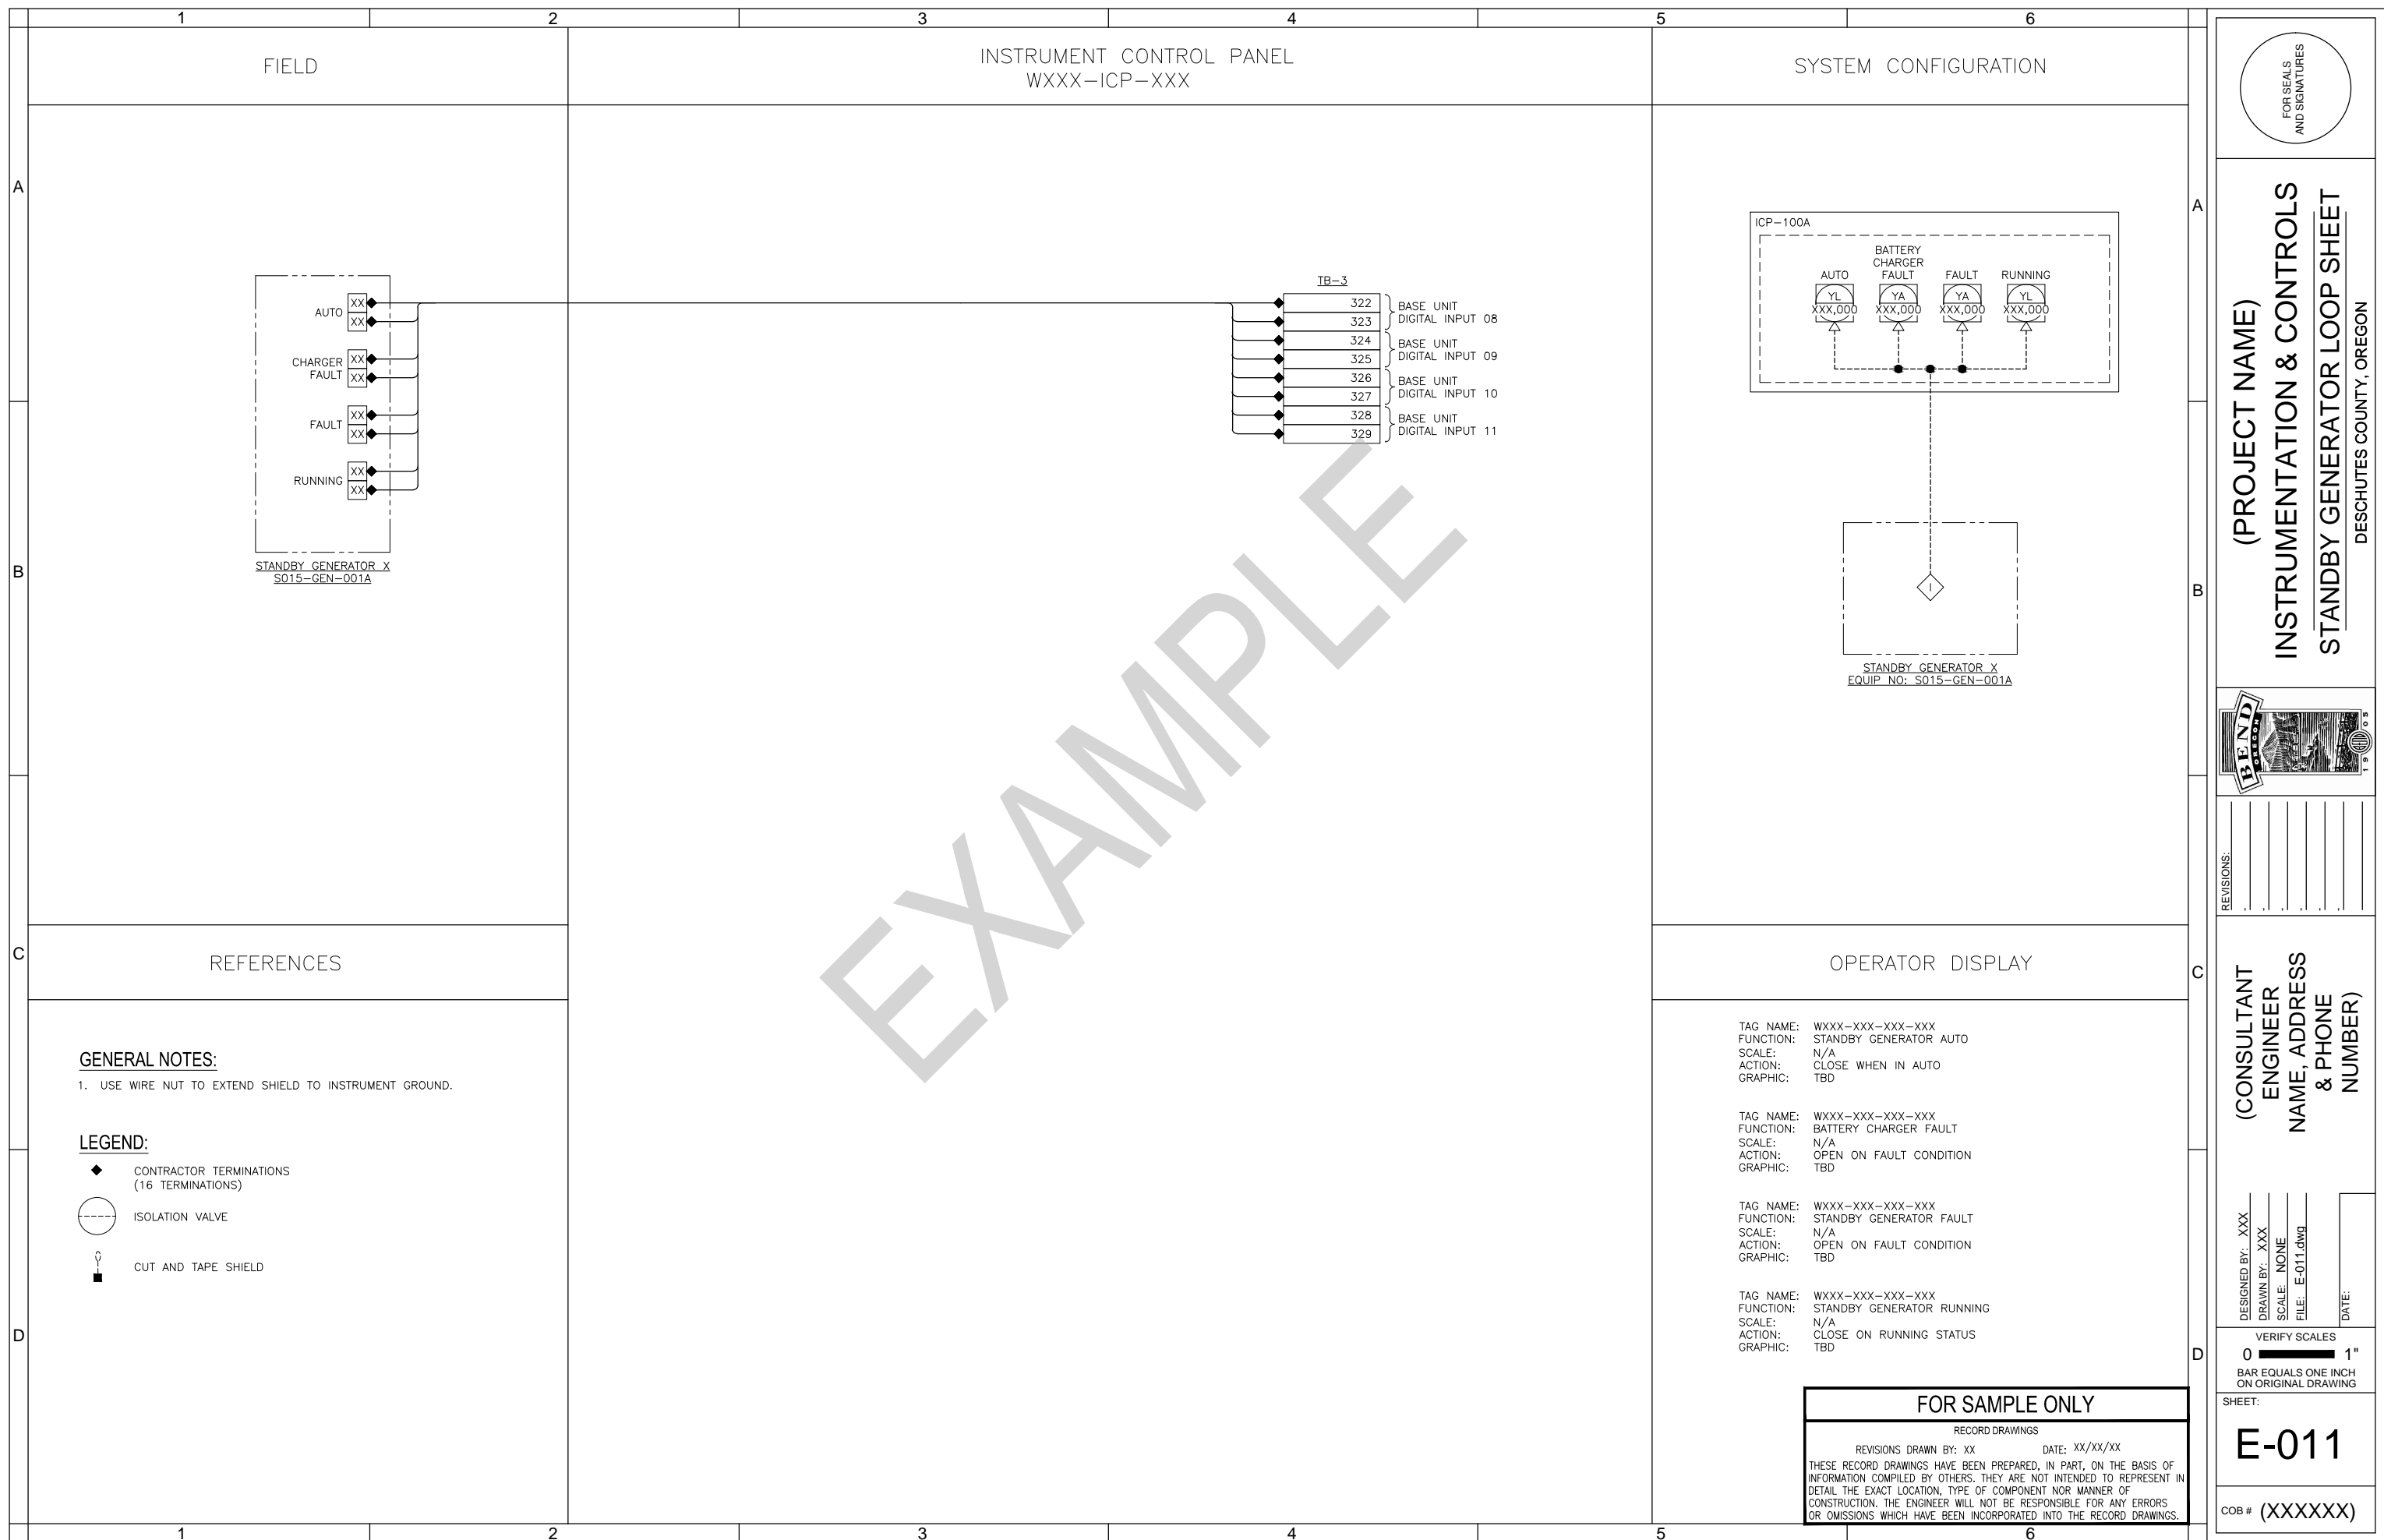

	1	2	3	4	5	6	
	FIELD		INSTRUMENT CONTROL PANEL WXXX-ICP-XXX			SYSTEM CONFIGURATION	
A							
B			<div><div><div><div>NORMAL POSITION</div><div>XX</div><div>XX</div></div><div>STANDBY POSITION</div><div>XX</div><div>XX</div></div><div><div>NORMAL POWER AVAILABLE</div><div>XX</div><div>XX</div></div><div>STANDBY POWER AVAILABLE</div><div>XX</div><div>XX</div></div>				

AUTO-TRANSFER SWITCH

EQUIP. NO: S015-ATS-100A

TB-3

331

332

333

334

335

336

337

338

BASE UNIT

DIGITAL INPUT 12

BASE UNIT

DIGITAL INPUT 13

BASE UNIT

DIGITAL INPUT 14

BASE UNIT

DIGITAL INPUT 15

FOR SEALS
AND SIGNATURES

(PROJECT NAME)
INSTRUMENTATION & CONTROLS
AUTO-TRANSFER SWITCH LOOP SHEET
DESCHUTES COUNTY, OREGON

DESIGNED BY: XXX

DRAWN BY: XXX

SCALE: NONE

FILE: E-012.dwg


DATE:

VERIFIED BY: XXX

VERIFY SCALES
0 1"
BAR EQUALS ONE INCH
ON ORIGINAL DRAWING

SHEET:
E-012

COB # (XXXXXXX)

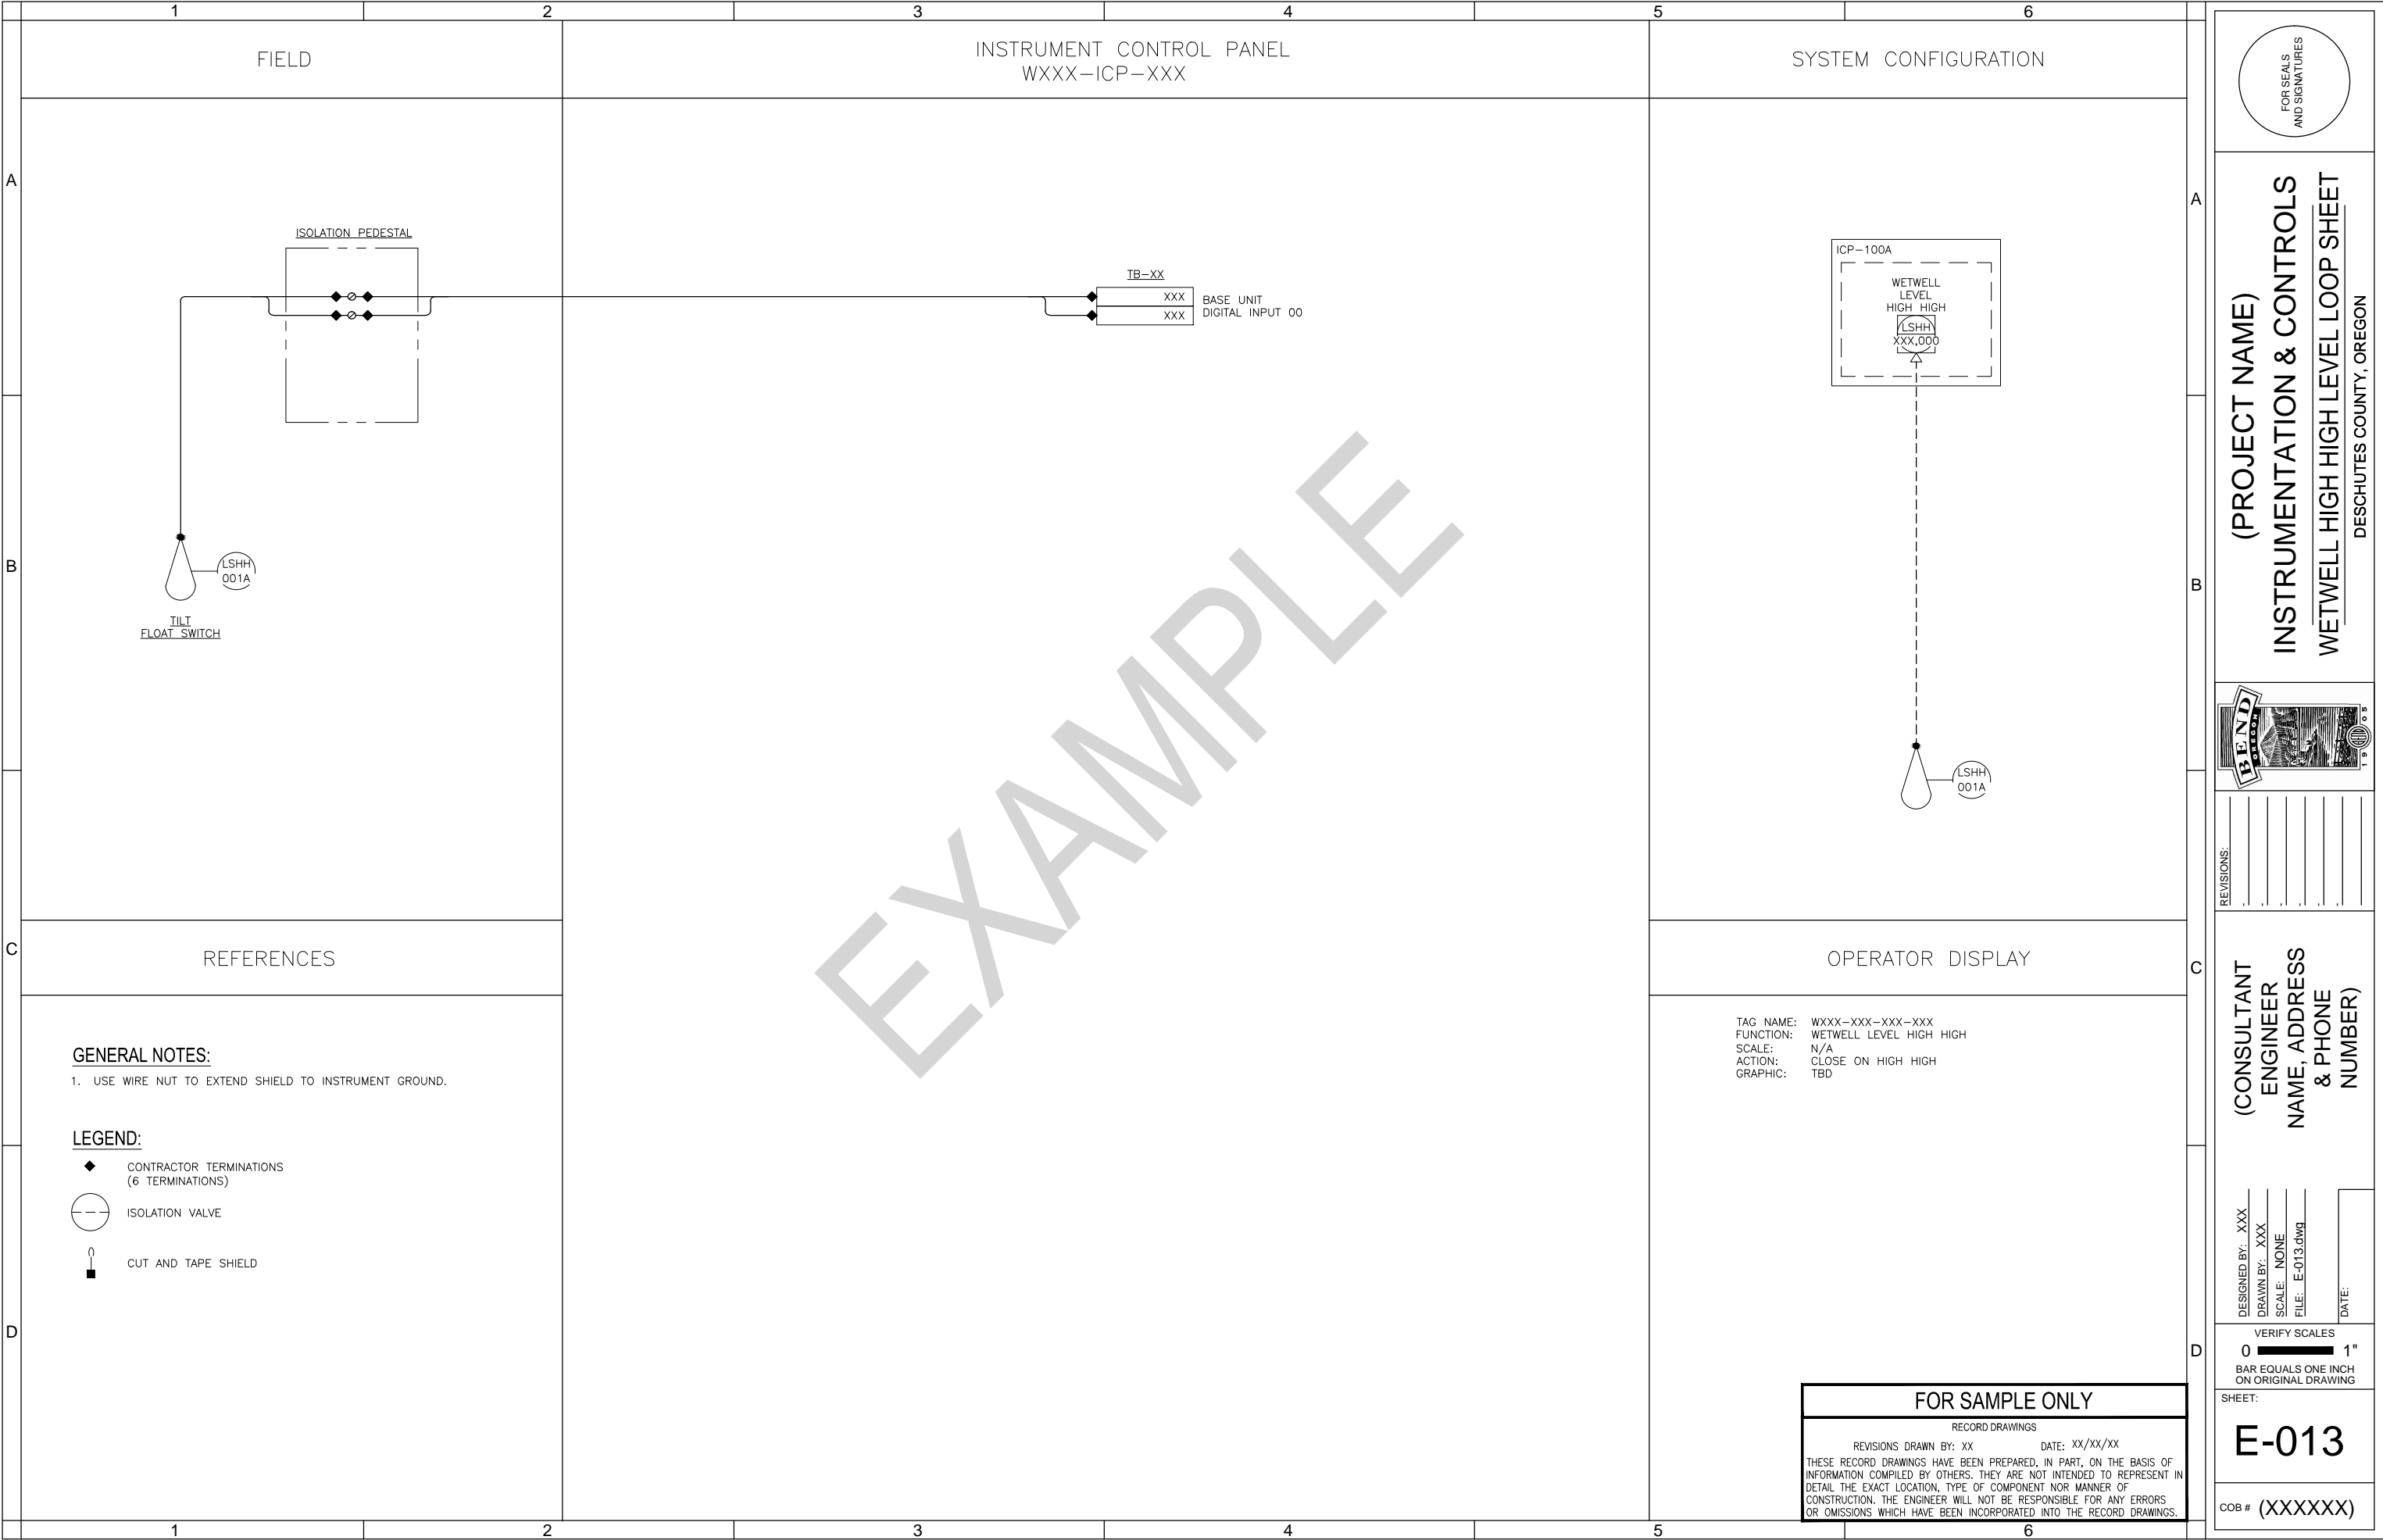

FOR SEALS
AND SIGNATURES

(PROJECT NAME)
INSTRUMENTATION & CONTROLS
WETWELL HIGH HIGH LEVEL LOOP SHEET
DESCHUTES COUNTY, OREGON

REVISIONS:


--	--	--	--	--	--	--	--	--	--

(CONSULTANT
ENGINEER
NAME, ADDRESS
& PHONE
NUMBER)

DESIGNED BY: XXX
DRAWN BY: XXX
SCALE: NONE
FILE: E-013.dwg
DATE:

VERIFY SCALES
0 1"
BAR EQUALS ONE INCH
ON ORIGINAL DRAWING

SHEET:
E-013
COB # (XXXXXXX)

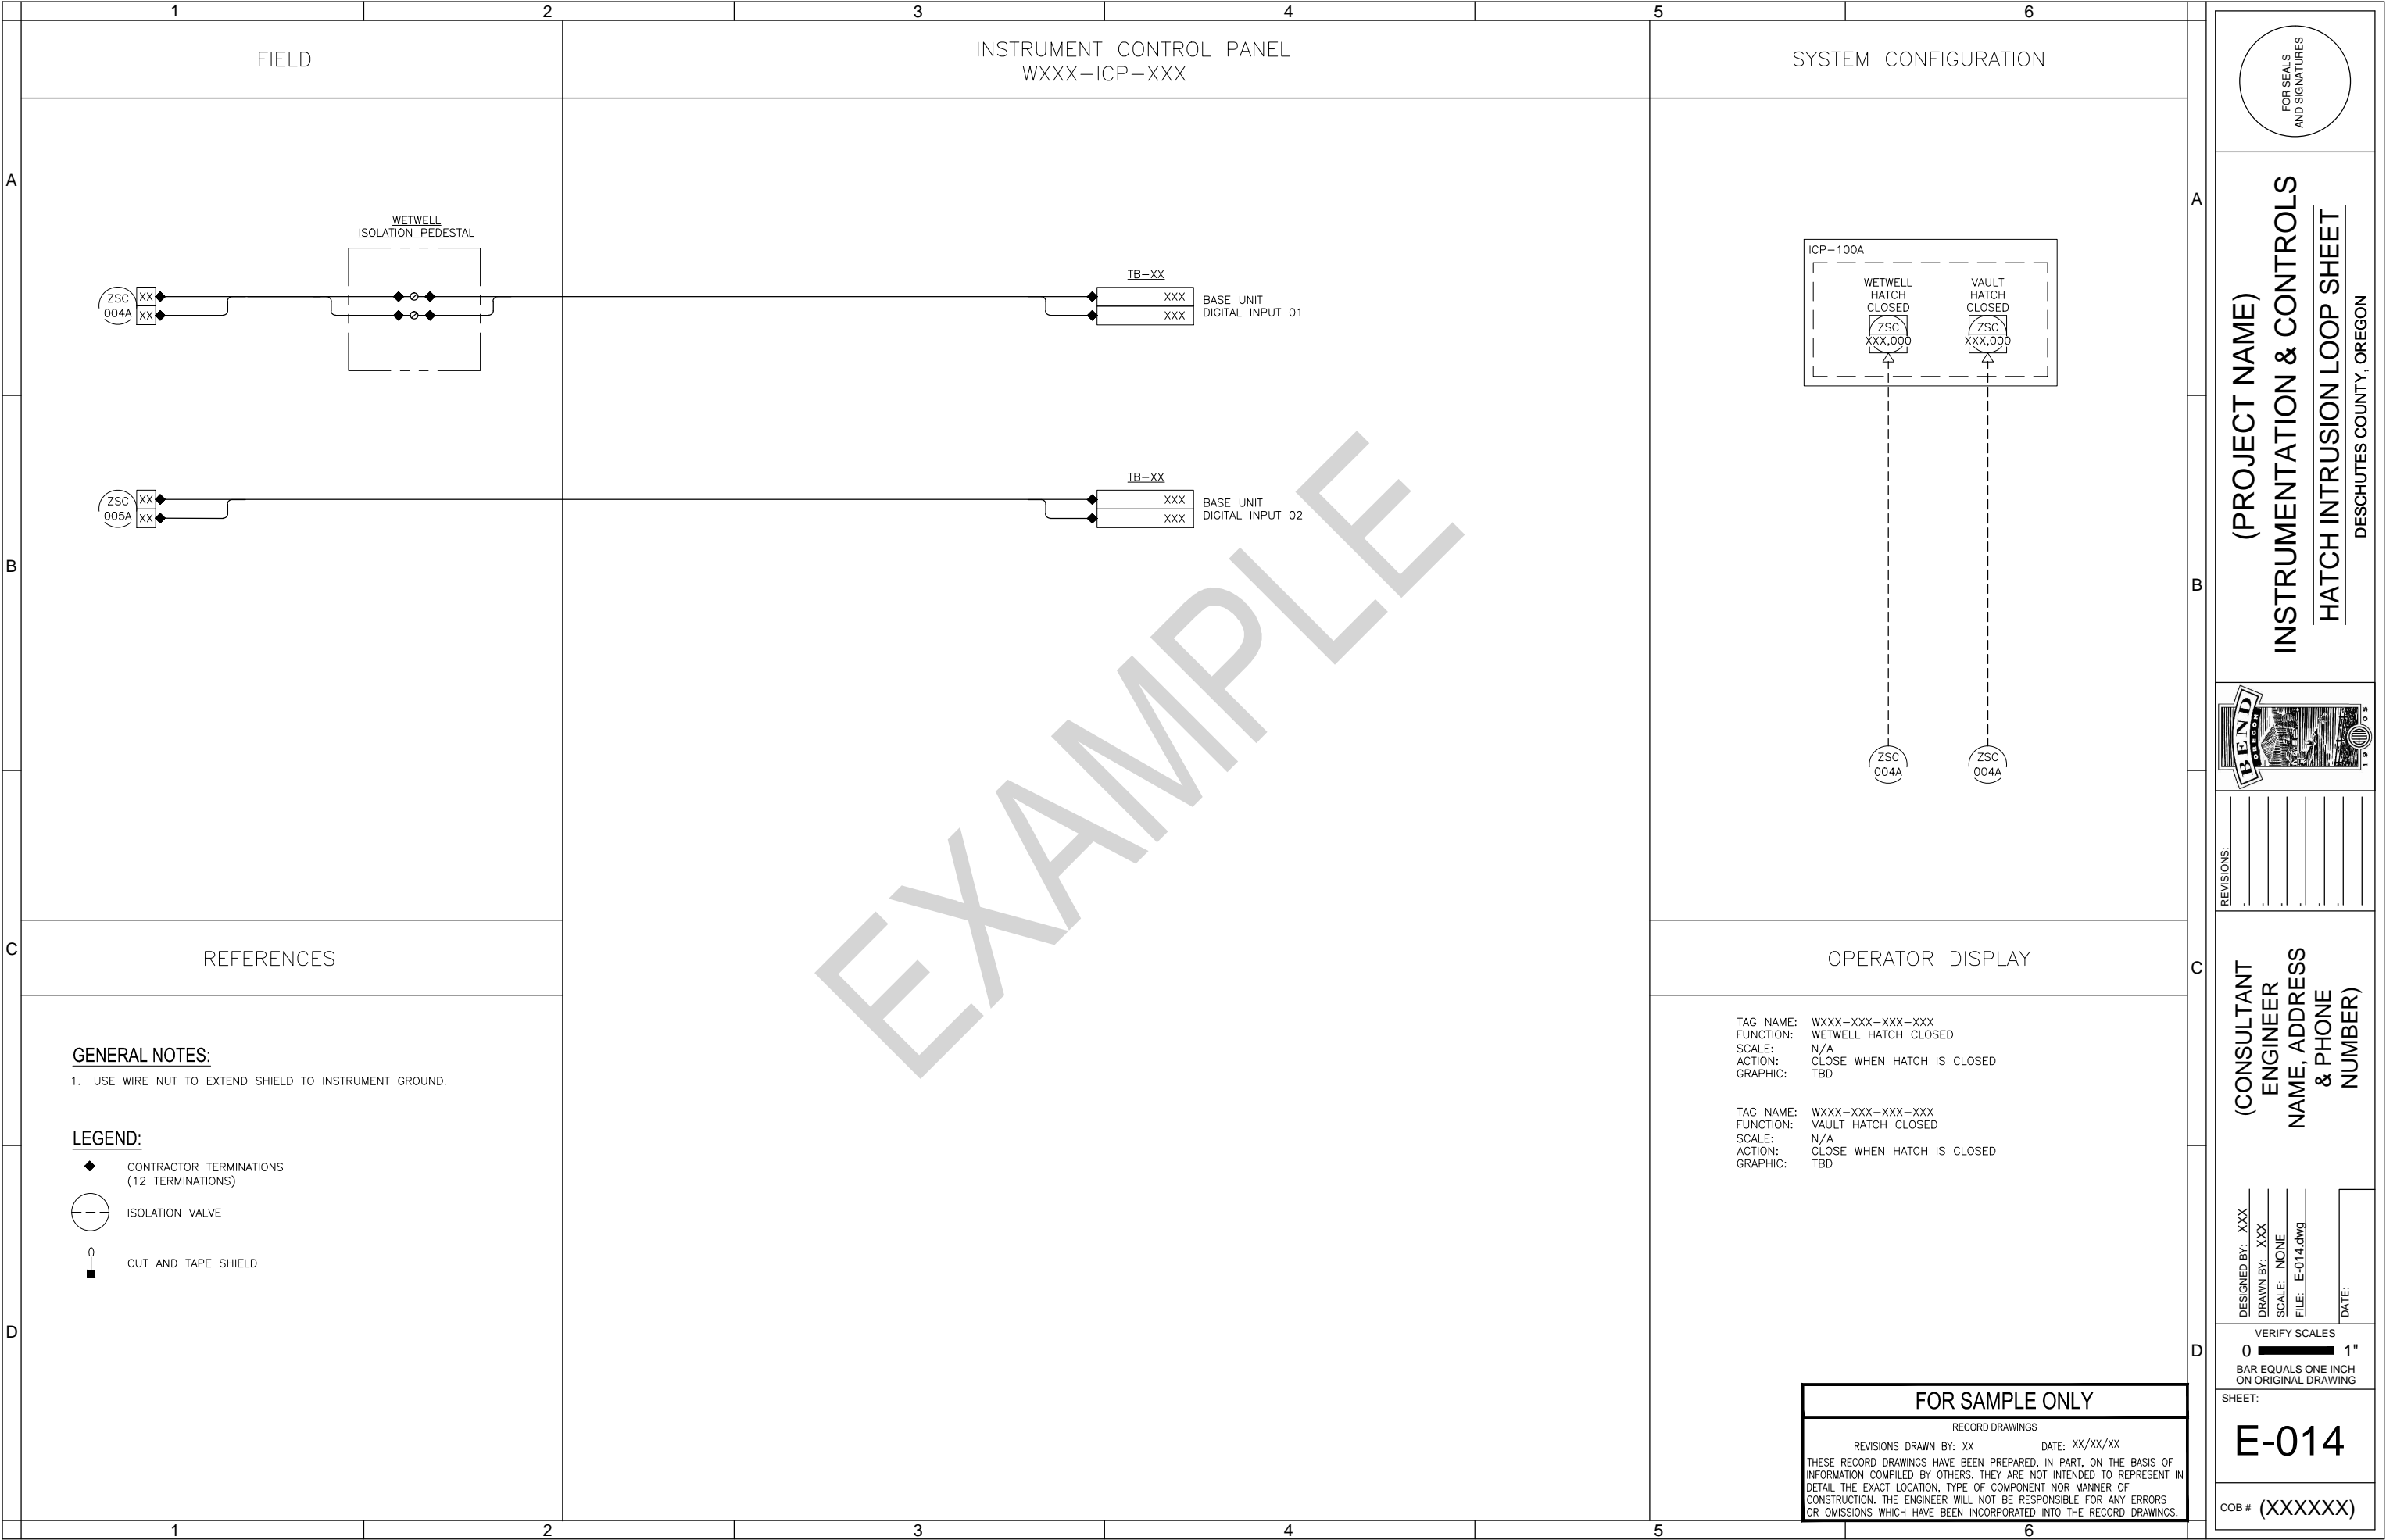

(PROJECT NAME)

INSTRUMENTATION & CONTROLS

HATCH INTRUSION LOOP SHEET

DESCHUTES COUNTY, OREGON



REVISIONS:

(CONSULTANT
ENGINEER
NAME, ADDRESS
& PHONE
NUMBER)

DESIGNED BY: XXX
DRAWN BY: XXX
SCALE: NONE
FILE: E-014.dwg
DATE:

VERIFY SCALES
0 1"
BAR EQUALS ONE INCH ON ORIGINAL DRAWING

SHEET:

E-014

COB # (XXXXXXX)

