
PART VI

APPENDICES

PART VI
APPENDIX A

**Example Tier III Right of Way Plan
Set**

[NORTH ARROW]



CITY OF BEND

[PROJECT NAME]

[MONTH, YEAR]

[CITY PROJECT OR FILE NUMBER]

CITY OF BEND, DESCHUTES COUNTY, OREGON

OWNER:
[NAME]
[ADDRESS]
[CITY, STATE & ZIP]
[PHONE NUMBER]

SCHEDULE OF IMPROVEMENTS:

- CITY OF BEND:**
- # LF FULL STREET IMPROVEMENT
 - # LF SIDEWALK
 - # LF #\" CURB
 - # CURB RAMPS
 - # STREET LIGHTS
 - # LF #\" PVC-3034 SEWER MAIN
 - # MANHOLES
 - #4\" SEWER SERVICES
 - # STORM CATCH BASINS
 - # DRYWELLS
 - # LF #\" STORM PIPE
 - # LF #\" DI WATER MAIN
 - # LF #\" DI WATER MAIN
 - # FIRE HYDRANTS
 - # #\" WATER SERVICES
- PRIVATE:**
- # LF #\" DI WATER MAIN
 - # LF #\" DI WATER MAIN
 - # FIRE HYDRANTS
 - # #\" WATER SERVICES

VICINITY MAP

VICINITY MAP

SCALE:

[NORTH ARROW]

SITE PLAN (AREA CAN BE RESIZED TO FIT PROJECT)

SITE PLAN

SCALE:

LEGEND:

	BENCHMARK (FOUND)		BANK (BOTTOM)
	BENCHMARK (SET)		BANK (TOP)
	CATCH BASIN		CABLE TV
	CLEANOUT		CANAL
	CONCRETE		CENTERLINE
	CONIFEROUS TREE		DITCH (CENTER)
	CONTROL MON CULVERT		EDGE OF CONCRETE
	DECIDUOUS TREE		EDGE OF GRAVEL
	DITCH INLET		EDGE OF PAVEMENT
	DRYWELL		EASEMENT
	GAS METER		FENCE (OTHER)
	GAS VALVE		FENCE (SILT)
	GRAVEL		FENCE (STEEL)
	GUY WIRE		FENCE (WOOD)
	HANDICAP		FIBER OPTICS
	MAILBOX		FORCE MAIN
	MONUMENT (FOUND)		GAS
	MONUMENT (SET)		GRADE BREAK
	RAILROAD CROSSING ARM		GUARDRAIL
	SANITARY MANHOLE		IRRIGATION
	SIDEWALK		JERSEY BARRIER
	SIGN		PAVEMENT REPAIR
	STORM MANHOLE		PROPERTY BOUNDARY
	TELEPHONE RISER		PROPERTY SETBACKS
	TELEPHONE MANHOLE		POWER
	TRAFFIC SIGNAL CONTROL BOX		POWER (OVERHEAD)
	TRAFFIC SIGNAL W/ MAST ARM		RAILROAD
	UTILITY POLE		RIVER
	UTILITY POLE/LIGHT		SANITARY SEWER
	UTILITY VAULT W/ MANHOLE		STORM DRAIN
	WATER AIR RELEASE VALVE		STRIPPING
	WATER BELL JOINT		TELEPHONE
	WATER BLIND FLANGE		WATER
	WATER BLOW OFF VALVE		
	WATER BUTTERFLY VALVE		
	WATER CHECK VALVE		
	WATER COMBINATION AIR RELEASE VALVE		
	WATER DOUBLE DETECTOR CHECK VALVE		
	WATER FIRE DEPT CONNECTION		
	WATER FIRE HYDRANT		
	WATER FLANGED GATE VALVE		
	WATER FLANGED BY MECHANICAL JOINT GATE VALVE		
	WATER GATE VALVE		
	WATER MECHANICAL JOINT		
	WATER METER		
	WATER PRESSURE REDUCING VALVE		
	WATER PRESSURE REGULATOR/SUSTAINING		
	WATER PRESSURE RELIEF VALVE		
	WATER RESTRAINED MECHANICAL JOINT		
	WATER SAMPLE STATION		
	WATER SINGLE DETECTOR CHECK VALVE		
	WATER THRUST BLOCK (STRADDLE)		
	WATER THRUST BLOCK		

FADED BLACK FEATURES ARE EXISTING (EXCEPT FOR FOUND MONUMENTS)

[ON COVER SHEET IF APPLICABLE]

APPROVALS:

CITY OF BEND ENGINEER: _____

NOTE: SIGNATURE DOES NOT GRANT APPROVAL TO COMMENCE CONSTRUCTION.

[REQUIRED UTILITY: _____]

[REQUIRED UTILITY: _____]

[REQUIRED UTILITY: _____]

[REQUIRED UTILITY: _____]

PERMANENT BENCH MARKS USED:

IDENTIFICATION	DESCRIPTION

SHEET INDEX:

- SHEET 1 COVER
- SHEET 2 CONTRUCTION NOTES
- SHEET 3 SITE PLAN & PROFILE
- SHEET 4 GRADING PLAN & PROFILE
- SHEET 5 DETAILS
- SHEET 6 EROSION CONTROL

STAMP
[ENGINEERS]

[PROJECT NAME]
[PROJECT NAME 2ND LINE]
COVER
DESCHUTES COUNTY, OREGON



REVISIONS:
1. _____
2. _____
3. _____

[COMPANY NAME]
[COMPANY ADDRESS]

DESIGNED BY: _____
DRAWN BY: _____
SCALE: _____
FILE: _____
DATE: ____/____/____

VERIFY SCALES
0 1"
BAR EQUALS ONE INCH
ON ORIGINAL DRAWING

SHEET:
1/6

COB #

GENERAL NOTES:

- NO CONSTRUCTION SHALL BE STARTED WITHOUT A NOTICE TO PROCEED BY THE CITY ENGINEERING DEPARTMENT. THE CITY ENGINEERING DEPARTMENT AND THE DESIGN ENGINEER SHALL BE NOTIFIED AT LEAST 24 HOURS PRIOR TO THE START OF CONSTRUCTION. ANY CONSTRUCTION WORK DONE PRIOR TO NOTICE TO PROCEED BEING ISSUED OR WITHOUT INSPECTION WILL BE REJECTED.
- CONTRACTOR SHALL VERIFY ALL CONDITIONS ON THE JOB SITE INCLUDING BUT NOT LIMITED TO, ALL DIMENSIONS, GRADES, ELEVATIONS, EXTENT AND COMPATIBILITY TO THE EXISTING SITE CONDITIONS, AND WITH THE WORK DESCRIBED ON THE ENGINEER'S DRAWINGS. ANY DISCREPANCIES OR UNEXPECTED CONDITIONS THAT AFFECT OR CHANGE THE WORK DESCRIBED IN THE CONTRACT DOCUMENTS SHALL BE BROUGHT TO THE ENGINEER'S ATTENTION IMMEDIATELY. CONTRACTOR SHALL NOT PROCEED WITH ANY OF THE WORK IN THE AREA OF DISCREPANCIES UNTIL ALL SUCH DISCREPANCIES ARE RESOLVED. IF THE CONTRACTOR CHOOSES TO DO SO, THEN IT IS UNDERSTOOD THAT THE CONTRACTOR IS CHOOSING TO PROCEED AT THE CONTRACTOR'S OWN RISK AND SHALL INCUR ALL COSTS, IF ANY TO RESOLVE THE ISSUES TO THE SATISFACTION OF THE ENGINEER.
- A CITY INSPECTOR ACTING ON BEHALF OF THE CITY MAY REQUIRE REVISIONS IN PLANS TO SOLVE UNFORESEEN PROBLEMS THAT MAY ARISE IN THE FIELD.
- ALL CONSTRUCTION WORK AND INSTALLATIONS SHALL CONFORM TO THE CITY STANDARDS AND SPECIFICATIONS, AND ALL WORK SHALL BE SUBJECT TO THE APPROVAL OF THE CITY.
- IT SHALL BE THE RESPONSIBILITY OF THE CONTRACTOR TO CONTACT "UNDERGROUND LOCATE SERVICE" AT 1-800-332-2344 AT LEAST 48 BUSINESS-DAY HOURS PRIOR TO THE START OF CONSTRUCTION FOR THE LOCATION OF POWER, GAS, CABLE TV AND TELEPHONE UNDERGROUND FACILITIES. THE CONTRACTOR WILL ALSO BE RESPONSIBLE FOR CONTACTING THE APPROPRIATE PUBLIC AGENCY FOR THE LOCATION OF UNDERGROUND FACILITIES.
- ALL UTILITIES SHOWN ARE ACCURATE TO THE EXTENT OF AVAILABLE RECORDS AND KNOWLEDGE. NO POTHOLES TO VERIFY LOCATIONS AND ELEVATIONS WAS AUTHORIZED BY THE OWNER. THE CONTRACTOR HAS THE TOTAL RESPONSIBILITY TO VERIFY THE LOCATION OF EXISTING UNDERGROUND UTILITIES AND TO NOTIFY THE UTILITY COMPANIES WHEN WORKING IN THEIR PROXIMITY. CONTRACTOR TO VERIFY LOCATION OF EXISTING UTILITIES PRIOR TO CONSTRUCTION. OREGON LAW REQUIRES YOU TO FOLLOW RULES ADOPTED BY THE OREGON UTILITY NOTIFICATION CENTER. THOSE RULES ARE SET FORTH IN OAR 952-001-0010 THROUGH 952-001-0090. YOU MAY OBTAIN COPIES OF THE RULES BY CALLING THE CENTER. THE TELEPHONE NUMBER FOR THE OREGON UTILITY NOTIFICATION CENTER IS (503)232-2987.
- ALL GRADING SHALL BE IN CONFORMANCE WITH THE CURRENT CITY STANDARDS AND SPECIFICATIONS AND CURRENT GRADING ORDINANCE. ALL SUBGRADE MATERIAL SHALL BE CONSIDERED CLASS A AND COMPACTED TO 95% OF OPTIMUM DENSITY. AS SPECIFIED IN THESE PLANS, ALL FILL MATERIAL SHALL BE COMPACTED TO 95% RELATIVE COMPACTION PER THE CITY TESTING REQUIREMENTS.
- ALL FINAL CUT AND FILL SLOPES SHALL NOT EXCEED A GRADE OF 2 HORIZONTAL TO 1 VERTICAL UNLESS OTHERWISE APPROVED.
- ALL UNSUITABLE SOILS MATERIALS, RUBBISH AND DEBRIS RESULTING FROM GRADING OPERATIONS SHALL BE REMOVED FROM THE JOB SITE AND DISPOSED OF PROPERLY.
- THE CONTRACTOR SHALL EMPLOY ALL LABOR, EQUIPMENT, AND METHODS REQUIRED TO PREVENT DUST IN AMOUNTS DAMAGING TO PROPERTY, CULTIVATED VEGETATION AND DOMESTIC ANIMALS OR CAUSING A NUISANCE TO PERSONS OCCUPYING BUILDINGS IN THE VICINITY OF THE JOB SITE. THE CONTRACTOR SHALL BE RESPONSIBLE FOR ANY DAMAGE CAUSED BY DUST RESULTING FROM CONSTRUCTION.
- THE CONTRACTOR SHALL FOLLOW ALL APPLICABLE INDUSTRIAL SAFETY REGULATIONS, THE CITY AND DESCHUTES COUNTY AND THEIR OFFICIALS, THE ENGINEER, AND THE OWNER SHALL NOT BE RESPONSIBLE FOR ENFORCING SAFETY REGULATIONS.
- MATERIAL QUANTITIES USED, NOTED, OR PROVIDED IN A SEPARATE ITEMIZED QUANTITY TAKE-OFF ARE AN ENGINEER'S OPINION OF PROBABLE MATERIAL REQUIREMENTS, AND IS AN ESTIMATE ONLY. CONTRACTORS HAVE THE SOLE RESPONSIBILITY OF MAKING THEIR OWN QUANTITY TAKE-OFF AND COST ESTIMATE.
- ALL WORK IN THE PUBLIC RIGHT OF WAY SHALL BE PERFORMED BY A CITY APPROVED CONTRACTOR (INCLUDING SUBCONTRACTORS).
- UTILITIES SHALL HAVE THE RIGHT TO INSTALL, MAINTAIN, AND OPERATE THEIR EQUIPMENT ABOVE AND BELOW GROUND AND ALL OTHER RELATED FACILITIES WITHIN THE PUBLIC UTILITY EASEMENTS (PUE) IDENTIFIED ON THIS PLAT MAP AS MAY BE NECESSARY OR DESIRABLE IN SERVING THE LOTS IDENTIFIED HEREIN, INCLUDING THE RIGHT OF ACCESS TO SUCH FACILITIES AND THE RIGHT TO REQUIRE THE REMOVAL OF ANY OBSTRUCTIONS INCLUDING TREES AND VEGETATION THAT MAY BE PLACED WITHIN THE PUE AT THE LOT OWNERS EXPENSE. AT NO TIME MAY ANY PERMANENT STRUCTURES BE PLACED WITHIN THE PUE OR ANY OTHER OBSTRUCTION WHICH INTERFERES WITH THE USE OF THE PUE WITHOUT PRIOR WRITTEN APPROVAL OF THE UTILITIES AND FACILITIES IN THE PUE.
- CITY ENGINEER'S SIGNATURE DOES NOT CONSTITUTE APPROVAL OF FACILITIES PROPOSED ON PRIVATE PROPERTY. SEPARATE PERMITS ISSUED BY THE BUILDING DEPARTMENT ARE REQUIRED AND SHALL BE OBTAINED BY THE DEVELOPER FOR FACILITIES LOCATED OUTSIDE OF THE PUBLIC RIGHT-OF-WAY.
- ANY WORK WITHIN EXISTING PUBLIC RIGHT-OF-WAY OR DEDICATED CITY EASEMENTS REQUIRES A SEPARATE RIGHT-OF-WAY EXCAVATION PERMIT OBTAINED FROM THE CITY ENGINEERING DIVISION.
- ALL WATER MAIN CONNECTION TO BE DESIGNED AND CONSTRUCTED WITH CROSS CONNECTION PROTECTION.
- CONTRACTOR SHALL OBTAIN HYDRANT METER PERMIT FOR USE OF TESTING WATER MAIN. A MINIMUM OF 48 HOURS ADVANCED NOTICE IS REQUIRED TO THE CITY OF BEND UTILITIES DEPARTMENT.
- ALL RESTORATION TO BE COMPLETED AS SOON AS POSSIBLE UPON COMPLETION AND APPROVAL FROM THE INSPECTOR FOR ON-SITE WORK AND UNDERGROUND WORK.
- ALL RESTORATION SHALL COMPLY WITH CITY OF BEND STANDARDS AND SPECIFICATIONS AND FOLLOW THE BMP PAVING GUIDELINES ESTABLISHED BY STREET DEPARTMENT.
- PRIOR TO IMPLEMENTING ANY TRAFFIC CONTROL PLANS, NOTIFICATION AND APPROVAL IS REQUIRED BY THE CITY OF BEND PRIVATE DEVELOPMENT ENGINEERING DEPARTMENT.
- THESE PLANS WILL EXPIRE ONE YEAR FROM THE "CITY OF BEND ENGINEER" SIGNATURE DATE ON THE COVER.
- PRIVATE INSPECTIONS WILL BE REQUIRED PER PART V OF THE CITY OF BEND STANDARDS AND SPECIFICATIONS UNLESS SPECIFIED OTHERWISE.

TRAFFIC CONTROL NOTES:

- THE CONTRACTOR IS RESPONSIBLE FOR IMPLEMENTING THE APPROVED TRAFFIC CONTROL PLAN (TCP) TO PROVIDE SAFE AND EFFICIENT VEHICULAR, BICYCLE AND PEDESTRIAN MOVEMENT IN AND AROUND THE WORK ZONES. CERTIFIED TRAFFIC CONTROL FLAGGERS AND PROFESSIONALS MAY BE REQUIRED PER THE CONDITIONS OF THE PERMIT. THE CITY OF BEND RESERVES THE RIGHT TO MODIFY THE TCP AT ANY TIME BASED ON FIELD CONDITIONS.
- THE CONTRACTOR SHALL COMPLY WITH ALL PERMIT REQUIREMENTS INCLUDING THE MANUAL OF UNIFORM TRAFFIC CONTROL DEVICES (MUTCD) AND THE OREGON TEMPORARY TRAFFIC CONTROL HANDBOOK FOR OPERATIONS OF THREE DAYS OR LESS, DATED DECEMBER 2011 AND PREPARED BY ODOT (ORANGE BOOK).
- UNLESS APPROVED BY THE CITY ENGINEER, ARTERIAL ROADS SHALL HAVE NO LANE RESTRICTIONS FROM 6:30 TO 9:00 AM AND FROM 3:30 TO 6:30 PM. COLLECTORS AND LOCAL NEIGHBORHOOD MAIN ROUTES SHALL HAVE NO LANE RESTRICTIONS FROM 7:00 AM TO 8:30 AM AND FROM 4:00 PM TO 6:00 PM.
- TCP SHALL BE SUBMITTED TO THE CITY OF BEND A MINIMUM OF 14 DAYS PRIOR TO IMPLEMENTATION FOR REVIEW. 48 HOURS PRIOR TO IMPLANTATION THE CITY OF BEND SHALL BE NOTIFIED IN ORDER TO PROVIDE ADEQUATE PUBLIC NOTIFICATION.

UTILITIES NOTES:

- UTILITIES CROSSING SHALL BE PERPENDICULAR (90 DEGREES) TO THE CITY WATER, STORM, AND SEWER LINES.
- UTILITY CROSSINGS SHALL MAINTAIN A MINIMUM VERTICAL SEPARATION OF 12 INCHES FROM ALL WATER AND SEWER MAIN LINES.
- ANY UTILITY THAT IS LOCATED PARALLEL TO A CITY WATER OR SEWER MAIN LINE SHALL MAINTAIN A MINIMUM OF 10-FT OF HORIZONTAL SEPARATION.
- THE CITY REQUIRES VISUAL INSPECTION (POT HOLING) OF ALL UTILITY CROSSINGS OF CITY WATER, STORM, AND SEWER LINES. SEWER LINES MAY BE INSPECTED BY CLOSED CIRCUIT CAMERA AT THE APPROVAL OF THE CITY ENGINEER.
- EXCAVATION AND DIRECTIONAL DRILLING REQUIRES POT HOLING PRIOR TO ANY WORK BEING CONDUCTED AND DURING DRILLING
- DIRECTIONAL DRILLING REQUIRES ADVANCED PROFILING OF THE CROSSING BEFORE WORK CAN BE PERMITTED.
- NO EXCAVATION IS PERMITTED WITHIN 10 FT BEHIND A FORCE MAINS, PRESSURE MAINS, FIRE HYDRANT OR WATER MAINS THRUST BLOCK.
- UTILITY CROSSINGS SHALL MAINTAIN 2 FT CLEARANCE HORIZONTALLY FROM CITY UTILITIES SUCH AS MANHOLES, VALVE CANS, INLETS, CATCH BASINS, ETC.
- UTILITY LINES SHALL NOT BE PLACED IN THE ROOT AREAS OF TREES AND SHALL MAINTAIN 5 FT CLEARANCE FROM THE DRIPLINE OF TREES OR AS DIRECTED BY THE CITY ENGINEER. ANY TREES DAMAGED ARE TO BE REPLACED
- COMPACTION IS REQUIRED AND TESTING PER SECTION 060405.46 (C) OR AT THE DISCRETION OF THE CITY ENGINEER. ALL LIFTS MUST BE MECHANICALLY COMPACTED WITH ADEQUATE COMPACTION EQUIPMENT, WITH A MINIMUM OF 5 PASSES FOR EACH LIFT OR AS DIRECTED BY THE CITY.

STREET NOTES:

- IF ANY WORK (NEW CONSTRUCTION OR RECONSTRUCTION) IMPACTS A CURB WHERE THERE IS A PEDESTRIAN WALKWAY (E.G. A SIDEWALK OR TRAIL/PATH) INTERSECTING A ROADWAY THEN A NEW RAMP OR REPLACEMENT OF AN EXISTING NON-COMPLIANT CURB RAMP MUST BE CONSTRUCTED.
- IF ANY NEW WORK INCLUDES RESURFACING THROUGH A STREET LEVEL PEDESTRIAN WALKWAY (E.G. MARKED OR UNMARKED CROSSWALK), EVEN IF THE WORK IS NOT THE FULL WIDTH OF THE ROADWAY, CURB RAMPS MUST BE BUILT OR RECONSTRUCTED ON BOTH ENDS OF THE CROSSWALK.
- IF ANY NEW SIDEWALK WORK CONNECTING TO AN EXISTING NON-COMPLIANT RAMP THAT REQUIRES ANY MODIFICATION TO ANY PORTION OF THE RAMP TO MEET CURRENT SIDEWALK DESIGN STANDARDS, THEN THE ENTIRE RAMP SHALL BE RECONSTRUCTED TO CURRENT STANDARDS.
- IF ANY UTILITY TRENCH WORK IMPACTS A CURB AT A CROSS WALK, WITH OR WITHOUT A RAMP, THE REPLACEMENT OF AN EXISTING NON-COMPLIANT CURB RAMP MUST BE CONSTRUCTED.
- IF UTILITY TRENCH WORK DOES NOT IMPACT A CURB RAMP BUT IS "LIMITED TO A PORTION OF THE PAVEMENT, INCLUDING A PORTION OF THE CROSS WALK" REPLACEMENT OF AN EXISTING NON-COMPLIANT CURB RAMP MAY NOT BE REQUIRED (DEPENDENT ON OVERALL PROJECT SCOPE AND REQUIRED PAVEMENT RESTORATION LIMITS).
- ANY WORK WITHIN THE PUBLIC RIGHT-OF-WAY THAT DISTURBS A PEDESTRIAN SIDEWALK OR TRAIL REQUIRES THE REPLACEMENT OF THAT FACILITY TO CURRENT CITY AND PROWAG STANDARDS. THIS INCLUDES BUT IS NOT LIMITED TO ALL ADA RAMPS, CONCRETE SIDEWALKS, ASPHALT TRAILS, DRIVEPADS, CROSSWALKS, AND SIGNAGE.
- IF ANY ADA RAMPS ARE IDENTIFIED TO BE CONSTRUCTED, THE CONTRACTOR SHALL CONSTRUCT PERPENDICULAR RAMPS PER CITY STANDARDS. DIAGONAL OR PARALLEL RAMPS SHALL ONLY BE USED IF THERE ARE UNIQUE SITE CONSTRAINTS THAT PROHIBIT CONSTRUCTION OF PERPENDICULAR RAMPS. ALL VARIATIONS FROM PERPENDICULAR RAMPS ARE AT THE DISCRETION OF THE CITY ENGINEER.
- THE CITY PREFERS THAT VACTOR EXCAVATION AND ASPHALT CORE SAW BE USED TO POT HOLE UTILITIES. ALTERNATE METHODS MAY BE ALLOWED, BUT REQUIRE APPROVAL AS A CONDITION OF THE PERMIT.
- ASPHALT RESTORATION LIMITS WILL BE DETERMINED AFTER PERMIT SCOPE IS COMPLETED.

CONSTRUCTION, INSPECTION, AND NOTIFICATION NOTES:

- PERMITTEE SHALL REQUEST INSPECTIONS A MINIMUM OF 24 HOURS IN ADVANCE.
- THE PERMITTEE SHALL REQUEST FINAL INSPECTION 48 HOURS AFTER THE WORK IS COMPLETE.
- THE CITY CAN INSPECT ANY PORTION OF THE PROJECT AT ANY TIME. THE INSPECTION SHALL BE PERFORMED BY CITY INSPECTORS AND MAY REQUIRE INSPECTION BY THE ENGINEER OF RECORD (THIRD PARTY INSPECTORS). PRIOR TO CONSTRUCTION, A PRE-CONSTRUCTION MEETING MAY BE REQUIRED. THE PERMITTEE/CONTRACTOR IS REQUIRED TO CALL IN ALL INSPECTIONS PER THE REQUIREMENTS OF THE PERMIT
- CONTRACTOR SHALL PROVIDE THE CITY A MINIMUM OF 48 HRS NOTICE PRIOR TO ANY TRAFFIC CONTROL BEING IMPLEMENTED. NOTICE TO THE CITY AND THE INSPECTOR BY EMAIL IS PREFERRED (COMDEVENG@BENDOREGON.GOV)
- INSPECTIONS ARE REQUIRED FOR CITY UTILITY CROSSINGS AND FINAL STREET RESTORATION.
- OUTSTANDING AND INCOMPLETE PERMITS MAY CONSTITUTE RESTRICTED PERMITTING TO THE APPLICANT AND CONTRACTOR(S).
- THE PERMITTEE AND CONTRACTOR ARE RESPONSIBLE FOR ANY DAMAGE TO PUBLIC AND PRIVATE PROPERTY. ALL DAMAGE SHALL BE REPAIRED TO PRE-CONSTRUCTION CONDITIONS AND TO THE SATISFACTION OF THE PROPERTY OWNER.

GRADING AND ESC NOTES:

- THE ENGINEER OF RECORD CAN PROVIDE ADDITIONAL BEST MANAGEMENT PRACTICES (BMP) FROM SECTION 9.4.3 IN THE CENTRAL OREGON STORMWATER MANUAL (COSM) THAT APPLY TO THE PROJECT.
- HOLD A PRE-CONSTRUCTION MEETING THAT INCLUDES THE CITY OF BEND INSPECTOR, EOR AND CONTRACTOR TO DISCUSS EROSION AND SEDIMENT CONTROL MEASURES AND CONSTRUCTION LIMITS.
- THE EROSION AND SEDIMENT CONTROL (ESC) PLAN MUST BE KEPT ONSITE AT ALL TIMES WHEN WORK IS OCCURRING.
- THE ESC MEASURES SHOWN ON THIS PLAN ARE MINIMUM REQUIREMENTS FOR ANTICIPATED SITE CONDITIONS. DURING THE CONSTRUCTION PERIOD, THE MEASURES MUST BE UPGRADED AS NEEDED TO COMPLY WITH ALL APPLICABLE LOCAL, STATE, AND FEDERAL EROSION AND SEDIMENT CONTROL REGULATIONS.
- THE FOLLOWING CONSTRUCTION SEQUENCE SHALL BE FOLLOWED IN ORDER TO BEST MINIMIZE THE POTENTIAL FOR EROSION AND SEDIMENTATION CONTROL PROBLEMS:
 - FENCE OR FLAG AREAS TO BE PROTECTED OR LEFT UNDISTURBED DURING CONSTRUCTION
 - INSTALL GRAVELED OR PAVED CONSTRUCTION ENTRANCES, EXITS, AND PARKING AREAS TO REDUCE THE TRACKING OF SEDIMENT ONTO PUBLIC AND PRIVATE ROADS
 - CLEAR AND GRUB SUFFICIENTLY FOR INSTALLATION OF TEMPORARY ESC BMPS
 - INSTALL TEMPORARY ESC BMPS, CONSTRUCTING SEDIMENT TRAPPING BMPS AS ONE OF THE FIRST STEPS PRIOR TO GRADING
 - CLEAR, GRUB AND GRADE INDIVIDUAL AND ROUGH GRADE FOR ROADS AND UTILITY LOCATIONS
 - CLEAR, GRUB AND GRADE INDIVIDUAL LOTS OR GROUPS OF LOTS
 - TEMPORARILY STABILIZE A LOT OR GROUPS OF LOTS, THROUGH RE-VEGETATION OR OTHER APPROPRIATE BMPS, WHERE SUBSTANTIAL CUT OR FILL SLOPES ARE RESULT OF SITE GRADING
 - CONSTRUCT ROADS, BUILDINGS, PERMANENT STORMWATER FACILITIES (I.E. INLETS, PONDS, UIC FACILITIES, ETC.)
 - PROTECT ALL PERMANENT STORMWATER FACILITIES UTILIZING THE APPROPRIATE BMPS
 - REMOVE TEMPORARY ESC CONTROLS WHEN PERMANENT STORMWATER FACILITIES HAVE BEEN INSTALLED, ALL LAND-DISTURBING ACTIVITIES HAVE CEASED, AND VEGETATION HAS BEEN ESTABLISHED IN THE AREAS NOTED ON THE ACCEPTED ESC PLANS)
- RETAIN THE DUFF LAYER, NATIVE TOPSOIL, AND NATURAL VEGETATION IN AN UNDISTURBED STATE TO THE MAXIMUM EXTENT AND DURATION PRACTICAL.
- INSPECT ALL ROADWAYS ADJACENT TO THE CONSTRUCTION ACCESS ROUTE AT THE END OF EACH DAY. SIGNIFICANT AMOUNTS OF SEDIMENT THAT LEAVES THE CONSTRUCTION SITE MUST BE CLEANED UP WITHIN 24 HOURS. VACUUMING OR DRY SWEEPING MUST BE USED TO CLEAN UP RELEASED SEDIMENT AND SEDIMENT MUST NOT BE INTENTIONALLY WASHED INTO STORM SEWERS, DRAINAGE WAYS, OR WATER BODIES.
- COVER AND SECURE ALL DUMP TRUCK LOADS LEAVING THE CONSTRUCTION SITE TO MINIMIZE SPILLAGE ON ROADS.
- RESTORE CONSTRUCTION ACCESS ROUTE EQUAL TO OR BETTER THAN THE PRE-CONSTRUCTION CONDITION. CONTROL FUGITIVE DUST FROM CONSTRUCTION ACTIVITY.
- STABILIZE EXPOSED UNWORKED SOILS (INCLUDING STOCKPILES), WHETHER AT FINAL GRADE OR NOT, WITHIN 10 CALENDAR DAYS DURING THE REGIONAL DRY SEASON (JULY 1 THROUGH SEPTEMBER 30) AND WITHIN 5 CALENDAR DAYS DURING THE REGIONAL WET SEASON (OCTOBER 1 THROUGH JUNE 30).
- PROTECT INLETS, DRYWELLS, CATCH BASINS AND OTHER STORMWATER MANAGEMENT FACILITIES FROM SEDIMENT, WHETHER OR NOT FACILITIES ARE OPERABLE.
- KEEP ROADS ADJACENT TO INLETS CLEAN.
- INSPECT INLETS WEEKLY AT A MINIMUM AND DAILY DURING STORM EVENTS. CLEAN OR REMOVE AND REPLACE INLET PROTECTION DEVICES BEFORE SIX INCHES OF SEDIMENT CAN ACCUMULATE.
- INSTALL SEDIMENT CONTROLS ALONG THE SITE PERIMETER ON ALL DOWN GRADIENT SIDES OF THE CONSTRUCTION SITE BEFORE COMMENCING EARTH DISTURBING ACTIVITIES.
- WHENEVER POSSIBLE, CONSTRUCT STORMWATER CONTROL FACILITIES (DETENTION/RETENTION STORAGE POND OR SWALES) BEFORE GRADING BEGINS. THESE FACILITIES SHOULD BE OPERATIONAL BEFORE THE CONSTRUCTION OR IMPERVIOUS SITE IMPROVEMENTS.
- STOCKPILE MATERIALS (SUCH AS TOPSOIL) ONSITE MUST BE KEPT OFF OF ROADWAY AND SIDEWALKS.
- COVER, CONTAIN AND PROTECT ALL CHEMICALS, LIQUID PRODUCTS, PETROLEUM PRODUCT, AND NON-INERT WASTES PRESENT ONSITE FROM VANDALISM. MAINTAIN A SUPPLY OF MATERIALS ON HAND TO ADDRESS AND CONTAIN SPILLS.
- LOCATE DESIGNATED VEHICLE AND EQUIPMENT SERVICE AREAS, FUEL, AND MATERIALS AWAY FROM DRAINAGE INLETS, WATER COURSES, AND CANALS. PROPERLY CONTAIN AREAS USING BERMS, SAND BAGS, OR OTHER BARRIERS.
- REGULARLY INSPECT AND MAINTAIN EQUIPMENT, ESPECIALLY FOR DAMAGED HOSES AND LEAKY GASKETS. CONDUCT MAINTENANCE AND REPAIR OF HEAVY EQUIPMENT AND VEHICLES (I.E. OIL CHANGES, FUEL TANK DRAIN DOWN, ETC) THAT MAY RESULT IN DISCHARGE OR SPILLAGE OF POLLUTANTS USING SPILL PREVENTION MEASURES, SUCH AS DRIP PANS. CLEAN ALL CONTAMINATED SURFACES IMMEDIATELY FOLLOWING ANY DISCHARGE OR SPILL INCIDENT. PERFORM REPAIRS ONSITE USING TEMPORARY PLASTIC OR OIL ABSORBING BLANKETS BENEATH THE VEHICLE.
- DESIGNATE AN AREA FOR CLEANING PAINTING EQUIPMENT AND TOOLS. NEVER CLEAN BRUSHES OR RINSE CONTAINERS INTO THE STREET, GUTTER, DRAINAGE INLET, OR WATERWAY.
- APPLY LANDSCAPING OR AGRICULTURAL CHEMICALS, INCLUDING FERTILIZERS AND PESTICIDES, IN SUCH A MANNER, AND AT APPLICATIONS RATES, THAT INHIBITS THE LOSS OF CHEMICALS INTO STORMWATER RUNOFF FACILITIES.
- INSPECT ON A REGULAR BASIS (AT A MINIMUM WEEKLY, AND DAILY DURING/AFTER A RUNOFF PRODUCING STORM EVENT) AND MAINTAIN ALL EROSION AND SEDIMENT CONTROL BMPS TO ENSURE SUCCESSFUL PERFORMANCE OF THE BMPS.
- REMOVE TEMPORARY ESC BMPS WITHIN 30 DAYS AFTER THE TEMPORARY BMPS ARE NO LONGER NEEDED. PERMANENTLY STABILIZE AREAS THAT ARE DISTURBED DURING THE REMOVAL PROCESS.
- KEEP SEDIMENT ON THE PROJECT SITE, TO THE MAXIMUM EXTENT PRACTICAL.
- CONTROL FUGITIVE DUST FROM CONSTRUCTION ACTIVITY. DUST CONTROL MUST BE CONTINUOUS, PARTICULARLY DURING THE DRY SEASON.
- DESIGNATE THE LOCATION OF A SLURRY PIT WHERE CONCRETE TRUCKS AND EQUIPMENT CAN BE WASHED OUT. SLURRY PITS ARE NOT TO BE LOCATED IN, OR UPSTREAM OF, A SWALE, DRAINAGE AREA, STORMWATER FACILITY, WATER BODY, OR IN AN AREA WHERE A STORMWATER FACILITY EXISTS OR IS PROPOSED.

STAMP
[ENGINEERS]

[PROJECT NAME]
[PROJECT NAME 2ND LINE]
CONSTRUCTION NOTES
DESCHUTES COUNTY, OREGON



CITY OF BEND

REVISIONS:
1. _____
2. _____
3. _____

[COMPANY NAME]

[COMPANY ADDRESS]


DESIGNED BY: _____
DRAWN BY: _____
SCALE: _____
FILE: _____
DATE: ____/____/____

VERIFY SCALES
0 1"
BAR EQUALS ONE INCH
ON ORIGINAL DRAWING

SHEET:

2/7

COB #

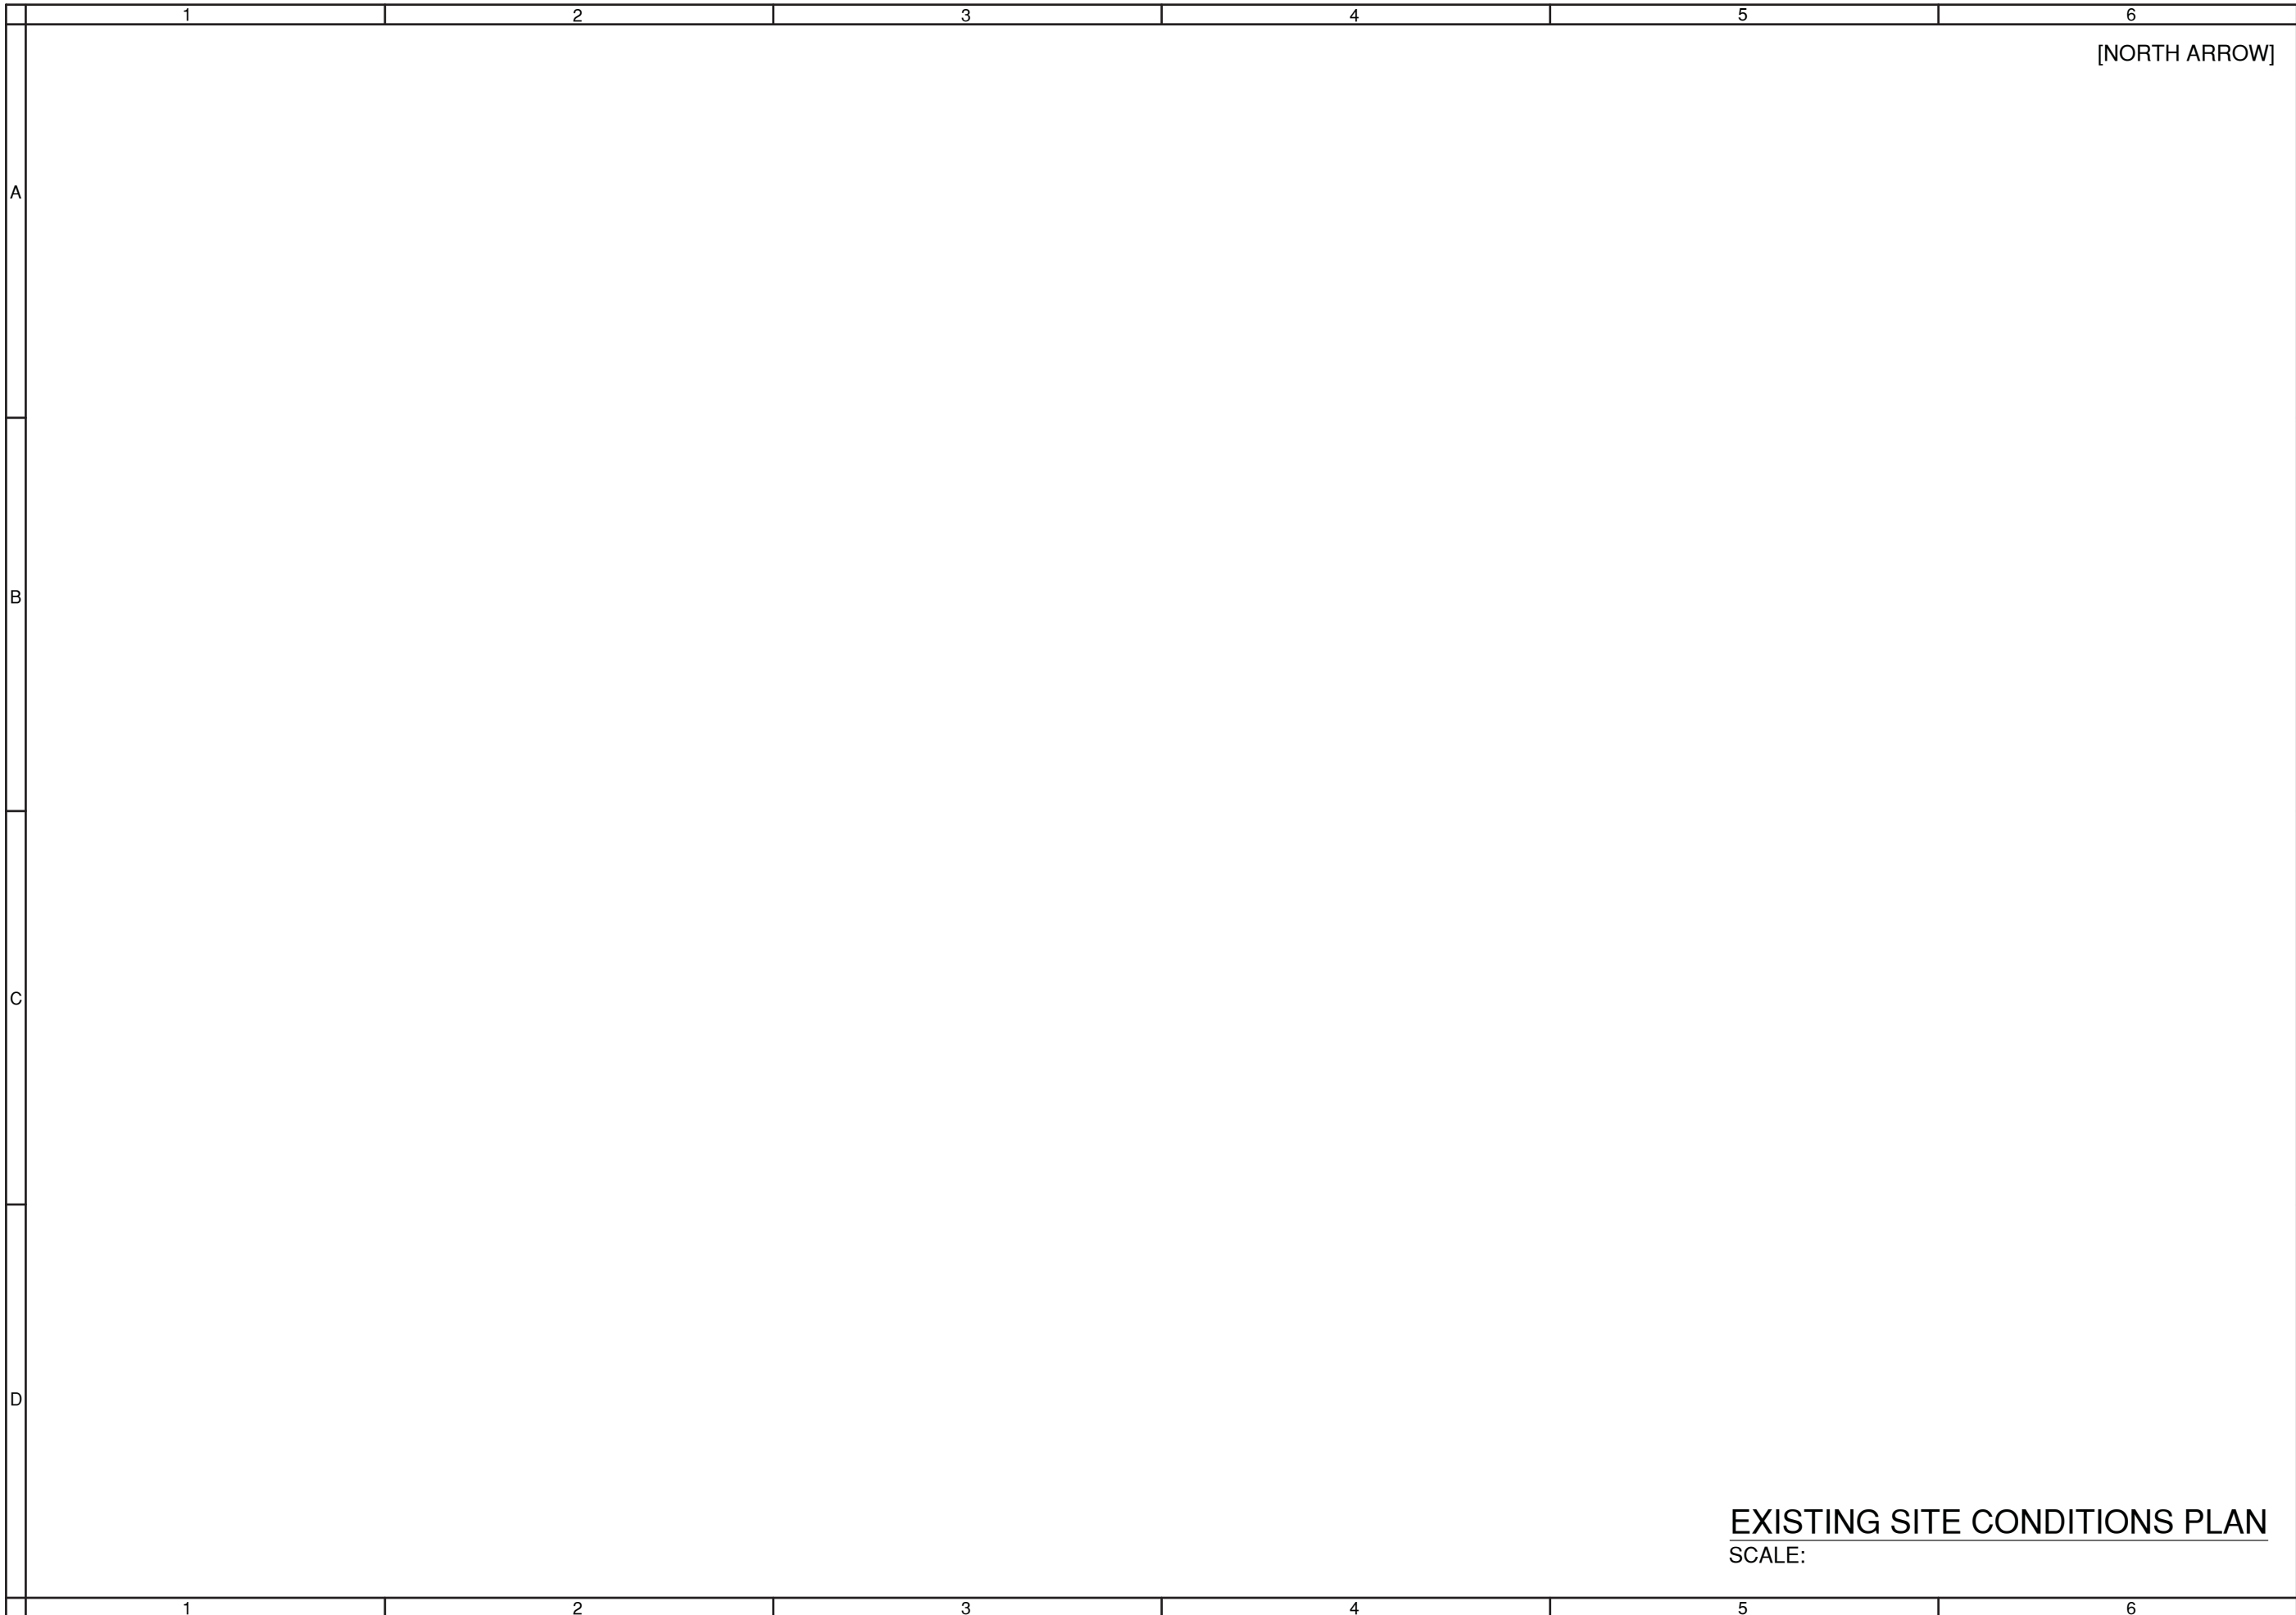

[NORTH ARROW]

STAMP
[ENGINEERS]

[PROJECT NAME]
[PROJECT NAME 2ND LINE]
EXISTING CONDITIONS
DESCHUTES COUNTY, OREGON



CITY OF BEND

REVISIONS:
1. _____
2. _____
3. _____

[COMPANY NAME]
[COMPANY ADDRESS]

 
DESIGNED BY: _____
DRAWN BY: _____
SCALE: _____
FILE: _____
DATE: / /

VERIFY SCALES
0 1"
BAR EQUALS ONE INCH
ON ORIGINAL DRAWING

SHEET:
3/7

COB #

EXISTING SITE CONDITIONS PLAN
SCALE:



[NORTH ARROW]

STAMP
[ENGINEERS]

[PROJECT NAME]
[PROJECT NAME 2ND LINE]
EROSION CONTROL
DESCHUTES COUNTY, OREGON



CITY OF BEND

REVISIONS:
1. _____
2. _____
3. _____

[COMPANY NAME]
[COMPANY ADDRESS]

DESIGNED BY: _____
DRAWN BY: _____
SCALE: _____
FILE: _____
DATE: ____/____/____

VERIFY SCALES
0 1"
BAR EQUALS ONE INCH
ON ORIGINAL DRAWING

SHEET:
4/7

COB #

	1	2	3	4	5	6
A	[NORTH ARROW]					
B	<p>SITE PLAN SCALE:</p>					

C	CROSS SECTION					
D	<p>DETAIL TITLE 2 NOT TO SCALE</p> <p>TYPICAL SECTION</p> <p>DETAIL TITLE 2 NOT TO SCALE</p>					
	1	2	3	4	5	6

STAMP
[ENGINEERS]

[PROJECT NAME]
[PROJECT NAME 2ND LINE]
SITE PLAN & PROFILE
DESCHUTES COUNTY, OREGON



CITY OF BEND

REVISIONS:

1.	
2.	
3.	


[COMPANY NAME]
[COMPANY ADDRESS]

DESIGNED BY: _____
DRAWN BY: _____
SCALE: _____
FILE: _____
DATE: / /

VERIFY SCALES
0 1"
BAR EQUALS ONE INCH
ON ORIGINAL DRAWING

SHEET:
5/7

COB #

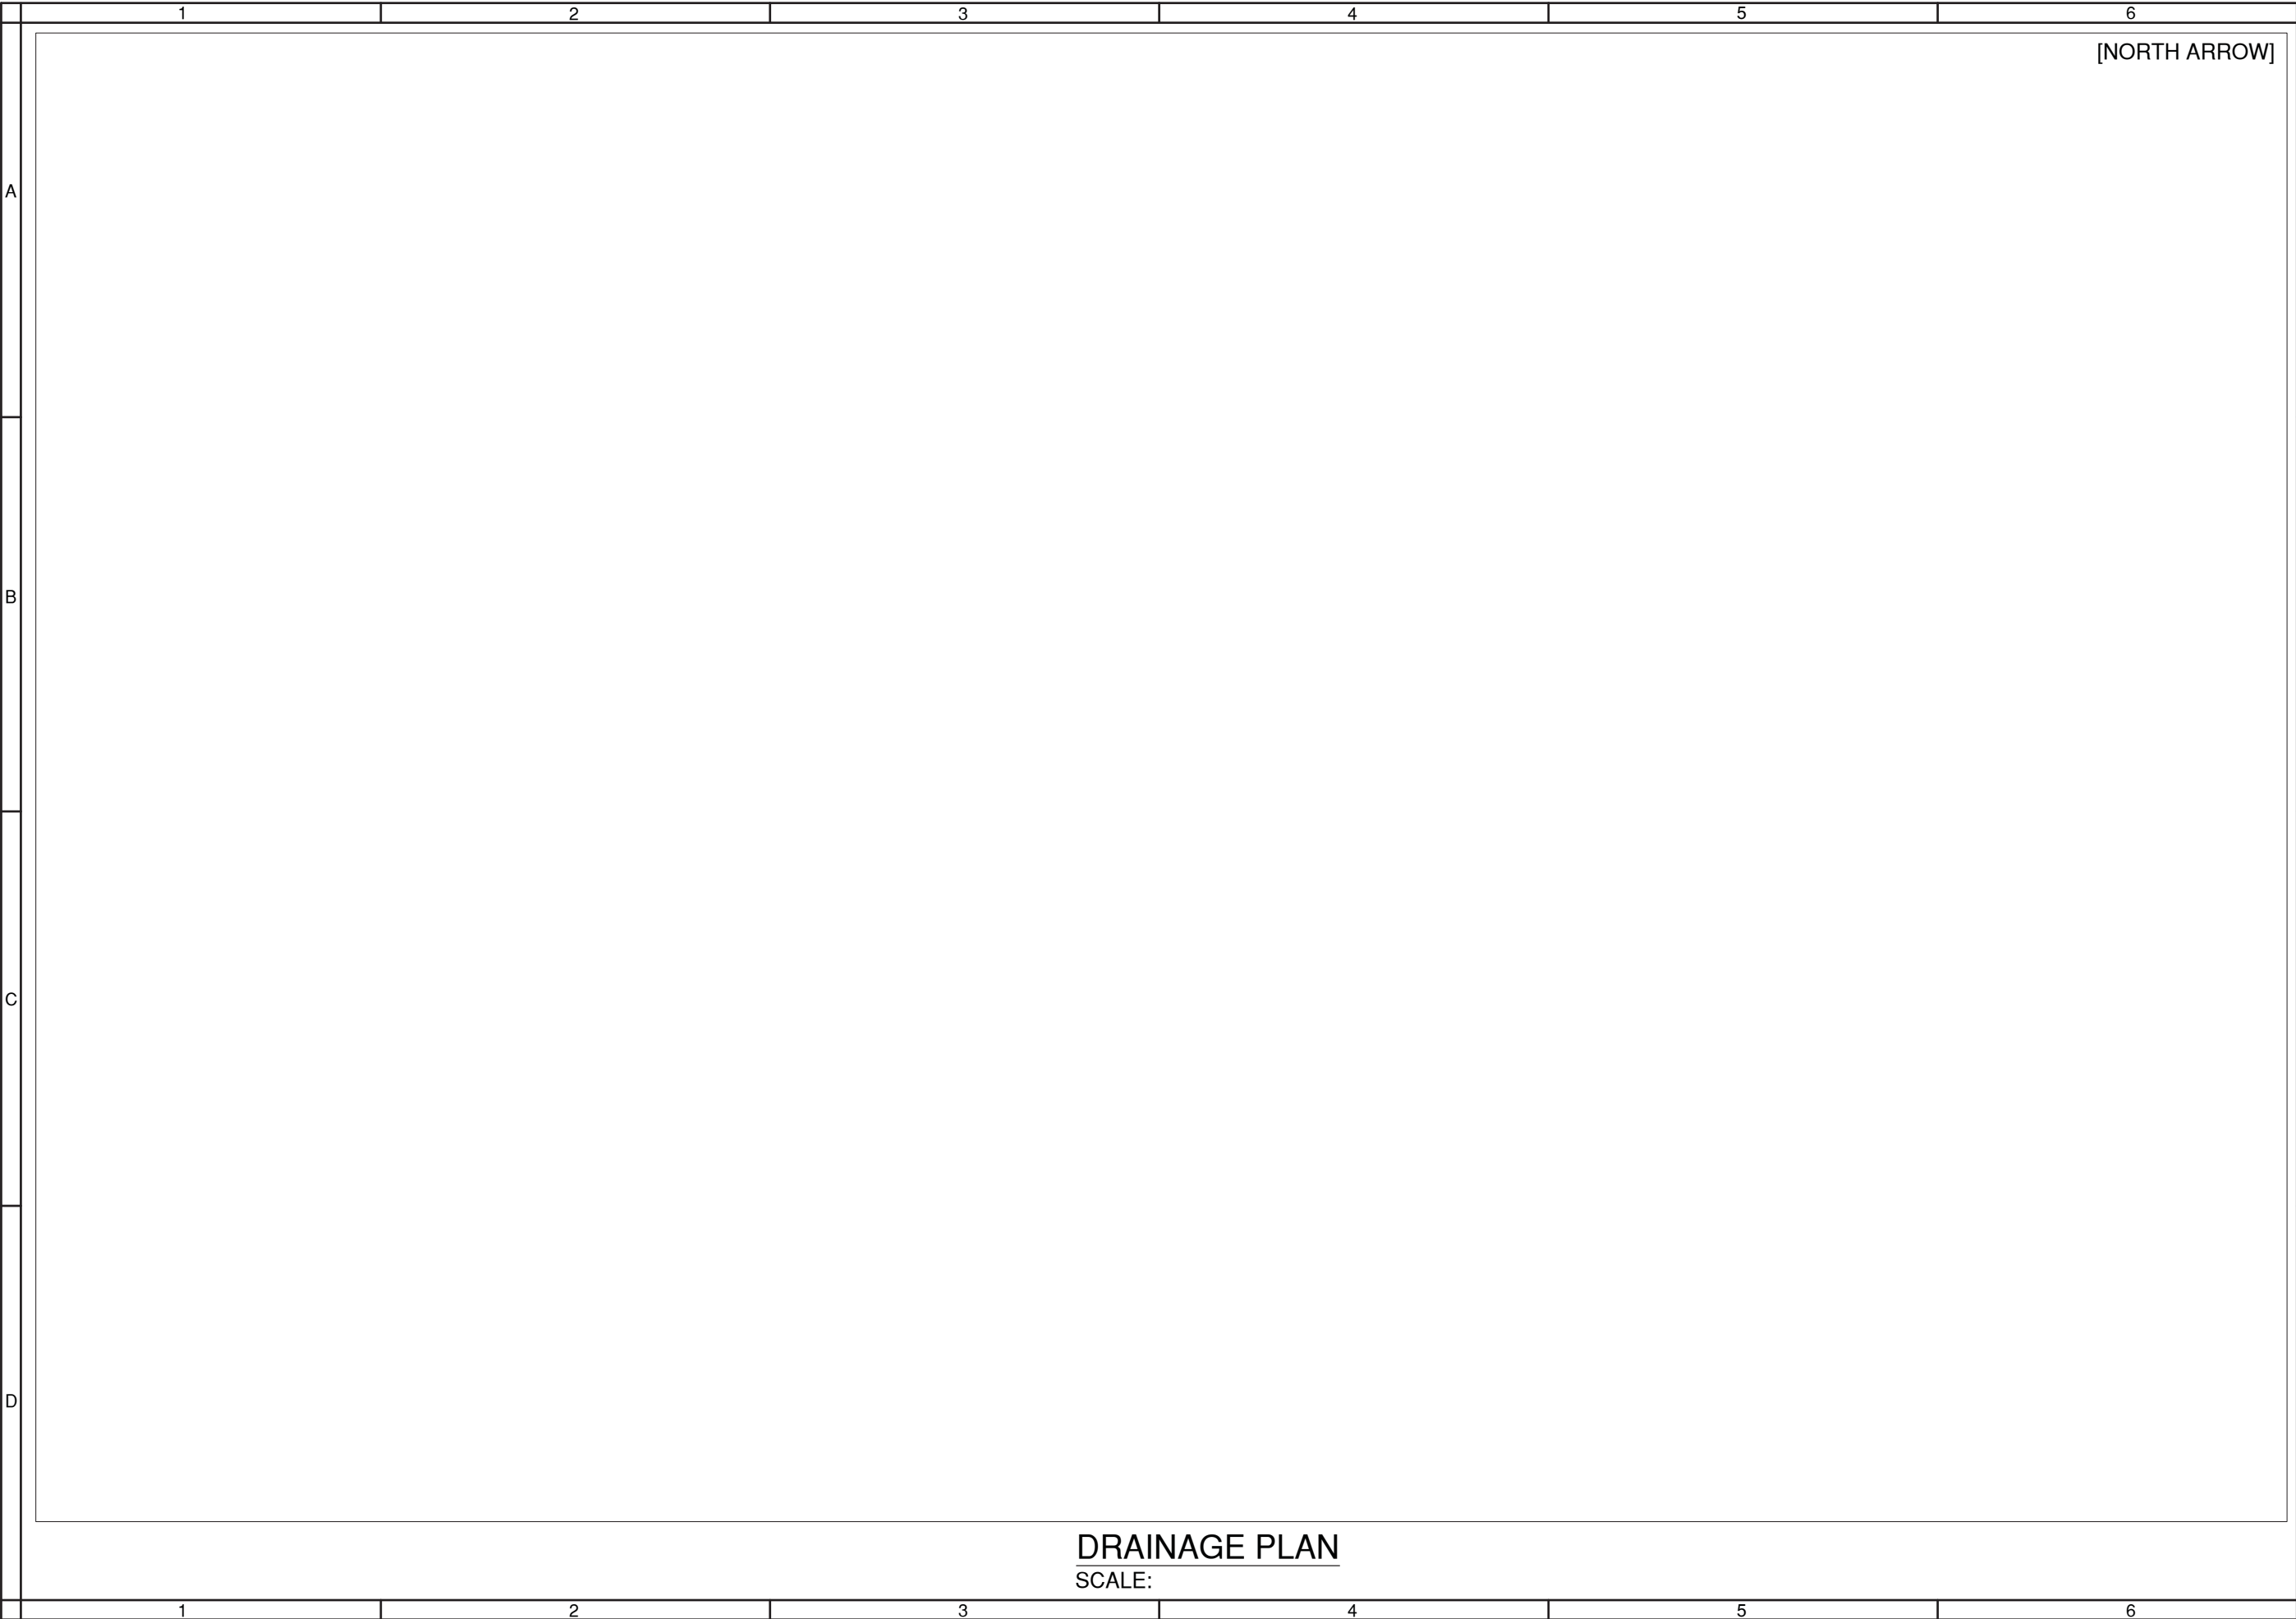

[NORTH ARROW]

A
B
C
D


1 2 3 4 5 6

1 2 3 4 5 6

DRAINAGE PLAN
SCALE:

STAMP
[ENGINEERS]

[PROJECT NAME]
[PROJECT NAME 2ND LINE]
GRADING PLAN & PROFILE
DESCHUTES COUNTY, OREGON

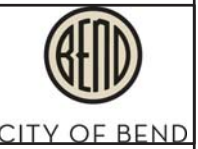

CITY OF BEND

REVISIONS:
1. _____
2. _____
3. _____

[COMPANY NAME]
[COMPANY ADDRESS]

DESIGNED BY: _____
DRAWN BY: _____
SCALE: _____
FILE: _____
DATE: / /

VERIFY SCALES
0 1"
BAR EQUALS ONE INCH
ON ORIGINAL DRAWING

SHEET:
6/7

COB #

1	2	3	4	5	6
A				SPECIAL DETAIL	
				DETAIL TITLE 1 NOT TO SCALE	
B				SPECIAL DETAIL	SPECIAL DETAIL
				DETAIL TITLE 2 NOT TO SCALE	DETAIL TITLE 3 NOT TO SCALE
C				SPECIAL DETAIL	
D				SPECIAL DETAIL	
				DETAIL TITLE 4 NOT TO SCALE	
1	2	3	4	5	6

STAMP
[ENGINEERS]

[PROJECT NAME]
[PROJECT NAME 2ND LINE]
DETAILS
DESCHUTES COUNTY, OREGON



REVISIONS:
1
2
3

[COMPANY NAME]
[COMPANY ADDRESS]

DESIGNED BY: _____
 DRAWN BY: _____
 SCALE: _____
 FILER: _____
 DATE: ____/____/____

VERIFY SCALES
0 1"
BAR EQUALS ONE INCH
ON ORIGINAL DRAWING

SHEET:
7/7


COB # _____

DRAWN:	CITY OF BEND	SCALE: NTS
BY: WATSEWSTORM	STANDARDS AND SPECIFICATIONS	DATE: 6/5/2009
REV: DATE: APPR:	710 NW WALL ST., BEND, OREGON 97701	APPR:
	DETAIL TITLE	DRW NO:


DRAWN:	CITY OF BEND	SCALE: NTS
BY: WATSEWSTORM	STANDARDS AND SPECIFICATIONS	DATE: 6/5/2009
REV: DATE: APPR:	710 NW WALL ST., BEND, OREGON 97701	APPR:
	DETAIL TITLE	DRW NO:

PART VI
APPENDIX B

Example Lift Station Plan Set

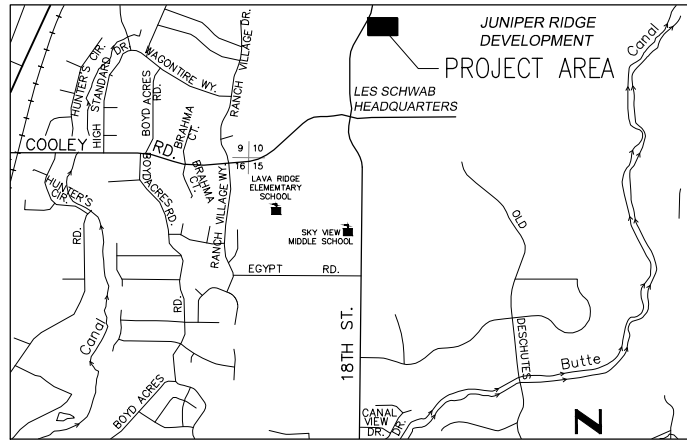


VICINITY MAP
SCALE: N.T.S.

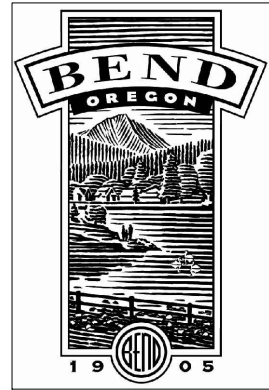

OWNER:
CITY OF BEND
UTILITY'S DEPARTMENT
62975 BOYD ACRES ROAD
BEND, OR 97701

(PROJECT NAME HERE)
(LIFT STATION NAME HERE)

SITE ADDRESS: (ADDRESS HERE)
DATE: (DATE HERE)
CITY PROJECT NUMBER: (IF APPLICABLE)
CITY OF BEND, DESCHUTES COUNTY, OREGON

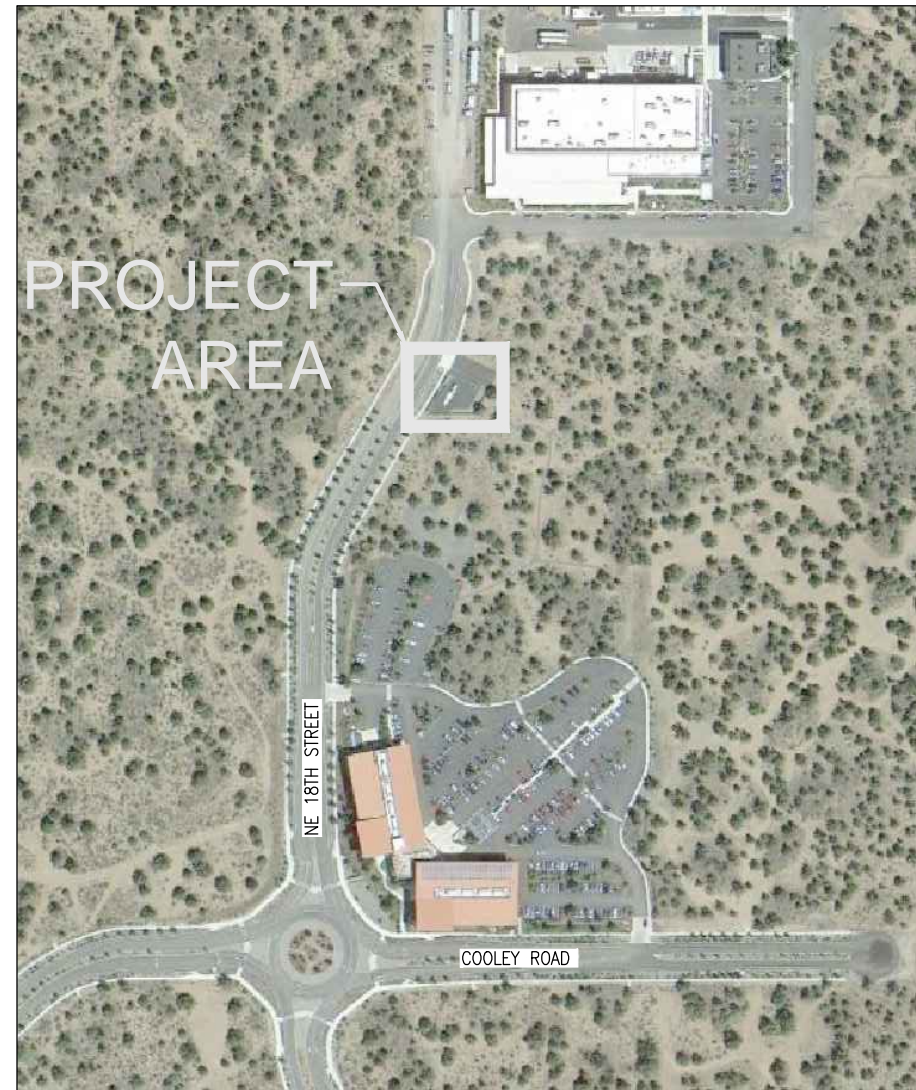

SITE PLAN
SCALE: N.T.S.

EXAMPLE

APPROVALS:

CITY OF BEND
ENGINEER: _____

NOTE: SIGNATURE DOES NOT GRANT APPROVAL TO COMMENCE CONSTRUCTION.

[REQUIRED UTILITY: _____]

[REQUIRED UTILITY: _____]

[REQUIRED UTILITY: _____]

[REQUIRED UTILITY: _____]

PERMANENT BENCH MARKS USED:

IDENTIFICATION	DESCRIPTION
NOT APPLICABLE	




(PROJECT NAME)
(LIFT STATION NAME)
COVER
DESCHUTES COUNTY, OREGON



REVISIONS:

(CONSULTANT ENGINEER NAME, ADDRESS & PHONE NUMBER)

DESIGNED BY: _____
DRAWN BY: _____
SCALE: _____
FILE: _____
DATE: _____




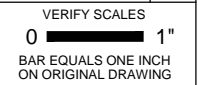


SHEET: **G-000**
COB # (XXXXXX)

FOR SAMPLE ONLY
RECORD DRAWINGS
REVISIONS DRAWN BY: XX DATE: XX/XX/XX
THESE RECORD DRAWINGS HAVE BEEN PREPARED, IN PART, ON THE BASIS OF INFORMATION COMPILED BY OTHERS. THEY ARE NOT INTENDED TO REPRESENT IN DETAIL THE EXACT LOCATION, TYPE OF COMPONENT NOR MANNER OF CONSTRUCTION. THE ENGINEER WILL NOT BE RESPONSIBLE FOR ANY ERRORS OR OMISSIONS WHICH HAVE BEEN INCORPORATED INTO THE RECORD DRAWINGS.

1	2	3	4	5	6
DRAWING INDEX					
1	G-000	COVER			
2	G-001	INDEX, SIGNATURE BLOCK, AND NOTES			
3	G-002	GENERAL LEGEND AND PIPING SYMBOLS			
4	G-003	PROCESS EQUIPMENT LEGEND AND PIPING SYMBOLS			
5	G-004	INSTRUMENTATION LEGEND AND SYMBOLS			
6	G-005	ELECTRICAL NOTES AND STANDARD SYMBOLS			
7	G-006	ELECTRICAL NOTES AND STANDARD SYMBOLS			
8	G-007	GENERAL STRUCTURAL NOTES			
9	G-008	BASIS OF DESIGN			
1	C-001	DEMOLITION AND EROSION CONTROL PLAN			
11	C-002	SITE PLAN			
12	C-003	GRADING AND DRAINAGE			
13	C-004	GRAVITY SEWER PLAN AND PROFILE			
14	C-005	FORCE MAIN SEWER PLAN AND PROFILE			
15	C-006	CIVIL DETAILS			
16	L-001	LANDSCAPE PLAN AND DETAILS (INCLUDE IF REQUIRED)			
17	L-002	IRRIGATION PLAN AND DETAILS (INCLUDE IF REQUIRED)			
18	M-101	LIFT STATION MECHANICAL PLAN			
19	M-102	LIFT STATION MECHANICAL SECTION			
20	M-103	MECHANICAL DETAILS			
21	M-104	MECHANICAL DETAILS			
22	I-001	STANDARD P&ID CONSTANT			
24	I-002	TEMPLATE (50 I/Os) PANEL LAYOUT			
25	I-003	(50 I/Os) BILL OF MATERIALS			
26	I-004	(50 I/Os) PWR WIRING SCHEMATIC			
27	I-005	(50 I/Os) PWR WIRING SCHEMATIC			
28	I-006	(50 I/Os) DIGITAL INPUT MODULE 1			
29	I-007	(50 I/Os) DIGITAL INPUT MODULE 2			
30	I-008	(50 I/Os) ANALOG INPUT MODULE			
31	I-009	INTRINSIC SAFETY RELAY PANEL (ISRP)			
32	I-010	COMMUNICATION NETWORK DIAGRAM			
33	E-001	ELECTRICAL SITE PLAN			
34	E-002	MAIN CONTROL CABINET LAYOUT			
35	E-003	ELECTRICAL ONE LINE DIAGRAM			
36	E-004	CONDUIT AND WIRE SCHEDULE			
37	E-005	WETWELL ISOLATION PEDESTAL			
38	E-006	ELECTRICAL DETAILS			
39	E-007	PUMP 1 WIRING DIAGRAM			
40	E-008	PUMP 2 WIRING DIAGRAM			
41	E-009	PUMP STATION FLOW LOOP SHEET			
42	E-010	WETWELL LEVEL LOOP SHEET			
43	E-011	STANDBY GENERATOR LOOP SHEET			
44	E-012	AUTO-TRANSFER SWITCH LOOP SHEET			
45	E-013	WETWELL HIGH HIGH LEVEL LOOP SHEET			
46	E-014	HATCH INTRUSION LOOP SHEET			
47	E-015	MAIN CONTROL CAB INTRUSION LOOP SHEET			

SECTION AND DETAIL DESIGNATION

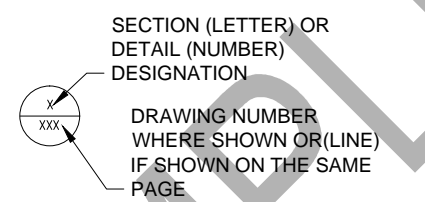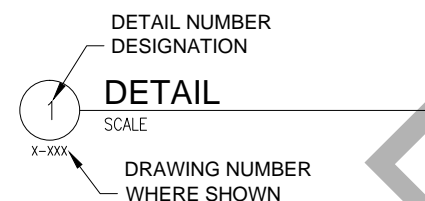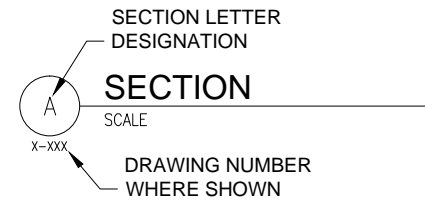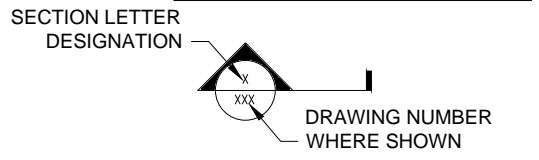


DESIGN DETAIL DESIGNATION



- NOTES:**
- ALL DESIGN DETAILS ARE TYPICAL AND MUST BE USED IF DESIGN DETAIL DESIGNATION IS NOT SHOWN.
 - THE TERM STANDARD DETAIL, OR A FORM OF IT, IS SYNONYMOUS WITH DESIGN DETAIL AND REFERS TO THE DESIGN DETAILS FOUND IN THIS SET OF CONTRACT DOCUMENTS.
 - THE DESIGN DETAILS REPRESENT THE CHARACTER AND NATURE OF THE WORK REQUIRED THROUGHOUT THE PROJECT. ALL ASSOCIATED WORK SHALL BE IN ACCORDANCE WITH THE DESIGN DETAILS SHOWN WHETHER THE DETAILS ARE SPECIFICALLY REFERENCED OR NOT.

KEY NOTE DESIGNATION

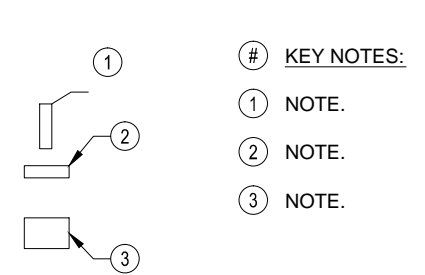

CONSTRUCTION NOTES:

- NO CONSTRUCTION SHALL BE STARTED WITHOUT A NOTICE TO PROCEED BY THE CITY ENGINEERING DEPARTMENT. THE CITY ENGINEERING DEPARTMENT AND THE DESIGN ENGINEER SHALL BE NOTIFIED AT LEAST 24 HOURS PRIOR TO THE START OF CONSTRUCTION. ANY CONSTRUCTION WORK DONE PRIOR TO NOTICE TO PROCEED BEING ISSUED OR WITHOUT INSPECTION WILL BE REJECTED.
- CONTRACTOR SHALL VERIFY ALL CONDITIONS ON THE JOB SITE INCLUDING BUT NOT LIMITED TO, ALL DIMENSIONS, GRADES, ELEVATIONS, EXTENT AND COMPATIBILITY TO THE EXISTING SITE CONDITIONS, AND WITH THE WORK DESCRIBED ON THE ENGINEER'S DRAWINGS. ANY DISCREPANCIES OR UNEXPECTED CONDITIONS THAT AFFECT OR CHANGE THE WORK DESCRIBED IN THE CONTRACT DOCUMENTS SHALL BE BROUGHT TO THE ENGINEER'S ATTENTION IMMEDIATELY. CONTRACTOR SHALL NOT PROCEED WITH ANY OF THE WORK IN THE AREA OF DISCREPANCIES UNTIL ALL SUCH DISCREPANCIES ARE RESOLVED. IF THE CONTRACTOR CHOOSES TO DO SO, THEN IT IS UNDERSTOOD THAT THE CONTRACTOR IS CHOOSING TO PROCEED AT THE CONTRACTOR'S OWN RISK AND SHALL INCUR ALL COSTS, IF ANY TO RESOLVE THE ISSUES TO THE SATISFACTION OF THE ENGINEER.
- A CITY INSPECTOR ACTING ON BEHALF OF THE CITY MAY REQUIRE REVISIONS IN PLANS TO SOLVE UNFORESEEN PROBLEMS THAT MAY ARISE IN THE FIELD.
- ALL CONSTRUCTION WORK AND INSTALLATIONS SHALL CONFORM TO THE CITY STANDARDS AND SPECIFICATIONS, AND ALL WORK SHALL BE SUBJECT TO THE APPROVAL OF THE CITY.
- IT SHALL BE THE RESPONSIBILITY OF THE CONTRACTOR TO CONTACT "UNDERGROUND LOCATE SERVICE" AT 1-800-332-2344 AT LEAST 48 BUSINESS-DAY HOURS PRIOR TO THE START OF CONSTRUCTION FOR THE LOCATION OF POWER, GAS, CABLE TV AND TELEPHONE UNDERGROUND FACILITIES. THE CONTRACTOR WILL ALSO BE RESPONSIBLE FOR CONTACTING THE APPROPRIATE PUBLIC AGENCY FOR THE LOCATION OF UNDERGROUND FACILITIES.
- ALL UTILITIES SHOWN ARE ACCURATE TO THE EXTENT OF AVAILABLE RECORDS AND KNOWLEDGE. NO POT-HOLING TO VERIFY LOCATIONS AND ELEVATIONS WAS AUTHORIZED BY THE OWNER. THE CONTRACTOR HAS THE TOTAL RESPONSIBILITY TO VERIFY THE LOCATION OF EXISTING UNDERGROUND UTILITIES AND TO NOTIFY THE UTILITY COMPANIES WHEN WORKING IN THEIR PROXIMITY. CONTRACTOR TO VERIFY LOCATION OF EXISTING UTILITIES PRIOR TO CONSTRUCTION. OREGON LAW REQUIRES YOU TO FOLLOW RULES ADOPTED BY THE OREGON UTILITY NOTIFICATION CENTER. THOSE RULES ARE SET FORTH IN OAR 952-001-0010 THROUGH 952-001-0090. YOU MAY OBTAIN COPIES OF THE RULES BY CALLING THE CENTER. THE TELEPHONE NUMBER FOR THE OREGON UTILITY NOTIFICATION CENTER IS (503)232-2987.
- ALL GRADING SHALL BE IN CONFORMANCE WITH THE CURRENT CITY STANDARDS AND SPECIFICATIONS AND CURRENT GRADING ORDINANCE. ALL SUBGRADE MATERIAL SHALL BE CONSIDERED CLASS A AND COMPACTED TO 95% OF OPTIMUM DENSITY. AS SPECIFIED IN THESE PLANS, ALL FILL MATERIAL SHALL BE COMPACTED TO 95% RELATIVE COMPACTION PER THE CITY TESTING REQUIREMENTS.
- ALL FINAL CUT SLOPES SHALL NOT EXCEED A GRADE OF 3 TO 1 VERTICAL UNLESS OTHERWISE APPROVED. FILL SLOPES SHALL NOT EXCEED A GRADE OF 2 HORIZONTAL TO 1 VERTICAL UNLESS OTHERWISE APPROVED BY THE ENGINEER.
- ALL UNSUITABLE SOILS MATERIALS, RUBBISH AND DEBRIS RESULTING FROM GRADING OPERATIONS SHALL BE REMOVED FROM THE JOB SITE AND DISPOSED OF PROPERLY.
- THE CONTRACTOR SHALL EMPLOY ALL LABOR, EQUIPMENT, AND METHODS REQUIRED TO PREVENT DUST IN AMOUNTS DAMAGING TO PROPERTY, CULTIVATED VEGETATION AND DOMESTIC ANIMALS OR CAUSING A NUISANCE TO PERSONS OCCUPYING BUILDINGS IN THE VICINITY OF THE JOB SITE. THE CONTRACTOR SHALL BE RESPONSIBLE FOR ANY DAMAGE CAUSED BY DUST RESULTING FROM CONSTRUCTION.
- THE CONTRACTOR SHALL FOLLOW ALL APPLICABLE INDUSTRIAL SAFETY REGULATIONS. THE CITY AND DESCHUTES COUNTY AND THEIR OFFICIALS, THE ENGINEER, AND THE OWNER SHALL NOT BE RESPONSIBLE FOR ENFORCING SAFETY REGULATIONS.
- MATERIAL QUANTITIES USED, NOTED, OR PROVIDED IN A SEPARATE ITEMIZED QUANTITY TAKE-OFF ARE AN ENGINEER'S OPINION OF PROBABLE MATERIAL REQUIREMENTS, AND IS AN ESTIMATE ONLY. CONTRACTOR'S HAVE THE SOLE RESPONSIBILITY OF MAKING THEIR OWN QUANTITY TAKE-OFF AND COST ESTIMATE.
- ALL WORK SHALL BE PERFORMED BY A CITY APPROVED CONTRACTOR.
- UTILITIES SHALL HAVE THE RIGHT TO INSTALL, MAINTAIN, AND OPERATE THEIR EQUIPMENT ABOVE AND BELOW GROUND AND ALL OTHER RELATED FACILITIES WITHIN THE PUBLIC UTILITY EASEMENTS (PUE) IDENTIFIED ON THIS PLAT MAP AS MAY BE NECESSARY OR DESIRABLE IN SERVING THE LOTS IDENTIFIED HEREIN, INCLUDING THE RIGHT OF ACCESS TO SUCH FACILITIES AND THE RIGHT TO REQUIRE THE REMOVAL OF ANY OBSTRUCTIONS INCLUDING TREES AND VEGETATION THAT MAY BE PLACED WITHIN THE PUE AT THE LOT OWNERS EXPENSE. AT NO TIME MAY ANY PERMANENT STRUCTURES BE PLACED WITHIN THE PUE OR ANY OTHER OBSTRUCTION WHICH INTERFERES WITH THE USE OF THE PUE WITHOUT PRIOR WRITTEN APPROVAL OF THE UTILITIES AND FACILITIES IN THE PUE.
- CITY ENGINEER'S SIGNATURE DOES NOT CONSTITUTE APPROVAL OF FACILITIES PROPOSED ON PRIVATE PROPERTY. SEPARATE PERMITS ISSUED BY THE BUILDING DEPARTMENT ARE REQUIRED AND SHALL BE OBTAINED BY THE DEVELOPER FOR FACILITIES LOCATED OUTSIDE OF THE PUBLIC RIGHT-OF-WAY.
- ANY WORK WITHIN EXISTING PUBLIC RIGHT-OF-WAY OR DEDICATED CITY EASEMENTS REQUIRES A SEPARATE RIGHT-OF-WAY EXCAVATION PERMIT OBTAINED FROM THE CITY ENGINEERING DIVISION.

SANITARY SEWER SYSTEM



APPROVED FOR CONSTRUCTION:

DATE

FOR SAMPLE ONLY

RECORD DRAWINGS

REVISIONS DRAWN BY: XX DATE: XX/XX/XX

THESE RECORD DRAWINGS HAVE BEEN PREPARED, IN PART, ON THE BASIS OF INFORMATION COMPILED BY OTHERS. THEY ARE NOT INTENDED TO REPRESENT IN DETAIL THE EXACT LOCATION, TYPE OF COMPONENT NOR MANNER OF CONSTRUCTION. THE ENGINEER WILL NOT BE RESPONSIBLE FOR ANY ERRORS OR OMISSIONS WHICH HAVE BEEN INCORPORATED INTO THE RECORD DRAWINGS.



(PROJECT NAME)
GENERAL
INDEX, NOTES, AND SIGNATURE BLOCK
DESCHUTES COUNTY, OREGON



REVISIONS:

(CONSULTANT ENGINEER NAME, ADDRESS & PHONE NUMBER)

DESIGNED BY: _____
DRAWN BY: _____
SCALE: _____
FILE: _____
DATE: _____

VERIFY SCALES
0 1"
BAR EQUALS ONE INCH ON ORIGINAL DRAWING

SHEET: **G-001**

COB # (XXXXXX)

1		2		3		4		5		6	
ABBREVIATIONS						INSTRUMENTATION EQUIPMENT ABBREVIATIONS LIST					
⊙	AT	FA	FIRST AID KIT	OC	ON CENTER	TG	TEMPERD GLASS	ACV	ANALYZER CONTROL VALVE	PCU	PROCESS CONTROL UNIT
A/B	AERATION BASIN	FAB	FABRICATION	OD	OUTSIDE DIAMETER, OVERFLOW DRAIN	THK	THICK	AE	ANALYZER ELEMENT	PCV	PRESSURE CONTROL VALVE
AB	ANCHOR BOLT	FFE	FINISHED FLOOR ELEVATION	O.F.	OUTSIDE FACE	THRD	THREADED	AI	ANALYZER INDICATOR	PDI	PRESSURE DIFFERENTIAL INDICATOR
ABDN	ABANDONED	FACIL	FACILITY	OFE	OWNER-FURNISHED EQUIPMENT	T.O.	TOP OF	AIC	ANALYZER INDICATING CONTROLLER	PDIC	PRESSURE DIFF. INDICATING CONTROLLER
ACBD	ACOUSTICAL BOARD	FCA	FLANGED COUPLING ADAPTER	OVHD	OVERHEAD	TOG	TOP OF GROUT	AIT	ANALYZER INDICATING TRANSMITTER	PDIT	PRESSURE DIFF. INDICATING TRANSMITTER
ACST	ACOUSTICAL TILE	FACTY	FACTORY	O TO O	OUT TO OUT	TPD	TONS PER DAY	ANT	ANTENNA	PDS	PRESSURE DIFFERENTIAL SWITCH
AD	AREA DRAIN	FD	FLOOR DRAIN	OPNG	OPENING	TPI	TURNOUT POINT OF INTERSECTION	AR	ANALYZER RECORDER	PDSH	PRESSURE DIFFERENTIAL SWITCH HIGH
ADDL	ADDITIONAL	FDN	FOUNDATION	OPP	OPPOSITE	TRANSV	TRANSVERSE	ARC	ANALYZER RECORDING CONTROLLER	PDSL	PRESSURE DIFFERENTIAL SWITCH LOW
ADJ	ADJACENT	FEXT	FIRE EXTINGUISHER	PL	PLATE	TRD	TREAD	ASH	ANALYZER SWITCH HIGH HIGH	PDT	PRESSURE DIFFERENTIAL TRANSMITTER
AFF	ABOVE FINISH FLOOR	FLL	FINISHED FLOOR	PLAM	PLASTIC LAMINATE	TSS	TOTAL SUSPENDED SOLIDS	ASHH	ANALYZER SWITCH HIGH HIGH	PE	PRESSURE ELEMENT
AHR	ANCHOR	FLL	FLOW LINE ELEVATION	PLYWD	PLYWOOD	TST	TOP OF STEEL	ASL	ANALYZER SWITCH LOW	PHE	pH ELEMENT
AL	ALUMINUM	FLEX	FLEXIBLE	POC	POINT ON CURVE	TTD	TOILET TISSUE DISPENSER	ASLL	ANALYZER SWITCH LOW LOW	PHR	pH RECORDER
ALTN	ALTERNATE	FLG	FLANGE	PI	POINT OF INTERSECTION	TW	TOP OF WALL	ARIC	ANALYTICAL RATIO INDICATING CONTROLLER	PI	PRESSURE INDICATOR
APPROX	APPROXIMATE	FL	FLOOR	PI&ID	PROCESS AND INSTRUMENTATION DIAGRAM	TYP	TYPICAL	AT	ANALYZER TRANSMITTER	PIC	PRESSURE INDICATING CONTROLLER
APVD	APPROVED	FNSH	FINISH	PJF	PREMOLDED JOINT FILLER	UBC	UNIFORM BUILDING CODE	CAB	CABINET	PIT	PRESSURE INDICATING TRANSMITTER
ARCH.	ARCHITECTURAL	FOT	FLAT ON TOP	PL	PLATE	UH	UNIT HEATER	EXP	VOLTS TO PRESSURE TRANSDUCER	PR	PRESSURE RECORDER
ASSY	ASSEMBLY	GA	GAUGE, GAGE	PLAM	PLASTIC LAMINATE	UON	UNLESS OTHERWISE NOTED	FCV	FLOW CONTROL VALVE	PRN	PRINTER
AVG	AVERAGE	GB	GRAB BAR	PLYWD	PLYWOOD	UNO	UNLESS NOTED OTHERWISE	FE	FLOW ELEMENT	PSH	PRESSURE SWITCH HIGH
BD	BOARD	GAL	GALLON	POC	POINT ON CURVE	UR	URNAL	FI	FLOW INDICATOR	PSHH	PRESSURE SWITCH HIGH HIGH
BETW	BETWEEN	GALV	GALVANIZED	POT	POINT ON TANGENT	V	VENT, VOLT	FIC	FLOW INDICATING CONTROLLER	PSHL	PRESSURE SWITCH HIGH LOW
BF	BOTTOM FACE	GALVS	GALVANIZED STEEL	PR	PAIR	VAC	VACUUM	FIR	FLOW INDICATING RECORDER	PSL	PRESSURE SWITCH LOW
BLDG	BUILDING	GD	GALLONS PER DAY	PRV	PRESSURE REDUCING VALVE	V.A.T.	VINYL ASBESTOS TILE	FIT	FLOW INDICATING TRANSMITTER	PSLL	PRESSURE SWITCH LOW LOW
BM	BEAM	GRD	GROUND	PS	PUMP STATION	VC	VERTICAL	FQ	FLOW TOTALIZER/INTEGRATOR	PT	PRESSURE TRANSMITTER
BOD	BOTTOM OF DUCT	GRTG	GRATING	PSF	POUNDS PER SQUARE FOOT	VERT	VERTICAL	FQI	FLOW TOTALIZER INDICATOR	PXI	PRESSURE TO CURRENT TRANSDUCER
BOT	BOTTOM	GVL	GRAVEL	PSI	POUNDS PER SQUARE INCH	VCP	VITRIFIED CLAY PIPE	FQIT	FLOW TOTALIZER INDICATING TRANSMITTER	PXP	PRESSURE TO PRESSURE TRANSDUCER
BRG	BEARING	GWB	GYPSPUM WALLBOARD	PT	POINT OF TANGENCY	VTR	VENT THRU ROOF	FR	FLOW RECORDER	PY	PRESSURE CONVERTER (SIGNAL BOOST)
BST	BOTTOM OF STEEL	GYP PLAS	GYPSPUM PLASTER	PTD	PAPER TOWEL DISPENSER	VWC	VINYL WALL COVERING	FSH	FLOW SWITCH HIGH	PZ	PRESSURE POSITIONER (ADJUST FOR PRESSURE CONTROL VALVE)
CAB.	CABINET	H.A.S	HEADED ANCHOR STUD	PTD/R	PAPER TOWEL DISPENSER/RECTACLE	W	WEST, WIDE FLANGE (BEAM)	FSH	FLOW SWITCH HIGH	RIO	REMOTE INPUT/OUTPUT PROCESSOR
CCP	CONCRETE CYLINDER PIPE	HD	HUB DRAIN	PTRD	PRESSURE TREATED	W/	WITH	FSHH	FLOW SWITCH HIGH HIGH	SAMP	SAMPLER
C/C	CHLORINE CONTACT	HDR	HARDNER	PVC	POINT OF VERTICAL CURVATURE	WAS	WASTE ACTIVATED SLUDGE	FSHL	FLOW SWITCH HIGH LOW	SE	SPEED ELEMENT
CEM PLAS	CEMENT PLASTER	HGT	HEIGHT	PVC	POLYVINYL CHLORIDE	WC	WATER CLOSET	FSL	FLOW SWITCH LOW	SI	SPEED INDICATOR (TACHOMETER)
CHEM	CHEMICAL	HPT	HIGH POINT	PVI	POINT OF VERTICAL INTERSECTION	WD	WOOD	FSL	FLOW SWITCH LOW	ST	SPEED TRANSMITTER
CHKD PL	CHECKERED PLATE	HR	HANDRAIL	PVM	PAVEMENT	WG	WIRE GLASS	FSL	FLOW SWITCH LOW	SV	SOLENOID VALVE
CFM	CUBIC FEET PER MINUTE	HS	HIGH STRENGTH	PVT	POINT OF VERTICAL TANGENCY	WH	WATER HEATER	FSL	FLOW SWITCH LOW	SWR	SWITCHER
CI	CAST IRON	I&C	INSTRUMENTATION AND CONTROL	QDRT	QUADRANT	WK	WEEK	FSL	FLOW SWITCH LOW	SY	SPEED CONVERTER (TRANSDUCER)
CIP	CAST IN PLACE	ID	INSIDE DIAMETER	QTY	QUANTITY	WP	WORKING POINT	FT	FLOW TRANSMITTER	SZ	SPEED ACTUATOR (ENGINE)
CJ	CONSTRUCTION JOINT	IE	INVERT ELEVATION	R	R-VALUE (INSULATION)	WR	WATER RESISTANT GYPSPUM WALLBOARD	GWY	GATEWAY	TC	TEMPERATURE CONTROLLER
Q OR CL	CENTER LINE	I.F.	INSIDE FACE	R OR RAD	RADIUS	WR	WASTE RECEPTACLE	HC	HAND CONTROLLER	TCV	TEMPERATURE CONTROL VALVE
CL 2	CHLORINE	INF	INFLUENT	RISER	RISER	WS	WATER STOP, WATERSURFACE, WELDED STEEL	HIC	HAND INDICATING CONTROLLER	TE	TEMPERATURE ELEMENT
CLG	CEILING	INFL	INFLUENT	RC	REINFORCED CONCRETE	WTR	WATER	HS	HAND SWITCH	TI	TEMPERATURE INDICATOR
CLR	CLEAR	INSTL	INSTALL	RCP	REINFORCED CONCRETE PIPE	WWM	WELDED WIRE MESH	HOA	HAND-OFF-AUTO SWITCH	TIC	TEMPERATURE INDICATING CONTROL
CLR	CLEAR	INSUL	INSULATION	RD	ROOF DRAIN	XFMR	TRANSFORMER	ICI	INFINET TO COMPUTER INTERFACE	TIS	TEMPERATURE INDICATING SWITCH
CMP	CORRUGATED METAL PIPE	INTG	INSULATED TEMPERED GLASS	RDCR	REDUCER	YD	YARD	KY	TIME RELAY	TIT	TEMPERATURE INDICATING TRANSMITTER
CMU	CONCRETE MASONARY UNITS	IT	INVERT	REHAB	REHABILITATE	YR	YEAR	L/R	LOCAL/REMOTE SWITCH	TQI	TORQUE INDICATOR
COB	CITY OF BEND	JT	JOINT	REINF	REINFORCE, REINFORCED, REINFORCING			LC	LEVEL CONTROLLER	TQIC	TORQUE INDICATING CONTROLLER
COL	COLUMN	L	LENGTH OF CURVE	REQD	REQUIRED			LCV	LEVEL CONTROL VALVE	TQIT	TORQUE INDICATING TRANSMITTER
CONC	CONCRETE	LB	POUNDS	RESIL	RESILIENT			LE	LEVEL ELEMENT	TQR	TORQUE RECORDER
CONN	CONNECTION	LB/D	POUNDS PER DAY	RM	ROOM			LG	LEVEL GAUGE	TQS	TORQUE SWITCH
CONST	CONSTRUCTION	LG	LONG	RO	ROUGH OPENING			LI	LEVEL INDICATOR	TQSH	TORQUE SWITCH HIGH
CONT	CONTINUOUS	LLV	LONG LEG VERTICAL	RST	REINFORCING STEEL			LIC	LEVEL INDICATING CONTROLLER	TQT	TORQUE TRANSMITTER
COR	CORNER	LNTL	LONG LITEL	S	SOUTH			LIS	LEVEL SWITCH HIGH	TR	TEMPERATURE RECORDER
CPLG	COUPLING	LNLC	LONG LEG VERTICAL	S.A.T.	SUSPENDED ACOUSTICAL TILE			LSH	LEVEL SWITCH HIGH HIGH	TSH	TEMPERATURE SWITCH HIGH
CPVC	CHLORINATED POLYVINYL CHLORIDE	LONG.	LONGITUDINAL	S/C	SECONDARY CLARIFIERS			LSHL	LEVEL SWITCH HIGH LOW	TSHH	TEMPERATURE SWITCH HIGH HIGH
C TO C	CENTER TO CENTER	LPT	LOW POINT	SCBA	SELF CONTAINED BREATHING APPARATUS			LSL	LEVEL SWITCH LOW	TSL	TEMPERATURE SWITCH LOW
CTR	CENTER	LT	LIGHT	SCHED	SCHEDULE			LSM	LEVEL SWITCH LOW LOW	TSLL	TEMPERATURE SWITCH LOW LOW
CTRD	CENTERED	MATL	MATERIAL	SD	SOAP DISPENSER, STORM DRAIN			LSM	LEVEL SWITCH MIDDLE	TT	TEMPERATURE TRANSMITTER
CU FT	CUBIC FEET	MAX	MAXIMUM	SECT	SECTION			LT	LEVEL TRANSMITTER	TW	THERMAL WELL
∟	CENTRAL ANGLE	MB	MACHINE BOLT	SG	SAFETY GLASS			MCD	MOTORIZED CONTROL DAMPER	TY	TEMPERATURE SELECT
DAFT	DISSOLVED AERATION FLOTATION THICKENING	MCC	MOTOR CONTROL CENTER	SH	SHEET			MPA	ANALOG MARSHALLING PANEL	UI	MULTIVARIABLE INDICATOR
DBA	DEFORMED BAR ANCHOR	MECH	MECHANICAL	SHG	SHEETING			MPC	MARSHALLING PANEL CONTROL	UR	MULTIVARIABLE RECORDER
DBL	DOUBLE	MFR	MANUFACTURER	SIM	SIMILAR			MPD	DIGITAL MARSHALLING PANEL	USH	MULTIVARIABLE SWITCH HIGH
DET	DETAIL	MGD	MILLION GALLONS PER DAY	SLV	SHORT LEG VERTICAL			MSL	MOTION SWITCH	VDT	VIDEO DISPLAY
DIA	DIAMETER	MG/L	MILLIGRAMS PER LITRE	S.O.	SHUTOFF			NE	MOISTURE PROBE	WI	WEIGHT INDICATOR
DIAG	DIAGONAL	MH	MANHOLE	SPEC	SPECIFIED			NI	MOISTURE INDICATOR	WT	WEIGHT INDICATING TRANSMITTER
DIM	DIMENSION	MIN	MINIMUM	SPECS	SPECIFICATIONS			NSH	MOISTURE SWITCH HIGH	XV	REMOTELY CONTROLLED ON-OFF VALVE
DIP.	DUCTILE IRON PIPE	MISC	MISCELLANEOUS	SPG	SPACING			OJB	OPTICAL JUNCTION BOX	ZI	POSITION INDICATOR
DIR	DIRECTION	MLSS	MIXED LIQUOR SUSPENDED SOLIDS	SPQ	SQUARE					ZIS	POSITION INDICATING SWITCH
DISCH	DISCHARGE	MLVSS	MIXED LIQUOR VOLATILE SUSPENDED SOLIDS	SQ	SQUARE					ZIT	POSITION INDICATING TRANSMITTER
DN	DOWN	MON	MASONARY OPENING	SST	STAINLESS STEEL					ZS	POSITION SWITCH
DS	DOWN SPOUT	MTG	MOUNTING	STA	STATION					ZSC	POSITION SWITCH CLOSED
DWG	DRAWING	MTR	METERING	STD	STANDARD					ZSO	POSITION SWITCH OPEN
DWL	DOWEL	N	NORTH	STIF	STIFFENER					ZT	POSITION TRANSMITTER
E	EAST	NO	NUMBER	STOR	STORAGE						
EA	EACH	NORM	NORMAL	STR	STRAIGHT						
ECC	ECCENTRIC	NTS	NOT TO SCALE	STRUCT	STRUCTURAL, STRUCTURE						
EFC	EACH FACE			STL	STEEL						
EFL	EFFLUENT			SWD	SIDE WATER DEPTH						
EL	ELEVATION			SYMM	SYMMETRICAL						
ELB	ELBOW			T	TINTED						
ELEC	ELECTRICAL			T	TANGENT LENGTH						
EP	EDGE OF PAVEMENT			T&B	TOP AND BOTTOM						
EQL	EQUAL			TAS	THREADED ANCHOR STUD						
EQL SP	EQUALLY SPACED			TC	TOP OF CONCRETE, TOP OF CURB						
EQPT	EQUIPMENT			TEMP	TEMPERED, TEMPERATURE						
EW	EACH WAY			TF	TOP FACE						
EXP JT	EXPANSION JOINT										
EXT	EXTERIOR, EXTERNAL, EXTENSION										
EXST	EXISTING										

FOR SEALS AND SIGNATURES

(PROJECT NAME)
GENERAL
DESCHUTES COUNTY, OREGON



REVISIONS:

(CONSULTANT ENGINEER NAME, ADDRESS & PHONE NUMBER)


DESIGNED BY:
DRAWN BY:
SCALE:
FILE:
DATE:

VERIFY SCALES
0 1" BAR EQUALS ONE INCH ON ORIGINAL DRAWING


SHEET: G-002

COB # (XXXXXX)

PIPE IDENTIFICATION

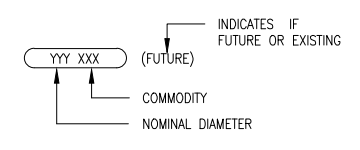

EQUIPMENT NUMBERING CONVENTION

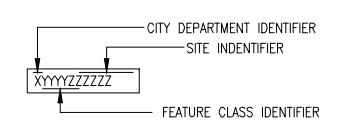

GENERAL NOTES

- THIS DRAWING IS GENERAL IN NATURE, SOME ABBREVIATIONS SHOWN HERE MAY NOT BE USED.
- SEE DRAWING G-04 FOR PROCESS EQUIPMENT LEGEND AND PIPING SYMBOLS.
- SEE DRAWING G-05 FOR INSTRUMENTATION SYMBOLS.
- SEE DRAWING G-06 AND G-07 FOR ELECTRICAL SYMBOLS.
- SEE DRAWING G-08 FOR STRUCTURAL NOTES.
- ADDITIONAL ABBREVIATIONS FOR INSTRUMENTATION EQUIPMENT CAN BE FOUND USING THE FUNCTIONAL IDENTIFICATION MATRIX ON DRAWING G-05.

FOR SAMPLE ONLY

RECORD DRAWINGS
REVISIONS DRAWN BY: XX DATE: XX/XX/XX
THESE RECORD DRAWINGS HAVE BEEN PREPARED, IN PART, ON THE BASIS OF INFORMATION COMPILED BY OTHERS. THEY ARE NOT INTENDED TO REPRESENT IN DETAIL THE EXACT LOCATION, TYPE OF COMPONENT NOR MANNER OF CONSTRUCTION. THE ENGINEER WILL NOT BE RESPONSIBLE FOR ANY ERRORS OR OMISSIONS WHICH HAVE BEEN INCORPORATED INTO THE RECORD DRAWINGS.

	1	2	3	4	5	6
	EQUIPMENT		EQUIPMENT		PROCESS LINES	
A	VARIABLE SPEED CONTROLLER (ELEC) BAR SCREEN, MECHANICAL INLINE SLUDGE SCREEN BLOWER OR CENTRIFUGAL FAN SLIDING VANE COMPRESSOR BOILER BURNER, WASTE GAS CENTRIFUGE CHILLER COMPRESSOR, ROTARY SCREW COMPRESSOR, PISTON DIFFUSER HEADER ENGINE EJECTOR, PNEUMATIC FILTER OR FILTER-SILENCER, INLET AIR RIGHT ANGLE GEAR TURBINE GENERATOR GRINDER HEAT EXCHANGER, PLATE TYPE HEAT EXCHANGER, SPIRAL TYPE HEAT EXCHANGER, STRAIGHT TUBE TYPE HEAT EXCHANGER, U-TUBE TYPE	MIXER MIXER, HORIZONTAL SURFACE MIXER, INLINE STATIC MOTOR PUMP, CENTRIFUGAL PUMP, DIAPHRAGM PUMP, DIAPHRAGM OPERATED PUMP, GEAR PUMP, IN-LINE CENTRIFUGAL PUMP, METERING PUMP, PROGRESSIVE CAVITY PUMP, ROTARY LOBE PUMP, SUBMERSIBLE PUMP, VERTICAL PUMP, LINE SHAFT WEIR STOP LOG SLIDE GATE (NORMALLY CLOSED) SLIDE GATE (NORMALLY OPEN) RECTANGULAR BUTTERFLY VALVE (NORMALLY CLOSED) RECTANGULAR BUTTERFLY VALVE (NORMALLY OPEN) SLIDE GATE (NORMALLY CLOSED) SLIDE GATE (NORMALLY OPEN) TELESCOPIC GATE VALVE	FLAP GATE SCREEN, ROTARY OVERFLOW SILENCER CONDENSATE TANK RECEIVER OR PRESSURE VESSEL TANK, DOUBLE WALLED TANK	PRIMARY PROCESS FLOW SECONDARY PROCESS FLOW FUTURE VENDOR PACKAGE BOUNDARY EXISTING PIPING AND EQUIPMENT EXISTING PIPING TO BE REMOVED ENCLOSURE BOUNDARY		
B			VALVES		EQUIPMENT LEGENDS	
			THREE WAY VALVE SOLENOID VALVE GATE VALVE (NORMALLY OPEN) GATE VALVE (NORMALLY CLOSED) PLUG VALVE (NORMALLY OPEN) PLUG VALVE (NORMALLY CLOSED) BALL VALVE (NORMALLY OPEN) BALL VALVE (NORMALLY CLOSED) BUTTERFLY VALVE BUTTERFLY DAMPER VALVE GLOBE VALVE DIAPHRAGM VALVE ANGLE VALVE FLOAT VALVE PINCH VALVE NEEDLE VALVE DOUBLE LEAF CHECK VALVE CHECK VALVE BALL CHECK VALVE REDUCED PRESSURE BACKFLOW PREVENTER DOUBLE CHECK VALVE BACKFLOW PREVENTER PUMP DISCHARGE VALVE (TRIPLE DUTY) GAUGE OR ROOT VALVE KNIFE GATE VALVE BALANCING COCK CIRCUIT BALANCING VALVE THERMOSTATICALLY CONTROLLED VALVE PRESSURE REGULATING VALVE (EXTERNAL SENSING) PRESSURE REGULATING VALVE (INTERNAL SENSING) BACK PRESSURE REGULATING VALVE PRESSURE AND VACUUM RELIEF VALVE VACUUM RELIEF VALVE PRESSURE RELIEF VALVE IN-LINE, SPRING LOADED RELIEF VALVE MUD VALVE		NEW EXISTING DEMOLISHED	
C			VALVE OPERATORS		PROCESS AND SIGNAL CROSS REFERENCE SYSTEM	
			SOLENOID HAND JACK W/ POSITIONER DIAPHRAGM (PRESSURE BALANCE) DIAPHRAGM (SPRING OPPOSED) SELF REGULATING PRESSURE BALANCE PISTON MOTOR		<p>1. ON DRAWING W-P2-PID1001 CONTINUATION IS SHOWN AS:</p> <p>2. ON DRAWING W-P2-PID1002 THIS CONTINUATION IS SHOWN AS:</p>	
D			FITTINGS/LINE STRAINERS			
			UNION CONCENTRIC ECCENTRIC FLAT BOTTOM ECCENTRIC FLAT TOP FLEX CONNECTOR BLIND FLANGES EXPANSION JOINT FLAME ARRESTOR WELDED CAP QUICK CONNECT DRAIN TO GRADE/GROUND SPRAY NOZZLE STEAM TRAP DIAPHRAGM SEAL PIPING SPECIFICATION BREAK SPEC. CHANGE TIE POINT RUPTURE DISC Y-STRAINER W/VALVE Y-STRAINER W/VALVE Y-STRAINER PLUGGED T-STRAINER TEMP. STRAINER CLEAN OUT SAMPLE STEAM OUT WATER PURGE			
			GENERAL NOTES			
			<p>1. THIS DRAWING IS GENERAL IN NATURE. SOME SYMBOLS SHOWN HERE MAY NOT BE USED.</p> <p>2. SEE DRAWING G-002 FOR EQUIPMENT AND PIPE COMMODITY DESIGNATION SYSTEMS.</p> <p>3. SEE DRAWING G-004 FOR INSTRUMENTATION SYMBOLS.</p> <p>4. TAG NAMING CONVENTION IS NOT FINALIZED IN THIS REVISION.</p>			

FOR SEALS AND SIGNATURES

(PROJECT NAME)
GENERAL
PROCESS EQUIPMENT LEGEND AND PIPING SYMBOLS
DESCHUTES COUNTY, OREGON



REVISIONS:

(CONSULTANT ENGINEER NAME, ADDRESS & PHONE NUMBER)

DESIGNED BY: _____
DRAWN BY: _____
SCALE: _____
FILE: _____
DATE: _____

VERIFY SCALES
0 1"
BAR EQUALS ONE INCH ON ORIGINAL DRAWING

SHEET: **G-003**
COB # (XXXXXX)

FOR SAMPLE ONLY
RECORD DRAWINGS
REVISIONS DRAWN BY: XX DATE: XX/XX/XX
THESE RECORD DRAWINGS HAVE BEEN PREPARED, IN PART, ON THE BASIS OF INFORMATION COMPILED BY OTHERS. THEY ARE NOT INTENDED TO REPRESENT IN DETAIL THE EXACT LOCATION, TYPE OF COMPONENT NOR MANNER OF CONSTRUCTION. THE ENGINEER WILL NOT BE RESPONSIBLE FOR ANY ERRORS OR OMISSIONS WHICH HAVE BEEN INCORPORATED INTO THE RECORD DRAWINGS.

FUNCTIONAL IDENTIFICATION				
FIRST LETTER		SUCCEEDING-LETTERS		
MEASURED OR INITIATING VARIABLE	MODIFIER	READOUT OR PASSIVE FUNCTION	OUTPUT FUNCTION	MODIFIER
A	ANALYSIS	ALARM		
B	BURNER, COMBUSTION		CLOSE-STOP DECREASE	
C	CONDUCTIVITY, pH (ACIDITY)	CLOSE	CONTROL OR CONTROLLER	
D	DENSITY		OPEN-START-INCREASE	
E	VOLTAGE	SENSOR (PRIMARY ELEMENT)		
F	FLOW RATE	RATIO (FRACTION)		FAIL
G	GAS	GLASS VIEWING DEVICE		
H	HAND			H-HIGH-(ALARM) HH-HIGH-(SHUTDOWN)
I	CURRENT (ELECTRICAL)	INDICATE		
J	POWER	SCAN		
K	TIME, TIME SCHEDULE	TIME RATE OF CHANGE		CONTROL STATION
L	LEVEL			L-LOW-(ALARM) LL-LOW-(SHUTDOWN)
M	MOISTURE	MOMENTARY	ON OR OPERATE	MIDDLE-INTERMEDIATE
N			SET POINT	
O	UNCLASSIFIED		OPEN ORIFICE, RESTRICTION POINT (TEST) CONNECTION	OVERLOAD
P	PRESSURE, VACUUM			PNEUMATIC
Q	QUANTITY	INTEGRATE, TOTALIZE		INTEGRATE OR TOTALIZE
R	RADIATION		RECORD	
S	SPEED, FREQUENCY, SOLENOID	SAFETY		SWITCH, OR SAFETY
T	TEMPERATURE			TRANSMIT
U	MULTIVARIABLE		MULTIFUNCTION	
V	VIBRATION, MECHANICAL ANALYSIS		VALVE, DAMPER, LOUVRE	MULTIFUNCTION
W	WEIGHT, FORCE		WELL	
X	ON/OFF	X AXIS	UNCLASSIFIED	UNCLASSIFIED
Y	EVENT, STATE, PRESENCE	Y AXIS	RELAY, COMPUTE, CONVERT	UNCLASSIFIED
Z	POSITION, DIMENSION	Z AXIS	DRIVER, ACTUATOR, UNCLASSIFIED - FINAL CONTROL ELEMENT	

INSTRUMENT AND FUNCTION SYMBOLS	
	FIELD MOUNTED INSTRUMENT
	ANALOG OUTPUT
	LOCAL PANEL - MOUNTED INSTRUMENT, ACCESSIBLE
	INSTRUMENT MOUNTED BEHIND LOCAL CONTROL PANEL, NOT READILY ACCESSIBLE
	INSTRUMENT MOUNTED ON MAIN PANEL, ACCESSIBLE
	INSTRUMENT MOUNTED BEHIND MAIN PANEL, NOT READILY ACCESSIBLE
	GENERALIZED FOR COMPLEX INTERLOCK LOGIC PERFORMED IN SOFTWARE. SEE SPECIFICATIONS FOR DETAILS.
	FIELD MOUNT ANNUNCIATOR POINT
	MAIN PANEL MOUNT ANNUNCIATOR POINT
	LOCAL PANEL MOUNT ANNUNCIATOR POINT
	SPECIAL PURPOSE DIGITAL DEVICE FOR PROCESSING MAINLY ANALOG INFORMATION. ACCESSIBLE
	CONTROL SYSTEM DIGITAL INPUT/OUTPUT
	COMPUTER - INTERNAL SYSTEM FUNCTION (i.e. COMPUTATION/SIGNAL CONDITIONING)
	COMPUTER - INTERNAL SYSTEM FUNCTION NORMALLY ACCESSIBLE TO OPERATOR
	ANALOG INPUT
	EQUIPMENT TAG
	PROPOSED NEW INSTRUMENT
	PROPOSED REMOVAL

PRIMARY ELEMENT SYMBOLS	
	ORIFICE PLATE
	VENTURI OR FLOW TUBE
	FLUME
	WEIR
	VARIABLE AREA FLOW INDICATOR (ROTAMETER)
	FLOW ELEMENT INTEGRAL WITH TRANSMITTER (MASS FLOW, ETC)
	DIAPHRAGM SEAL
	IN-LINE PRESSURE SENSOR
	VORTEX FLOW SENSOR
	IN-LINE CAPACITANCE FLOW ELEMENT
	MAGNETIC FLOWMETER
	SONIC FLOWMETER (DOPPLER OR TRANSIT TIME)
	POSITIVE DISPLACEMENT METER
	THERMAL MASS FLOW ELEMENT
	ANNUBAR
	PITOT TUBE
	PROPELLER OR TURBINE METER
	CORIOLIS MASS FLOWMETER
	TILT FLOAT SWITCH
	FLOAT SWITCH
	DISPLACEMENT LEVEL ELEMENT
	ULTRASONIC/MICROWAVE LEVEL ELEMENT
	RADIO FREQUENCY LEVEL ELEMENT
	SUBMERSIBLE LIQUID LEVEL ELEMENT
	THERMAL SENSING RTD STRIP

TYPICAL INSTRUMENT IDENTIFICATION	
<p>FIELD TAG IDENTIFICATION</p> <p>EXAMPLE: WRF-001-PDSHH-001-1010-A1</p> <p>CITY DEPARTMENT IDENTIFIER - (3 CHARACTER) WATER RECLAMATION PLANT SPECIFIC - (4 CHARACTERS) LOOP NUMBER - (4 NUMERALS) SUFFIX - (UP TO 2 CHARACTERS)</p>	<p>SCHEMATIC IDENTIFICATION</p> <p>PROCESS FUNCTION CODE * FUNCTIONAL IDENTIFICATION CODE OPERATING FUNCTION * BASIC INSTRUMENT PANEL LOCATION * PROCESS IDENTIFIER</p>
<p>CITY DEPARTMENT IDENTIFIER - (3 CHARACTER)</p> <p>1. C - COLLECTIONS OPERATIONS 2. W - WATER OPERATIONS 3. D - DRAINAGE OPERATIONS 4. WRF - WATER RECLAMATION PLANT</p>	<p>WATER RECLAMATION PLANT SPECIFIC - (4 CHARACTERS)</p> <p>1. C - COLLECTIONS OPERATIONS 2. W - WATER OPERATIONS 3. D - DRAINAGE OPERATIONS 4. WRF - WATER RECLAMATION PLANT</p>
<p>FACILITY IDENTIFIER - (UP TO 4 CHARACTER)</p> <p>1. XXXX - COLLECTION PUMP STATIONS 2. XXXX - WATER RESERVOIR 3. XXXX - STORM SEWER STATIONS 4. XXXX - PRESSURE (XXX)</p>	<p>SUFFIX - (UP TO 2 CHARACTERS)</p> <p>USED ONLY WHEN 2 OR MORE INSTRUMENTS ARE IN THE LOOP</p>
<p>EQUIPMENT ACRONYM OR ISA - (UP TO 5 CHARACTER)</p> <p>SEE DWG WPRV015-G002 FOR DETAILS</p>	

INSTRUMENT OPERATING FUNCTIONS	
<p>ANALYTICAL FUNCTIONS</p> <p>RES Cl₂ RESIDUAL CHLORINE SO₂ SULFUR DIOXIDE COMB COMBUSTIBLE GAS H₂S HYDROGEN SULFIDE pH pH DO DISSOLVED OXYGEN O₂ OXYGEN VIB VIBRATION CO CONDUCTIVITY</p>	<p>SWITCHING FUNCTIONS</p> <p>3W THREE-WAY SWITCH EH EMERGENCY HIGH (24VDC BACKED) MS MOTOR-RATED SWITCH HA HAND-AUTO SELECTION HOA HAND-OFF-AUTO SELECTION JOA JOG-OFF-AUTO SELECTION S/S START-STOP L/L LEAD-LAG SELECTION LLCO LOW LEVEL CUT OFF F/S FAST-SLOW SELECTION OCA OPEN-CLOSE-AUTO SELECTION OSC OPEN-STOP-CLOSE SELECTION SEL SELECTOR SWITCH O/O ON-OFF SELECTION M/A MANUAL-AUTO SELECTION L/R LOCAL-REMOTE SELECTION ESD EMERGENCY SHUTDOWN ACK ACKNOWLEDGE (ALARM) D/P DIFFERENTIAL PRESSURE I/P CURRENT TO PRESSURE IBD INBOARD BEARING OBD OUTBOARD BEARING RSP REMOTE SET POINT RST RESET</p>
<p>INSTRUMENT SIGNAL SYMBOLS</p> <p>INSTRUMENT SUPPLY, PROCESS TAPS PNEUMATIC SIGNAL ELECTRIC SIGNAL DISCRETE, 120VAC ELECTRIC SIGNAL DISCRETE, 24VDC ELECTRIC SIGNAL ANALOG CAPILLARY TUBE OR FILLED SYSTEM ELECTROMAGNETIC OR SONIC SIGNAL (GUIDED) ELECTROMAGNETIC OR SONIC SIGNAL (UNGUIDED) SOFTWARE AND DATA LINK IN CONTROL SYSTEM MECHANICAL LINK HYDRAULIC</p>	<p>LINE DESIGNATIONS</p> <p>ES 120 VAC 60 HZ (UNLESS OTHERWISE NOTED) SA SERVICE AIR SUPPLY IA INSTRUMENT QUALITY AIR SUPPLY C2 WATER SUPPLY C1, C2, C3, ETC.</p>

MISCELLANEOUS SYMBOLS	
	INTERLOCK - SEE CONTROL STRATEGY DESCRIPTION
	RESET FOR LATCH-TYPE OPERATOR
	ANNUNCIATOR HORN
	GROUND
	INSTRUMENT LOOP SHIELD GROUND
	BOND
<p>GENERAL NOTES</p> <p>1. THIS DRAWING IS GENERAL IN NATURE. SOME SYMBOLS SHOWN HERE MAY NOT BE USED. 2. REFER TO DRAWING G-002 AND G-003 FOR EQUIPMENT AND PIPE COMMODITY DESIGNATIONS. 3. TAG NAMING CONVENTION IS NOT FINALIZED IN THIS REVISION.</p>	
<p>FOR SAMPLE ONLY</p> <p>RECORD DRAWINGS REVISIONS DRAWN BY: XX DATE: XX/XX/XX THESE RECORD DRAWINGS HAVE BEEN PREPARED, IN PART, ON THE BASIS OF INFORMATION COMPILED BY OTHERS. THEY ARE NOT INTENDED TO REPRESENT IN DETAIL THE EXACT LOCATION, TYPE OF COMPONENT NOR MANNER OF CONSTRUCTION. THE ENGINEER WILL NOT BE RESPONSIBLE FOR ANY ERRORS OR OMISSIONS WHICH HAVE BEEN INCORPORATED INTO THE RECORD DRAWINGS.</p>	

FOR SEALS AND SIGNATURES

(PROJECT NAME)
GENERAL

INSTRUMENTATION LEGEND AND SYMBOLS
DESCHUTES COUNTY, OREGON

CONSULTANT ENGINEER NAME, ADDRESS & PHONE NUMBER

DESIGNED BY: _____ DRAWN BY: _____ SCALE: _____ FILE: _____ DATE: _____

VERIFY SCALES
0 1" BAR EQUALS ONE INCH ON ORIGINAL DRAWING

SHEET: **G-004**

COB # (XXXXXX)

CIRCUITS AND RACEWAYS

MCC1000/HS1010-C RACEWAY IDENTIFIER

RACEWAY EXPOSED

RACEWAY CONCEALED

RACEWAY TURNED TOWARD THE VIEWER.

RACEWAY TURNED DOWN

CONDUIT PLUGGED FLUSH

CONDUIT CAPPED

DUCT BANK, NON-REINFORCED CONCRETE

DUCT BANK, REINFORCED CONCRETE

HH23 MANHOLE (MH) OR HANDHOLE (HH), X = CABLE TYPE (SEE CABLE IDENTIFICATION SYSTEM)

JB2700A JUNCTION BOX. OPTIONAL IDENTIFIER.

TB1035 TERMINAL BOX. OPTIONAL IDENTIFIER.

HOME RUN - SEE PANELBOARD, SWITCHBOARD, OR MCC SCHEDULE FOR CIRCUIT INFORMATION.

PBD-A-1,3,5

EXAMPLE: HOME TO PANELBOARD PBD-A, CIRCUITS 1, 3, AND 5.

DISTRIBUTION EQUIPMENT

APPROXIMATE SHAPE AND SCALE REPRESENTED WHERE POSSIBLE. HOWEVER, EXACT SIZE AND NUMBER OF SECTIONS IS ESTIMATED.

FLOOR-STANDING DISTRIBUTION ASSEMBLY, SUCH AS A SWITCHBOARD, TRANSFORMER, OR MOTOR CONTROL CENTER

MCC1234 EQUIPMENT DESIGNATION (EXAMPLE)

WALL-MOUNTED DISTRIBUTION ASSEMBLY, SUCH AS PANELBOARD, MOTOR STARTER PANEL, OR TERMINAL CABINET

PBD1234 120/208V EQUIPMENT DESIGNATION (EXAMPLE)

	120/240V
	120/208V
	480V

TRANSFORMER

GROUNDING

GROUND ROD

GROUND ROD WITH GROUND WELL

GROUND CONNECTION, COMPRESSION OR EXOTHERMIC.

GROUNDING CONDUCTOR

LIGHTING

FIXTURE IDENTIFIER:

NUMBER OF FIXTURES (OPTIONAL IDENTIFIER)

FIXTURE TYPE. REFER TO LIGHT SPEC. TYPE APPLIES TO ALL FIXTURES OF THE SAME SHAPE WITHIN A ROOM OR AREA.

MOUNTING (OPTIONAL IDENTIFIER):

L = POLE R = RECESSED
G = GROUND S = SURFACE
P = PENDANT W = WALL

MOUNTING HEIGHT, FLOOR TO BOTTOM OF FIXTURE UON. AHAP = AS HIGH AS POSSIBLE.

NUMBER OF LAMPS/LAMP WATTAGE (OPTIONAL IDENTIFIER)

LIGHTING FIXTURE SHAPES AND SCALE ARE REPRESENTED WHERE POSSIBLE. THE EXAMPLES SHOWN BELOW ARE TYPICAL APPLICATIONS.

FLUORESCENT FIXTURE

COMPACT FLUORESCENT OR HID FIXTURE

WALL MOUNTED FIXTURE

DIRECTIONAL LIGHT

POLE MOUNTED AREA LIGHT

EXISTING LIGHT POST

EMERGENCY LIGHTING UNIT. SELF CONTAINED.

EXIT SIGN. DARK QUADRANTS INDICATE FACES ILLUMINATED. DIRECTIONAL ARROWS INDICATED.

CIRCUIT IDENTIFIER: WHEN SHOWN ADJACENT TO FIXTURE IDENTIFIES CIRCUIT NUMBER AND SWITCH. EXAMPLE: CIRCUIT 3, CONTROLLED BY SWITCH a.

EXIT AND EMERGENCY UNIT SIGN. DARK QUADRANTS INDICATE FACES ILLUMINATED. DIRECTIONAL ARROWS INDICATED.

WIRING DEVICES

SWITCHES:

UNLESS OTHERWISE NOTED, ALL SWITCHES ARE WALL MOUNTED.

TOGGLE SWITCH, SINGLE POLE, 20 AMP

GANGED SWITCHES IN COMMON BOX WITH COMMON WALL PLATE

SUPERSCRIPIT INDICATES CIRCUIT CONTROLLED: a, b, c, ETC. MAY BE COMBINED WITH CIRCUIT NUMBER. EXAMPLE: 1a, 4b, ETC.

SUBSCRIPT MODIFIER INDICATES:

2 = DOUBLE POLE
3 = THREE WAY
4 = FOUR WAY
D = DIMMER
K = KEY OPERATED
MC = MOMENTARY CONTACT, THREE POSITION
MS = MANUAL (MOTOR) STARTER OR SWITCH
R = RHEOSTAT (DIMMER, SPEED CONTROL)

RECEPTACLES:

UNLESS OTHERWISE NOTED, ALL RECEPTACLES ARE 120 VOLT, SINGLE PHASE, STRAIGHT BLADE, NON-LOCKING, GROUNDING STYLE.

DUPLEX RECEPTACLE, 20 AMP, 3 WIRE

RECEPTACLE MODIFIERS:

C = CLOCK HANGER
WP = WEATHER PROOF
GFCI = GROUND FAULT CIRCUIT INTERRUPTER
H = HAZARDOUS AREA-EXPLOSION PROOF

EXPLOSION PROOF, CLASS 1, 20A DEAD FRONT, 45° ANGLE, TWO GANG

RECESSED FLOOR RECEPTACLE-- ANY RECEPTACLE INSIDE A SQUARE.

SURFACE FLOOR RECEPTACLE-- ANY RECEPTACLE INSIDE A TRIANGLE.

DOUBLE DUPLEX RECEPTACLES--IN COMMON BOX, WITH COMMON WALL PLATE.

SPECIAL RECEPTACLE-- X = NEMA DESIGNATOR, EXAMPLE: L22-20R

TELEPHONE & COMMUNICATION SYSTEMS

UNLESS OTHERWISE NOTED, TELEPHONE OUTLETS SHALL BE MOUNTED AT SAME HEIGHT AS THE RECEPTACLES. VERIFY.

(OPTIONAL SUPERSCRIPIT)

EXTERNAL LINE OR PLANT PHONE SYSTEM OUTLET

MODIFIERS:

A = ATTENDANT'S CONSOLE
F = FUTURE INSTRUMENT
J = JACK, PLUG-IN TYPE
W = WALL INSTRUMENT

BELL

TV CAMERA

SPEAKER

DATA

MOTORS AND EQUIPMENT

MOTOR STARTER, INDIVIDUAL. NOT LOCATED IN AN MCC OR SIMILAR GROUP ASSEMBLY

COMBINATION MOTOR STARTER. NOT LOCATED IN AN MCC OR SIMILAR GROUP ASSEMBLY

DISCONNECT SWITCH, NON-FUSED

DISCONNECT SWITCH, FUSED

MOTOR

HEATER

THERMOSTAT

WATER HEATER

FIELD INSTRUMENT

CONTROL STATION. SEE CONTROL DIAGRAMS FOR DEVICES REQUIRED

EQUIPMENT OR INSTRUMENTATION DESIGNATION (EXAMPLE)

CABLE IDENTIFICATION SYSTEM

1. LABEL CABLES WITH "ORIGIN/DESTINATION" AS PREFIX AND CABLE TYPE AS SUFFIX (e.g. MCC1000/HS1010-C). SEE EXPLANATION BELOW:

MCC1000 / HS 1 010 A1 - C

ORIGIN / DESTINATION

CABLE TYPE - (1 CHARACTER)

P POWER
C CONTROL
S SIGNAL (FOUNDATION FIELDBUS AND 4-20mA ANALOG I/O)
D DATA (INCLUDES ALL NON-FIBER OPTIC NETWORKS)
F OPTICAL FIBER

SYMBOL GENERAL NOTES:

- NEW WORK SHOWN IN BOLD LINE WEIGHT. EXISTING CONDITIONS SHOWN IN LIGHT LINE WEIGHT.
- THIS DRAWING IS GENERAL IN NATURE. SOME SYMBOLS SHOWN HEREON MAY NOT BE USED ON THE CONTRACT DRAWINGS.
- SYMBOLS ARE ARRANGED ON SPECIFIC DRAWINGS AND IN CATEGORIES FOR CONVENIENCE ONLY; SYMBOLS MAY BE USED ON ANY OF THE CONTRACT DRAWINGS.
- IDENTIFICATIONS (ID), SIZES, RATINGS, LOCATIONS AND SIMILAR INFORMATION SHOWN ASSOCIATED WITH SYMBOLS ARE OPTIONAL; EXAMPLES OF SUCH INFORMATION ARE SHOWN WITH SOME SYMBOLS FOR CLARITY.
- CABLE IDENTIFICATION SYSTEM IS NOT FINALIZED IN THIS REVISION.

GENERAL NOTES

- ALL ELECTRICAL EQUIPMENT AND MATERIALS SHALL BE APPROVED FOR USE BY THE CITY OF BEND PRIOR TO INSTALLATION. EQUIPMENT DATA SHALL BE SUBMITTED AS DIRECTED BY THE CITY.
- ALL ELECTRICAL WORK SHALL COMPLY WITH THE APPLICABLE PORTIONS OF THE OREGON ELECTRICAL SPECIALTY CODE (OESC), THE NATIONAL ELECTRIC CODE (NEC), AND LOCAL CODES IN FORCE AT THE TIME OF CONSTRUCTION.
- ALL ELECTRICAL EQUIPMENT AND MATERIALS SHALL BE APPROVED BY UNDERWRITERS LABORATORIES INC. (UL) FOR THE PURPOSE FOR WHICH THEY ARE USED, AND ALL SHALL BEAR A UL LABEL.
- ALL ELECTRICAL EQUIPMENT AND RACEWAY SHALL BE SUPPORTED / ANCHORED / BRACED TO MEET ALL IMPOSED GRAVITY, WIND, AND/OR SEISMIC FORCES, IN ACCORDANCE WITH THE REQUIREMENTS OF THE OREGON STRUCTURAL SPECIALTY CODE AND THE INTERNATIONAL BUILDING CODE. WHERE THE DESIGN OF THESE SUPPORT SYSTEMS ARE NOT PROVIDED AS PART OF THESE CONTRACT DOCUMENTS, THE CONTRACTOR SHALL BE RESPONSIBLE FOR THIS DESIGN AND SHALL PROVIDE MANUFACTURERS DATA OR CALCULATIONS PREPARED BY A STRUCTURAL ENGINEER REGISTERED IN THE STATE OF OREGON VERIFYING COMPLIANCE WITH THESE REQUIREMENTS.
- ALL EQUIPMENT LOCATIONS AND DIMENSIONS SHALL BE FIELD-VERIFIED AND FINAL LOCATIONS SHALL BE APPROVED BY THE CITY OF BEND PRIOR TO INSTALLATION.
- CONDUITS SHALL BE INSTALLED WITH A MINIMUM NUMBER OF BENDS, LIMITED TO MEET NEC REQUIREMENTS. CONTRACTOR TO PROVIDE FITTINGS AND BOXES AS REQUIRED TO LIMIT THE NUMBER OF BENDS.
- CONDUIT RUNS ON DRAWINGS ARE PRESENTED DIAGRAMMATICALLY AND ARE NOT INTENDED TO DEPICT ACTUAL ROUTING. CONTRACTOR TO ROUTE CONDUITS PARALLEL AND PERPENDICULAR TO EQUIPMENT AND STRUCTURES. GROUP MULTIPLE CONDUIT RUNS AND NEATLY RACK AND SUPPORT. COORDINATE RACEWAY LAYOUT WITH MECHANICAL, PIPING, AND STRUCTURAL SYSTEMS. ROUTE SURFACE CONDUITS VERTICALLY, WHERE POSSIBLE, TO ALLOW FOR FUTURE WALL-MOUNTED INSTALLATIONS ON UNUSED SPACE.
- PROVIDE CLEARLY VISIBLE ARC FLASH LABELING ON NEW ELECTRICAL EQUIPMENT TO COMPLY WITH NEC ARTICLE 110.16, "ELECTRICAL EQUIPMENT, SUCH AS SWITCHBOARDS, PANELBOARDS, INDUSTRIAL CONTROL PANELS, METER SOCKET ENCLOSURES, AND MOTOR CONTROL CENTERS, THAT ARE IN OTHER THAN DWELLING UNITS, AND ARE LIKELY TO REQUIRE EXAMINATION, ADJUSTMENT, SERVICING, OR MAINTENANCE WHILE ENERGIZED SHALL BE FIELD MARKED TO WARN QUALIFIED PERSONS OF POTENTIAL ARC FLASH HAZARDS."
- ALL CONDUCTORS #6 AND SMALLER SHALL HAVE COLORED INSULATION JACKETS MEETING THE FOLLOWING COLOR CODING. CONDUCTORS #4 AND LARGER SHALL HAVE THE SAME COLOR CODING OR COLORED TAPE AT EACH END TO MATCH THE FOLLOWING COLOR CODES:

AØ (LEFT BUS IN PANEL)	208Y/120V BLACK	480Y/277V BROWN
BØ (CENTER BUS IN PANEL)	RED	ORANGE
CØ (RIGHT BUS IN PANEL)	BLUE	YELLOW
NEUTRAL	WHITE	GRAY
GROUND	GREEN	GREEN

- CONTRACTOR SHALL BE RESPONSIBLE FOR ROUTING, PROVIDING, AND INSTALLING ALL CONDUITS AND CONDUCTORS REQUIRED TO RESULT IN FULLY FUNCTIONING EQUIPMENT, WHETHER OR NOT SUCH CONDUIT IS SHOWN ON THESE DRAWINGS.
- CONTRACTOR SHALL BE RESPONSIBLE FOR PROVIDING PROPERLY SIZED STARTER OVERLOADS FOR ALL STARTER EQUIPMENT FURNISHED.

FOR SAMPLE ONLY

RECORD DRAWINGS

REVISIONS DRAWN BY: XX DATE: XX/XX/XX

THESE RECORD DRAWINGS HAVE BEEN PREPARED, IN PART, ON THE BASIS OF INFORMATION COMPILED BY OTHERS. THEY ARE NOT INTENDED TO REPRESENT IN DETAIL THE EXACT LOCATION, TYPE OF COMPONENT NOR MANNER OF CONSTRUCTION. THE ENGINEER WILL NOT BE RESPONSIBLE FOR ANY ERRORS OR OMISSIONS WHICH HAVE BEEN INCORPORATED INTO THE RECORD DRAWINGS.

FOR SEALS AND SIGNATURES

(PROJECT NAME)

GENERAL

ELECTRICAL NOTES AND STANDARD SYMBOLS

DESCHUTES COUNTY, OREGON

REVISIONS:

(CONSULTANT ENGINEER NAME, ADDRESS & PHONE NUMBER)

DESIGNED BY: _____

DRAWN BY: _____

SCALE: _____

FILE: _____

DATE: _____

VERIFY SCALES

0 1"

BAR EQUALS ONE INCH ON ORIGINAL DRAWING

SHEET: **G-005**

COB # (XXXXXX)

1		2		3		4		5		6	
CONTROL DIAGRAM SYMBOLS											
GENERAL		PUSHBUTTONS		CONTROL RELAYS		INDICATING LIGHTS		ONE LINE DIAGRAM SYMBOLS			
<p>ENCLOSURE BOUNDARY, EXISTING ENCLOSURE BOUNDARY, NEW CONDUCTORS CONNECTED CONDUCTORS NOT CONNECTED TERMINAL POINT FOR EXTERNAL CONNECTIONS EXISTING EQUIPMENT</p>		<p>PUSH BUTTON, MOMENTARY CONTACT, NORMALLY OPEN PUSH BUTTON, MOMENTARY CONTACT, NORMALLY CLOSED PUSH BUTTON WITH MUSHROOM HEAD, EMERGENCY STOP, MOMENTARY CONTACT</p>		<p>OPERATING COIL FUNCTION CR = CONTROL RELAY U = UNLATCH L = LATCH THERMAL OVERLOAD RELAY OUTPUT CONTACTS. LINE NUMBER OF RELAY COIL SHOWN (OPTIONAL)</p>		<p>INDICATING LIGHTS L = LENS COLOR: A = AMBER B = BLUE G = GREEN R = RED W = WHITE PUSH TO TEST. TEST VOLTAGE TERMINAL SHOWN</p>		<p>POTHEAD STRESS CONE INCOMING LINE INDICATES THAT ALL OR PART OF CONDUIT MAY BE ROUTED IN DUCT BANK OR UNDERGROUND. SIGNAL PORTABLE CABLE BUS CONDUCTOR CABLE CONDUCTOR SURGE PROTECTOR LIGHTNING ARRESTOR AND GROUND TEST DEVICE METERING SWITCH METERS: 0-1000 AMPS A = AMPERES F = FREQUENCY KW = KILOWATTS, DEMAND PF = POWER FACTOR V = VOLTS VA = VOLT-AMPERES VAR = VOLTAMPERES REACTIVE WH = WATTHOURS METER SWITCH AS = AMMETER SWITCH VS = VOLTMETER SWITCH RECEPTACLE/PLUG CONNECTION/BUS CONNECTION MOTOR, HORSEPOWER SHOWN HEATER, 5KW SIZE SHOWN DISCONNECT OR ISOLATING SWITCH. 200 AMP SHOWN</p>			
DISCONNECTS AND OVERCURRENT DEVICES		INPUT SWITCHES		TIMING RELAYS		TRANSFORMERS		<p>CONTROL TRANSFORMER. PRIMARY AND SECONDARY VOLTAGES SHOWN. SIZE AS SHOWN OR SPECIFIED. CURRENT TRANSFORMER. PRIMARY/SECONDARY TURNS RATIO SHOWN. INDICATED POLARITY</p>			
<p>MOTOR CIRCUIT PROTECTOR</p> <p>CIRCUIT BREAKER, THERMAL- MAGNETIC, 3 POLE, UON.</p> <p>MODIFIERS: /M MAGNETIC ONLY /2P POLES, IF OTHER THAN 3</p> <p>FUSE SIZE</p> <p>FUSE</p> <p>MODIFIERS: CLF = CURRENT LIMITING FUSE DE = DUAL ELEMENT F = CLASS F</p> <p>NEON BLOWN FUSE INDICATOR</p>		<p>LIQUID LEVEL ACTIVATED SWITCH OPENS ON RISING LEVEL CLOSES ON RISING LEVEL PRESSURE OR VACUUM ACTIVATED SWITCH OPENS ON RISING PRESSURE CLOSES ON RISING PRESSURE TEMPERATURE ACTIVATED SWITCH OPENS ON RISING TEMPERATURE CLOSES ON RISING TEMPERATURE FLOW ACTIVATED SWITCH OPENS ON INCREASE IN FLOW CLOSES ON INCREASE IN FLOW LIMIT SWITCH DIRECTLY ACTIVATED, SPRING RETURN NORMALLY OPEN NORMALLY OPEN - HELD CLOSED NORMALLY CLOSED NORMALLY CLOSED - HELD OPEN FOOT OPERATED SWITCH OPENS BY FOOT PRESSURE CLOSES BY FOOT PRESSURE TIME DELAY SWITCH NORMALLY OPEN CONTACT CLOSES AFTER TIME DELAY WHEN COIL IS ENERGIZED, OPENS INSTANTANEOUSLY WHEN DE-ENERGIZED NORMALLY CLOSED CONTACT OPENS AFTER TIME DELAY WHEN COIL IS ENERGIZED, CLOSES INSTANTANEOUSLY WHEN DE-ENERGIZED NORMALLY OPEN CONTACT CLOSES INSTANTANEOUSLY WHEN COIL IS ENERGIZED, OPENS AFTER TIME DELAY WHEN DE-ENERGIZED NORMALLY CLOSED CONTACT OPENS INSTANTANEOUSLY WHEN COIL IS ENERGIZED, CLOSES AFTER TIME-DELAY WHEN DE-ENERGIZED</p>		<p>OPERATING COIL ON or OFF DELAY RANGE:SEC/MIN SET:SEC/MIN NORMALLY OPEN NORMALLY CLOSED DELAY ON COIL ENERGIZATION (ON DELAY) DELAY ON COIL DE-ENERGIZATION (OFF DELAY)</p>		<p>HORN RESISTOR RESISTOR, 250 OHMS, ±0.1%, 1/2 WATT PRECISION RECTIFIER SURGE OR ARC SUPPRESSOR TRIAC CAPACITOR CONNECTOR PLUG GROUND CONNECTION POTENTIOMETER BUS DUCT BATTERY SHIELDED CABLE AC TERMINAL BLOCK DC TERMINAL BLOCK</p>		<p>100F FUSE. 100 AMP CLASS "F" SHOWN 100 KVA 13.2 KV POWER TRANSFORMER. VOLTAGES, SIZE, IMPEDANCE SHOWN 5.75% Z 480/277 V 1.5 KVA 120 V ISOLATION TRANSFORMER. VOLTAGES, SIZE, IMPEDANCE SHOWN 2.5% Z 240/120 V 4.16 KV POTENTIAL TRANSFORMER. PT QUANTITY (3), VOLTAGES, WYE-DELTA CONFIGURATION SHOWN 120 V 400:5 CURRENT TRANSFORMER. CT QUANTITY (3) AND 400:5 TURNS RATIO SHOWN. WINDING CONFIGURATIONS: DELTA WYE (GROUNDED) 600KW 60HZ 480V 3Ø, 4W PF 0.8 GENERATOR. POWER RATING, FREQUENCY, VOLTAGE, POWER FACTOR, GROUNDED WYE WINDING SHOWN. 50 AMP/10 SEC NEUTRAL GROUNDING RESISTOR. AMPS/TIME RATING SHOWN KIRK KEY INTERLOCK CIRCUIT BREAKER</p>			
SELECTOR SWITCHES				CONTACTORS				<p>AIR BREAK CONTACTOR VACUUM BREAK CONTACTOR</p>			
<p>2 POSITION MAINTAINED CONTACT CLOSED IN POSITION 1 CLOSED IN POSITION 2 2-POSITION SPRING RETURNED TO RIGHT CLOSED IN POSITION 1 CLOSED IN POSITION 2 3-POSITION MAINTAINED CONTACT CLOSED IN POSITION 1 CLOSED IN POSITION 2 CLOSED IN POSITION 3</p>				<p>OPERATING COILS C = CONTACTOR, LIGHTING OR GENERAL USE F = FAST OR FORWARD M = MAIN OR LINE 1M = FIRST MAIN OR WYE 2M = SECOND MAIN OR DELTA R = RUN OR REVERSE S = SLOW OR START MAIN CONTACTS</p>		<p>MOTOR SPACE HEATER. WATTAGE SHOWN MAGNETIC COIL SOLENOID HOUR METER (ELAPSED TIME) TIME CONTROLLER</p>		<p>SYMBOL GENERAL NOTES:</p> <ol style="list-style-type: none"> THIS DRAWING IS GENERAL IN NATURE. SOME SYMBOLS SHOWN HEREON MAY NOT BE USED ON THE CONTRACT DRAWINGS. SYMBOLS ARE ARRANGED ON SPECIFIC DRAWINGS AND IN CATEGORIES FOR CONVENIENCE ONLY; SYMBOLS MAY BE USED ON ANY OF THE CONTRACT DRAWINGS. IDENTIFICATIONS (ID), SIZES, RATINGS, LOCATIONS AND SIMILAR INFORMATION SHOWN ASSOCIATED WITH SYMBOLS ARE OPTIONAL; EXAMPLES OF SUCH INFORMATION ARE SHOWN WITH SOME SYMBOLS FOR CLARITY. 			
<p>DESIGNED BY: _____ DRAWN BY: _____ SCALE: _____ FILE: _____ DATE: _____</p> <p>VERIFY SCALES 0 1" BAR EQUALS ONE INCH ON ORIGINAL DRAWING</p> <p>SHEET: G-006</p> <p>COB # (XXXXXX)</p>											

FOR SEALS AND SIGNATURES

(PROJECT NAME)
GENERAL

ELECTRICAL NOTES AND STANDARD SYMBOLS
DESCHUTES COUNTY, OREGON

REVISIONS:

NO.	DESCRIPTION	DATE	BY

DESIGNED BY: _____ DRAWN BY: _____ SCALE: _____ FILE: _____ DATE: _____

FOR SAMPLE ONLY

RECORD DRAWINGS
REVISIONS DRAWN BY: XX DATE: XX/XX/XX

THESE RECORD DRAWINGS HAVE BEEN PREPARED, IN PART, ON THE BASIS OF INFORMATION COMPILED BY OTHERS. THEY ARE NOT INTENDED TO REPRESENT IN DETAIL THE EXACT LOCATION, TYPE OF COMPONENT NOR MANNER OF CONSTRUCTION. THE ENGINEER WILL NOT BE RESPONSIBLE FOR ANY ERRORS OR OMISSIONS WHICH HAVE BEEN INCORPORATED INTO THE RECORD DRAWINGS.

GENERAL STRUCTURAL NOTES (GSN)

GENERAL


- G1. SCOPE**
THE NOTES ON THIS SHEET AND THE STANDARD STRUCTURAL DETAILS ARE GENERAL AND APPLY TO THE ENTIRE PROJECT WHETHER SPECIFICALLY CALLED OUT OR NOT, EXCEPT WHERE THERE ARE SPECIFIC INDICATIONS TO THE CONTRARY ON STRUCTURAL SHEETS. IF THERE ARE QUESTIONS, THEY SHALL BE SUBMITTED TO THE STRUCTURAL ENGINEER AND ANSWERED IN WRITING PRIOR TO CONSTRUCTION.
- G2. APPLICABLE SPECIFICATIONS AND CODES**
A. INTERNATIONAL BUILDING CODE, IBC 2012 WITH APPLICABLE EDITIONS OF THE CODE REFERENCED STANDARDS.
B. LOCAL JURISDICTION AMENDMENTS
- G3. DESIGN CRITERIA**
1. APPLIES TO ALL STRUCTURES (UNO)
A. DEAD LOAD:
1. ACTUAL TRIBUTARY STRUCTURE WEIGHT
2. SUPERIMPOSED DEAD LOAD: X PSF
B. LIVE LOAD:
1. ROOF: XX PSF (NOT REDUCIBLE)
C. SNOW LOAD:
1. GROUND SNOW LOAD: XX PSF
2. FLAT ROOF SNOW LOAD: XX PSF
3. EXPOSURE FACTOR Ce: X.X
4. IMPORTANCE FACTOR Is: X.X
5. THERMAL FACTOR Ct: X.X
D. SEISMIC:
1. RISK CATEGORY: X
2. IMPORTANCE FACTOR: X
3. SPECTRAL RESPONSE ACCELERATION, Ss: X.XXX
4. SPECTRAL RESPONSE ACCELERATION, Si: X.XXX
5. SITE CLASS: X
6. SEISMIC DESIGN CATEGORY: X
7. SPECTRAL RESPONSE COEFFICIENT, Sms: X.XX
8. SPECTRAL RESPONSE COEFFICIENT, Smi: X.XXX
9. BASIC SEISMIC FORCE RESISTING SYSTEM: STEEL ORDINARY CANTILEVER COLUMN
10. ANALYSIS PROCEDURE: EQUIVALENT LATERAL FORCE
11. RESPONSE MODIFICATION FACTOR R: X.XX
12. SEISMIC RESPONSE COEFFICIENT Cs: X.XXX
13. DESIGN BASE SHEAR V: XX.XXXX
E. WIND:
1. BASIC WIND SPEED: XXX MPH
2. EXPOSURE: C
3. ENCLOSURE: OPEN
- G4. GEOTECHNICAL DATA IS ASSUMED:**
ALLOWABLE [NET] SOIL BEARING: XXXX PSF
- G5. SAFETY**
SAFETY AND STRUCTURE STABILITY DURING CONSTRUCTION ARE THE SOLE RESPONSIBILITY OF THE CONTRACTOR. STRUCTURES HAVE BEEN DESIGNED TO RESIST THE DESIGN LIVE LOADS ONLY AS A COMPLETED STRUCTURE.
- G6. OPENINGS**
OPENINGS FOR PIPES, DUCTS, CONDUITS, ETC. ARE NOT ALL SHOWN ON THE STRUCTURAL DRAWINGS. COORDINATE AND PROVIDE OPENINGS AS REQUIRED TO ACCOMMODATE ALL WORK SHOWN OR SPECIFIED IN THE CONTRACT DOCUMENTS AND OTHERWISE REQUIRED FOR THE FURNISHING OF A FUNCTIONALLY COMPLETE PROJECT. REINFORCE AROUND OPENINGS PER STANDARD STRUCTURAL DETAILS UNLESS OTHERWISE SHOWN.
- G7. SPECIAL INSPECTIONS**
SPECIAL INSPECTIONS ARE REQUIRED IN ACCORDANCE WITH CHAPTER 1 AND CHAPTER 17 OF THE IBC. PAYMENT FOR THESE INSPECTIONS IS NOT THE RESPONSIBILITY OF THE CONTRACTOR. THE CONTRACTOR SHALL PROVIDE FOR FULL ACCESS TO THE WORK BY THE SPECIAL INSPECTOR AND SHALL PROVIDE FOR THESE INSPECTIONS IN HIS CONSTRUCTION SCHEDULE IN ACCORDANCE WITH THE SPECIFICATIONS.
- G8. STANDARD DETAILS:**
THE STANDARD DETAILS DEPICT TYPICAL DETAILING TO BE USED ON THIS PROJECT. IF CONDITIONS ARE NOT EXPLICITLY SHOWN ON THE DRAWINGS THEY SHALL BE MADE SIMILAR TO THE STANDARD DETAILS. OBTAIN APPROVAL OF ENGINEER IN WRITING FOR SIMILAR CONDITIONS PRIOR TO CONSTRUCTION.
- G9. EXISTING CONSTRUCTION:**
THE CONTRACTOR SHALL FIELD VERIFY ALL DIMENSIONS AND ELEVATIONS OF EXISTING CONSTRUCTION AS REQUIRED TO COORDINATE NEW CONSTRUCTION. SUBMIT REQUIRED CHANGES FOR APPROVAL.
- G10. EQUIPMENT LOADING:**
CONTRACTOR TO SUBMIT FOR REVIEW ALL EQUIPMENT SIZES, OPERATING WEIGHTS, VIBRATION FORCES, SUPPORT LOCATIONS, ALONG WITH ANY FLOOR OPENINGS, NOTCHES, AND RECESSES REQUIRED BY SUCH EQUIPMENT. CONCRETE SUPPORT PADS AND/OR FRAMING REQUIRED TO SUPPORT SAID EQUIPMENT SHALL NOT BE FABRICATED AND PLACED UNTIL THE CONCRETE SUPPORT PADS AND/OR FRAMING IS APPROVED TO SUPPORT THE EQUIPMENT.
- CONCRETE**
- C1. DESIGN STRENGTHS:**
F'c = 4500 PSI
Fy = 60,000 PSI
- C2. CONCRETE COVER**
UNLESS OTHERWISE NOTED, PROVIDE CONCRETE COVER FOR REINFORCING AS FOLLOWS:
CONCRETE DEPOSITED AGAINST EARTH: 3"
ALL OTHER: 2"
SEE DRAWINGS FOR EXCEPTIONS
- C3. SEE SPECIFICATIONS FOR REINFORCING PLACEMENT REQUIREMENTS.**
- C4. REFER TO OTHER DISCIPLINE DRAWINGS PRIOR TO CONSTRUCTION FOR EMBEDDED ITEMS AND PENETRATIONS NOT SHOWN ON STRUCTURAL DRAWINGS. AS REQUIRED TO ACCOMMODATE ALL WORK SHOWN OR SPECIFIED IN THE CONTRACT DOCUMENTS AND OTHERWISE REQUIRED FOR THE FURNISHING OF A FUNCTIONALLY COMPLETE PROJECT, REINFORCE AROUND OPENINGS PER STANDARD STRUCTURAL DETAILS UNLESS OTHERWISE SHOWN.**

CONCRETE (continued)

- C5. PROVIDE 3/4" CHAMFERS AT ALL EXPOSED EDGES NOT ALL CHAMFERS MAY BE SHOWN ON DRAWINGS.**
- C6. FIELD ADJUST REINFORCING AT OPENINGS AND EMBEDDED ITEMS AS INDICATED.**
- C7. ANCHOR BOLTS NOT SPECIFIED BY ENGINEER SHALL BE DESIGNED AND CERTIFIED BY A REGISTERED PROFESSIONAL ENGINEER, RETAINED BY THE CONTRACTOR, IN ACCORDANCE WITH APPLICABLE PROJECT AND CODE REQUIREMENTS. SUBMIT AS A SHOP DRAWING FOR REVIEW AND APPROVAL BY THE ENGINEER. COORDINATE LOCATION, SIZE AND EMBEDMENT PRIOR TO CASTING CONCRETE.**
- C8. ABSOLUTELY NO WELDING OF REINFORCING BARS OR TORCHING TO BEND REINFORCING BARS SHALL BE ALLOWED WITHOUT SPECIFIC APPROVAL FROM THE STRUCTURAL ENGINEER.**
- C9. ALL CAST IN PLACE AND POST-INSTALLED ANCHORS INDICATED IN THE STRUCTURAL DOCUMENTS SHALL COMPLY WITH APPENDIX D OF ACI 318 AND CHAPTER 19 OF THE IBC. ALL EXPANSION AND ADHESIVE ANCHORS SHALL HAVE THE ICC REPORT SHOWING EQUIVALENT LOAD CAPACITY. SUBMIT AND INSTALL PER THE ICC EVALUATION REPORT.**

STEEL

- S1. DESIGN STRENGTHS:**
HSS SECTIONS: Fy=46 KSI
ALL OTHER PLATES AND SHAPES: Fy=36 KSI
- S2. DIMENSIONS:**
TO CENTERLINES OF COLUMNS AND BEAMS, TOP SURFACES OF BEAMS AND TUBES AND BACKS OF CHANNELS AND ANGLES UNO.
- S3. ELEVATIONS:**
TOP OF STEEL REFERS TO TOP SURFACE OF MEMBER OR FLANGE UNO.
- S4. FILLET WELDS:**
WHEN FILLET WELD SIZE IS NOT INDICATED, PROVIDE MAXIMUM WELD SIZE BASED ON MATERIAL THICKNESS IN ACCORDANCE WITH AISC SPECIFICATIONS.
- S5. BOLTED CONNECTIONS:**
ALL BOLTED STRUCTURAL CONNECTIONS ARE BEARING TYPE CONNECTIONS UNLESS OTHERWISE SPECIFIED TO BE SLIP-CRITICAL. PROVIDE LOAD INDICATING WASHERS AT SLIP-CRITICAL CONNECTIONS.
- S6. STEEL MANUAL:**
CONFORM TO AISC 360, STEEL CONSTRUCTION MANUAL AND AISC 341, SEISMIC DESIGN MANUAL.
- STEEL DECK:**
- SD1. THE DESIGN, FABRICATION, AND ERECTION OF METAL DECKING SHALL BE IN ACCORDANCE WITH THE CURRENT EDITION OF THE SDI SPECIFICATIONS AND THE SDI DIAPHRAGM MANUAL.**
- SD2. STEEL ROOF DECK IS 1-1/2 INCH X 18 GAUGE DESIGNED FOR THE DEAD, SNOW AND LIVE LOADS INDICATED.**
- SD3. STEEL ROOF DECK IS TO BE A STRUCTURAL DIAPHRAGM AND SHALL BE CONNECTED TO THE STRUCTURE AS INDICATED IN THE METAL DECK SCHEDULE.**
- SD4. THE PLANS INDICATE DECK SPAN DIRECTION.**
- SD5. SUSPENDED CEILINGS, LIGHT FIXTURES, DUCTS, AND OTHER UTILITIES SHALL NOT BE SUPPORTED FROM THE STEEL DECK.**
- FINISHES:**
F1. _____ COLOR OF ROOF.
F2. _____ COLOR OF SUPPORT STEEL.

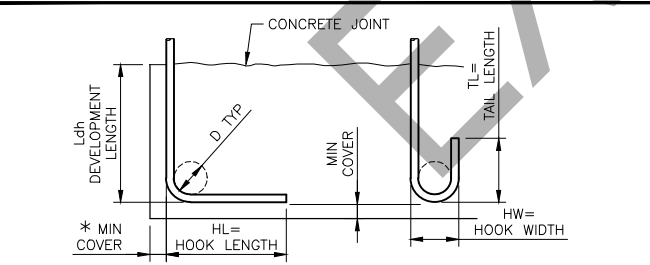


90 DEG STD HOOK 180 DEG STD HOOK

BAR SIZE	GRADE	HL	HW	TL	D	f'c=4.0 OR 4.5 KSI	
						Ldh	*
#3	60	6"	3"	3"	2 1/4"	6"	
#4	60	8"	4"	4 1/2"	3"	7"	
#5	60	10"	5"	5"	3 3/4"	9"	
#6	60	1'-0"	6"	6"	4 1/2"	10"	
#7	60	1'-2"	7"	7"	5 1/4"	12"	
#8	60	1'-4"	8"	8"	6"	14"	
#9	60	1'-7"	11 3/4"	10 1/2"	9 1/2"	15"	
#10	60	1'-10"	1'-1 1/4"	11 1/2"	10 3/4"	17"	
#11	60	2'-0"	1'-2 3/4"	1'-1"	12"	19"	

* COMPLYING WITH MINIMUM COVER REQUIREMENTS OF ACI 318, 12.5.3. OTHERWISE Ldh MUST BE RE-CALCULATED.

1 REINFORCING HOOK SCHEDULE
1"=1'-0"

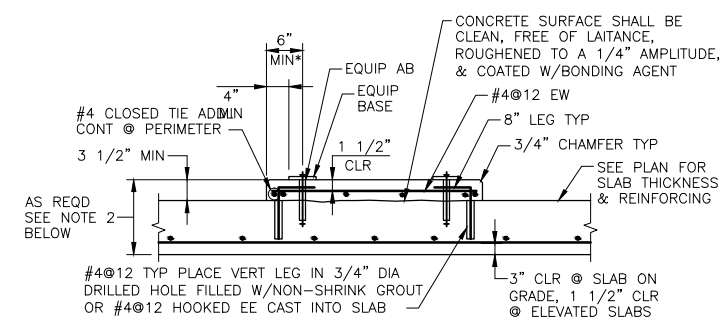

NOTES:

1. PROVIDE ABOVE PAD UNDER ALL STATIC, NON-VIBRATING ELECTRICAL AND MECHANICAL EQUIPMENT SUPPORTED ON STRUCTURAL SLABS. ALSO PROVIDE FOR EQUIPMENT WEIGHING LESS THAN 5000 POUNDS WHICH ARE SUPPORTED ON GRADE OR WHERE SPECIFICALLY NOTED ON PLANS. STRUCTURAL ENGINEER TO REVIEW AND PROVIDE PROJECT SPECIFIC DESIGN FOR ALL EQUIPMENT PADS.
2. PAD THICKNESS SHALL BE THE LARGER OF SLAB THICKNESS PLUS 3 1/2" OR MINIMUM PAD THICKNESS FROM TABLE. PROVIDE AN ADDITIONAL LAYER OF #4@12 EACH WAY WITH 1 1/2" CLEAR TOP AND BOTTOM FOR EACH 8" ADDITIONAL PAD THICKNESS EXCEEDING THE 3 1/2" MINIMUM THICKNESS. ALTERNATIVELY, THICKEN SLAB ON GRADE BELOW EQUIPMENT PAD AS REQD TO MAINTAIN MIN 3" COVER ON ANCHOR BOLTS.

AB DIA	MIN PAD THK
1/4" DIA	6"
3/8" DIA	6 1/2"
1/2" DIA	8"
5/8" DIA	9 1/2"
3/4" DIA	11"
7/8" DIA	12 1/2"
1" DIA	14"

PAD NOTES:

1. ABOVE PAD DETAILS APPLY FOR SUPPORT OF STATIC, NON-VIBRATING EQUIPMENT UNLESS INDICATED OTHERWISE ON THE DRAWINGS. STRUCTURAL ENGINEER TO REVIEW AND PROVIDE PROJECT SPECIFIC DESIGN FOR EQUIPMENT PADS.
2. BEFORE EQUIPMENT SUPPORT PADS ARE CAST, THE PAD SIZES AND REINFORCING SHALL BE APPROVED BY THE ENGINEER AS BEING CAPABLE OF SUPPORTING EQUIPMENT TO BE PLACED THEREON. EQUIPMENT BASE DIMENSIONS SHALL BE THE LARGER OF AS DETERMINED BY THE EQUIPMENT MANUFACTURER OR AS INDICATED ON THE DRAWINGS. SUBMIT ALL EQUIPMENT DIMENSIONS AND LOADS TO ENGINEER. THE SIZE, NUMBER, TYPE, LOCATION AND THREAD PROJECTION OF THE ANCHOR BOLTS (AB) SHALL BE AS DETERMINED BY THE EQUIPMENT MANUFACTURER AND SHALL BE AS APPROVED BY THE ENGINEER. AB SHALL BE HELD IN POSITION WITH A TEMPLATE WHILE EQUIPMENT PAD IS CAST.
- *3. 6" MINIMUM PAD EDGE DIMENSION TO EQUIPMENT AB APPLIES FOR ALL EQUIPMENT SUPPORT PADS.



2 TYPICAL EQUIPMENT SUPPORT PAD
N.T.S.

BAR	f'c = 4.0 ksi fy = 60 ksi	
	BARS SPACED GREATER THAN 4"	BARS SPACED LESS THAN OR EQUAL TO 4"
#3	14"	20"
#4	19"	32"
#5	29"	46"
#6	39"	62"
#7	55"	87"
#8	69"	107"
#9	76"	116"
#10	97"	140"
#11	120"	146"


NOTES:

1. PROVIDE MINIMUM LAP SPLICE LENGTHS AND EMBEDMENTS PER TABLE UNLESS NOTED OTHERWISE. EMBEDMENT LENGTH EQUALS THE LAP SPLICE LENGTH UNLESS OTHERWISE NOTED.
2. BAR SPACING AT LAP SPLICE IS THE MINIMUM CLEAR DISTANCE BETWEEN LAPPED BARS PLUS ONE BAR DIAMETER.
3. ALL SPLICES TO BE CONTACT SPLICES AND WIRED TOGETHER UNLESS OTHERWISE APPROVED BY ENGINEER.

3 CONCRETE REINFORCING LAP AND EMBEDMENT SCHEDULE
N.T.S.

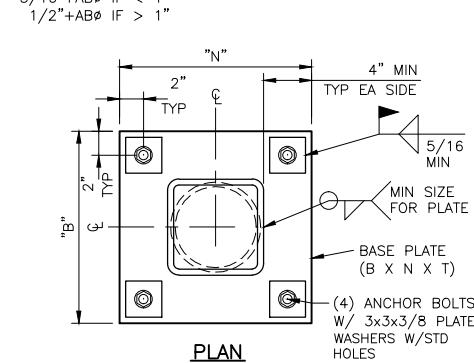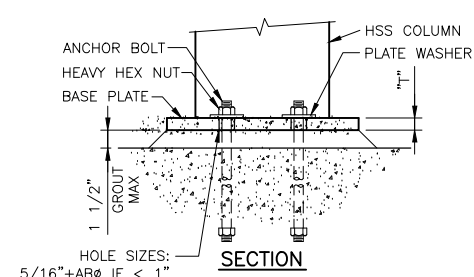

4 COLUMN BASE PLATE
N.T.S.

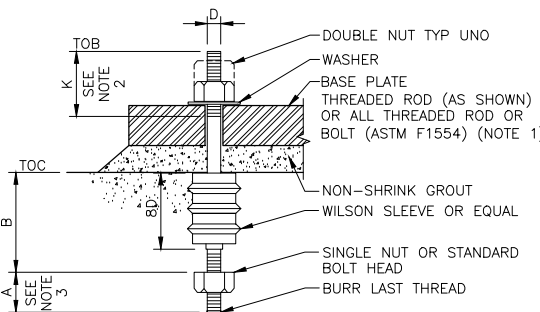

D	A	B	K	REMARKS
3/8"	1"	6"	2 3/4"	
1/2"	1 1/4"	8"	3"	
5/8"	1 1/2"	10"	3 1/4"	
3/4"	1 3/4"	12"	3 1/2"	
7/8"	2"	14"	3 3/4"	
1"	2 1/4"	16"	4"	
1 1/8"	2 1/2"	18"	4 1/4"	
1 1/4"	2 3/4"	20"	4 1/2"	
1 3/8"	3"	22"	4 3/4"	
1 1/2"	3 1/4"	24"	5"	
1 3/4"	3 3/4"	28"	5 1/2"	
2"	4 1/4"	32"	6"	
2 1/2"	5 1/2"	48"	7"	
3"	6 1/4"	66"	8"	

NOTES:

1. PROVIDE SST ANCHOR BOLTS WHERE INDICATED IN SECTIONS AND DETAILS.
2. STANDARD BOLT THREAD LENGTH MAY BE USED WHERE APPLICABLE.
3. DIMENSION IN SCHEDULE OR STANDARD BOLT HEAD.

5 ANCHOR BOLT DETAIL
N.T.S.

FOR SAMPLE ONLY
RECORD DRAWINGS
REVISIONS DRAWN BY: XX DATE: XX/XX/XX
THESE RECORD DRAWINGS HAVE BEEN PREPARED, IN PART, ON THE BASIS OF INFORMATION COMPILED BY OTHERS. THEY ARE NOT INTENDED TO REPRESENT IN DETAIL THE EXACT LOCATION, TYPE OF COMPONENT NOR MANNER OF CONSTRUCTION. THE ENGINEER WILL NOT BE RESPONSIBLE FOR ANY ERRORS OR OMISSIONS WHICH HAVE BEEN INCORPORATED INTO THE RECORD DRAWINGS.

FOR SEALS AND SIGNATURES

(PROJECT NAME)
GENERAL
GENERAL STRUCTURAL NOTES
DESCHUTES COUNTY, OREGON



REVISIONS:

(CONSULTANT ENGINEER NAME, ADDRESS & PHONE NUMBER)

DESIGNED BY: _____
DRAWN BY: _____
SCALE: _____
FILE: _____
DATE: _____



VERIFY SCALES
0 1"
BAR EQUALS ONE INCH ON ORIGINAL DRAWING

SHEET: **G-007**


COB# (XXXXXX)

WASTEWATER PUMP STATION AND FORCE MAIN DESIGN DATA SUMMARY TABLE 1

BASIN CHARACTERISTICS	
LOCATION	ADDRESS AND CROSS STREET
BASIN AREA	XXX ACRES
EQUIVALENT DWELLING UNITS (EDU) PER ACRE	X.X
PERSON PER EDU	X.X
POPULATION EQUIVALENT	XXXX
AVERAGE PER CAPITA FLOW	XX GPD
INFILTRATION AND INFLOW, PEAK WET WEATHER FLOW (PWPF)	XXX,XXX GPD
AVERAGE DAILY FLOW	XXX,XXX GPD
PEAK HOURLY FLOW	XXX GPM
PUMP STATION	
TYPE	DUPLEX SUBMERSIBLE, NON-CLOG, VARIABLE SPEED PUMPS
CAPACITY (PER PUMP)	XXX GPM @ XX FEET TDH (STATIC HEAD = XX FT)
HORSEPOWER, HP	XX HP EACH WITH VARIABLE FREQUENCY DRIVES
MOTOR DATA	Xxx VOLT X PHASE XX CYCLE
FIRM CAPACITY OF PUMP STATION	X.XX MGD (XXX GPM)
MAXIMUM PUMP STARTS PER HOUR	X - SEE NOTE 4
WET WELL VOLUME	XXXX GALLONS (PUMPS OFF TO LEAD PUMP)
LEVEL CONTROL TYPE	PRESSURE SENSORS LEVEL CONTROL
OVERFLOW POINT	MANHOLE NUMBER AND ELEVATION
OVERFLOW LOCATION	DESCRIPTION
AVERAGE TIME TO OVERFLOW	TIME AND DESCRIPTION, XX HOURS AT XX GPM DESIGN AVERAGE INFILTRANT FLOW - SEE NOTE 1
TELEMETRY	BY CITY
TRANSFER SWITCH	AUTOMATIC
STANDBY POWER TYPE	XXX KW STATIONARY DIESEL POWERED STANDBY GENERATOR
FUEL TANK CAPACITY	XX HRS/DAYS (XXX GALLONS)
EPA RELIABILITY CLASS	1
FLOW METER	"X" MAGNETIC (DESCRIPTION)
CONTROL	CONSTANT SPEED OR VFD - PER CITY APPROVAL
FORCE MAIN	
TYPE AND LENGTH	XXXX FEET, TYPE
FORCEMAIN VELOCITY	X.X FEET PER SECOND
PROFILE	DESCRIPTION
AIR RELEASE VALVE	QUANTITY, DESCRIPTION
DISCHARGE LOCATION	MANHOLE NUMBER AND ELEVATION
AVERAGE DETENTION TIME	XX HOURS
ODOR CONTROL SYSTEM	DESCRIPTION
OPERATING LEVELS	
GROUND ELEVATION	XXXX.XX
OVERFLOW ALARM ELEVATION	FLOAT CONTROL SYSTEM? (BACKUP)
LAG PUMP ON/HIGH WATER ALARM ELEVATION XXXX.XX	PRESSURE PROBE (PROVIDE DISTANCE FROM WET WELL FLOOR IN FEET) SAME AS LEVEL INDICATOR DIGITAL DISPLAY
LEAD PUMP ON ELEVATION XXXX.XX	PRESSURE PROBE (PROVIDE DISTANCE FROM WET WELL FLOOR IN FEET) SAME AS LEVEL INDICATOR DIGITAL DISPLAY
ALL PUMPS OFF ELEVATION XXXX.XX	PRESSURE PROBE (PROVIDE DISTANCE FROM WET WELL FLOOR IN FEET) SAME AS LEVEL INDICATOR DIGITAL DISPLAY
WETWELL FLOOR ELEVATION XXXX.XX	PRESSURE PROBE (0.00 FEET)
LANDSCAPING	
LANDSCAPING AREA	SQUARE FEET AND DESCRIPTION
IRRIGATION SYSTEM	TYPE
CONTROL VALVES	NUMBER AND TYPE
BACKFLOW DEVICE	SIZE AND TYPE

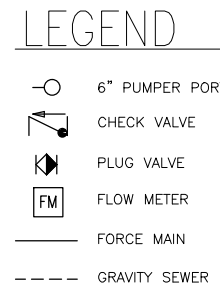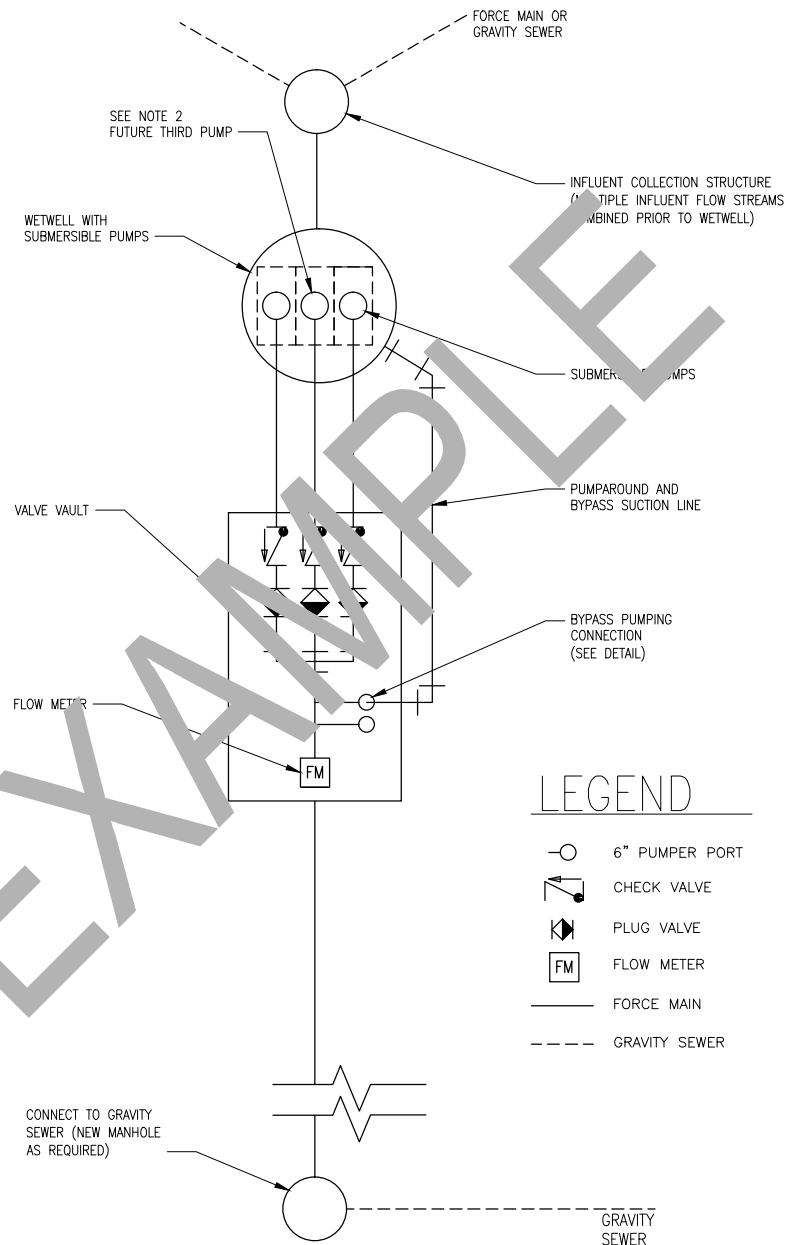

PUMP STATION SCHEMATIC

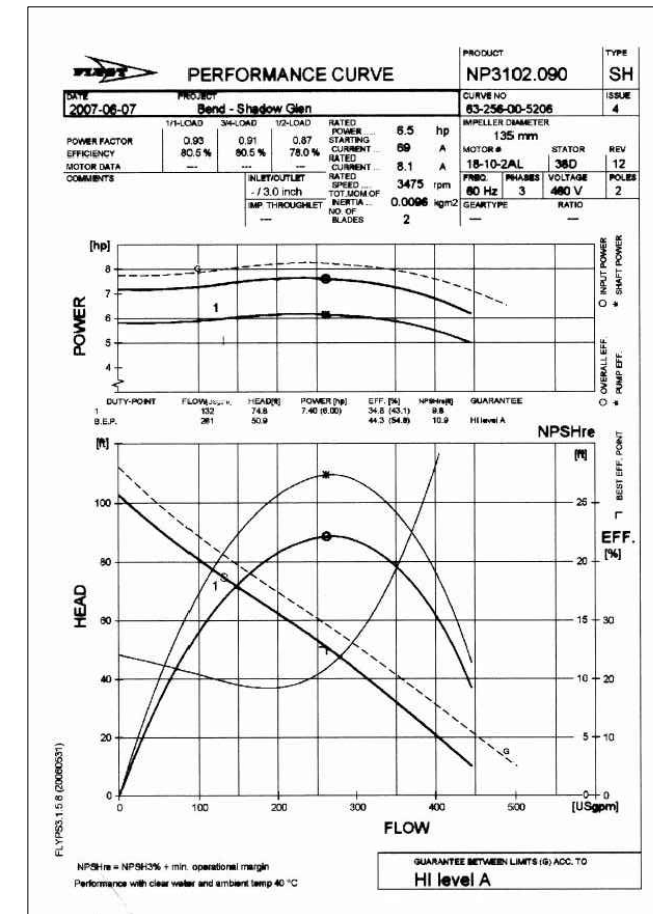

EXAMPLE PUMP PERFORMANCE CURVE

PUMP STATION SCHEMATIC

- DESIGN ENGINEER TO FILL IN DESIGN INFORMATION IN THE TABLE FOR APPROVAL BY CITY OF BEND. PUMP STATION WETWELL SHALL CONFORM TO ANSI/HYDRAULIC INSTITUTE STANDARD 9.8.
- RESERVED FOR FUTURE THIRD PUMP IN PUMP STATION.
- PUMP SELECTION DESIGN POINT SHALL CONFORM TO HYDRAULIC INSTITUTE STANDARDS 9.6.3
- PUMP STATION WETWELL STORAGE VOLUME PER HYDRAULIC INSTITUTE STANDARD 9.8 BASED ON THE MAXIMUM PUMP CYCLE TIME, LESS THAN EIGHT (8) STARTS PER HOUR.

FOR SAMPLE ONLY

RECORD DRAWINGS

REVISIONS DRAWN BY: XX DATE: XX/XX/XX

THESE RECORD DRAWINGS HAVE BEEN PREPARED, IN PART, ON THE BASIS OF INFORMATION COMPILED BY OTHERS. THEY ARE NOT INTENDED TO REPRESENT IN DETAIL THE EXACT LOCATION, TYPE OF COMPONENT NOR MANNER OF CONSTRUCTION. THE ENGINEER WILL NOT BE RESPONSIBLE FOR ANY ERRORS OR OMISSIONS WHICH HAVE BEEN INCORPORATED INTO THE RECORD DRAWINGS.

FOR SEALS AND SIGNATURES

(PROJECT NAME)
GENERAL
BASIS OF DESIGN
DESCHUTES COUNTY, OREGON





REVISIONS:

(CONSULTANT ENGINEER NAME, ADDRESS & PHONE NUMBER)

DESIGNED BY:
DRAWN BY:
SCALE:
FILE:
DATE:

VERIFY SCALES
0 1" BAR EQUALS ONE INCH ON ORIGINAL DRAWING

SHEET: **G-008**
COB # (XXXXXX)

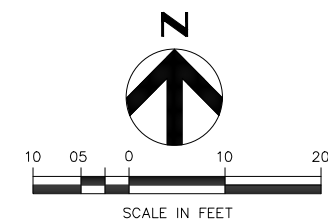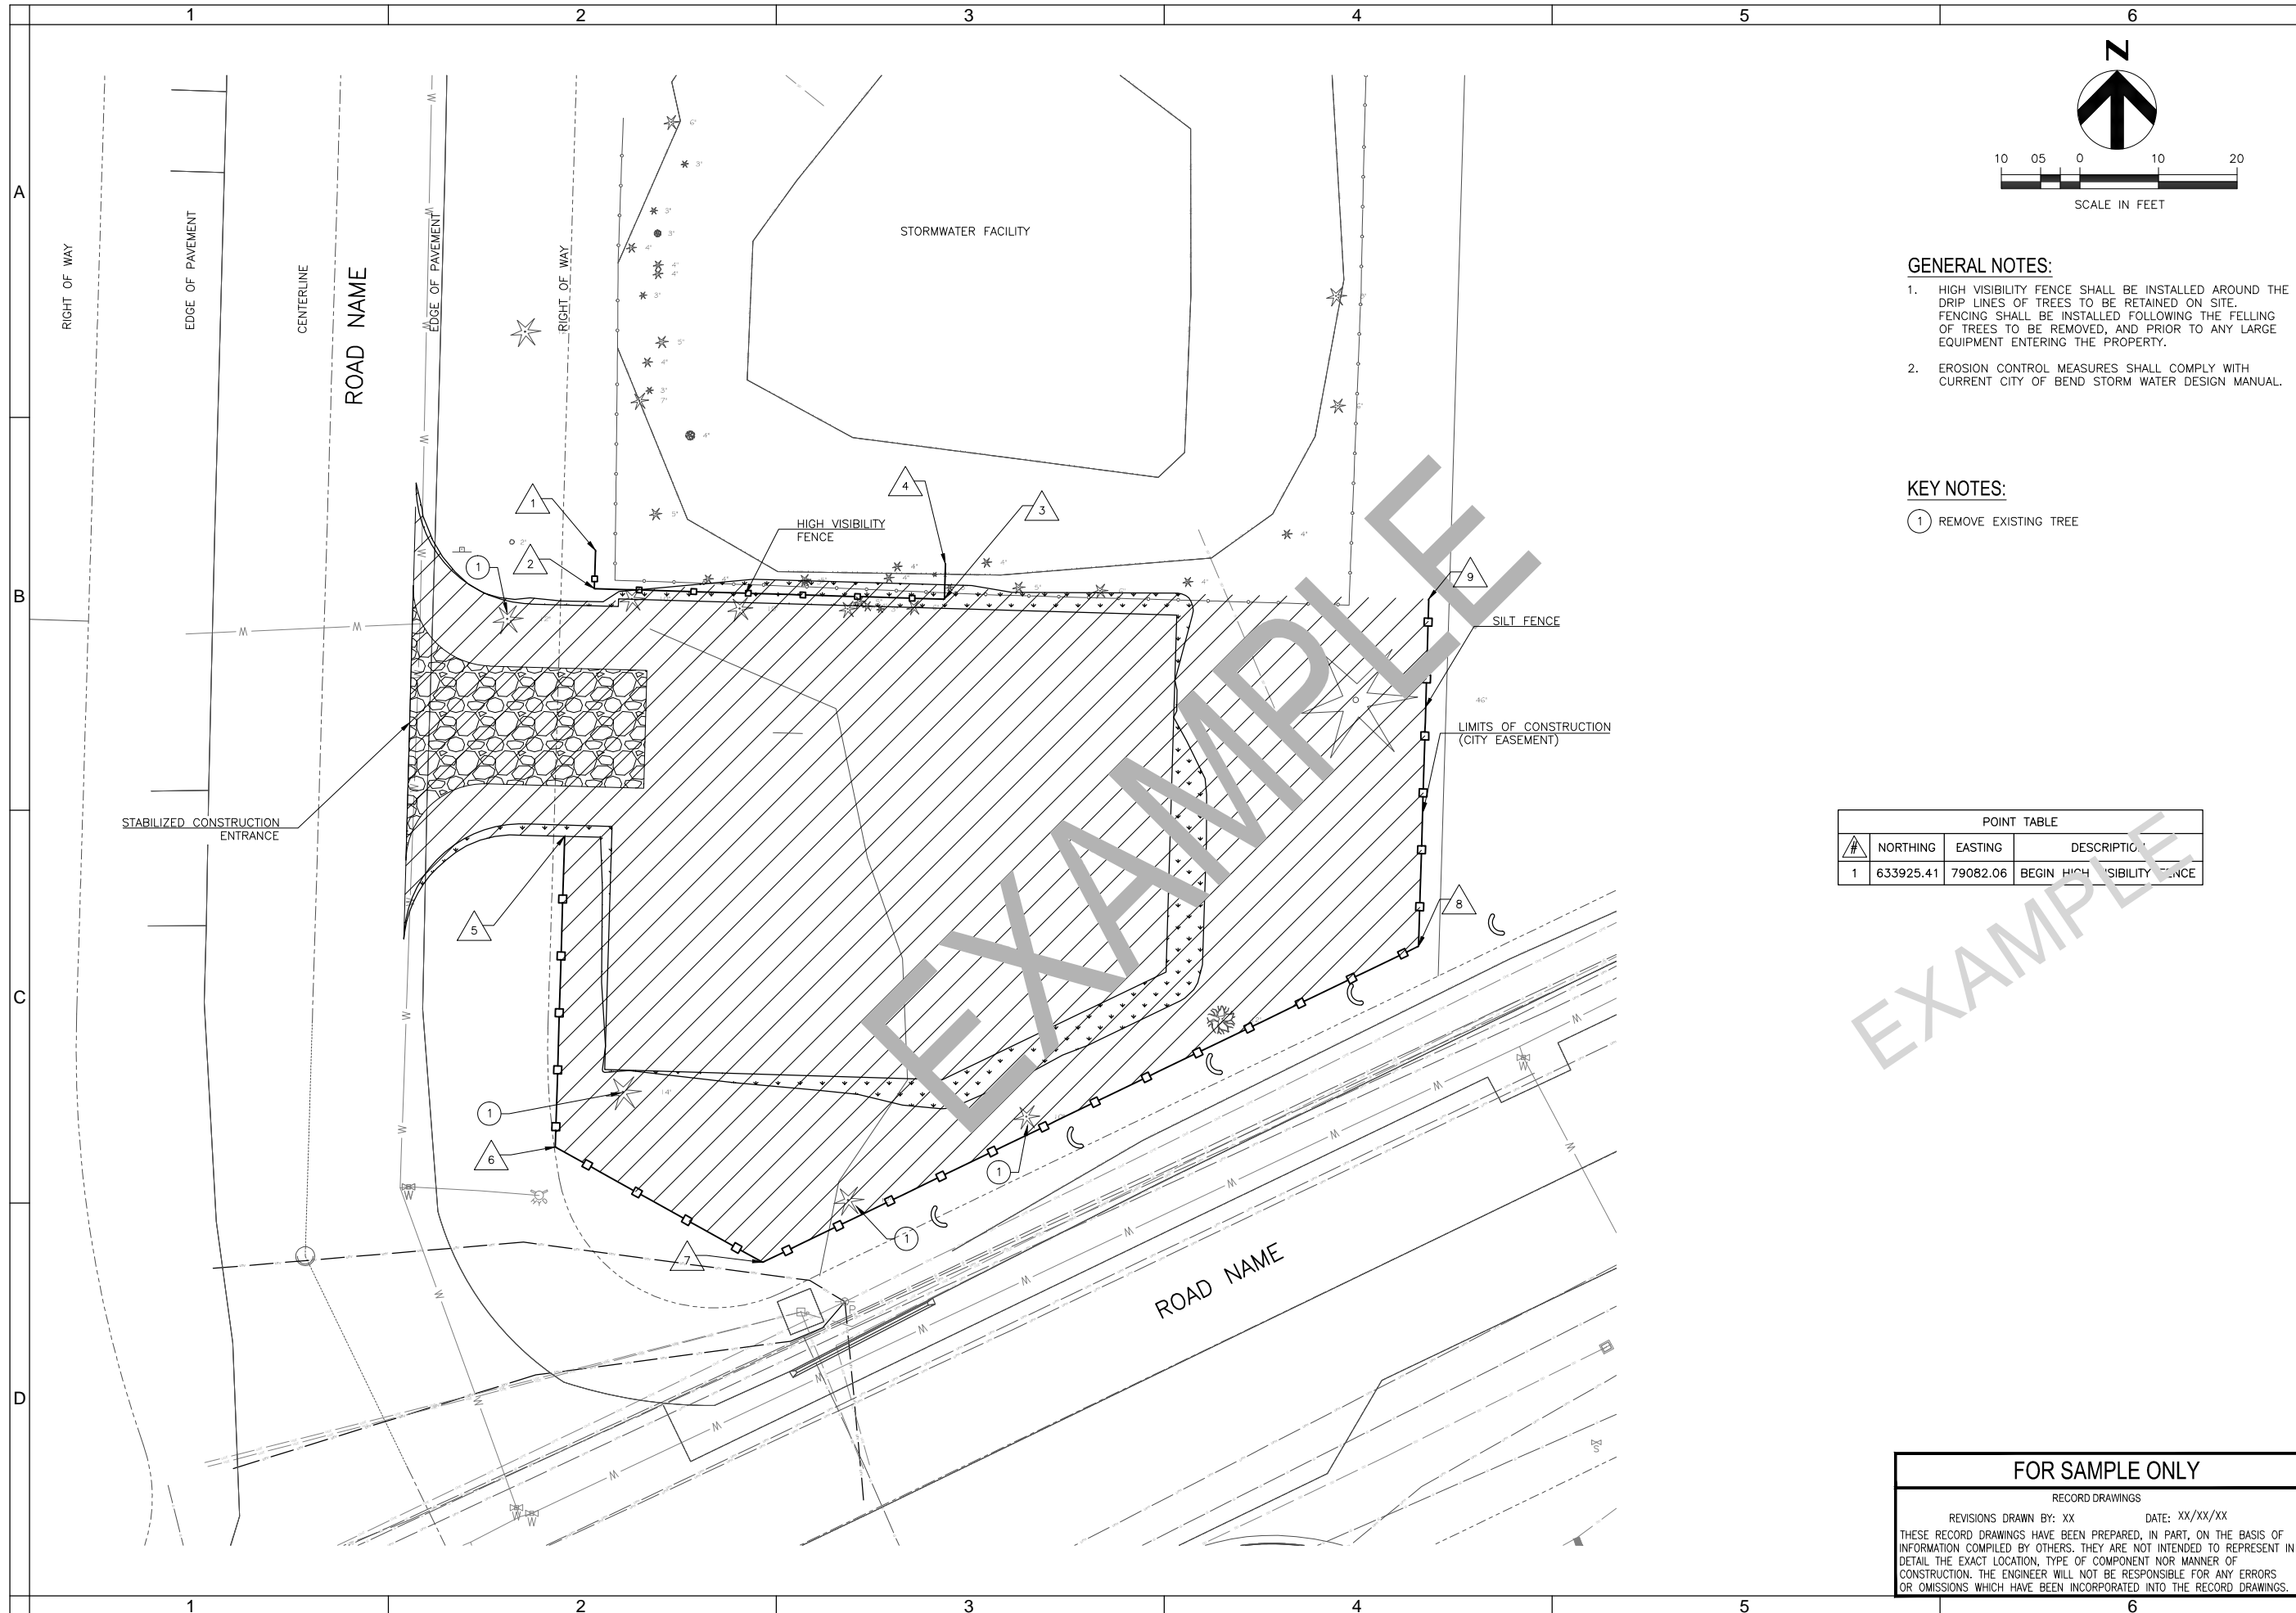

GENERAL NOTES:

- HIGH VISIBILITY FENCE SHALL BE INSTALLED AROUND THE DRIP LINES OF TREES TO BE RETAINED ON SITE. FENCING SHALL BE INSTALLED FOLLOWING THE FELLING OF TREES TO BE REMOVED, AND PRIOR TO ANY LARGE EQUIPMENT ENTERING THE PROPERTY.
- EROSION CONTROL MEASURES SHALL COMPLY WITH CURRENT CITY OF BEND STORM WATER DESIGN MANUAL.

KEY NOTES:

- ① REMOVE EXISTING TREE

POINT TABLE			
POINT	NORTHING	EASTING	DESCRIPTION
1	633925.41	79082.06	BEGIN HIGH VISIBILITY FENCE

FOR SEALS AND SIGNATURES

(PROJECT NAME)
CIVIL
DEMOLITION AND EROSION CONTROL PLAN
DESCHUTES COUNTY, OREGON



REVISIONS:

(CONSULTANT ENGINEER NAME, ADDRESS & PHONE NUMBER)


DESIGNED BY: _____
DRAWN BY: _____
SCALE: _____
FILE: _____
DATE: _____

VERIFY SCALES
0 1" BAR EQUALS ONE INCH ON ORIGINAL DRAWING


SHEET: C-001

COB # (XXXXXX)

FOR SAMPLE ONLY
RECORD DRAWINGS
REVISIONS DRAWN BY: XX DATE: XX/XX/XX
THESE RECORD DRAWINGS HAVE BEEN PREPARED, IN PART, ON THE BASIS OF INFORMATION COMPILED BY OTHERS. THEY ARE NOT INTENDED TO REPRESENT IN DETAIL THE EXACT LOCATION, TYPE OF COMPONENT NOR MANNER OF CONSTRUCTION. THE ENGINEER WILL NOT BE RESPONSIBLE FOR ANY ERRORS OR OMISSIONS WHICH HAVE BEEN INCORPORATED INTO THE RECORD DRAWINGS.

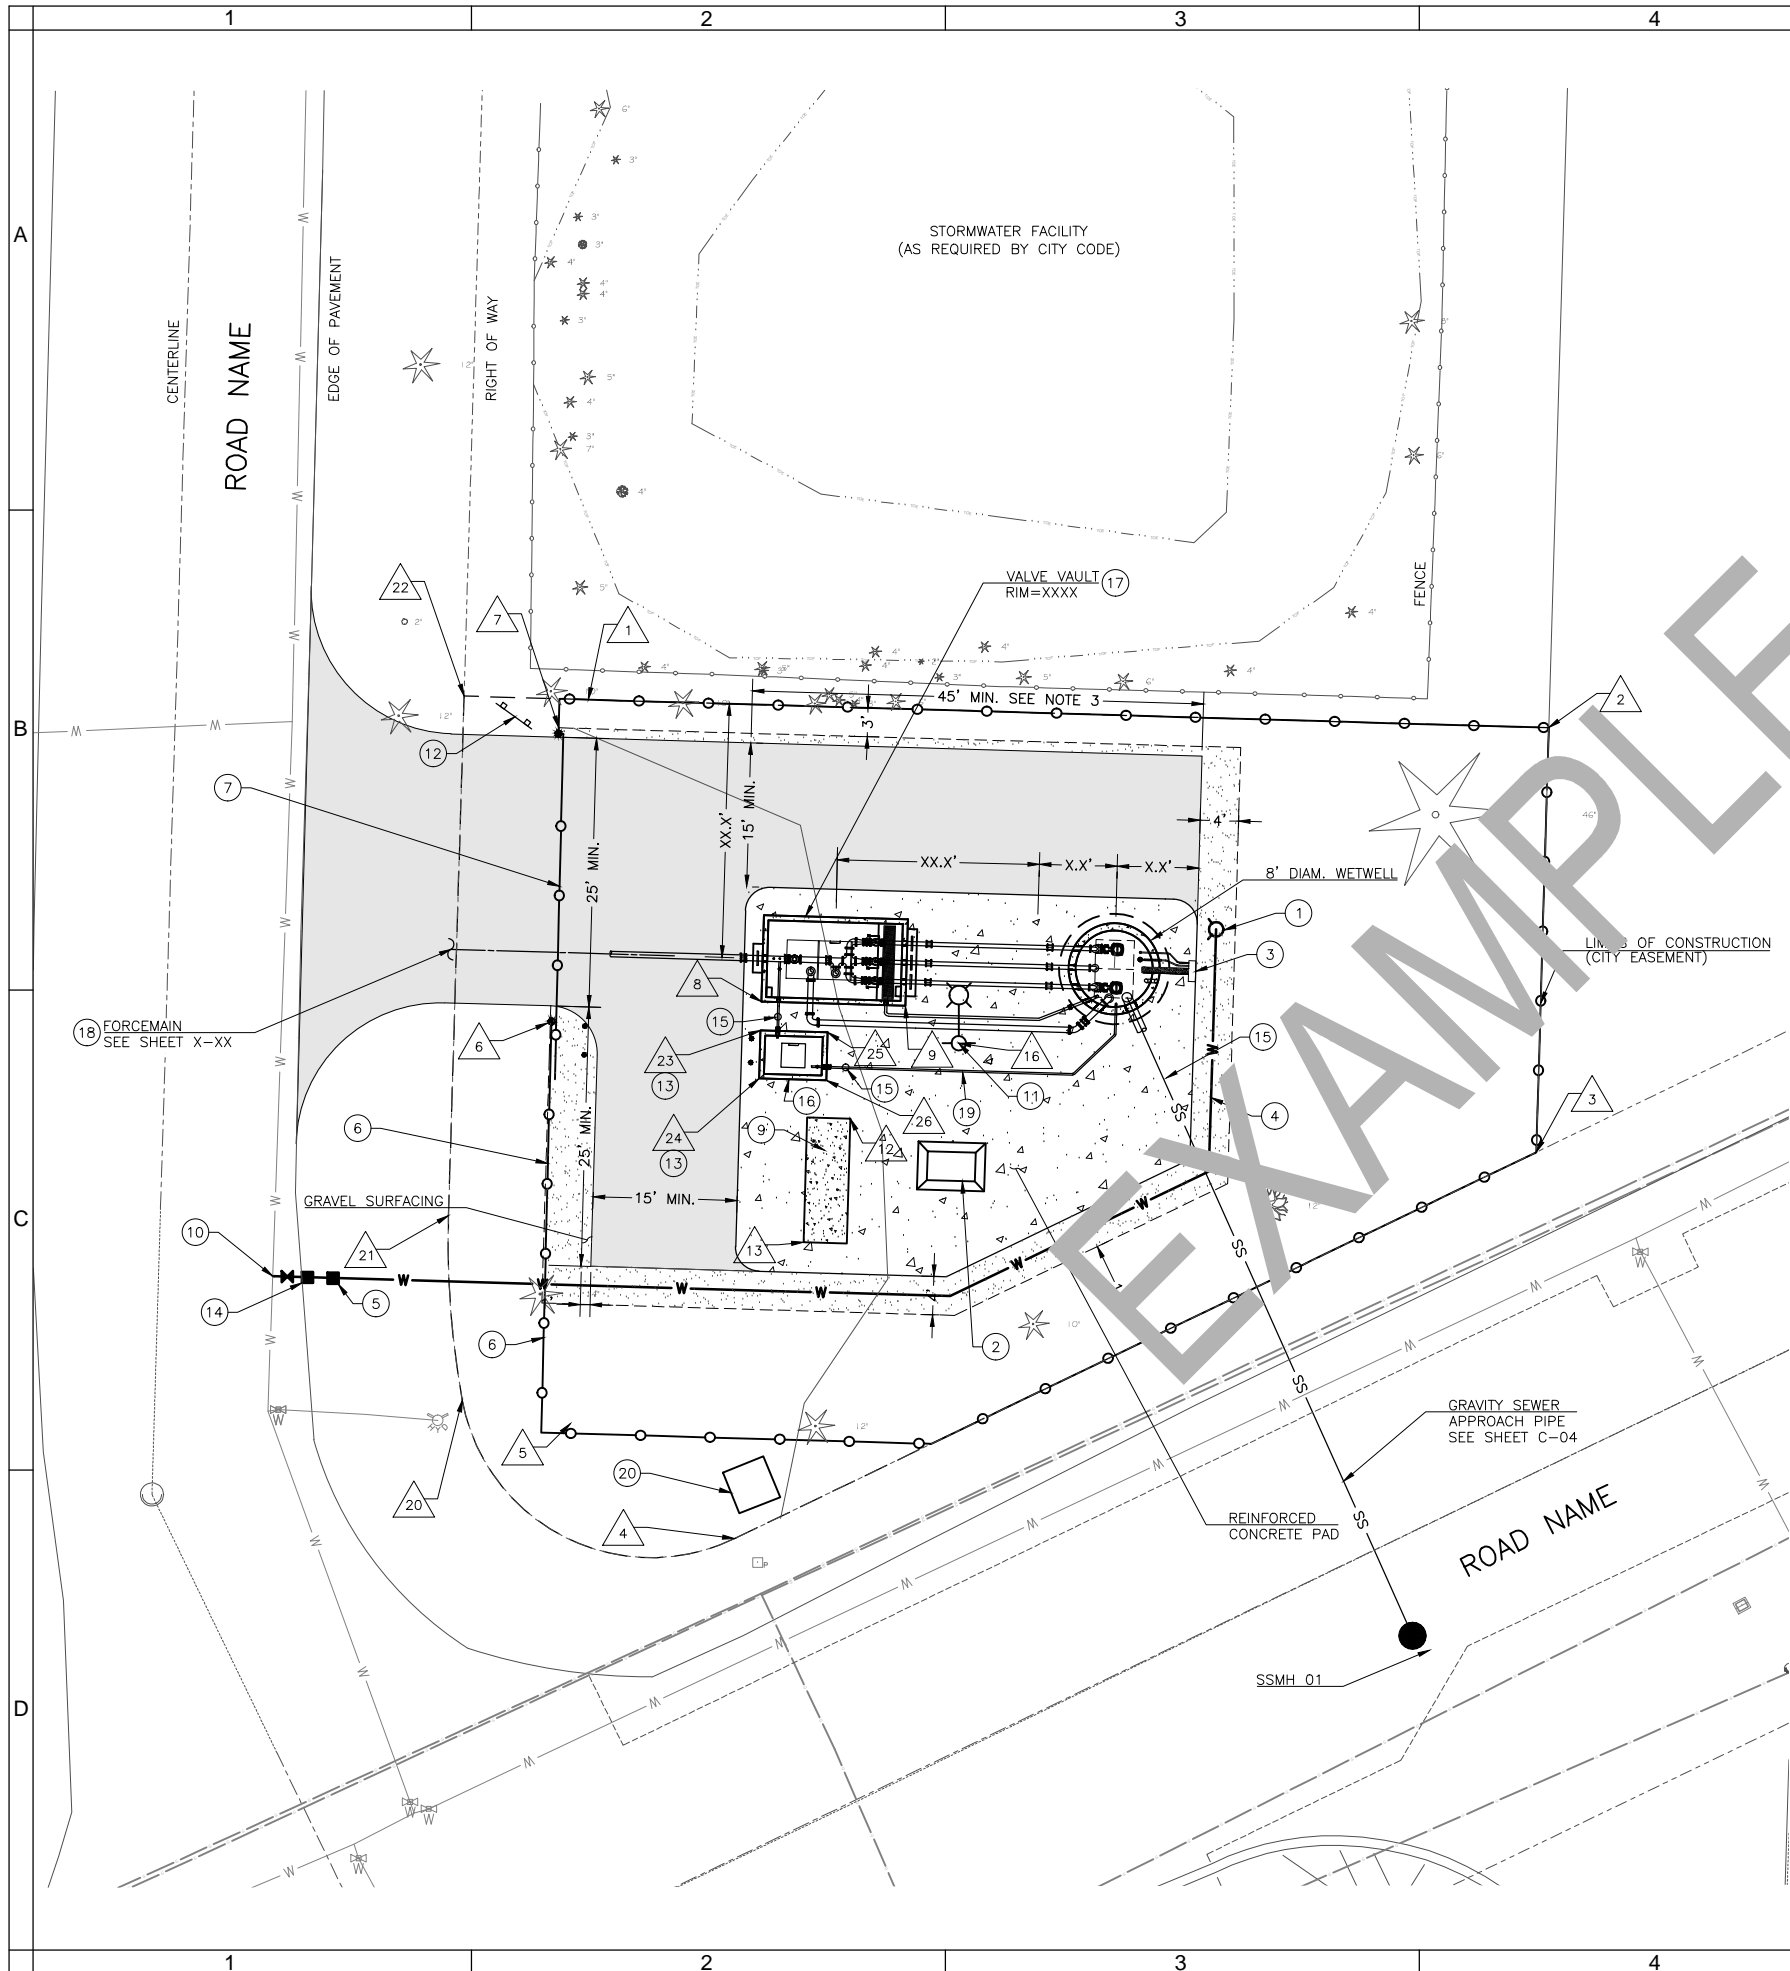

POINT TABLE			
#	NORTHING	EASTING	DESCRIPTION
1	633922.15	79088.07	FENCE
2	633919.22	79188.12	FENCE / EASEMENT AP
3	633875.01	79186.83	FENCE / EASEMENT AP
4	633834.76	79103.32	FENCE / EASEMENT PC
5	633846.73	79086.21	FENCE
6	633888.55	79087.24	FENCE / SLIDE GATE
7	633918.54	79087.98	FENCE / SLIDE GATE
8	633890.69	79106.11	VALVE VAULT
9	633890.25	79121.10	VALVE VAULT
12	633880.50	79115.45	GENERATOR PAD
13	633867.51	79115.01	GENERATOR PAD
16	633886.36	79106.67	SITE LIGHTING
20	633849.21	79074.76	EASEMENT PCC
21	633868.41	79074.72	EASEMENT PT
22	633922.53	79175.14	EASEMENT AP
23	633887.00	79106.19	BOLLARD
24	633885.19	79106.12	BOLLARD
25	633887.77	79110.19	ODOR CONTROL STATION
26	633883.07	79110.11	ODOR CONTROL STATION

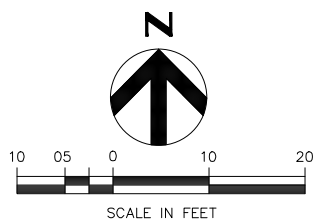

- GENERAL NOTES:**
- SEE CITY OF BEND STANDARD DETAIL FOR LIFT STATION AIR AND VACUUM RELEASE.
 - SEE CITY OF BEND STANDARD DETAIL FOR STANDARD VALVE BOX INSTALLATION.
 - DIMENSION SHOWN FOR CITY MAINTENANCE AND TRACTOR TRUCK ACCESS, ANY SITE VARIATION TO ACCESS MUST BE REVIEWED AND APPROVED BY THE CITY UTILITY DEPARTMENT.

- KEY NOTES:**
- NON-FREEZE TYPE WASH HYDRANT.
 - CONTROL PANEL PER NFPA 820.
 - ISOLATION PEDESTAL.
 - 2" POLYETHYLENE PIPE CLASS 200.
 - REDUCED PRESSURE BACK FLOW ASSEMBLY.
 - COATED CHAIN LINK FENCE.
 - AUTOMATIC 30' SLIDE GATE, VINYL COATED.
 - NOTE NOT USED
 - GENERATOR ON CONCRETE PAD (PROVIDE STRUCTURAL DESIGN).
 - CONNECT TO EXISTING WATER MAIN.
 - LIFT STATION SITE LIGHT.
 - CITY SIGN, SEE DETAIL (8).
 - BOLLARD TYPE 1.
 - 2" WATER SERVICE WITH 2" BALL VALVE (NO METER).
 - CITY OF BEND VALVE BOX.
 - 6'-0" x 4'-0" CONTAINMENT FOR ODOR CONTROL STATION TO BE COORDINATED AS NEEDED BY CITY OF BEND UTILITY DEPARTMENT.
 - SEE VALVE VAULT DETAILS SHEET M-101.
 - ROUTE TO EXISTING FORCE MAIN.
 - 4" SCHEDULE 80 PVC.
 - POWER VAULT TO BE INSTALLED BY XXX.



(PROJECT NAME)
CIVIL
SITE PLAN
DESCHUTES COUNTY, OREGON



REVISIONS:

(CONSULTANT ENGINEER NAME, ADDRESS & PHONE NUMBER)

DESIGNED BY: _____
DRAWN BY: _____
SCALE: _____
FILE: _____
DATE: _____

FOR SAMPLE ONLY

RECORD DRAWINGS



REVISIONS DRAWN BY: XX DATE: XX/XX/XX

THESE RECORD DRAWINGS HAVE BEEN PREPARED, IN PART, ON THE BASIS OF INFORMATION COMPILED BY OTHERS. THEY ARE NOT INTENDED TO REPRESENT IN DETAIL THE EXACT LOCATION, TYPE OF COMPONENT NOR MANNER OF CONSTRUCTION. THE ENGINEER WILL NOT BE RESPONSIBLE FOR ANY ERRORS OR OMISSIONS WHICH HAVE BEEN INCORPORATED INTO THE RECORD DRAWINGS.

VERIFY SCALES
0 1"
BAR EQUALS ONE INCH ON ORIGINAL DRAWING

SHEET: **C-002**

COB # (XXXXXX)

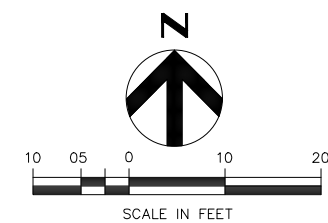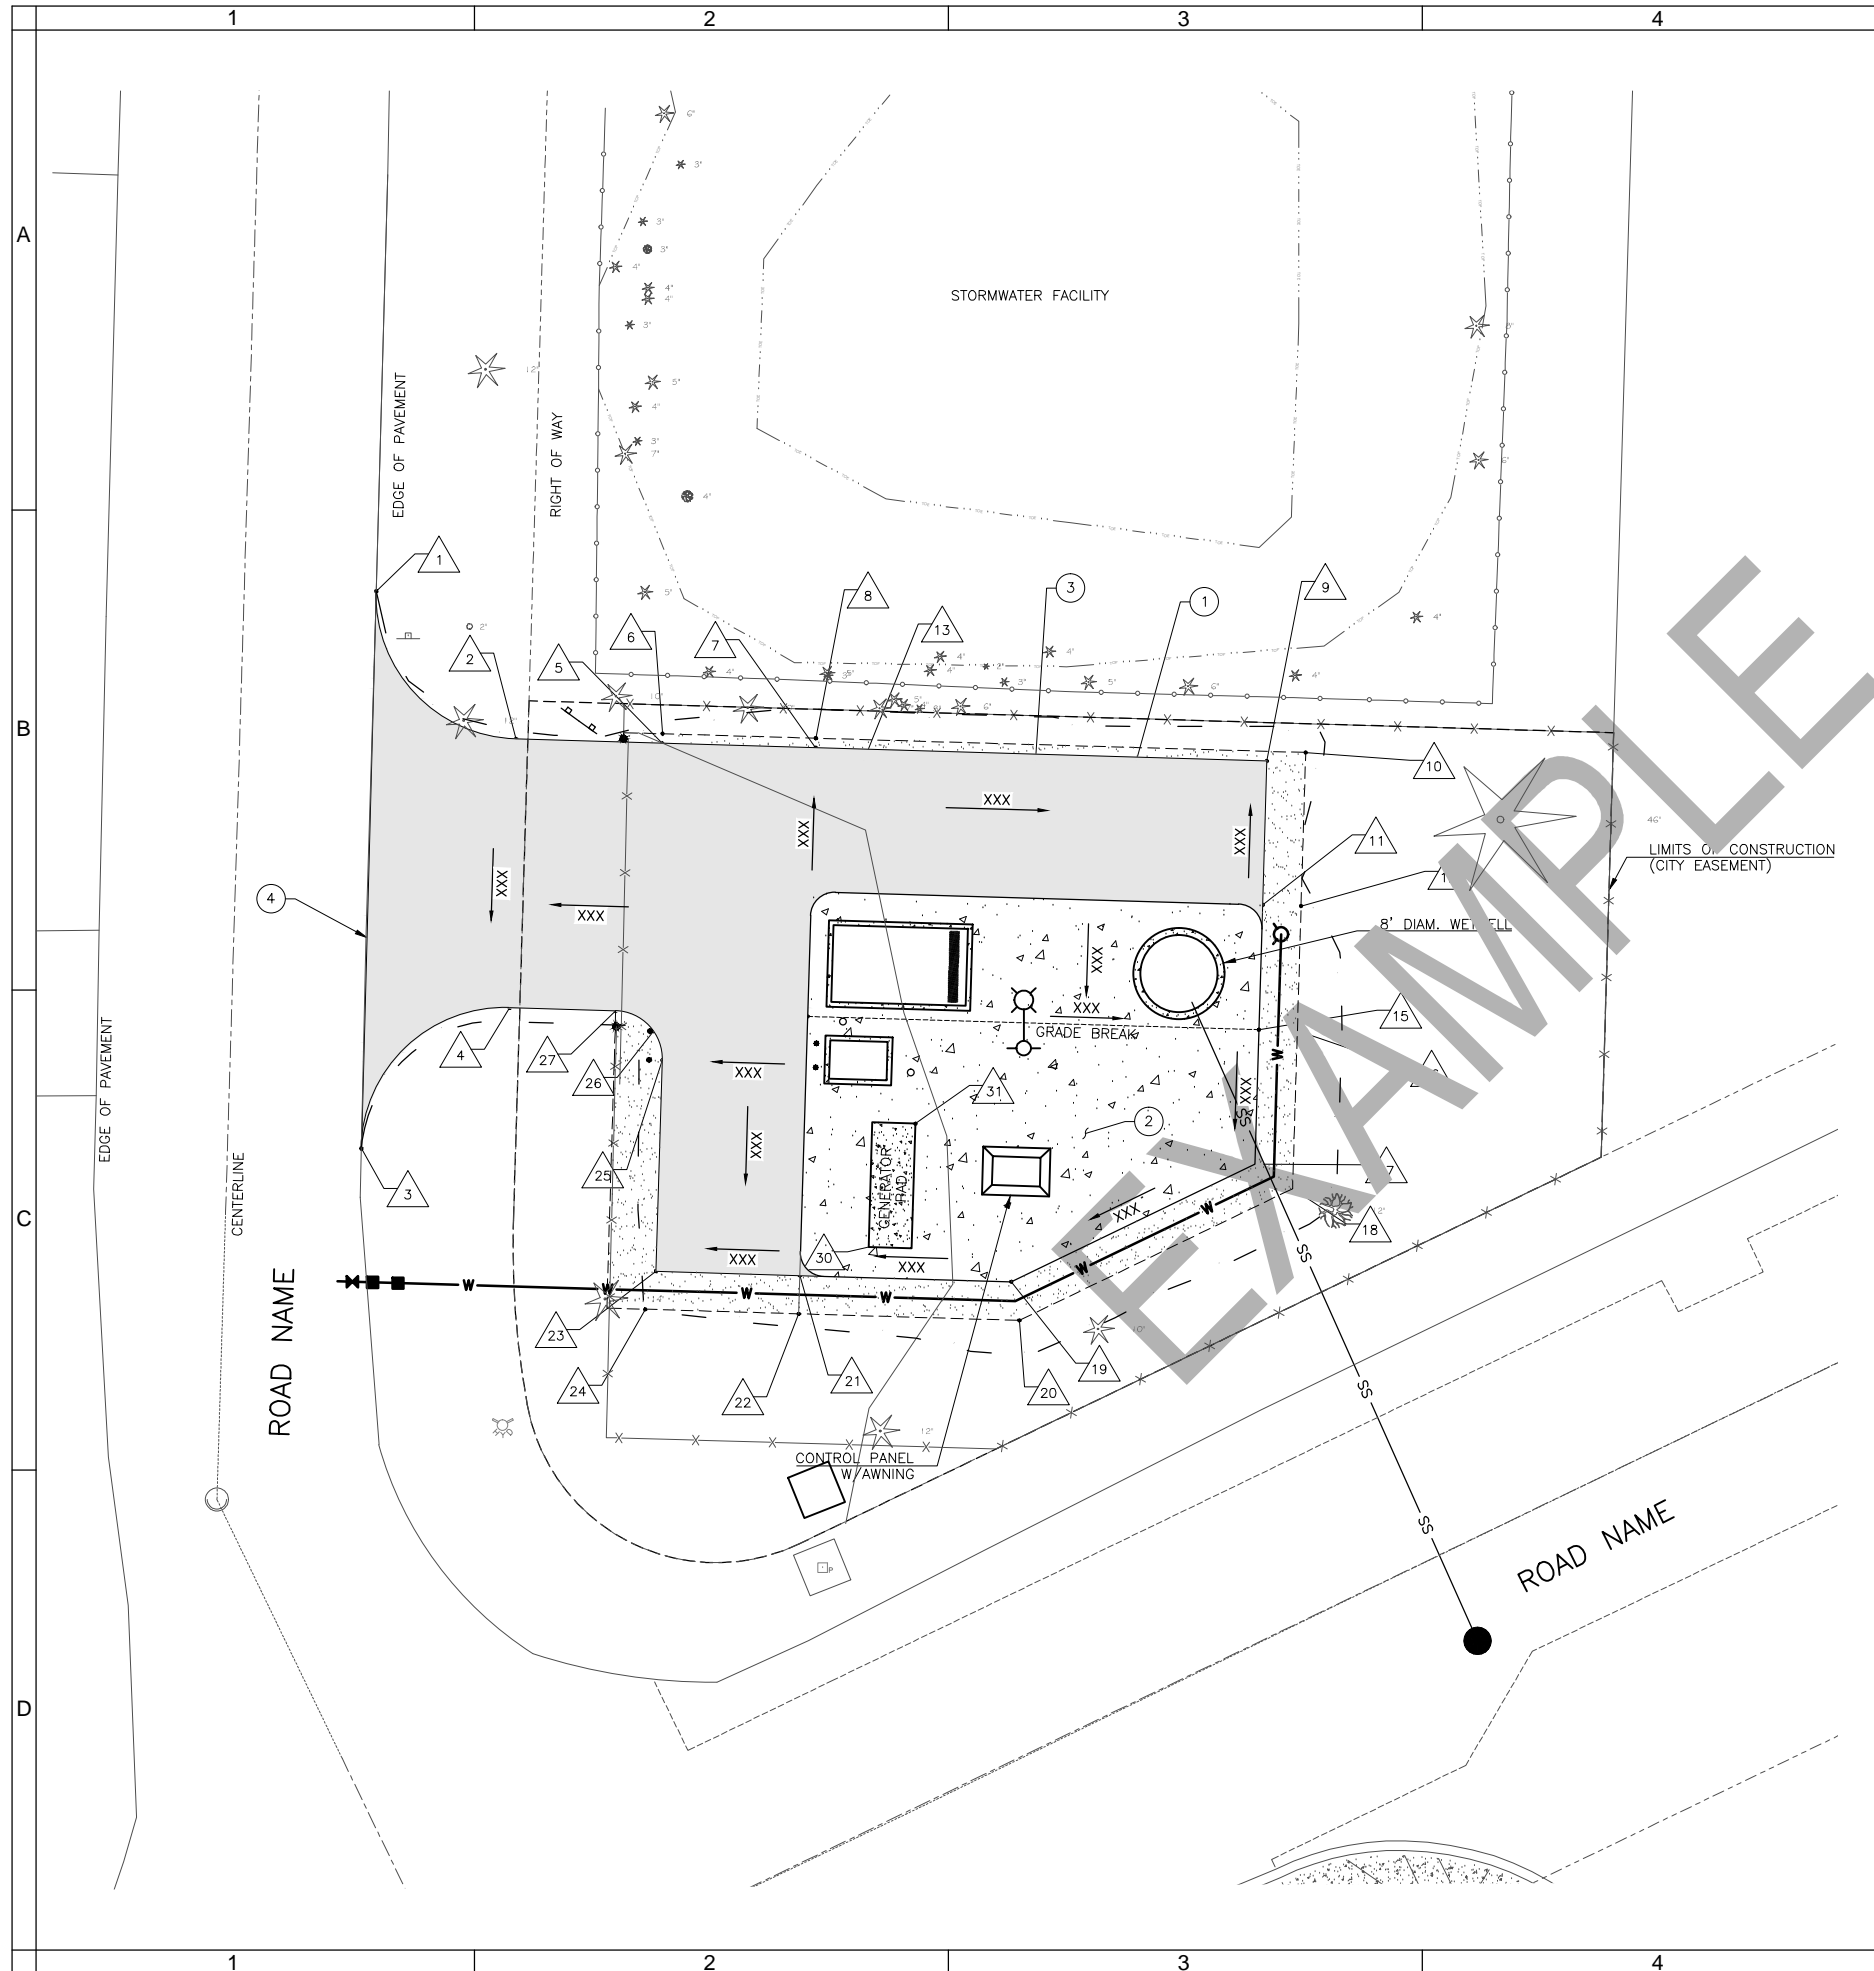

- KEY NOTES:**
- ① COMMERCIAL HMA
 - ② REINFORCED CONCRETE PAD.
 - ③ GRAVEL SURFACING SECTION.
 - ④ SAWCUT EXISTING ASPHALT CONC. PAVEMENT. TACKCOAT PER ODOT STANDARD.

POINT TABLE			
#	NORTHING	EASTING	DESCRIPTION
1	633933.96	79059.23	BEGIN ASPHALT
2	633918.57	79073.79	PT, ASPHALT
3	633875.90	79057.68	END ASPHALT
4	633890.57	79073.11	PC, ASPHALT
5	633918.13	79089.01	BEGIN GRAVEL
6	633919.12	79089.04	AP, GRAVEL
7	633917.65	79104.99	GRADE BREAK, CONCRETE & GRAVEL
8	633918.65	79105.02	GRADE BREAK, GRAVEL
9	633916.28	79152.00	AP, CONCRETE & GRAVEL
10	633917.16	79156.04	AP, GRAVEL
11	633901.28	79151.56	AP, CONCRETE
12	633901.16	79155.56	GRADE BREAK, GRAVEL
13	633902.66	79104.55	AP, CONCRETE
14	633889.67	79104.16	GRADE BREAK, CONCRETE
15	633888.29	79151.18	GRADE BREAK, CONCRETE
16	633888.17	79155.17	GRADE BREAK, GRAVEL
17	633874.27	79150.75	AP, CONCRETE & GRAVEL
18	633871.73	79154.68	AP, GRAVEL
19	633862.03	79125.36	AP, CONCRETE & GRAVEL
20	633858.01	79126.22	AP, GRAVEL
21	633862.68	79103.35	AP, CONCRETE
22	633858.68	79103.23	GRADE BREAK, GRAVEL
23	633863.12	79088.36	AP, CONCRETE & GRAVEL
24	633859.15	79087.24	AP, GRAVEL
25	633885.10	79089.02	PC, ASPHALT & GRAVEL
26	633888.14	79088.11	END GRAVEL
27	633890.25	79084.17	PT, ASPHALT
28	633894.97	79113.74	VALVE VAULT
29	633894.24	79142.88	WETWELL
30	633867.64	79110.57	GENERATOR PAD
31	633880.50	79115.45	GENERATOR PAD

FOR SEALS AND SIGNATURES

(PROJECT NAME)
CIVIL
GRADING AND DRAINAGE PLAN
DESCHUTES COUNTY, OREGON



REVISIONS:

(CONSULTANT ENGINEER NAME, ADDRESS & PHONE NUMBER)



DESIGNED BY:
DRAWN BY:
SCALE:
FILE:
DATE:

VERIFY SCALES
0 1" BAR EQUALS ONE INCH ON ORIGINAL DRAWING

SHEET: C-003

COB # (XXXXXX)

FOR SAMPLE ONLY
RECORD DRAWINGS
REVISIONS DRAWN BY: XX DATE: XX/XX/XX
THESE RECORD DRAWINGS HAVE BEEN PREPARED, IN PART, ON THE BASIS OF INFORMATION COMPILED BY OTHERS. THEY ARE NOT INTENDED TO REPRESENT IN DETAIL THE EXACT LOCATION, TYPE OF COMPONENT NOR MANNER OF CONSTRUCTION. THE ENGINEER WILL NOT BE RESPONSIBLE FOR ANY ERRORS OR OMISSIONS WHICH HAVE BEEN INCORPORATED INTO THE RECORD DRAWINGS.

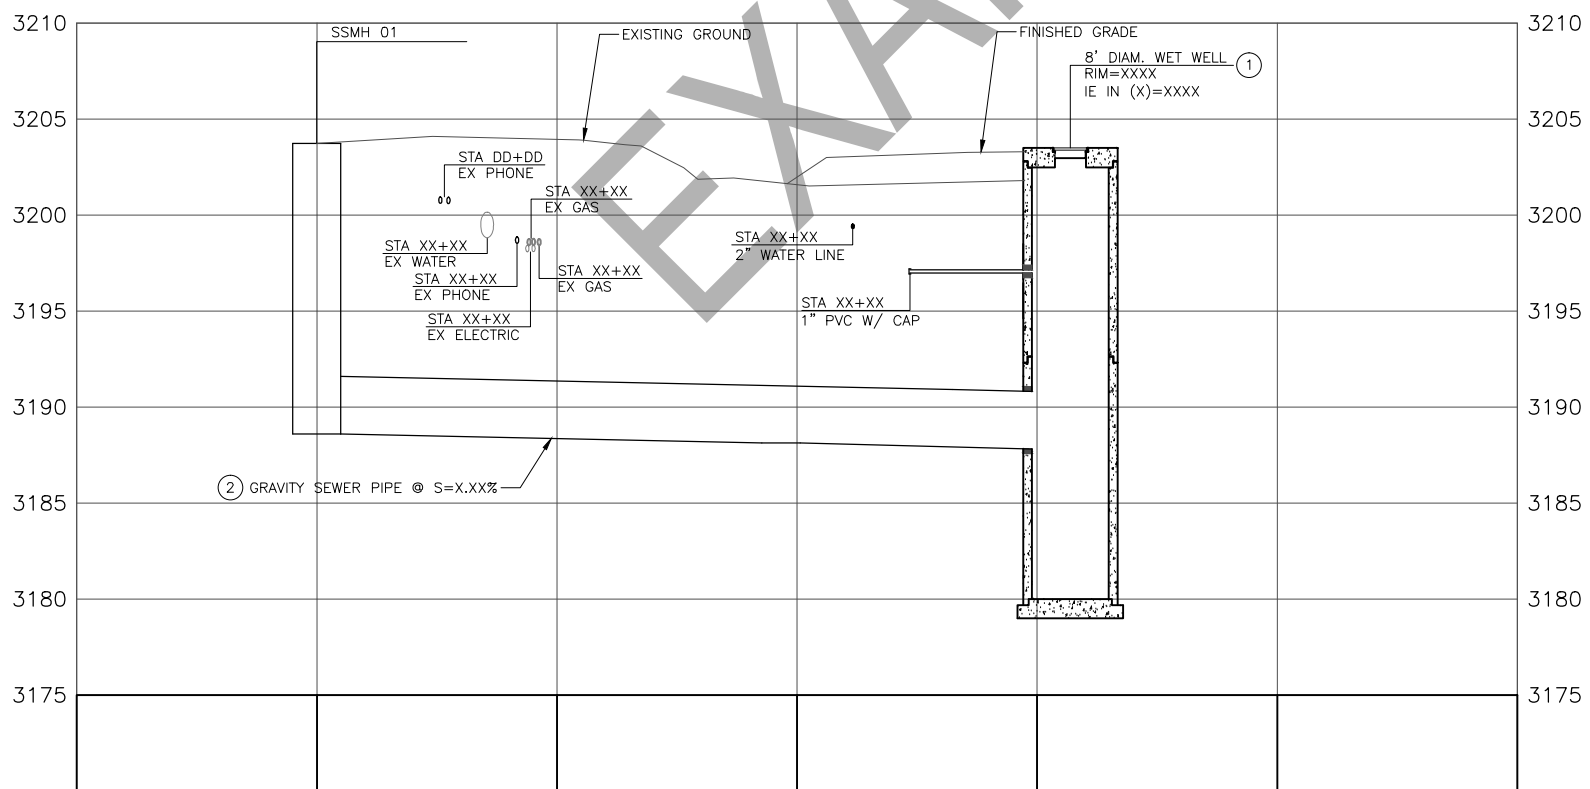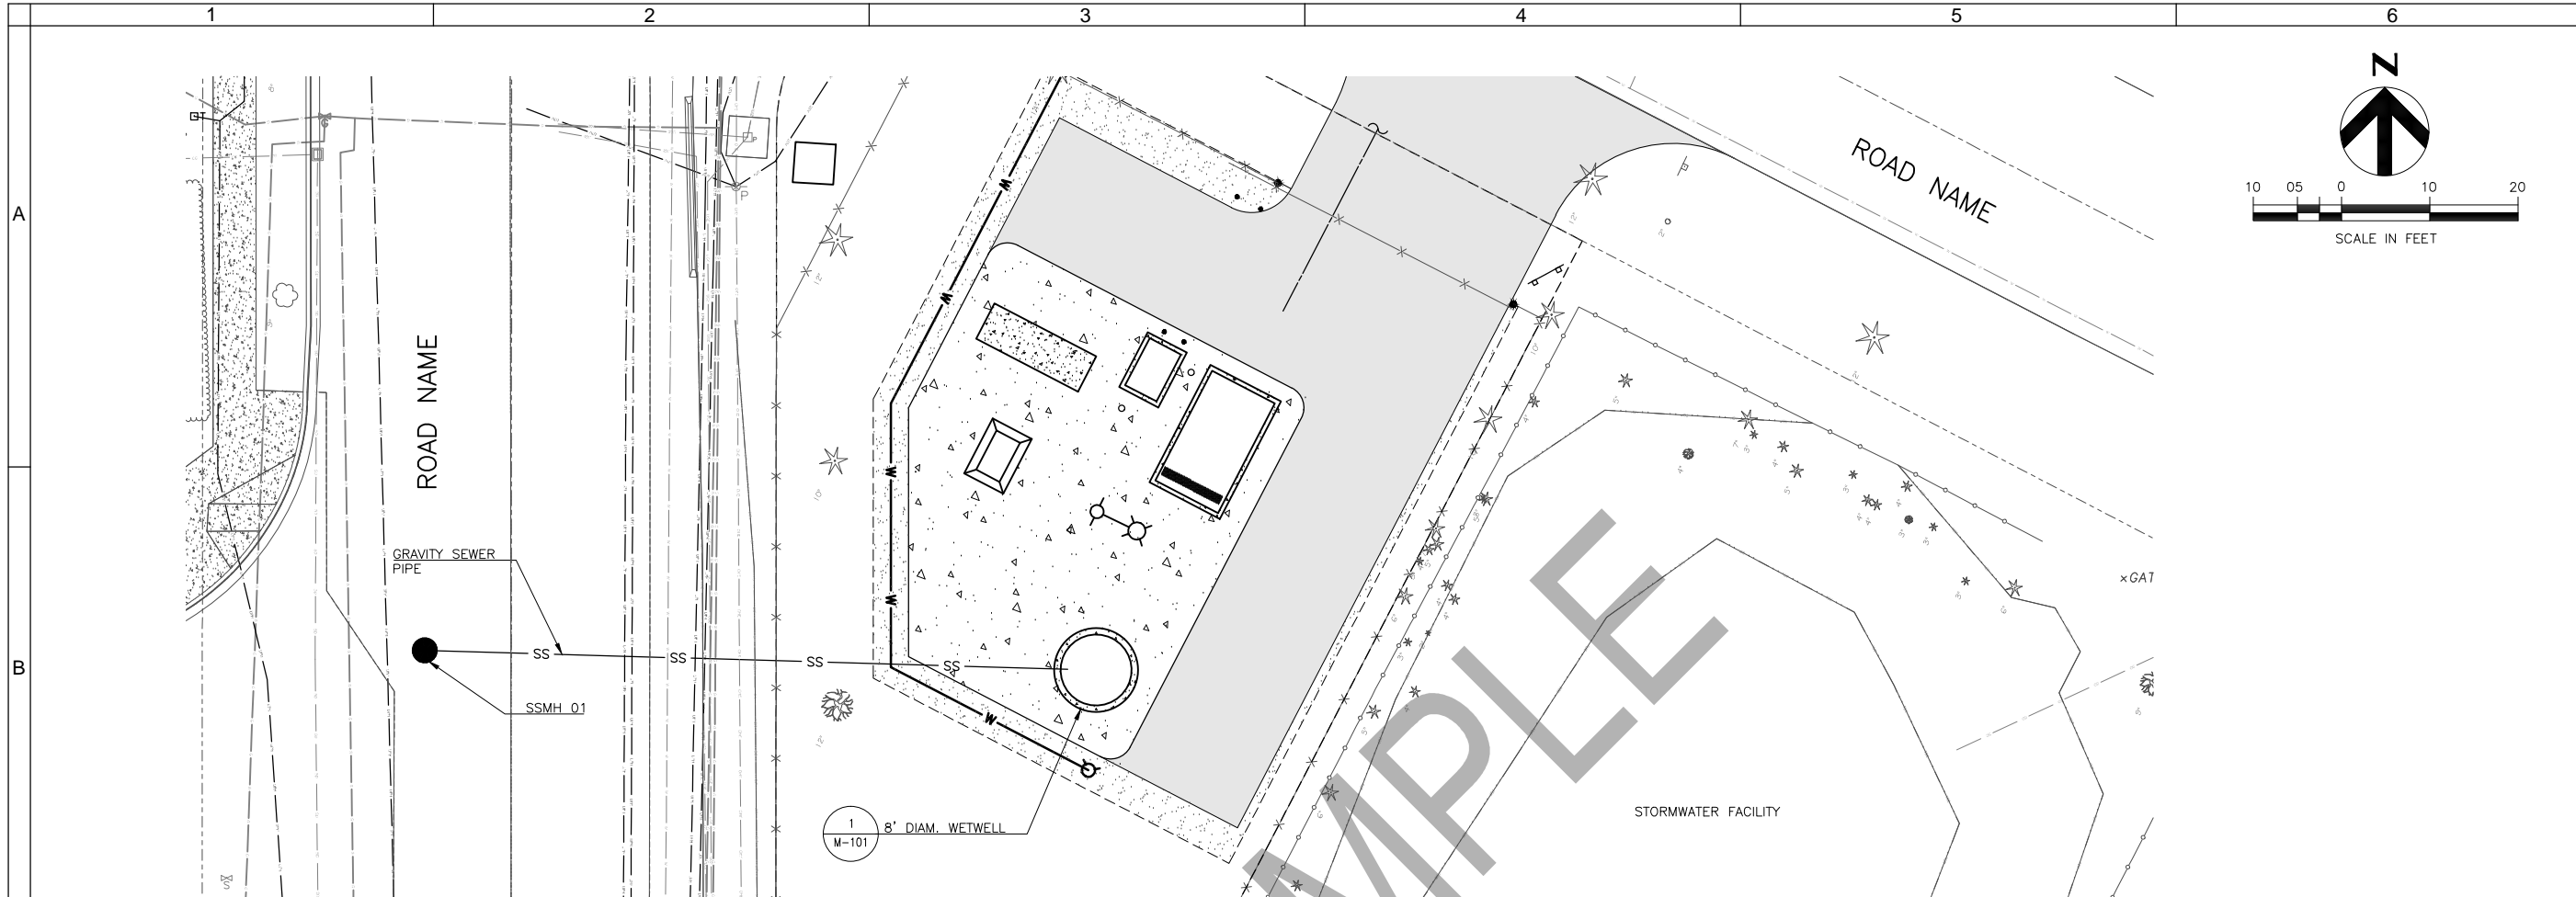

KEY NOTES:

- ① RIM ELEVATION TO BE 6" ABOVE FINISH GRADE AND 12" ABOVE 100 YEAR FLOOD ELEVATION.
- ② NOTE MAXIMUM SLOPE PER HYDRAULIC INSTITUTE STANDARD 9.8, ARTICLE C.4.2

FOR SEALS AND SIGNATURES

(PROJECT NAME)
CIVIL
GRAVITY SEWER PLAN AND PROFILE
DESCHUTES COUNTY, OREGON



REVISIONS:

(CONSULTANT ENGINEER NAME, ADDRESS & PHONE NUMBER)



DESIGNED BY: _____
DRAWN BY: _____
SCALE: _____
FILE: _____
DATE: _____

VERIFY SCALES
0 1" BAR EQUALS ONE INCH ON ORIGINAL DRAWING

SHEET: **C-004**

COB# (XXXXXX)

FOR SAMPLE ONLY
RECORD DRAWINGS
REVISIONS DRAWN BY: XX DATE: XX/XX/XX
THESE RECORD DRAWINGS HAVE BEEN PREPARED, IN PART, ON THE BASIS OF INFORMATION COMPILED BY OTHERS. THEY ARE NOT INTENDED TO REPRESENT IN DETAIL THE EXACT LOCATION, TYPE OF COMPONENT NOR MANNER OF CONSTRUCTION. THE ENGINEER WILL NOT BE RESPONSIBLE FOR ANY ERRORS OR OMISSIONS WHICH HAVE BEEN INCORPORATED INTO THE RECORD DRAWINGS.

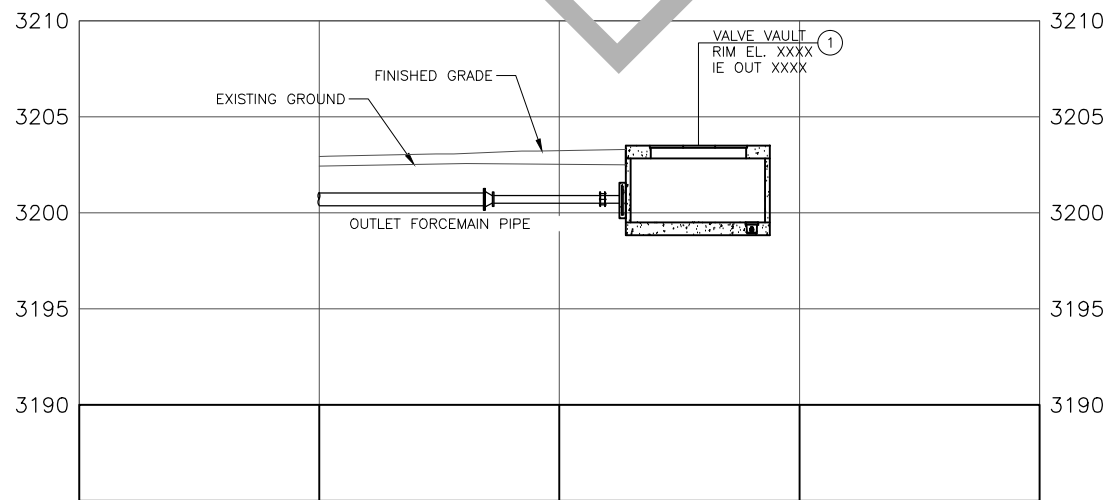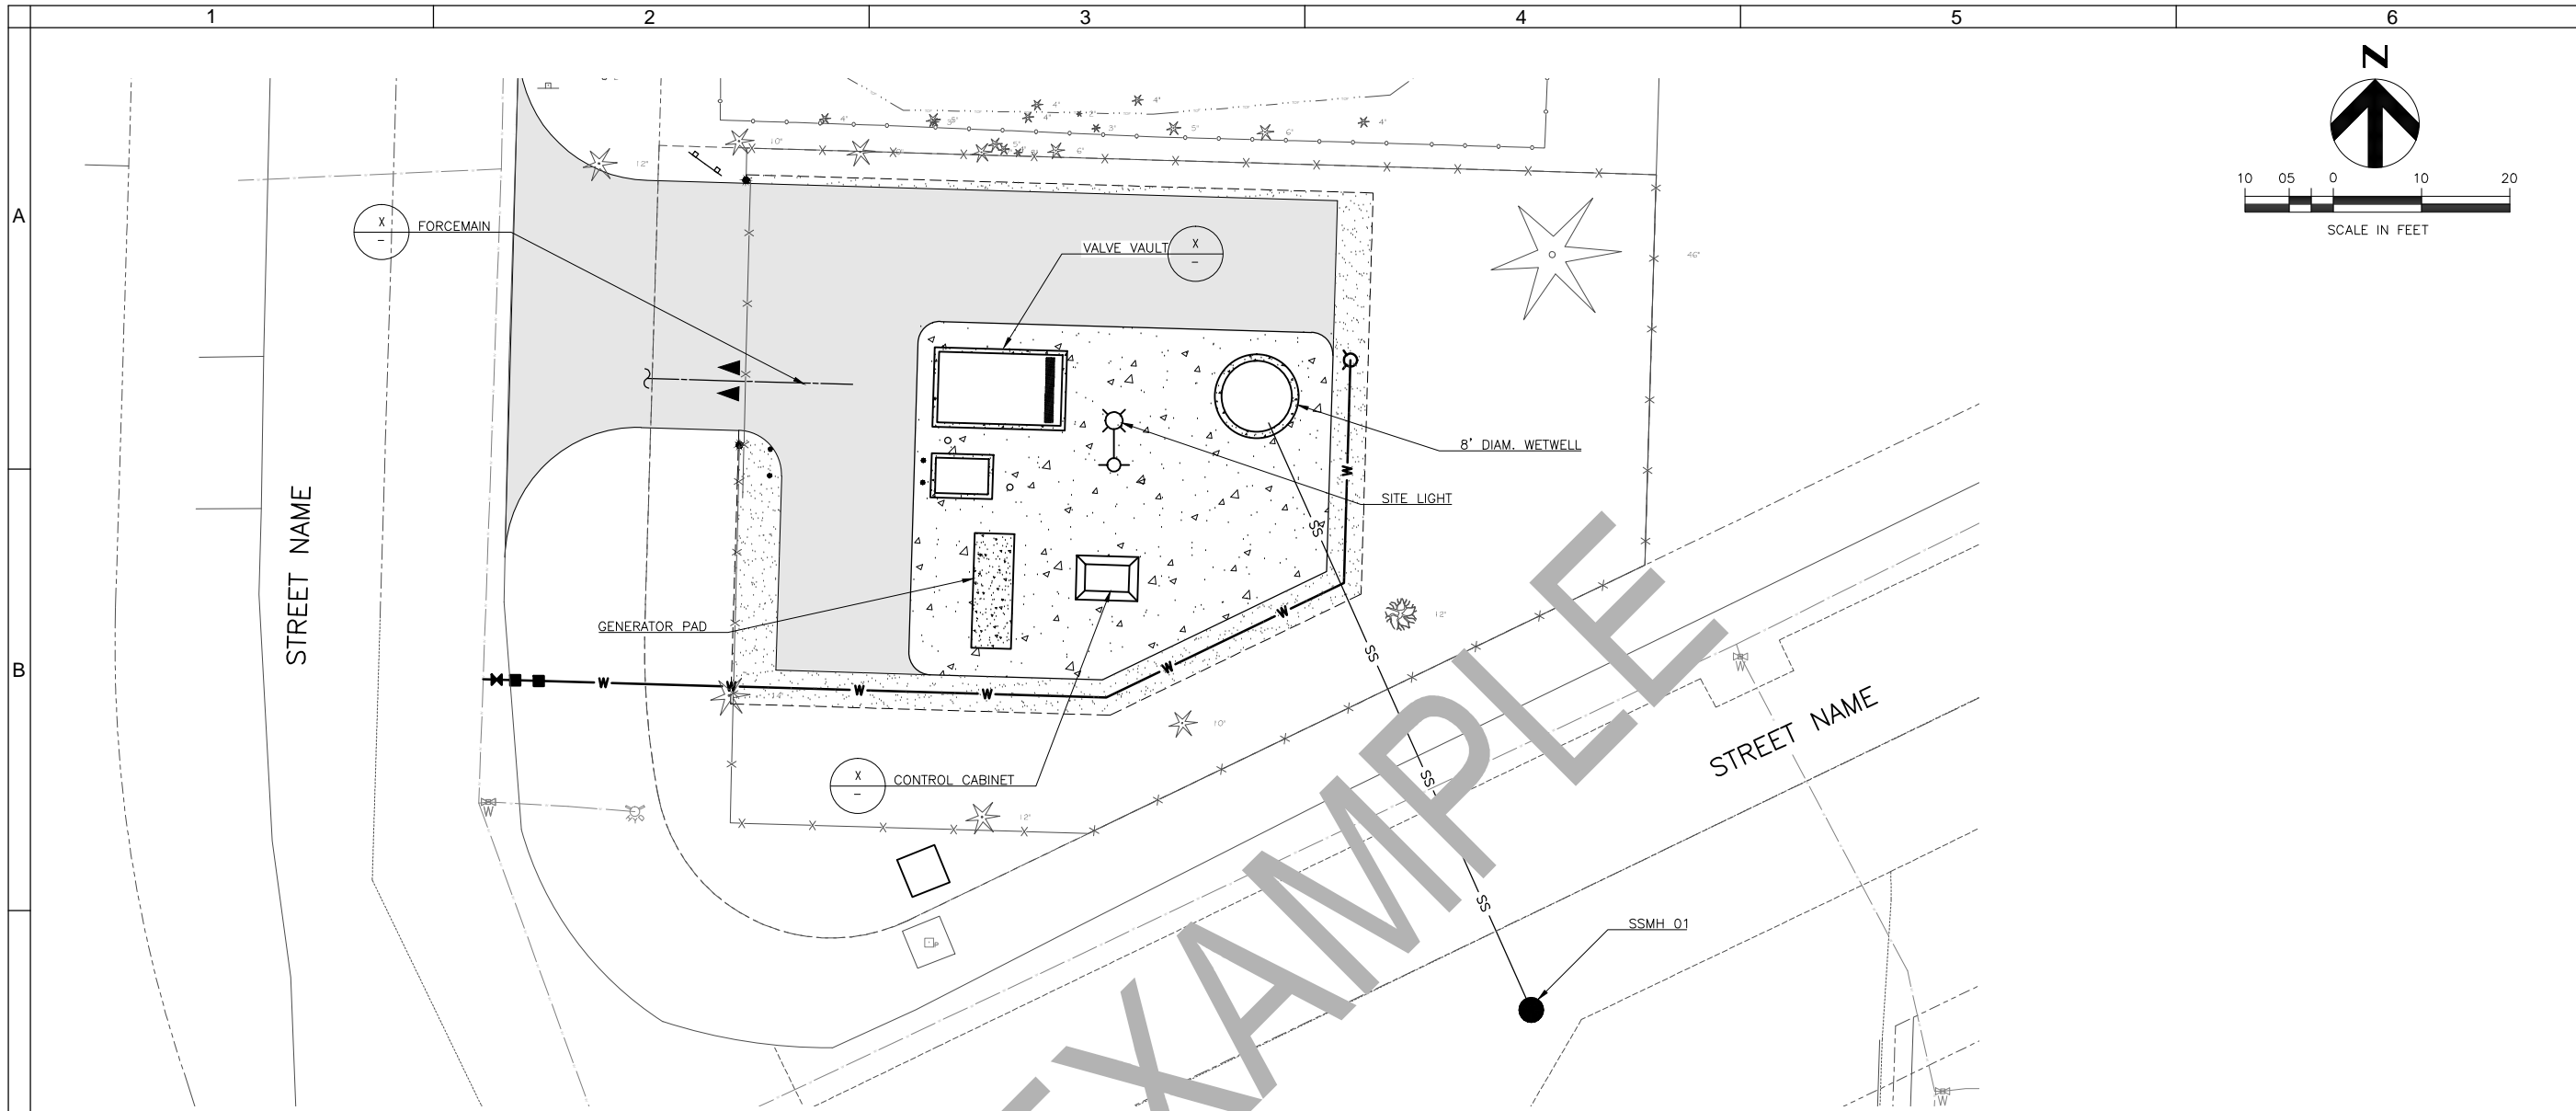

KEY NOTES:

- ① RIM ELEVATION TO BE 6" ABOVE FINISH GRADE AND 12" ABOVE 100 YEAR FLOOD ELEVATION.

FOR SEALS AND SIGNATURES

(PROJECT NAME)
CIVIL
 FORCE MAIN SEWER PLAN AND PROFILE
 DESCHUTES COUNTY, OREGON



REVISIONS:









(CONSULTANT ENGINEER NAME, ADDRESS & PHONE NUMBER)

DESIGNED BY: _____
 DRAWN BY: _____
 SCALE: _____
 FILE: _____
 DATE: _____

VERIFY SCALES
 0 1"
 BAR EQUALS ONE INCH ON ORIGINAL DRAWING

SHEET:
C-005
 COB # (XXXXXX)

FOR SAMPLE ONLY
 RECORD DRAWINGS
 REVISIONS DRAWN BY: XX DATE: XX/XX/XX
 THESE RECORD DRAWINGS HAVE BEEN PREPARED, IN PART, ON THE BASIS OF INFORMATION COMPILED BY OTHERS. THEY ARE NOT INTENDED TO REPRESENT IN DETAIL THE EXACT LOCATION, TYPE OF COMPONENT NOR MANNER OF CONSTRUCTION. THE ENGINEER WILL NOT BE RESPONSIBLE FOR ANY ERRORS OR OMISSIONS WHICH HAVE BEEN INCORPORATED INTO THE RECORD DRAWINGS.

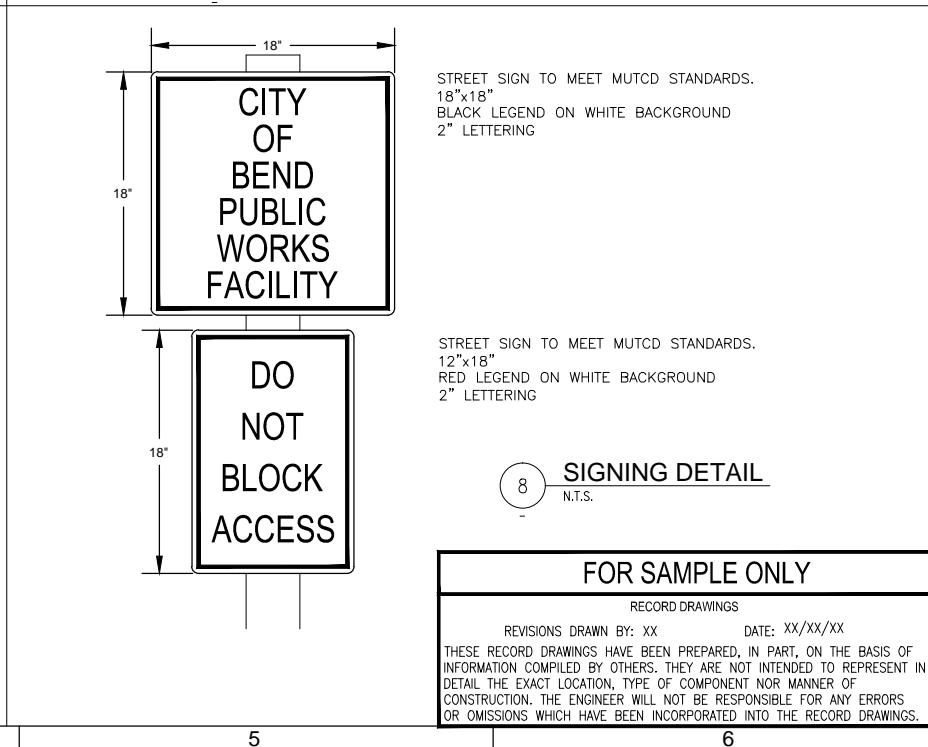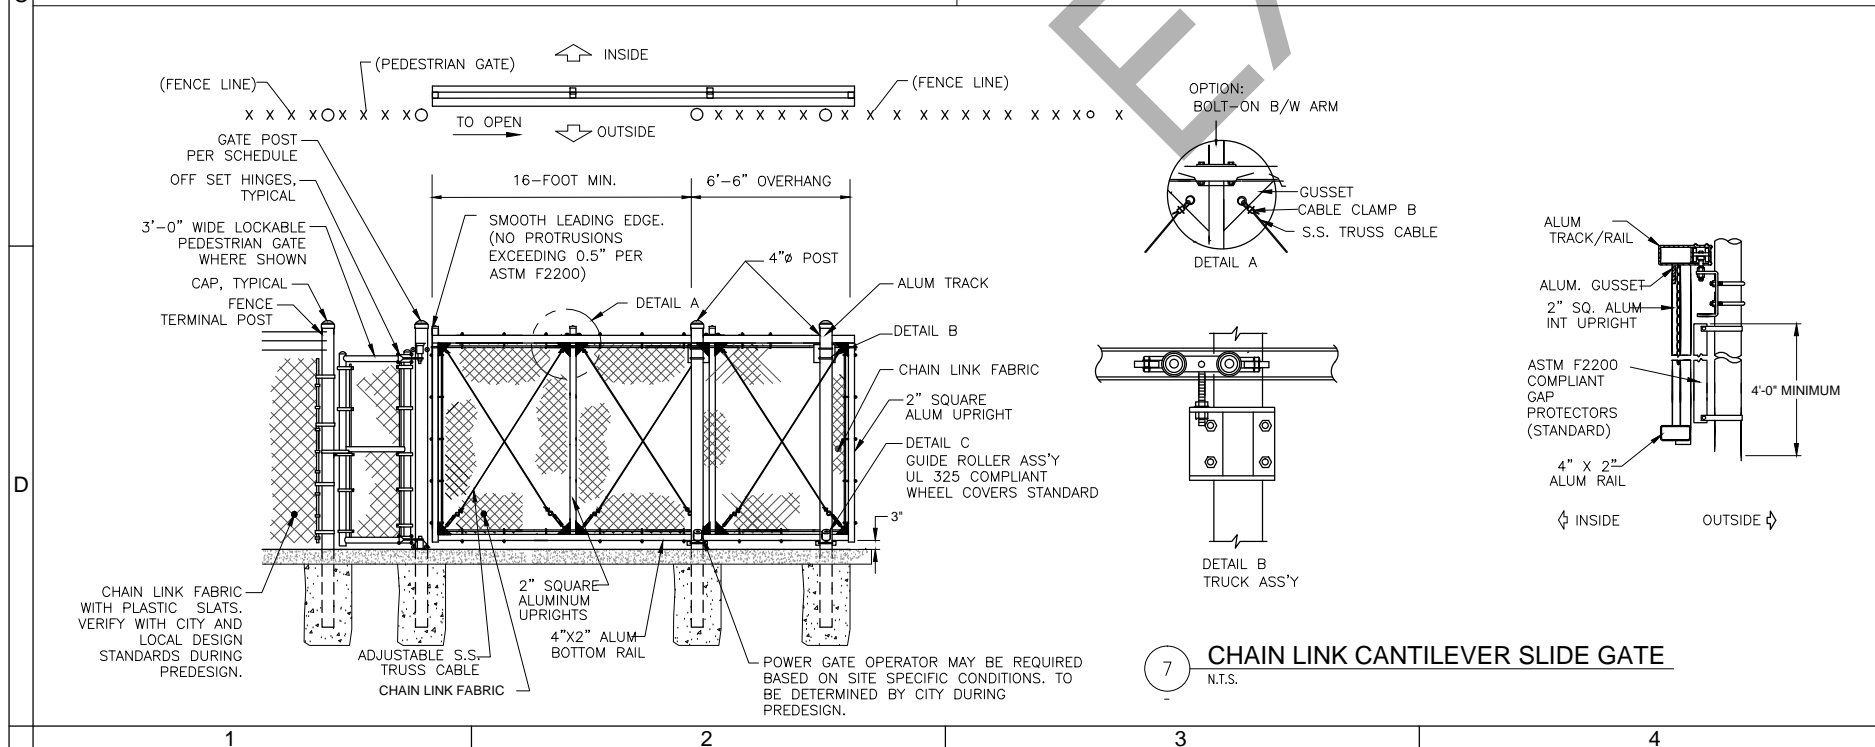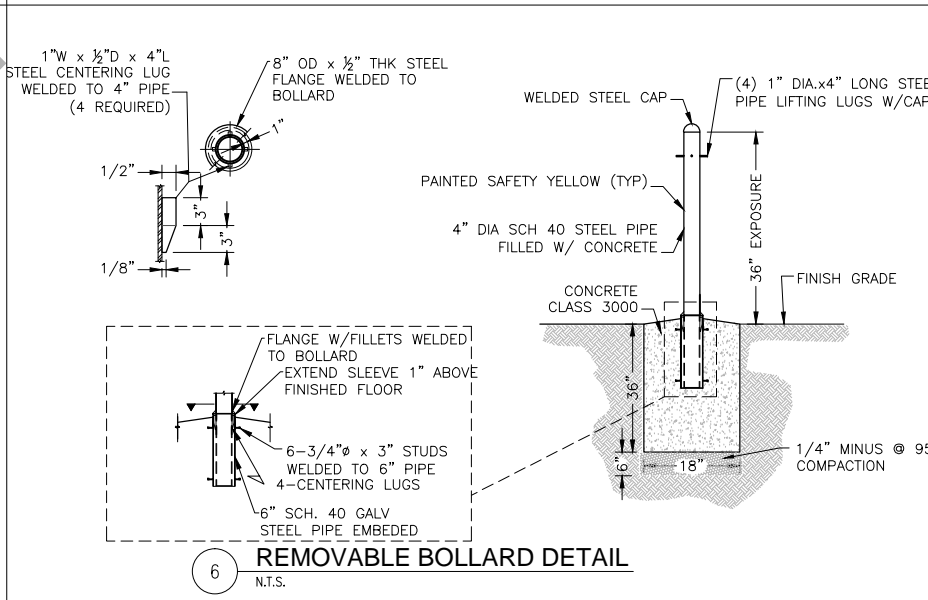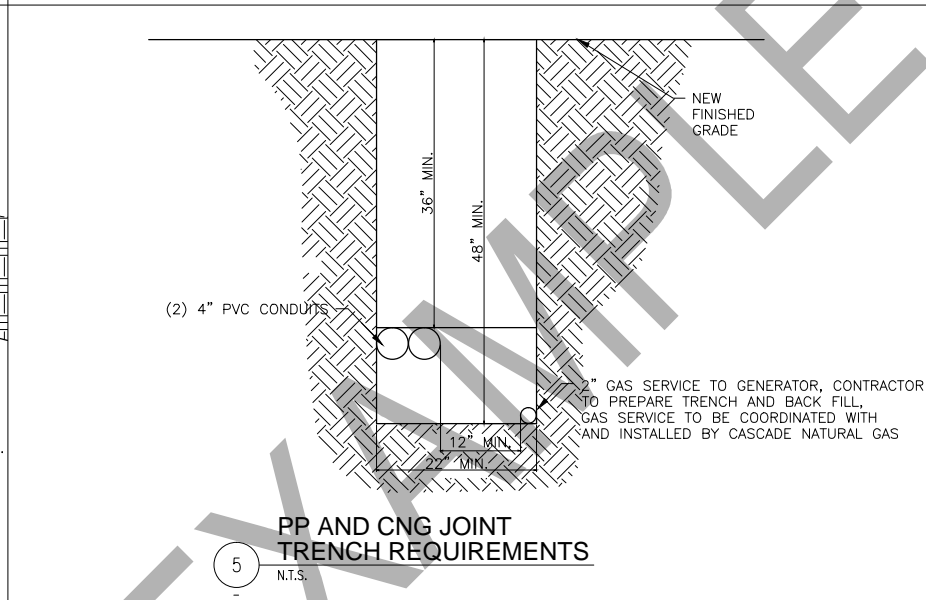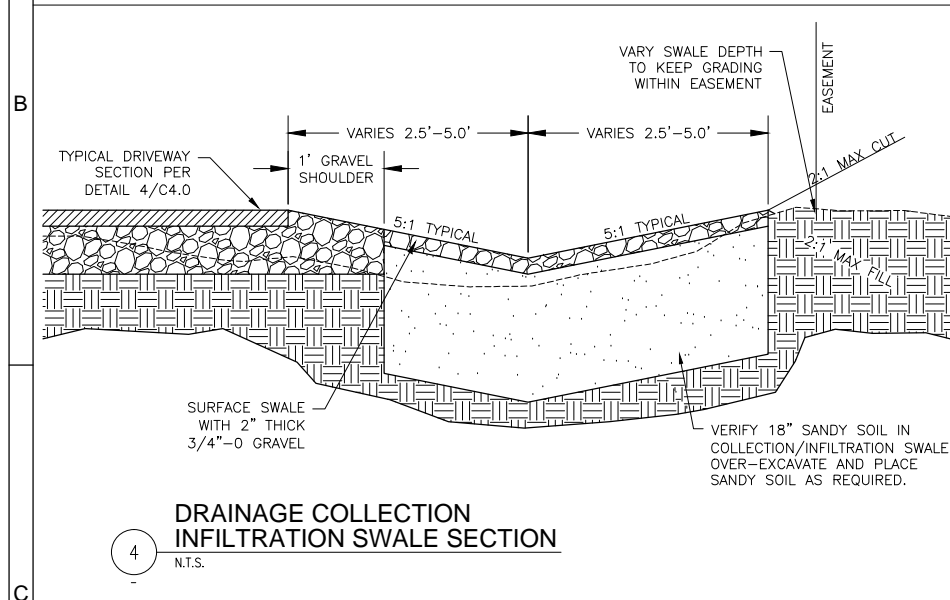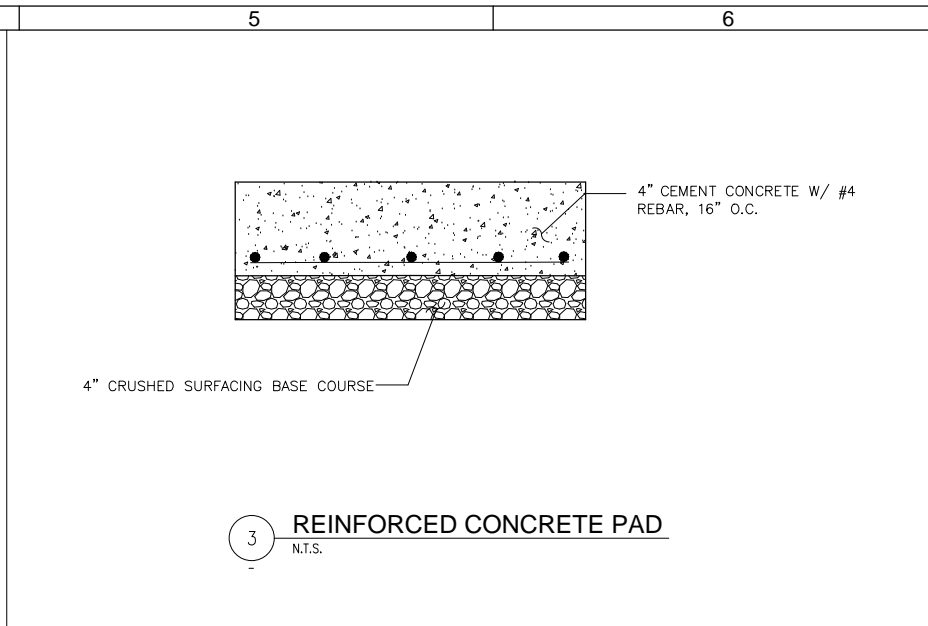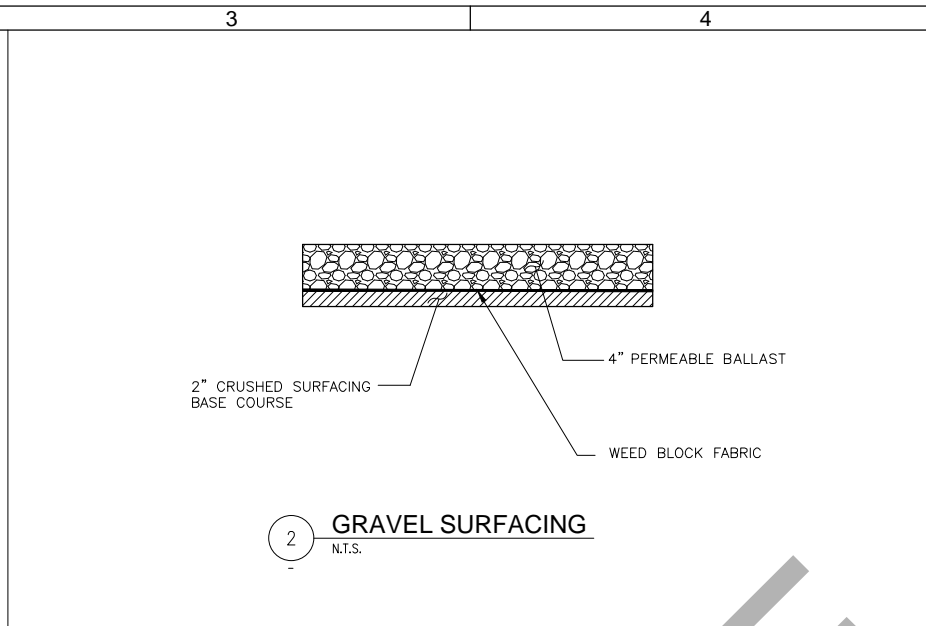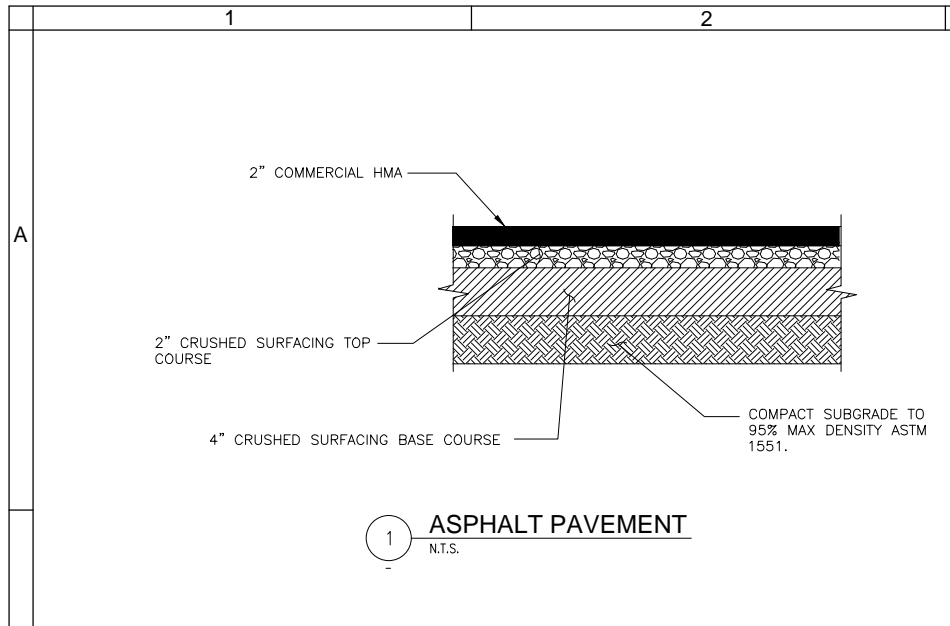

FOR SEALS AND SIGNATURES

(PROJECT NAME)
CIVIL
CIVIL DETAILS
DESCHUTES COUNTY, OREGON



REVISIONS:

(CONSULTANT ENGINEER NAME, ADDRESS & PHONE NUMBER)


DESIGNED BY: _____
DRAWN BY: _____
SCALE: _____
FILE: _____
DATE: _____

VERIFY SCALES
0 1"
BAR EQUALS ONE INCH ON ORIGINAL DRAWING

SHEET: **C-006**

COB # (XXXXXX)

FOR SAMPLE ONLY
RECORD DRAWINGS
REVISIONS DRAWN BY: XX DATE: XX/XX/XX
THESE RECORD DRAWINGS HAVE BEEN PREPARED, IN PART, ON THE BASIS OF INFORMATION COMPILED BY OTHERS. THEY ARE NOT INTENDED TO REPRESENT IN DETAIL THE EXACT LOCATION, TYPE OF COMPONENT NOR MANNER OF CONSTRUCTION. THE ENGINEER WILL NOT BE RESPONSIBLE FOR ANY ERRORS OR OMISSIONS WHICH HAVE BEEN INCORPORATED INTO THE RECORD DRAWINGS.

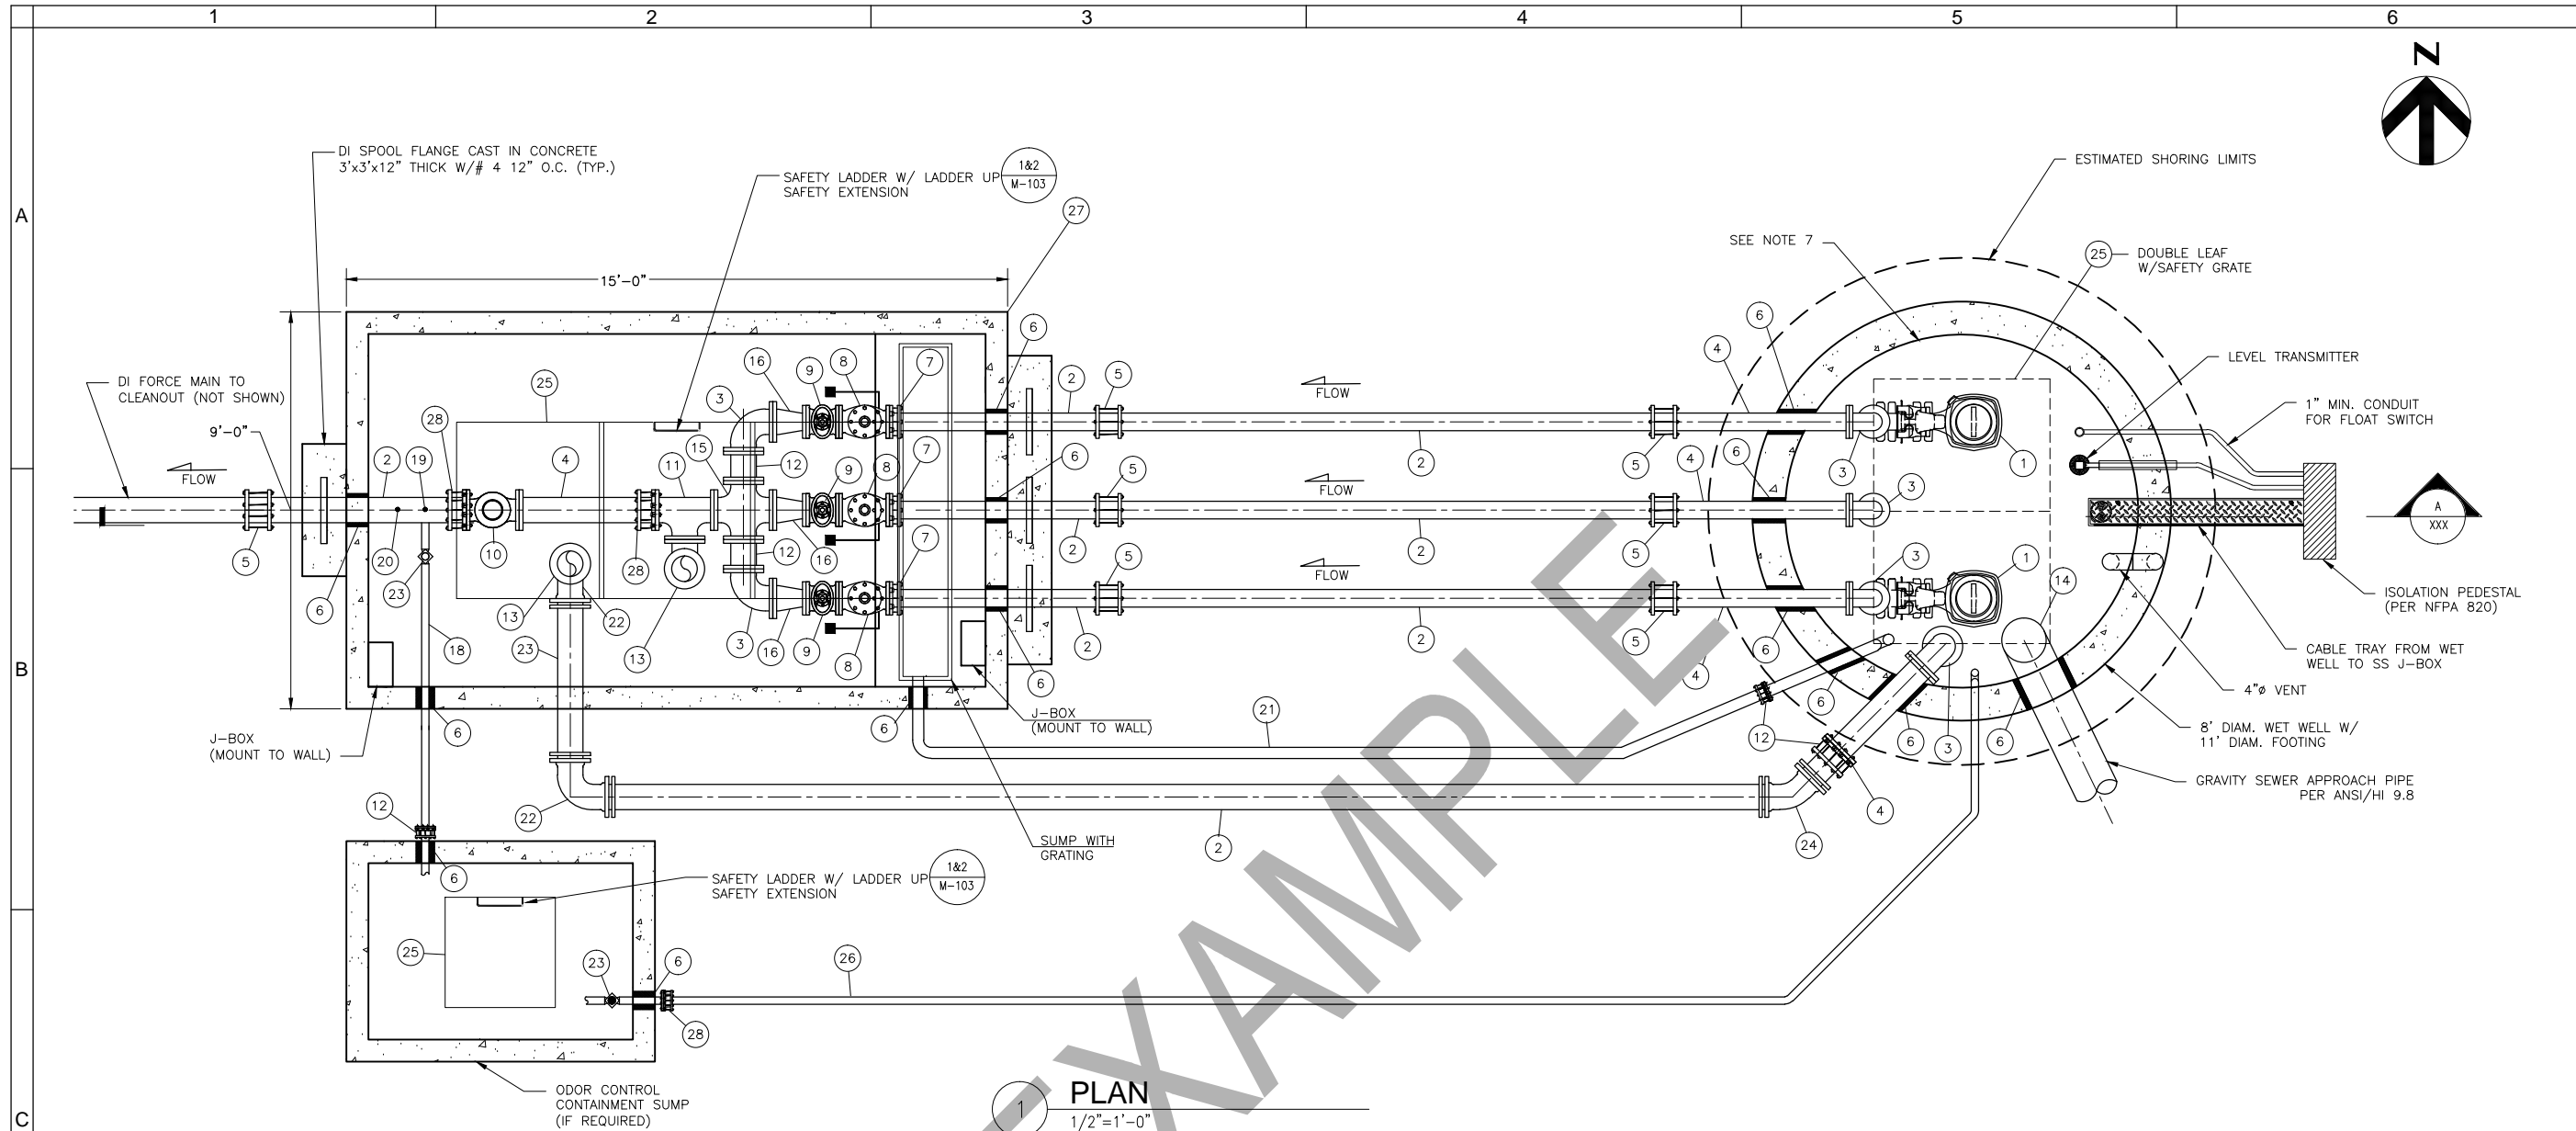

1 PLAN
1/2"=1'-0"

KEY NOTES:

- | | |
|---|--|
| 1 SUBMERSIBLE PUMPS, NOTE 6 | 17 NOT USED THIS SHEET |
| 2 DUCTILE IRON, PLAIN END | 18 PIPE FOR FUTURE ODOR CONTROL CHEMICAL FEED PENETRATION WITH CAP, NOTE 5 |
| 3 DUCTILE IRON 90° BEND, FL | 19 TAPPING SADDLE WITH 1" BALL VALVE |
| 4 DUCTILE IRON PIPE, FLANGE X PLAIN END | 20 PRESSURE TRANSMITTER ASSEMBLY WITH SADDLE TAP |
| 5 FLEXIBLE COUPLING | 21 PVC SDR 35 DRAIN LINE |
| 6 LINK SEAL | 22 90° BEND, MJ |
| 7 DISMANTLING JOINT | 23 ISOLATION BALL VALVE IN VALVE BOX |
| 8 SWING CHECK VALVE W/ SPRING AND LEVER, FLANGED | 24 45° BEND, MJ |
| 9 PLUG VALVE, FLANGED | 25 ALUMINUM, H2O LOAD RATED ACCESS HATCH |
| 10 FLOW METER, FLANGED | 26 4" DUCTILE IRON DRAIN LINE |
| 11 TEE, FLANGED | 27 PRECAST VALVE VAULT, SEE NOTE 1 |
| 12 PROVIDE FLANGED COUPLING ADAPTER FOR DIFFERENTIAL SETTLEMENT | 28 FLANGED COUPLING ADAPTER |
| 13 PUMPER PORT WITH ALUMINUM CAM LOCK FITTINGS (2 TYP.) MALE W/ CAP | |
| 14 DOWN TURNED TEE | |
| 15 CROSS, FLANGED | |
| 16 REDUCER, FLANGED | |

GENERAL NOTES:

- VALVE VAULT SHALL BE PRECAST. (4' MAX DEPTH RIM TO FLOOR)
- ALL PIPE AND FITTINGS IN WETWELL SHALL BE DUCTILE IRON CLASS 52 WITH FLANGED JOINTS AND EPOXY COATED.
- ALL PENETRATIONS SHALL BE CORE DRILLED AND SECURED/SEALED WITH LINK SEAL.
- ALL HARDWARE AND FASTENERS TO BE 316 STAINLESS STEEL.
- CITY OF BEND RESERVES THE RIGHT TO REQUIRE ODOR CONTROL SECONDARY CONTAINMENT SUMP AND ODOR CONTROL CHEMICAL FEED BASED ON LOCAL SITE REQUIREMENTS.
- SUBMERSIBLE PUMPS TO BE FLYGT WITH WITH N-IMPELLER OR APPROVED EQUAL. SEE G-008 FOR ADDITIONAL DESIGN DETAIL INFORMATION.
- PROVIDE THERMOPLASTIC LINER SYSTEM PER CITY STANDARDS SPECIFICATION SECTION 44 42 73.01, PREDL SYSTEMS, OR EQUAL.
- CONTRACTOR TO INSTALL SST GUIDE RAILS AND PUMP DISCHARGE PIPING FOR FUTURE THIRD PUMP.
- BYPASS SUCTION END OF PIPE TO BE 2'-0" BELOW GRAVITY APPROACH SEWER INVERT.
- ALL PIPE AND FITTING SIZES TO BE DETERMINED BASED ON SITE SPECIFIC REQUIREMENTS.

FOR SAMPLE ONLY

RECORD DRAWINGS

DESIGNED BY: _____ DATE: XX/XX/XX
 DRAWN BY: _____
 SCALE: _____
 FILE: _____
 DATE: _____

0 1" BAR EQUALS ONE INCH ON ORIGINAL DRAWING

SHEET: **M-101**

COB # (XXXXXX)

FOR SEALS AND SIGNATURES

(PROJECT NAME)
MECHANICAL
LIFT STATION MECHANICAL PLAN
DESCHUTES COUNTY, OREGON



REVISIONS:


(CONSULTANT ENGINEER NAME, ADDRESS & PHONE NUMBER)

DESIGNED BY: _____
DRAWN BY: _____
SCALE: _____
FILE: _____
DATE: _____

VERIFY SCALES
0 1" BAR EQUALS ONE INCH ON ORIGINAL DRAWING

SHEET: **M-101**

COB # (XXXXXX)

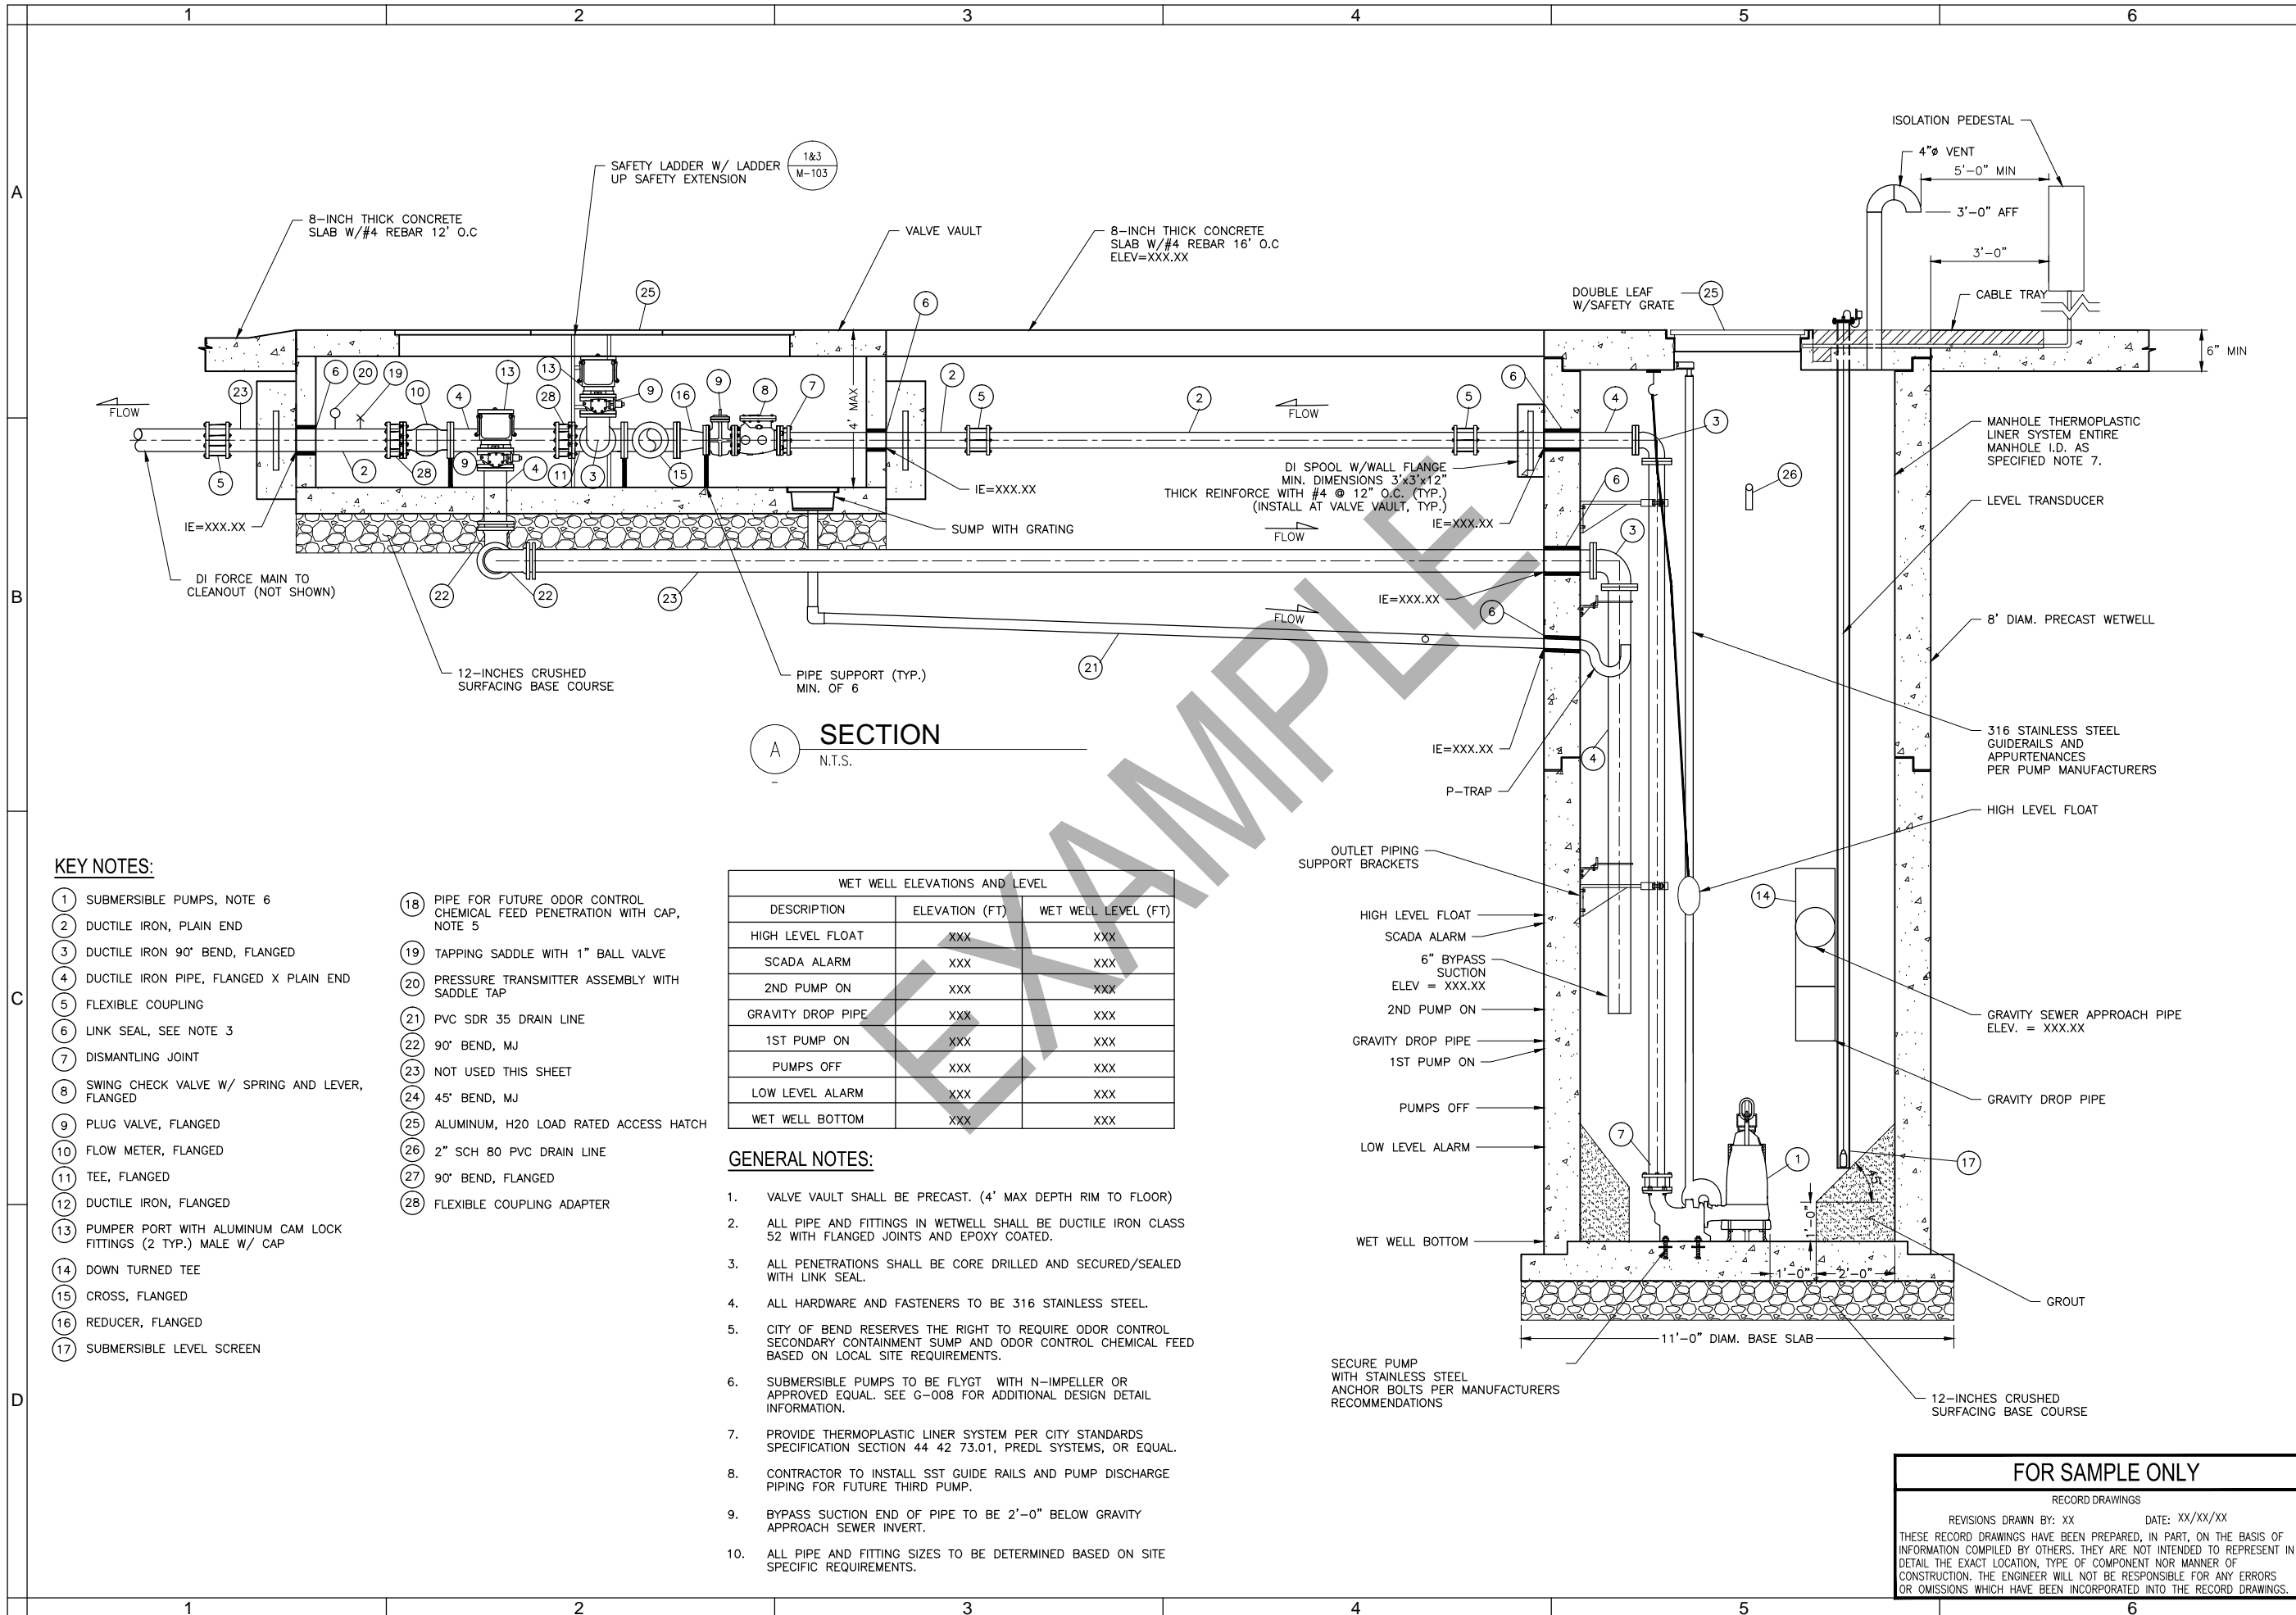

SECTION
N.T.S.

KEY NOTES:

- 1 SUBMERSIBLE PUMPS, NOTE 6
- 2 DUCTILE IRON, PLAIN END
- 3 DUCTILE IRON 90° BEND, FLANGED
- 4 DUCTILE IRON PIPE, FLANGED X PLAIN END
- 5 FLEXIBLE COUPLING
- 6 LINK SEAL, SEE NOTE 3
- 7 DISMANTLING JOINT
- 8 SWING CHECK VALVE W/ SPRING AND LEVER, FLANGED
- 9 PLUG VALVE, FLANGED
- 10 FLOW METER, FLANGED
- 11 TEE, FLANGED
- 12 DUCTILE IRON, FLANGED
- 13 PUMPER PORT WITH ALUMINUM CAM LOCK FITTINGS (2 TYP.) MALE W/ CAP
- 14 DOWN TURNED TEE
- 15 CROSS, FLANGED
- 16 REDUCER, FLANGED
- 17 SUBMERSIBLE LEVEL SCREEN
- 18 PIPE FOR FUTURE ODOR CONTROL CHEMICAL FEED PENETRATION WITH CAP, NOTE 5
- 19 TAPPING SADDLE WITH 1" BALL VALVE
- 20 PRESSURE TRANSMITTER ASSEMBLY WITH SADDLE TAP
- 21 PVC SDR 35 DRAIN LINE
- 22 90° BEND, MJ
- 23 NOT USED THIS SHEET
- 24 45° BEND, MJ
- 25 ALUMINUM, H2O LOAD RATED ACCESS HATCH
- 26 2" SCH 80 PVC DRAIN LINE
- 27 90° BEND, FLANGED
- 28 FLEXIBLE COUPLING ADAPTER

WET WELL ELEVATIONS AND LEVEL		
DESCRIPTION	ELEVATION (FT)	WET WELL LEVEL (FT)
HIGH LEVEL FLOAT	XXX	XXX
SCADA ALARM	XXX	XXX
2ND PUMP ON	XXX	XXX
GRAVITY DROP PIPE	XXX	XXX
1ST PUMP ON	XXX	XXX
PUMPS OFF	XXX	XXX
LOW LEVEL ALARM	XXX	XXX
WET WELL BOTTOM	XXX	XXX

GENERAL NOTES:

1. VALVE VAULT SHALL BE PRECAST. (4' MAX DEPTH RIM TO FLOOR)
2. ALL PIPE AND FITTINGS IN WETWELL SHALL BE DUCTILE IRON CLASS 52 WITH FLANGED JOINTS AND EPOXY COATED.
3. ALL PENETRATIONS SHALL BE CORE DRILLED AND SECURED/SEALED WITH LINK SEAL.
4. ALL HARDWARE AND FASTENERS TO BE 316 STAINLESS STEEL.
5. CITY OF BEND RESERVES THE RIGHT TO REQUIRE ODOR CONTROL SECONDARY CONTAINMENT SUMP AND ODOR CONTROL CHEMICAL FEED BASED ON LOCAL SITE REQUIREMENTS.
6. SUBMERSIBLE PUMPS TO BE FLYGT WITH N-IMPELLER OR APPROVED EQUAL. SEE G-008 FOR ADDITIONAL DESIGN DETAIL INFORMATION.
7. PROVIDE THERMOPLASTIC LINER SYSTEM PER CITY STANDARDS SPECIFICATION SECTION 44 42 73.01, PREDL SYSTEMS, OR EQUAL.
8. CONTRACTOR TO INSTALL SST GUIDE RAILS AND PUMP DISCHARGE PIPING FOR FUTURE THIRD PUMP.
9. BYPASS SUCTION END OF PIPE TO BE 2'-0" BELOW GRAVITY APPROACH SEWER INVERT.
10. ALL PIPE AND FITTING SIZES TO BE DETERMINED BASED ON SITE SPECIFIC REQUIREMENTS.

FOR SEALS AND SIGNATURES

(PROJECT NAME)
MECHANICAL
LIFT STATION MECHANICAL SECTION
DESCHUTES COUNTY, OREGON



REVISIONS:

(CONSULTANT ENGINEER NAME, ADDRESS & PHONE NUMBER)

DESIGNED BY:
DRAWN BY:
SCALE:
FILE:
DATE:



VERIFY SCALES
0 1" BAR EQUALS ONE INCH ON ORIGINAL DRAWING

SHEET: **M-102**

COB # (XXXXXX)


FOR SAMPLE ONLY
RECORD DRAWINGS
REVISIONS DRAWN BY: XX DATE: XX/XX/XX
THESE RECORD DRAWINGS HAVE BEEN PREPARED, IN PART, ON THE BASIS OF INFORMATION COMPILED BY OTHERS. THEY ARE NOT INTENDED TO REPRESENT IN DETAIL THE EXACT LOCATION, TYPE OF COMPONENT NOR MANNER OF CONSTRUCTION. THE ENGINEER WILL NOT BE RESPONSIBLE FOR ANY ERRORS OR OMISSIONS WHICH HAVE BEEN INCORPORATED INTO THE RECORD DRAWINGS.

CLAMP BRACKET MAY BE REVERSED TO ACCOMMODATE RUNG SIZES OF 3/4" TO 1-1/4" WITH STANDARD 2" BOLTS FURNISHED. LARGER RUNGS WILL REQUIRE LONGER BOLTS.

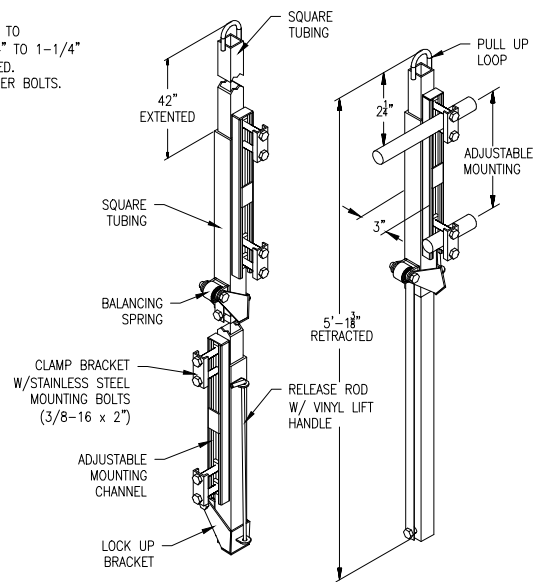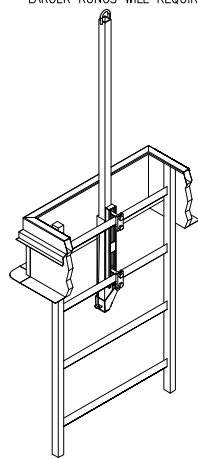


NOTES:
1. LADDER UP SAFETY EXTENSION SHALL BE STAINLESS STEEL

1 LADDER UP SAFETY EXTENSION
N.T.S.

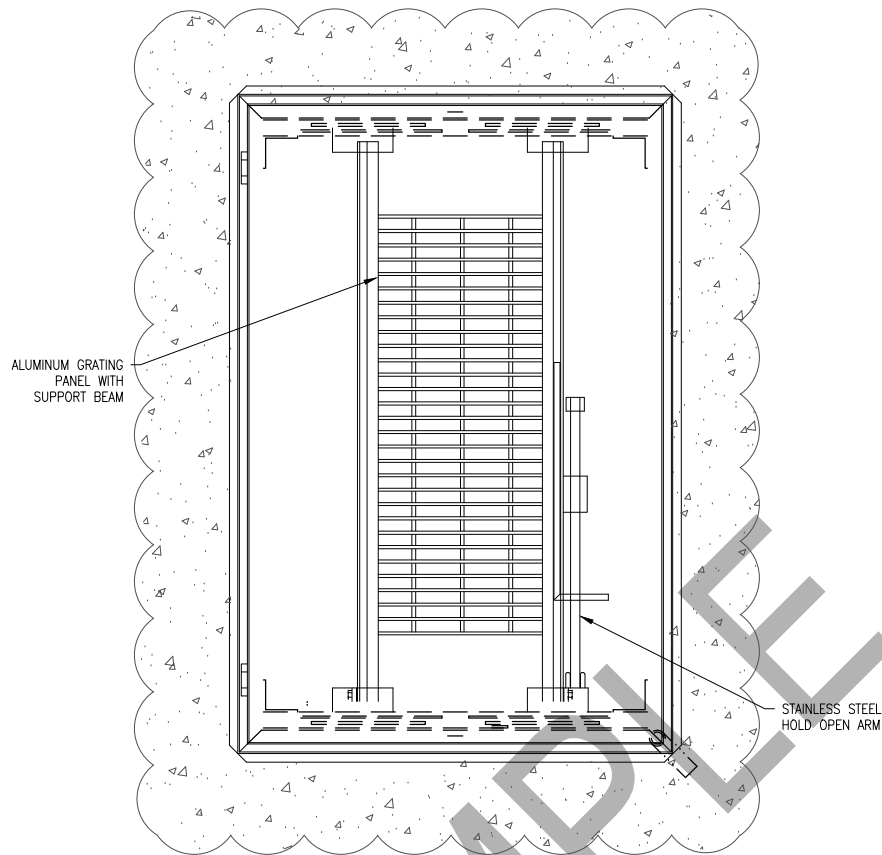


2 SAFETY GRATE DETAIL
N.T.S.


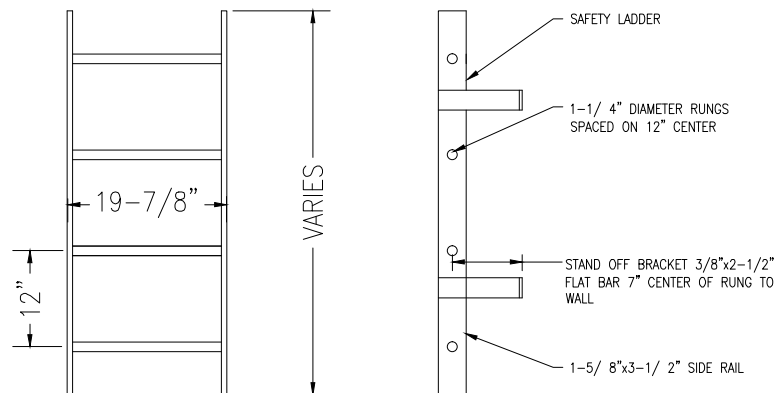


NOTES:
1. RUNGS SHOULD BE NONSKID.

3 LADDER DETAIL
N.T.S.

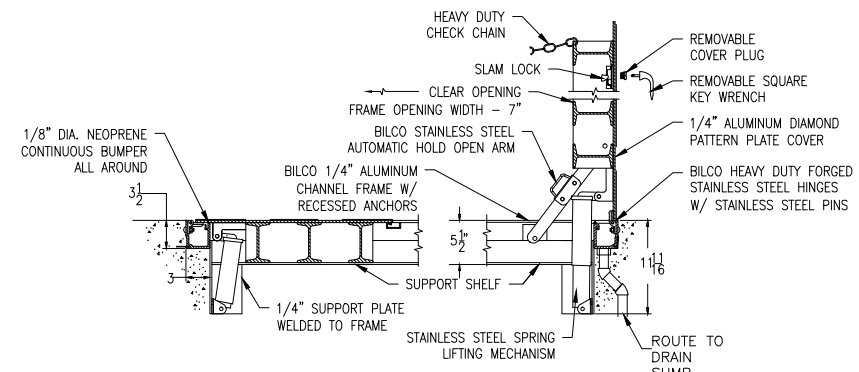

A SECTION
N.T.S.

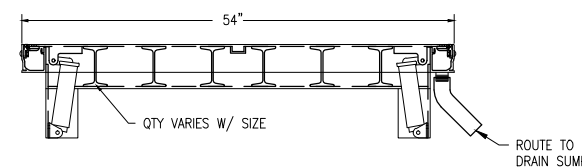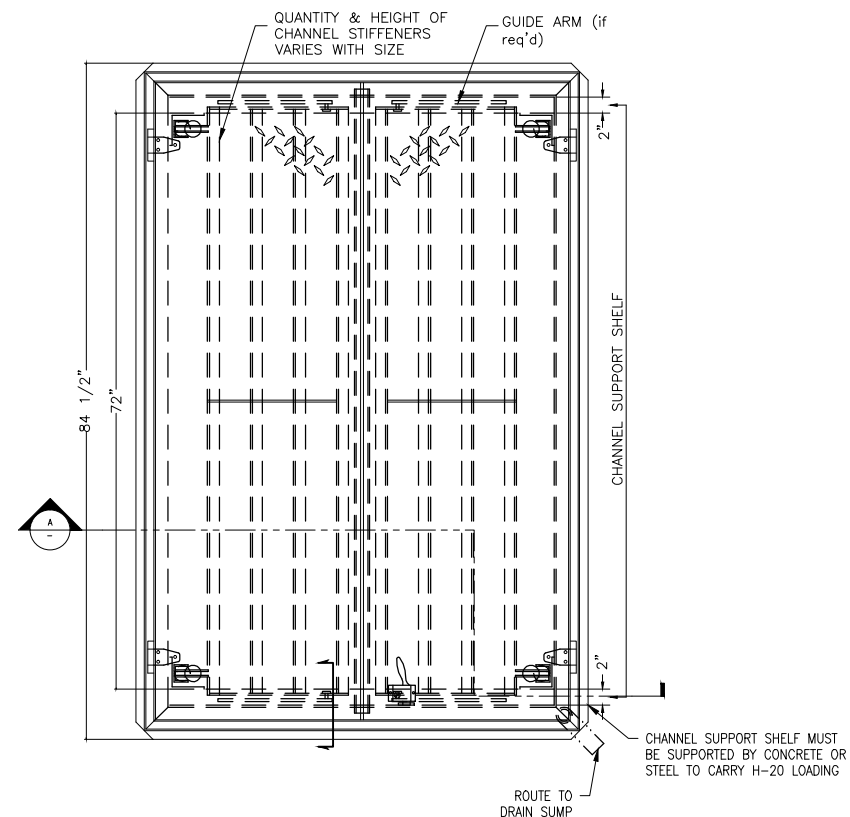

4 ACCESS DOOR DETAIL
N.T.S.

NOTES:
1. ALL ACCESS DOORS AND HATCHES TO BE H-20 RATED.

FOR SAMPLE ONLY
RECORD DRAWINGS
DESIGNED BY: _____ DATE: XX/XX/XX
DRAWN BY: _____ REVISIONS DRAWN BY: XX
SCALE: _____ FILE: _____
DATE: _____

THESE RECORD DRAWINGS HAVE BEEN PREPARED, IN PART, ON THE BASIS OF INFORMATION COMPILED BY OTHERS. THEY ARE NOT INTENDED TO REPRESENT IN DETAIL THE EXACT LOCATION, TYPE OF COMPONENT NOR MANNER OF CONSTRUCTION. THE ENGINEER WILL NOT BE RESPONSIBLE FOR ANY ERRORS OR OMISSIONS WHICH HAVE BEEN INCORPORATED INTO THE RECORD DRAWINGS.

FOR SEALS AND SIGNATURES

(PROJECT NAME)
MECHANICAL
MECHANICAL DETAILS
DESCHUTES COUNTY, OREGON



REVISIONS:


(CONSULTANT ENGINEER NAME, ADDRESS & PHONE NUMBER)

DESIGNED BY: _____
DRAWN BY: _____
SCALE: _____
FILE: _____
DATE: _____

VERIFY SCALES
0 1"
BAR EQUALS ONE INCH ON ORIGINAL DRAWING


SHEET: M-103

COB # (XXXXXX)

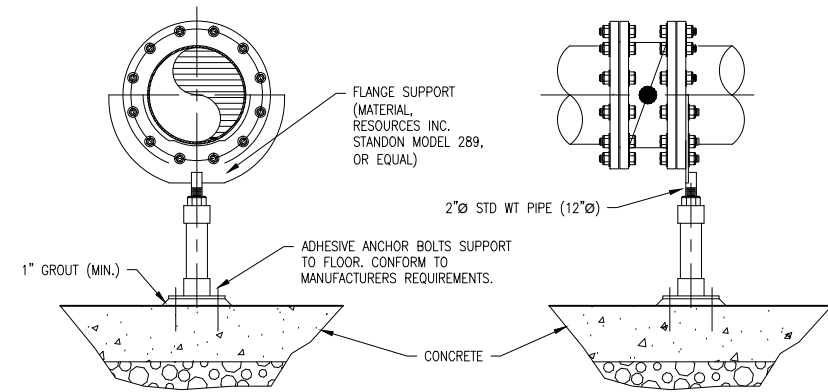


NOTE:
1. WELD TO RESIST UPLIFT PER MFR. RECOMMENDATIONS

5 **PIPE SUPPORT**
N.T.S.

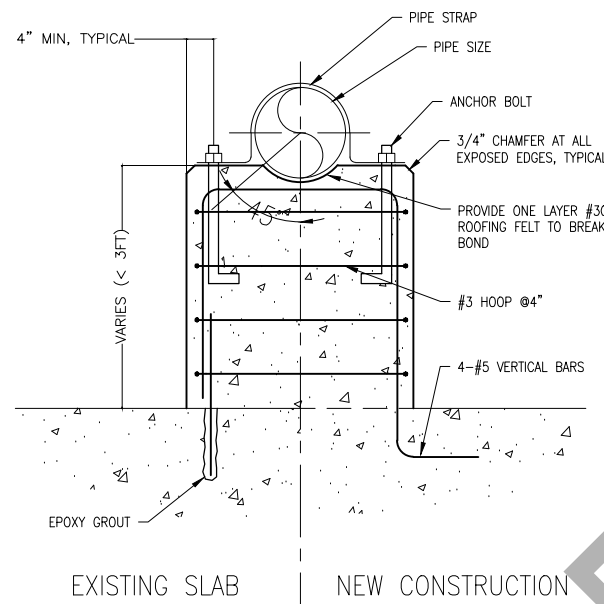


PIPE SIZE, DIA	PIPE STRAP	ANCHOR BOLTS, DIA	PEDESTAL THICKNESS
6"-12"	1/4"x2"	1/2"	12"

6 **CONCRETE PEDESTAL SUPPORT**
N.T.S.

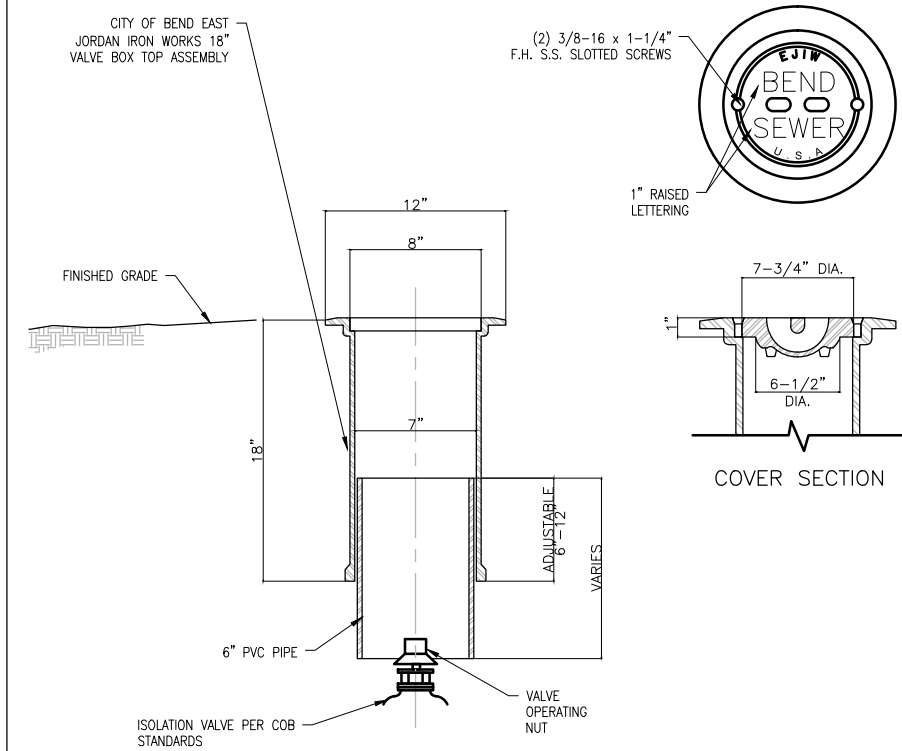

7 **VALVE BOX**
N.T.S.

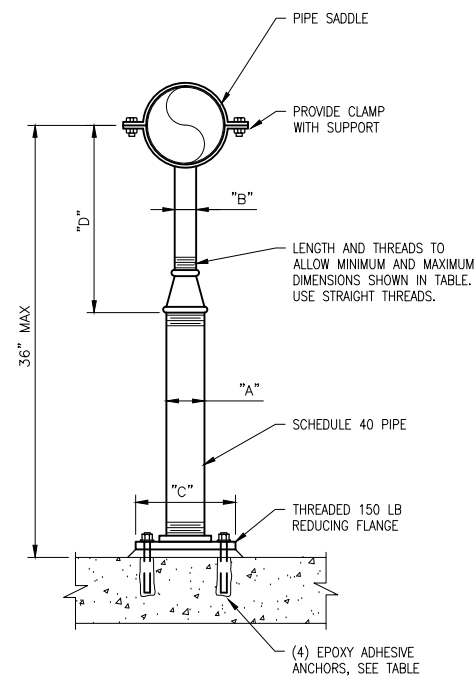

PIPE SIZE	FLOOR PIPE SUPPORT SCHEDULE DIMENSIONS IN INCHES							
	"A"	"B"	"C"	"D"		ANCHORS		
				MINIMUM	MAXIMUM	DIA	EMBED	
≤ 2 1/2	2 1/2	1 1/2	9	8	13	5/8	5	
3	2 1/2	1 1/2	9	8 1/2	13 1/2	5/8	5	
3 1/2	2 1/2	1 1/2	9	8 1/2	13 1/2	5/8	5	
4	3	2 1/2	9	9 1/2	14	5/8	5	
6	3	2 1/2	9	10 1/2	15 1/2	5/8	5	
8	3	2 1/2	9	11 1/2	16 1/2	5/8	5	
10	3	2 1/2	9	13 1/2	18 1/2	5/8	5	
12	3	2 1/2	9	15	19 1/2	5/8	5	

8 **FLOOR PIPE SUPPORT**
N.T.S.

FOR SEALS AND SIGNATURES

(PROJECT NAME)
MECHANICAL
MECHANICAL DETAILS
DESCHUTES COUNTY, OREGON



REVISIONS:


(CONSULTANT ENGINEER NAME, ADDRESS & PHONE NUMBER)

DESIGNED BY:
DRAWN BY:
SCALE:
FILE:
DATE:

VERIFY SCALES
0 1"
BAR EQUALS ONE INCH ON ORIGINAL DRAWING

SHEET:
M-104
COB # (XXXXXX)

FOR SAMPLE ONLY
RECORD DRAWINGS
REVISIONS DRAWN BY: XX DATE: XX/XX/XX
THESE RECORD DRAWINGS HAVE BEEN PREPARED, IN PART, ON THE BASIS OF INFORMATION COMPILED BY OTHERS. THEY ARE NOT INTENDED TO REPRESENT IN DETAIL THE EXACT LOCATION, TYPE OF COMPONENT NOR MANNER OF CONSTRUCTION. THE ENGINEER WILL NOT BE RESPONSIBLE FOR ANY ERRORS OR OMISSIONS WHICH HAVE BEEN INCORPORATED INTO THE RECORD DRAWINGS.

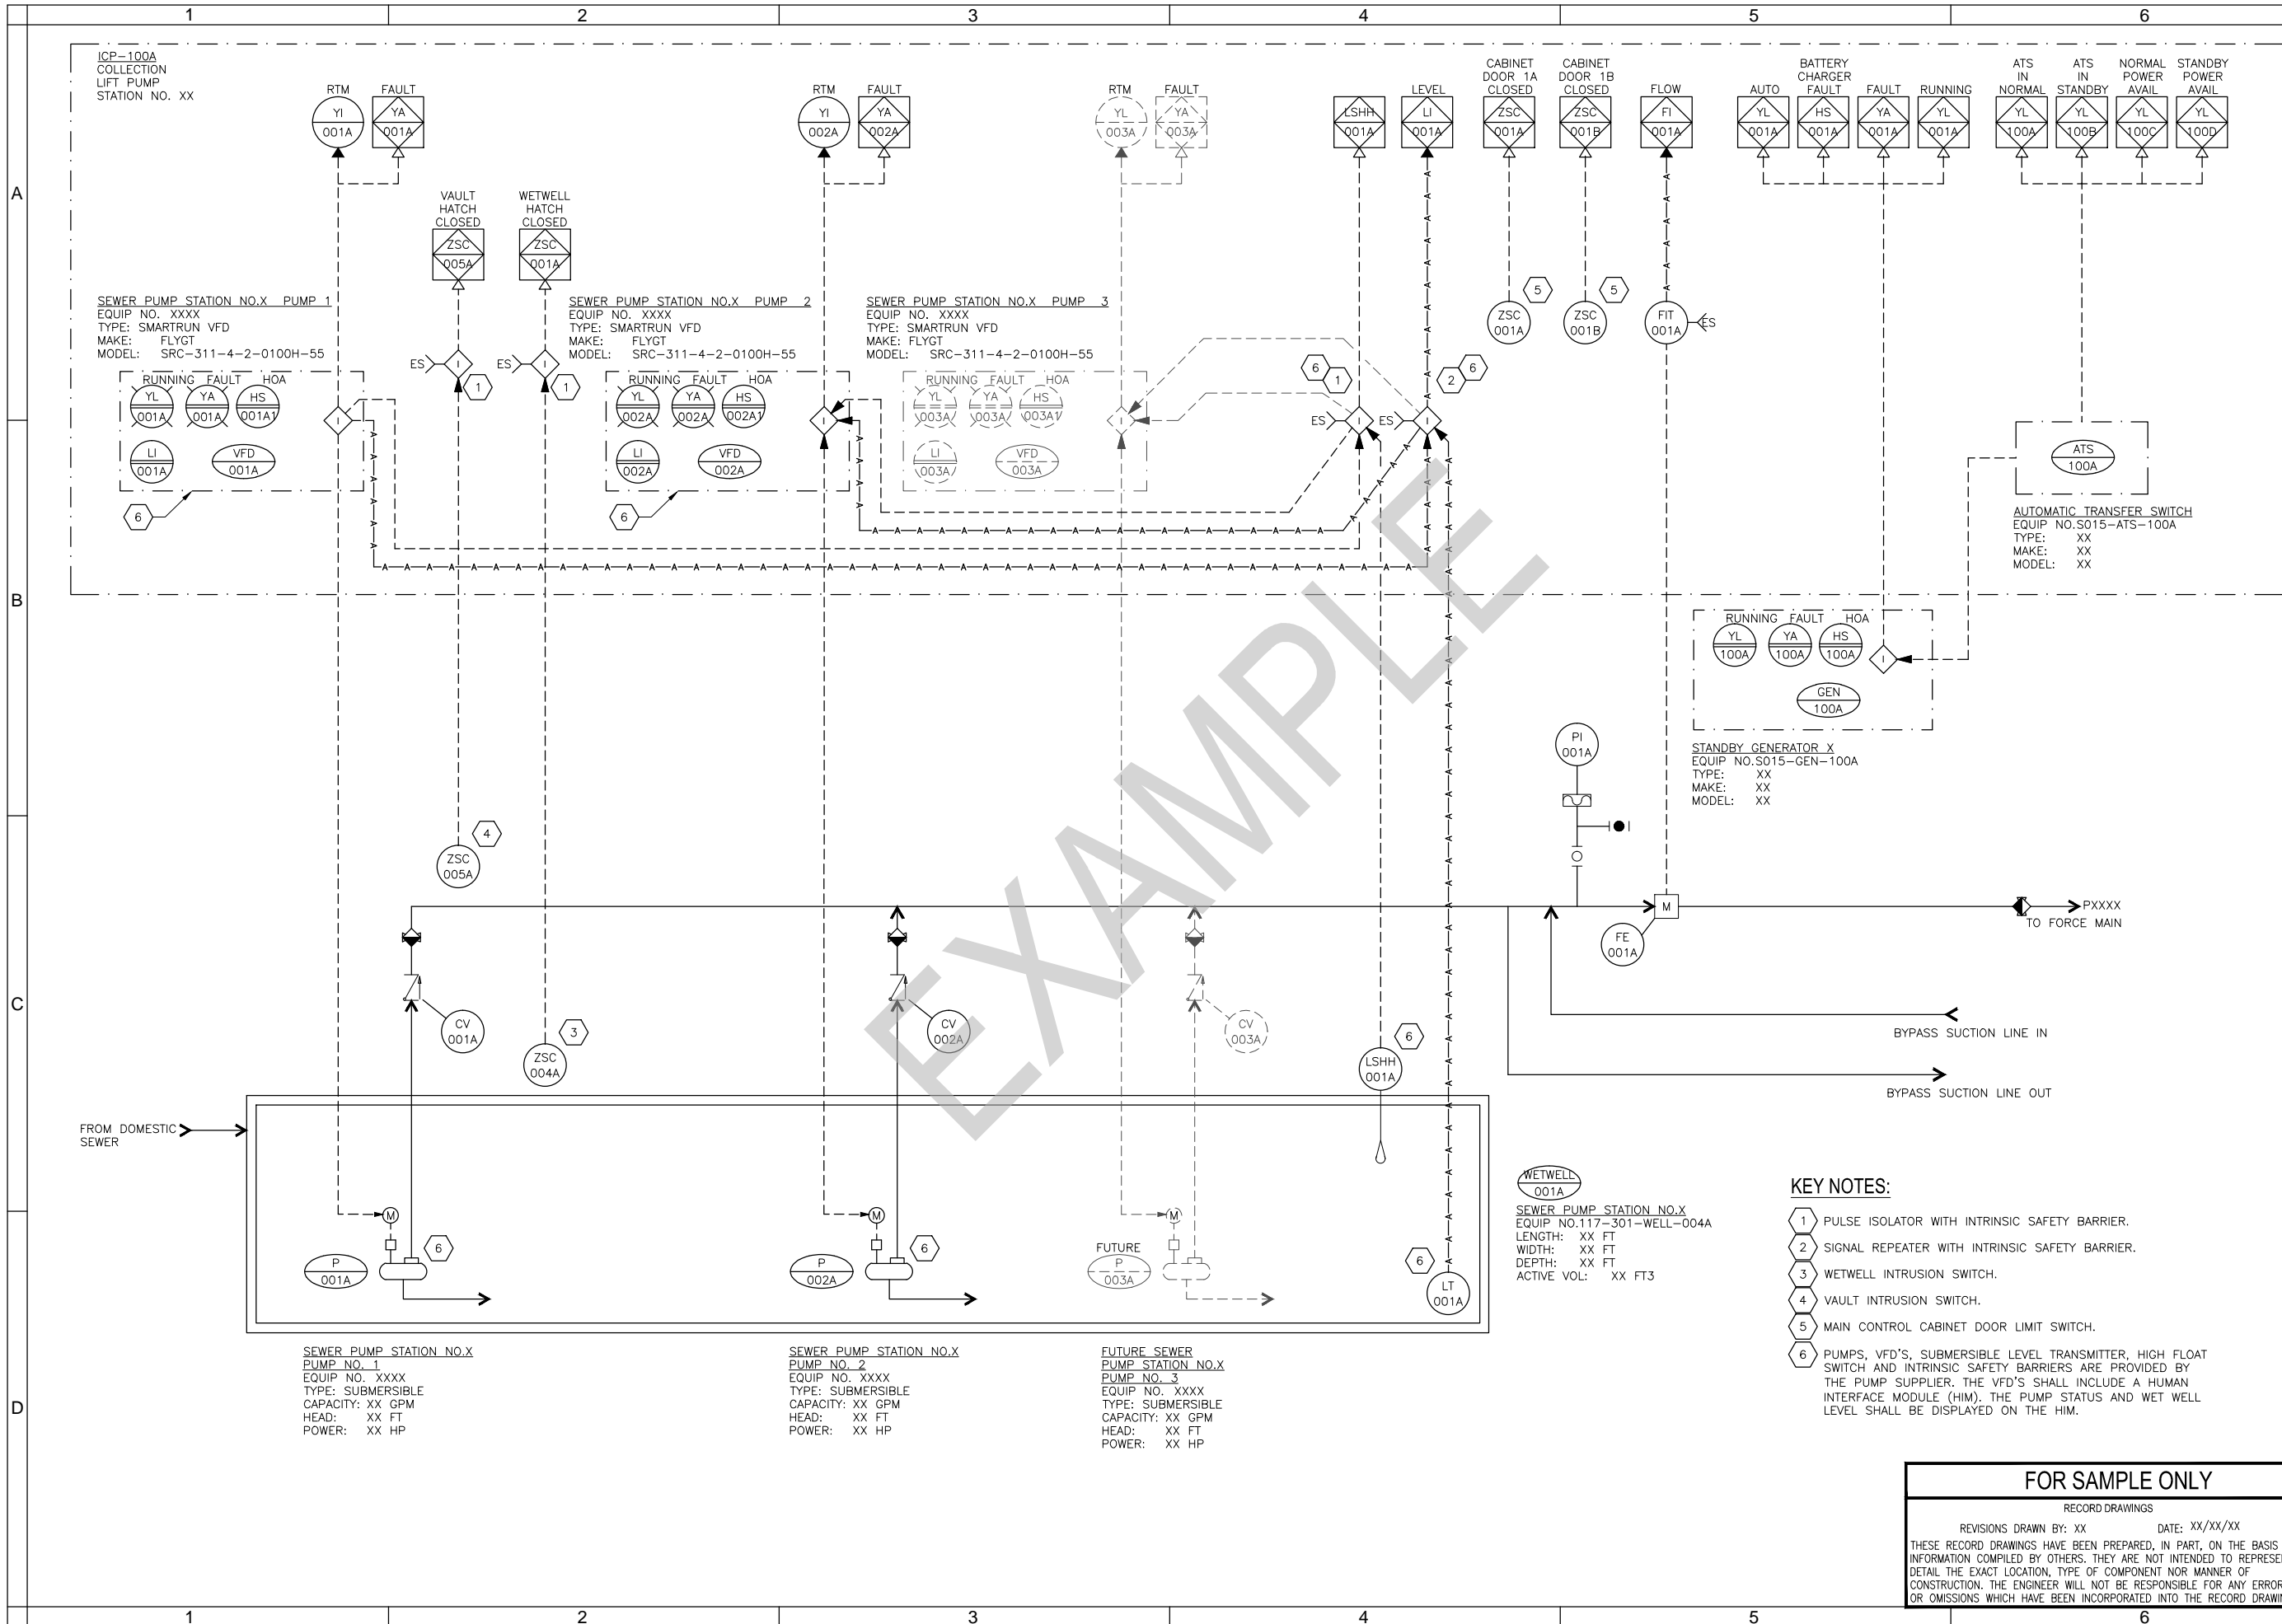

FOR SEALS AND SIGNATURES

(PROJECT NAME)
INSTRUMENTATION & CONTROLS
 STANDARD P&ID CONSTANT
 DESCHUTES COUNTY, OREGON



REVISIONS:

(CONSULTANT ENGINEER NAME, ADDRESS & PHONE & NUMBER)


DESIGNED BY: XXX
 DRAWN BY: XXX
 SCALE: NONE
 FILE: I-001.dwg
 DATE: _____

VERIFY SCALES
 0 1" BAR EQUALS ONE INCH ON ORIGINAL DRAWING


SHEET: **I-001**
 COB# (XXXXXX)

- KEY NOTES:**
- 1 PULSE ISOLATOR WITH INTRINSIC SAFETY BARRIER.
 - 2 SIGNAL REPEATER WITH INTRINSIC SAFETY BARRIER.
 - 3 WETWELL INTRUSION SWITCH.
 - 4 VAULT INTRUSION SWITCH.
 - 5 MAIN CONTROL CABINET DOOR LIMIT SWITCH.
 - 6 PUMPS, VFD'S, SUBMERSIBLE LEVEL TRANSMITTER, HIGH FLOAT SWITCH AND INTRINSIC SAFETY BARRIERS ARE PROVIDED BY THE PUMP SUPPLIER. THE VFD'S SHALL INCLUDE A HUMAN INTERFACE MODULE (HIM). THE PUMP STATUS AND WET WELL LEVEL SHALL BE DISPLAYED ON THE HIM.

FOR SAMPLE ONLY
 RECORD DRAWINGS
 REVISIONS DRAWN BY: XX DATE: XX/XX/XX
 THESE RECORD DRAWINGS HAVE BEEN PREPARED, IN PART, ON THE BASIS OF INFORMATION COMPILED BY OTHERS. THEY ARE NOT INTENDED TO REPRESENT IN DETAIL THE EXACT LOCATION, TYPE OF COMPONENT NOR MANNER OF CONSTRUCTION. THE ENGINEER WILL NOT BE RESPONSIBLE FOR ANY ERRORS OR OMISSIONS WHICH HAVE BEEN INCORPORATED INTO THE RECORD DRAWINGS.

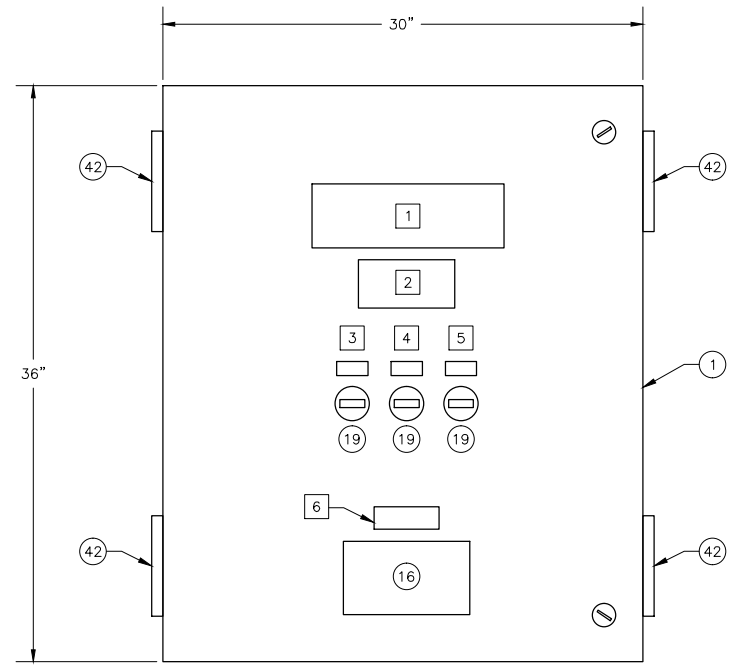

EXTERIOR FRONT ELEVATION

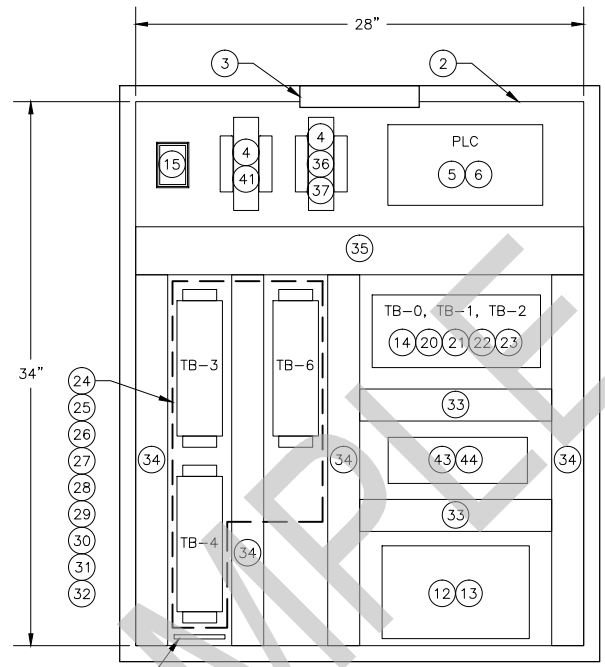

INTERIOR ELEVATION

1
N.T.S.
**CONTROL PANEL
PANEL LAYOUT ELEVATION**

GENERAL NOTES:

- PANEL CONSTRUCTION PER NEC 2014, UL 508A REQUIREMENTS, FOLLOW NFPA 79 WHERE APPLICABLE.
- PANEL WIRING EXCEPT WHERE OTHER SPECIFIED:
 - SINGLE WIRES SHALL BE THHN 16AWG, EXCEPT WHERE INTENDED FOR POWER OR MOTOR CIRCUITS WHICH SHALL BE 12AWG, MIN.
 - COLOR CODE SHALL FOLLOW UL 508A.
 - TWISTED PAIR ANALOG SIGNAL CABLE SHALL BE BELDEN 8760 OR EQUAL.
 - EACH WIRE SHALL BE IDENTIFIED WITH A PERMANENT WIRE LABEL, P/N BRADY LAT-18-361.
- PANEL FABRICATOR SHALL PROVIDE ENGRAVED NAMEPLATES AS INDICATED AND LOCATED ON THIS DRAWING. REFERENCE OWNER'S ELECTRICAL SPECIFICATIONS FOR MATERIAL, FABRICATION, AND INSTALLATION DETAILS.
- PANEL FABRICATOR TO LABEL ALL FUSES, TERMINAL BLOCKS, CIRCUIT BREAKERS WITH DEVICE DESIGNATION OR WIRE NUMBER AS SHOWN USING MANUFACTURER APPROPRIATE LABELING SYSTEM.
- CONTROL PANEL SHALL NOT BE FABRICATED WITH A FALSE FRONT.
- PROVIDE A MINIMUM OF 10% AVAILABLE TERMINAL BLOCKS.
- PANEL LAYOUT SHALL RESERVE SPACE TO ADD A MINIMUM OF TWO PLC EXPANSION MODULES.

LEGEND:

- [X] INDICATES BILL OF MATERIALS (BOM) ITEM; REFERENCE SHEET I-003
- (X) INDICATES NAMEPLATE ITEM; REFERENCE SHEET I-003

FOR SEALS
AND SIGNATURES

(PROJECT NAME)
CONTROL PANEL TYPE B
TEMPLATE (50 I/Os) PANEL LAYOUT
DESCHUTES COUNTY, OREGON



REVISIONS:

(CONSULTANT
ENGINEER
NAME, ADDRESS
& PHONE
NUMBER)

DESIGNED BY: XXX
DRAWN BY: XXX
SCALE: NONE
FILE: I-002.dwg
DATE:

VERIFY SCALES
0 1"
BAR EQUALS ONE INCH
ON ORIGINAL DRAWING

FOR SAMPLE ONLY
RECORD DRAWINGS
REVISIONS DRAWN BY: XX DATE: XX/XX/XX
THESE RECORD DRAWINGS HAVE BEEN PREPARED, IN PART, ON THE BASIS OF INFORMATION COMPILED BY OTHERS. THEY ARE NOT INTENDED TO REPRESENT IN DETAIL THE EXACT LOCATION, TYPE OF COMPONENT NOR MANNER OF CONSTRUCTION. THE ENGINEER WILL NOT BE RESPONSIBLE FOR ANY ERRORS OR OMISSIONS WHICH HAVE BEEN INCORPORATED INTO THE RECORD DRAWINGS.

SHEET:
I-002
COB # (XXXXXX)

BILL OF MATERIALS					
ITEM	QTY	DESCRIPTION	MANUFACTURE	MODEL/CAT #	SUPPLIER
1	1	ENCLOSURE	HOFFMAN	CSD363010 OR APPROVED EQUAL	PF
2	1	BACK PANEL	HOFFMAN	CP3630	PF
3	1	LIGHTING KIT	HOFFMAN	ALF16D12R	PF
4	AR	MOUNTING ALUMINUM BRACKETS	SHOP SUPPLY	SHOP SUPPLY	PF
5	1	MICROLOGIX 1400 WITH ETHERNET PORT	ALLEN-BRADLEY	1766-L32BXB	PF
6	1	1762 AI MODULE	ALLEN-BRADLEY	1762-IF4	PF
7	-	-	-	-	-
8	-	-	-	-	-
9	-	-	-	-	-
10	-	-	-	-	-
11	-	-	-	-	-
12	1	24VDC POWER SUPPLY	PULS	QS10.241	PF
13	1	24VDC UPS WITH INTEGRATED BATTERY	PULS	UBC10-241	PF
14	2	15A CIRCUIT BREAKER	ALLEN-BRADLEY	1492-SP1C150	PF
15	1	SURGE SUPPRESSOR	CONTROL CONCEPTS	ISLATROL IE-120	PF
16	1	DATA INTERFACE PORT	HOFFMAN	HGF5CN	PF
17	-	-	-	-	-
18	-	-	-	-	-
19	3	ELECTROMECHANICAL HOUR METER	REDINGTON	732-0014	PF
20	AR	10A CB4200 SERIES CIRCUIT BREAKER	WEIDMULLER	910 190 3500	PF
21	AR	0.5A CB4200 SERIES CIRCUIT BREAKER	WEIDMULLER	910 100 3500	PF
22	AR	3A CB4200 SERIES CIRCUIT BREAKER	WEIDMULLER	910 170 3500	PF
23	AR	2A CB4200 SERIES CIRCUIT BREAKER	WEIDMULLER	910 150 3500	PF
24	AR	0.1A CB4200 SERIES CIRCUIT BREAKER	WEIDMULLER	910 417 3500	PF
25	AR	FEED THROUGH TERMINAL WDU 2.5 (BEIGE)	WEIDMULLER	-	PF
26	AR	FEED THROUGH TERMINAL WDU 2.5 BL (BLUE)	WEIDMULLER	-	PF
27	AR	GROUNDING TERMINAL WPE 2.5	WEIDMULLER	-	PF
28	AR	END PLATE WAP 2.5-10 (BEIGE)	WEIDMULLER	-	PF
29	AR	END PLATE WAP 2.5-10 BL (BLUE)	WEIDMULLER	-	PF
30	AR	PARTITION WTW EN (DARK BEIGE)	WEIDMULLER	-	PF
31	AR	END BRACKET WEW 35/2 (DARK BEIGE)	WEIDMULLER	-	PF
32	AR	ZINC PLATED YELLOW-CHROMATE STEEL T-35 DIN RAIL	SHOP SUPPLY	SHOP SUPPLY	PF
33	AR	1.5" W X 3" D WIREWAY W/ COVER	PANDUIT	F1.5X3LG6 & C1.5LG6	PF
34	AR	2" W X 3" D WIREWAY W/ COVER	PANDUIT	F2X3LG6 & C2LG6	PF
35	AR	3" W X 3" D WIREWAY W/ COVER	PANDUIT	F3X3LG6 & C3LG6	PF
36	1	8 PORT NETWORK SWITCH	SIXNET	SLX-BMS	PF
37	1	6FT CAT6 PATCH CABLE	SHOP SUPPLY	SHOP SUPPLY	PF
38	2	GROUND BUS	SHOP SUPPLY	SHOP SUPPLY	PF
39	-	-	-	-	-
40	-	-	-	-	-
41	1	LONG RANGE IP/ETHERNET RADIO	GE MDS	TO BE DETERMINED BY CITY STAFF	PF
42	4	LOUVER WITH FILTER	HOFFMAN	AVK44 / AFLT44	PF
43	1	4-POLE ICE CUBE RELAY / SOCKET	ALLEN-BRADLEY	700-HF34Z24-4 / 700-HN139	PF
44	5	2-POLE ICE CUBE RELAY / SOCKET	ALLEN-BRADLEY	700-HF32Z24-4 / 700-HN116	PF

NOTE: ALL MATERIALS SHOWN ARE THE MINIMUM REQUIREMENTS AND SHALL BE REVIEWED AND APPROVED BY THE CITY OF BEND DURING PRELIMINARY DESIGN

PF = PANEL FABRICATOR
COB = CITY OF BEND

NAMEPLATE SCHEDULE				
NAMEPLATE	LINE	NAMEPLATE	PLATE SIZE	LETTERING SIZE
1	1	LIFT STATION XX LOCAL CONTROL PANEL		1/2"
	2	WXXX-ICP-XXXX	4" X 10"	1"
	-	-	-	-
2	1	120VAC POWER		1/4"
	2	FROM PANELS	3" X 6"	1/4"
	3	XXXXXX & XXXXXX		1/4"
3	1	PUMP 1 RTM		3/16"
	-	-	1/2" X 1"	-
	-	-	-	-
4	1	PUMP 2 RTM		3/16"
	-	-	1/2" X 1"	-
	-	-	-	-
5	1	PUMP 3 RTM		3/16"
	-	-	1/2" X 1"	-
	-	-	-	-
6	1	PORTABLE PROGRAMMING		3/16"
	2	TERMINAL POWER	1" X 3"	3/16"
	3	ONLY		3/16"



(PROJECT NAME)
CNTR PNL TYPE B TEMPLATE
(50 I/Os) BILL OF MATERIALS
DESCHUTES COUNTY, OREGON



REVISIONS:


(CONSULTANT ENGINEER NAME, ADDRESS & PHONE NUMBER)

DESIGNED BY: XXX
DRAWN BY: XXX
SCALE: NONE
FILE: I-003.dwg
DATE:

VERIFY SCALES
0 1"
BAR EQUALS ONE INCH ON ORIGINAL DRAWING

SHEET:
I-003
COB # (XXXXXX)

FOR SAMPLE ONLY
RECORD DRAWINGS
REVISIONS DRAWN BY: XX DATE: XX/XX/XX
THESE RECORD DRAWINGS HAVE BEEN PREPARED, IN PART, ON THE BASIS OF INFORMATION COMPILED BY OTHERS. THEY ARE NOT INTENDED TO REPRESENT IN DETAIL THE EXACT LOCATION, TYPE OF COMPONENT NOR MANNER OF CONSTRUCTION. THE ENGINEER WILL NOT BE RESPONSIBLE FOR ANY ERRORS OR OMISSIONS WHICH HAVE BEEN INCORPORATED INTO THE RECORD DRAWINGS.

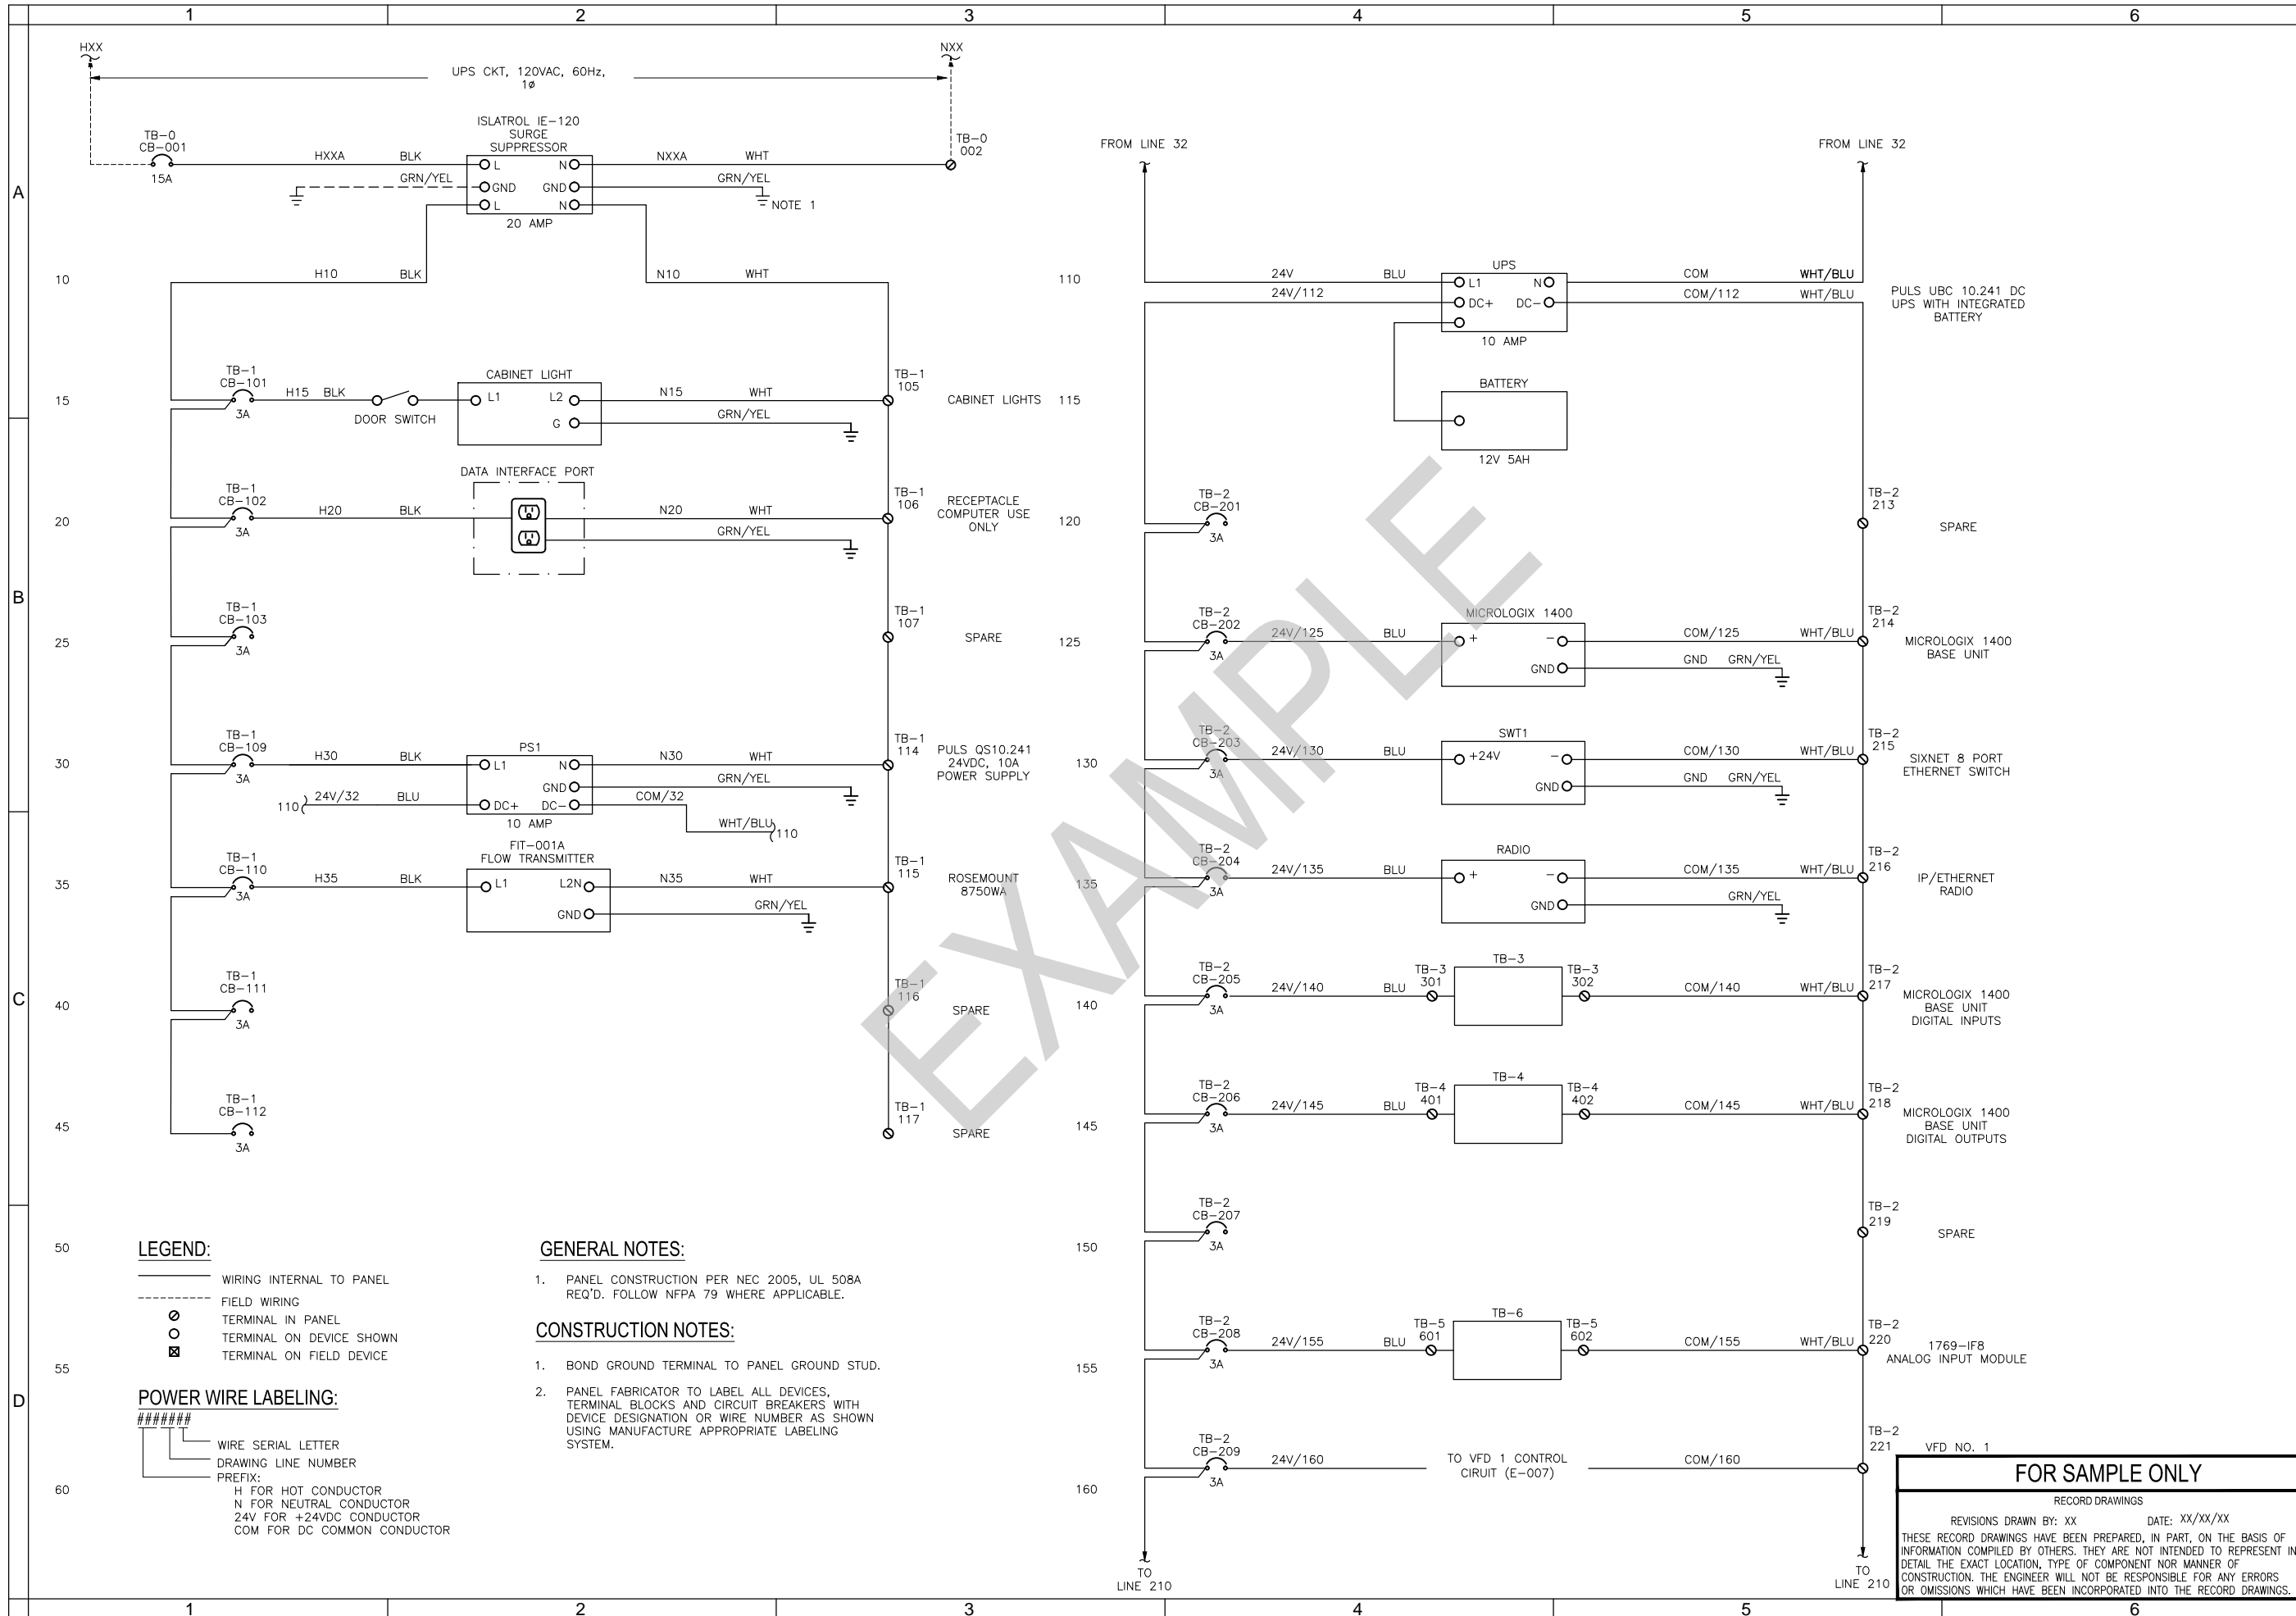

FOR SEALS AND SIGNATURES

(PROJECT NAME)
CNTR PNL TYPE B TEMPLATE
 (50 I/Os) PWR WIRING SCHEMATIC
 DESCHUTES COUNTY, OREGON



REVISIONS:


(CONSULTANT ENGINEER NAME, ADDRESS & PHONE NUMBER)

DESIGNED BY: XXX
 DRAWN BY: XXX
 SCALE: NONE
 FILE: I-004.dwg
 DATE: _____

VERIFY SCALES
 0 1" BAR EQUALS ONE INCH ON ORIGINAL DRAWING

SHEET: **I-004**
 COB # (XXXXXX)

FOR SAMPLE ONLY
 RECORD DRAWINGS
 REVISIONS DRAWN BY: XX DATE: XX/XX/XX
 THESE RECORD DRAWINGS HAVE BEEN PREPARED, IN PART, ON THE BASIS OF INFORMATION COMPILED BY OTHERS. THEY ARE NOT INTENDED TO REPRESENT IN DETAIL THE EXACT LOCATION, TYPE OF COMPONENT NOR MANNER OF CONSTRUCTION. THE ENGINEER WILL NOT BE RESPONSIBLE FOR ANY ERRORS OR OMISSIONS WHICH HAVE BEEN INCORPORATED INTO THE RECORD DRAWINGS.

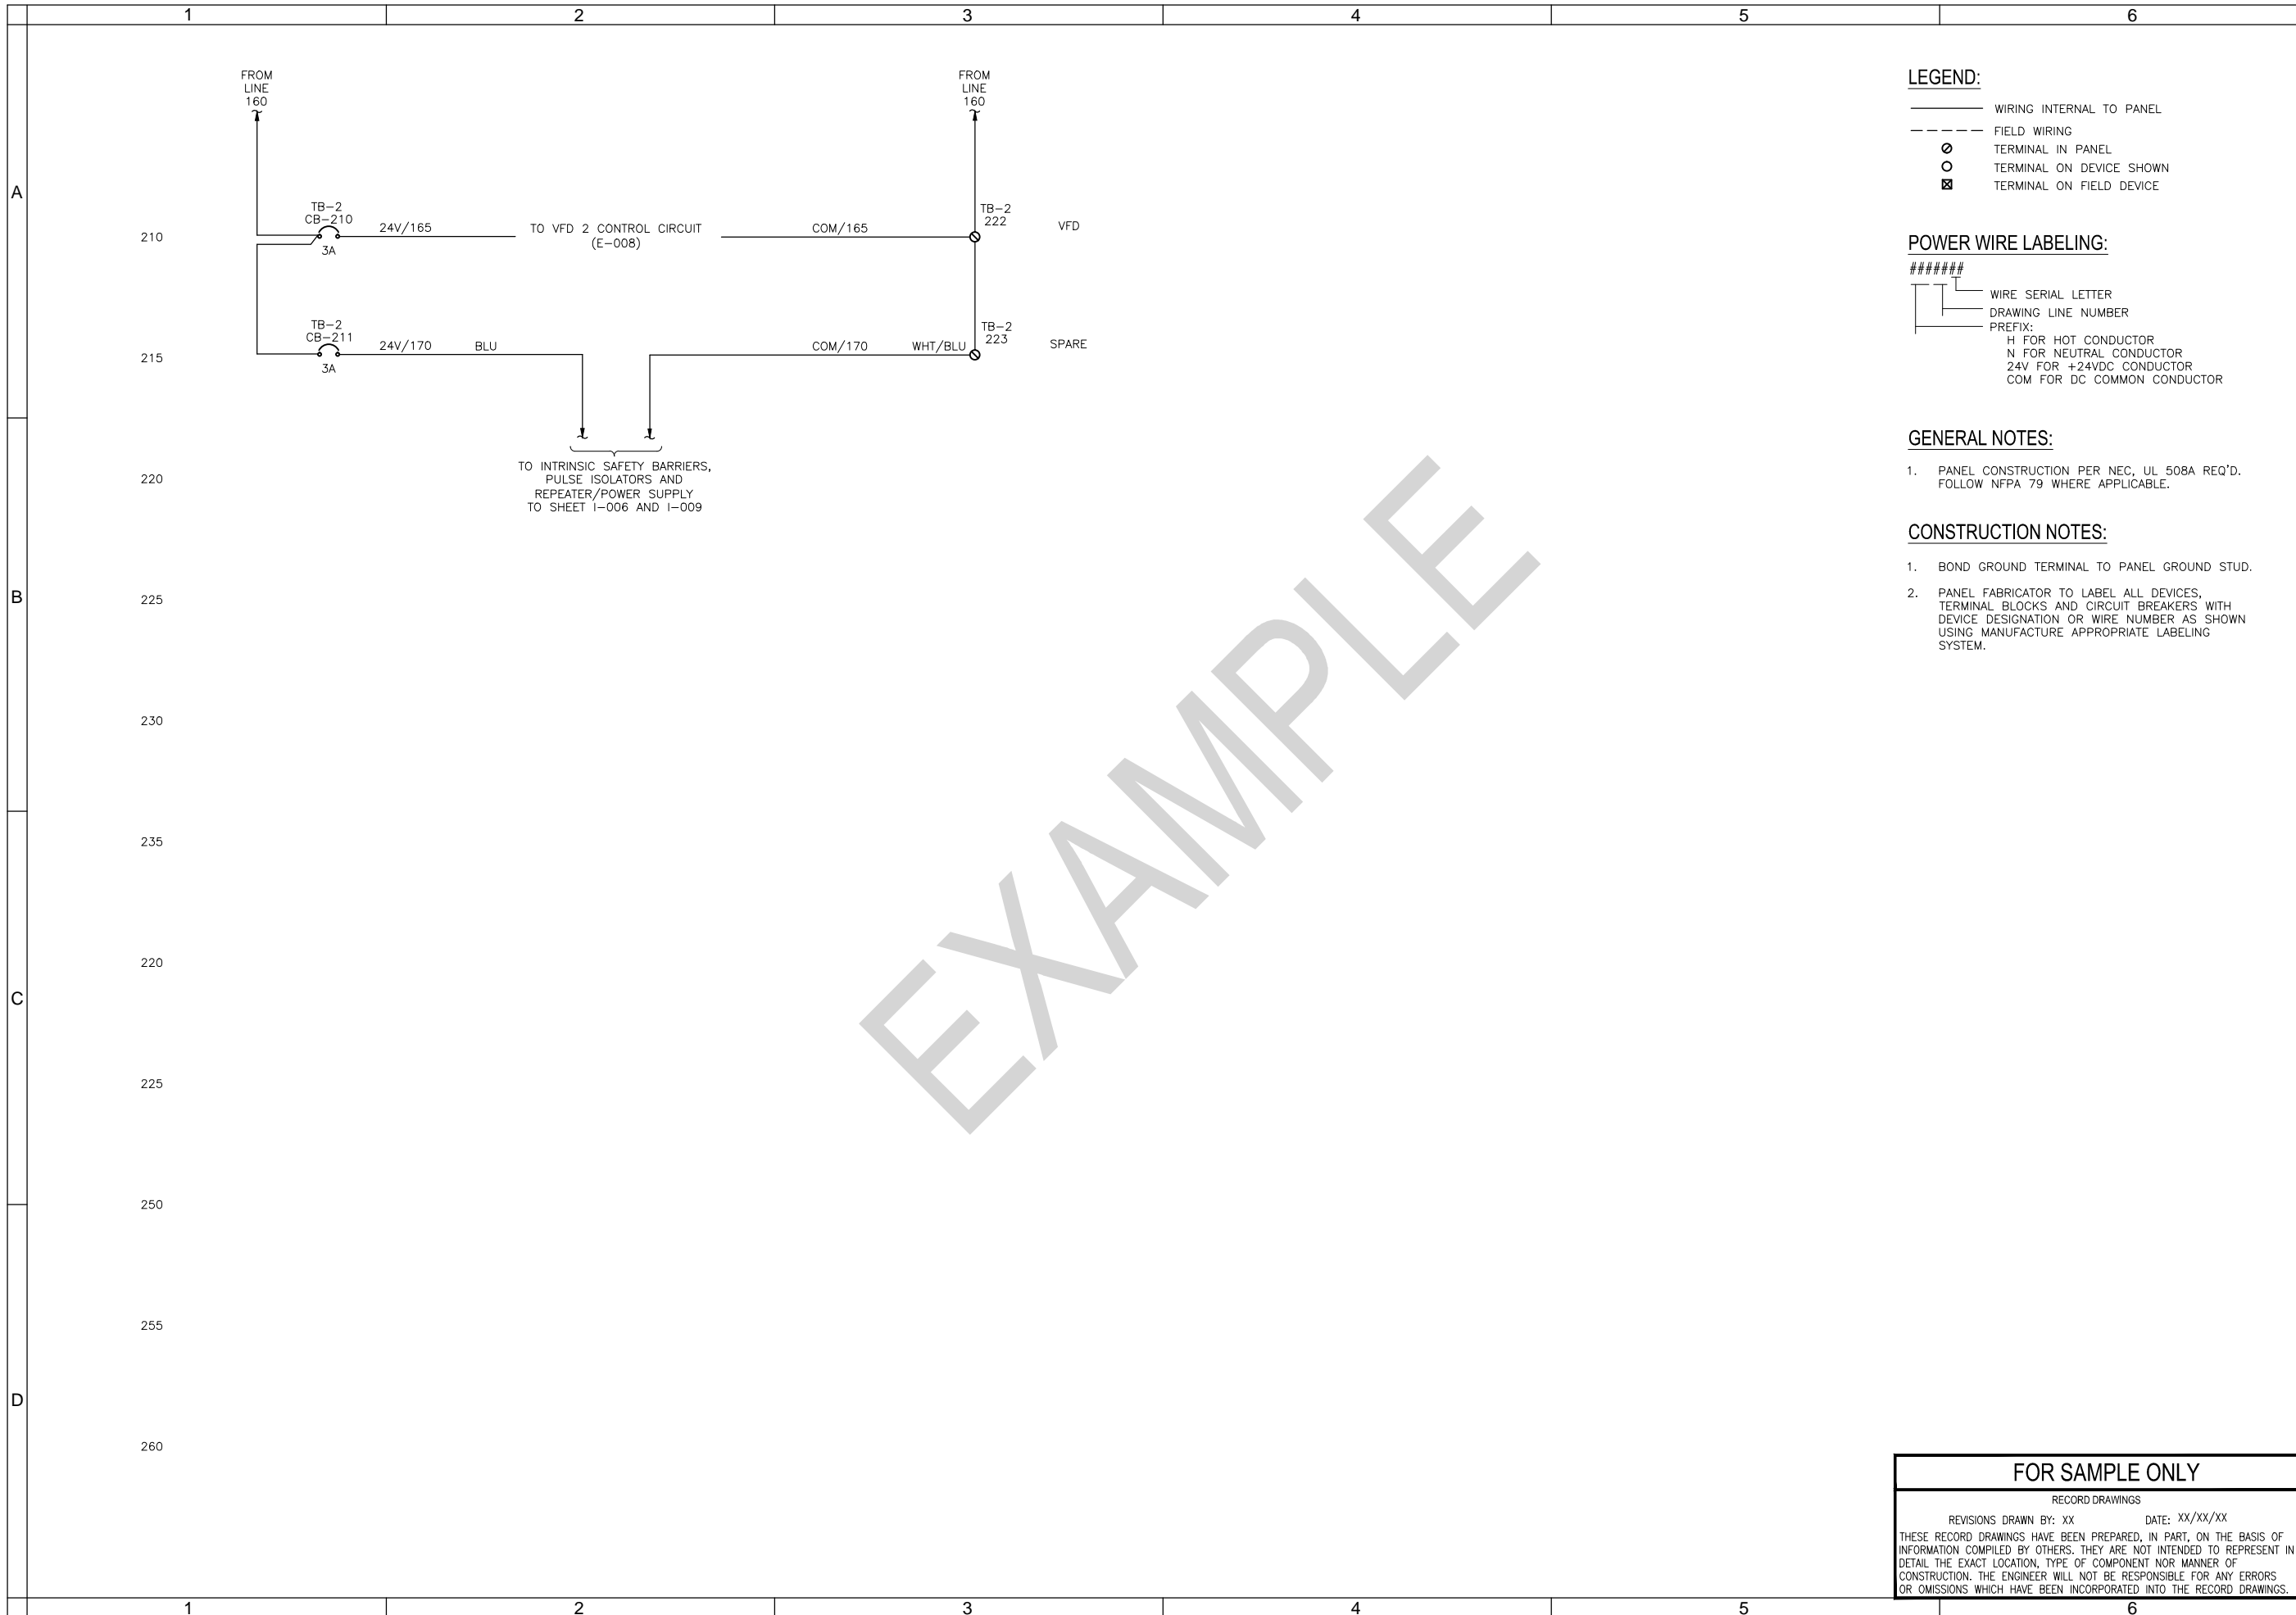

FOR SEALS AND SIGNATURES


(PROJECT NAME)
 CNTR PNL TYPE B TEMPLATE
 (50 I/Os) PWR WIRING SCHEMATIC
 DESCHUTES COUNTY, OREGON



REVISIONS:


(CONSULTANT ENGINEER NAME, ADDRESS & PHONE NUMBER)

DESIGNED BY: XXX
 DRAWN BY: XXX
 SCALE: NONE
 FILE: I-005.dwg
 DATE: _____

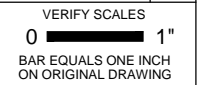

SHEET:
I-005
 COB# (XXXXXX)

FOR SAMPLE ONLY
 RECORD DRAWINGS
 REVISIONS DRAWN BY: XX DATE: XX/XX/XX
 THESE RECORD DRAWINGS HAVE BEEN PREPARED, IN PART, ON THE BASIS OF INFORMATION COMPILED BY OTHERS. THEY ARE NOT INTENDED TO REPRESENT IN DETAIL THE EXACT LOCATION, TYPE OF COMPONENT NOR MANNER OF CONSTRUCTION. THE ENGINEER WILL NOT BE RESPONSIBLE FOR ANY ERRORS OR OMISSIONS WHICH HAVE BEEN INCORPORATED INTO THE RECORD DRAWINGS.

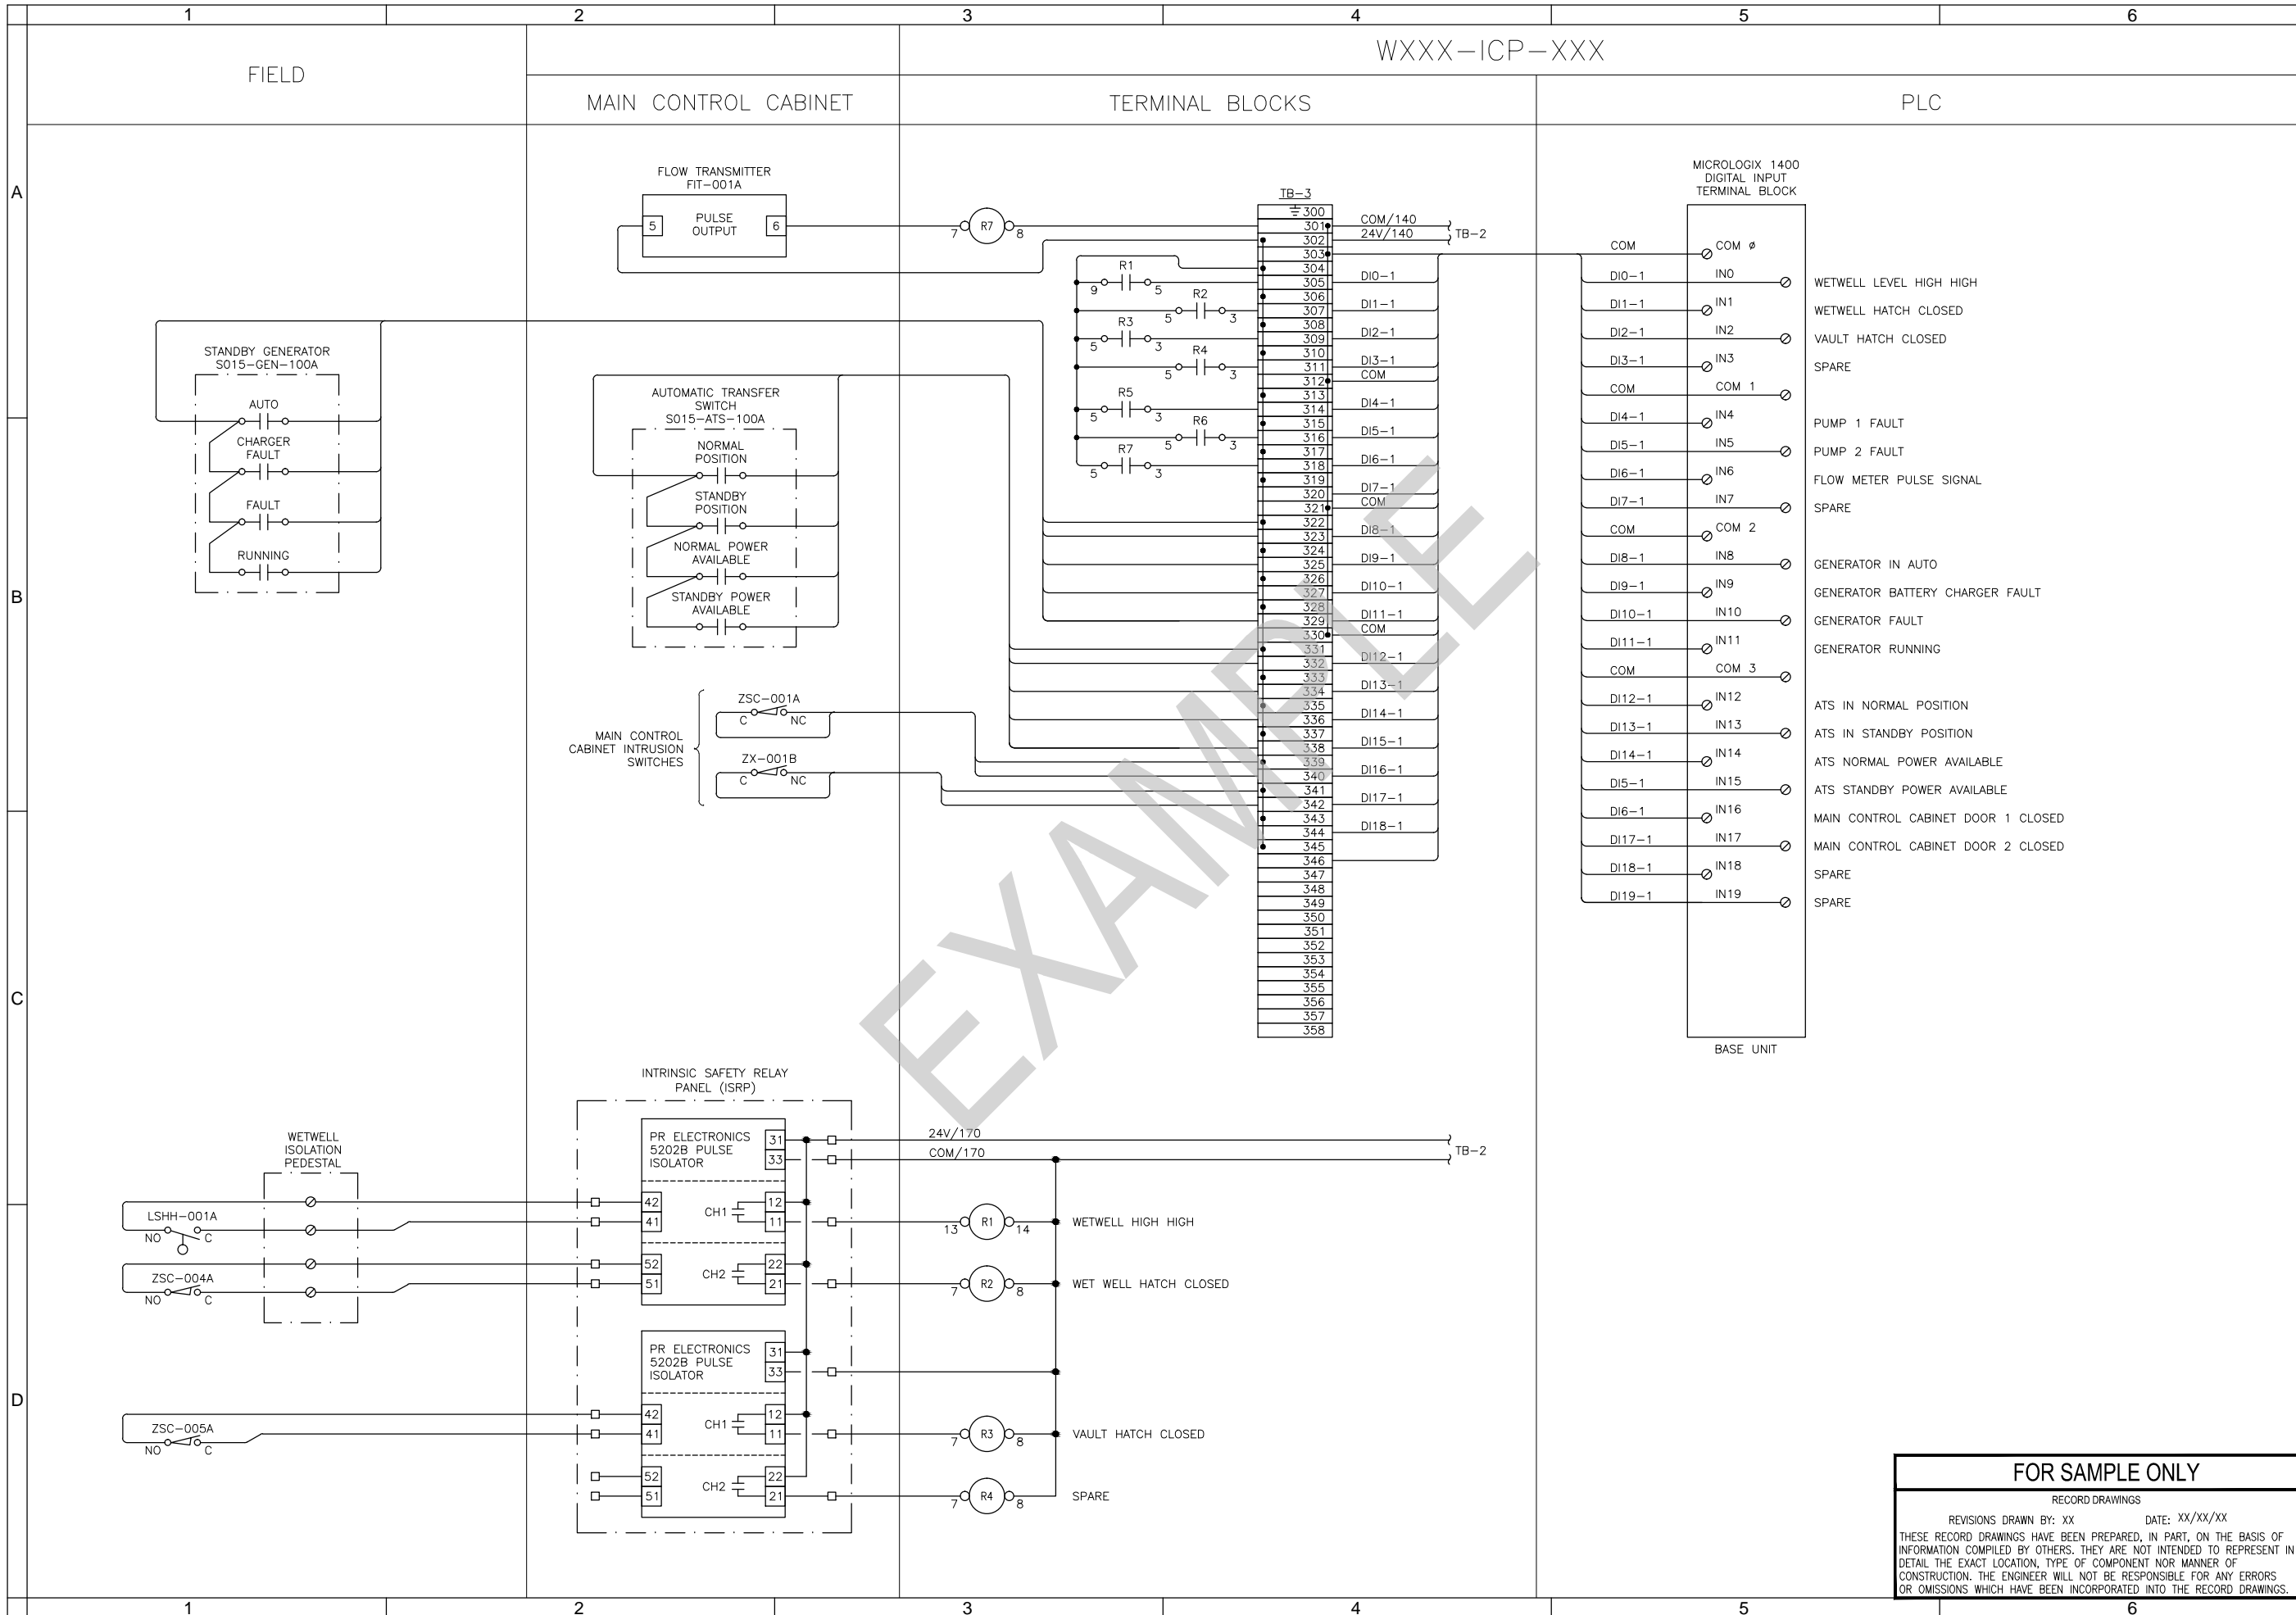

FOR SEALS AND SIGNATURES

(PROJECT NAME)
 CNTR PNL TYPE B TEMPLATE
 (50 I/Os) DIGITAL INPUT MODULE 1
 DESCHUTES COUNTY, OREGON



REVISIONS:


(CONSULTANT ENGINEER NAME, ADDRESS & PHONE NUMBER)

DESIGNED BY: XXX
 DRAWN BY: XXX
 SCALE: NONE
 FILE: I-006.dwg
 DATE:

VERIFY SCALES
 0 1" BAR EQUALS ONE INCH ON ORIGINAL DRAWING

SHEET: **I-006**
 COB# (XXXXXX)

FOR SAMPLE ONLY
 RECORD DRAWINGS
 REVISIONS DRAWN BY: XX DATE: XX/XX/XX
 THESE RECORD DRAWINGS HAVE BEEN PREPARED, IN PART, ON THE BASIS OF INFORMATION COMPILED BY OTHERS. THEY ARE NOT INTENDED TO REPRESENT IN DETAIL THE EXACT LOCATION, TYPE OF COMPONENT NOR MANNER OF CONSTRUCTION. THE ENGINEER WILL NOT BE RESPONSIBLE FOR ANY ERRORS OR OMISSIONS WHICH HAVE BEEN INCORPORATED INTO THE RECORD DRAWINGS.

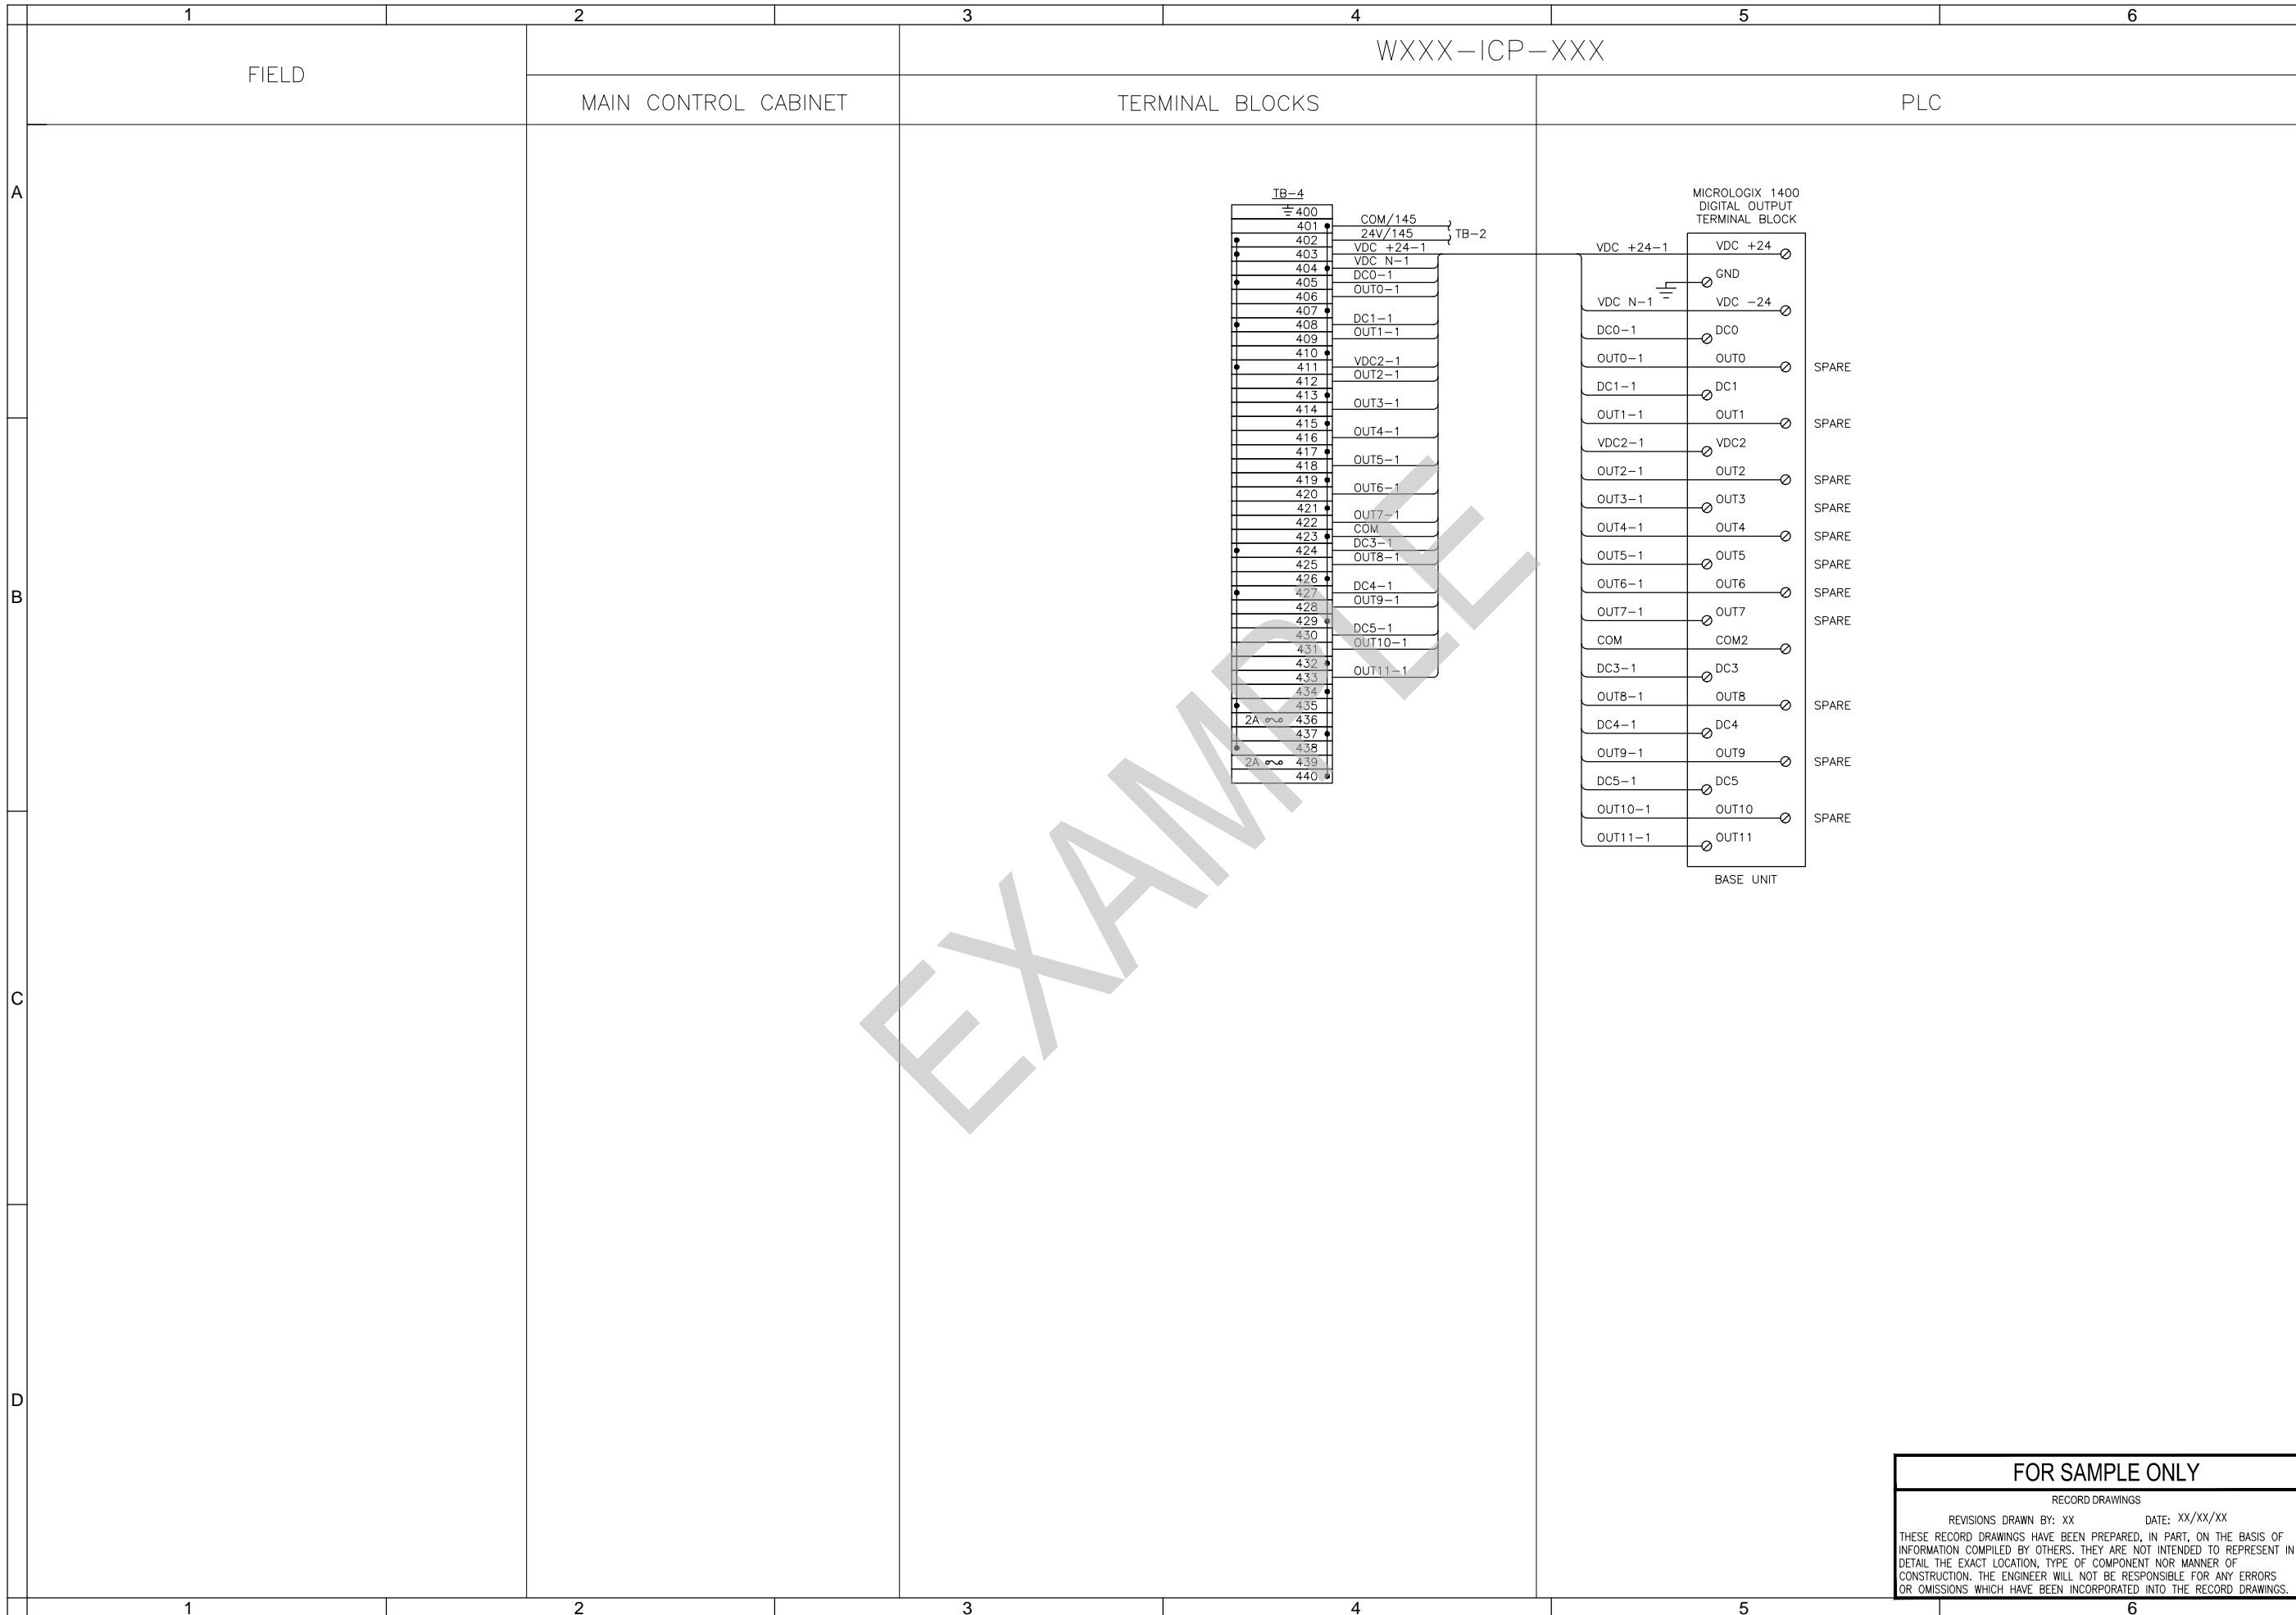

FOR SEALS
AND SIGNATURES

(PROJECT NAME)
CNTR PNL TYPE B TEMPLATE
(50 I/Os) DIGITAL INPUT MODULE 2
DESCHUTES COUNTY, OREGON



REVISIONS:

(CONSULTANT
ENGINEER
NAME, ADDRESS
& PHONE
NUMBER)


DESIGNED BY: XXX
DRAWN BY: XXX
SCALE: NONE
FILE: I-007.dwg
DATE: _____

VERIFY SCALES
0 1"
BAR EQUALS ONE INCH
ON ORIGINAL DRAWING

SHEET:
I-007
COB # (XXXXXX)

FOR SAMPLE ONLY

RECORD DRAWINGS
REVISIONS DRAWN BY: XX DATE: XX/XX/XX
THESE RECORD DRAWINGS HAVE BEEN PREPARED, IN PART, ON THE BASIS OF
INFORMATION COMPILED BY OTHERS. THEY ARE NOT INTENDED TO REPRESENT IN
DETAIL THE EXACT LOCATION, TYPE OF COMPONENT NOR MANNER OF
CONSTRUCTION. THE ENGINEER WILL NOT BE RESPONSIBLE FOR ANY ERRORS
OR OMISSIONS WHICH HAVE BEEN INCORPORATED INTO THE RECORD DRAWINGS.

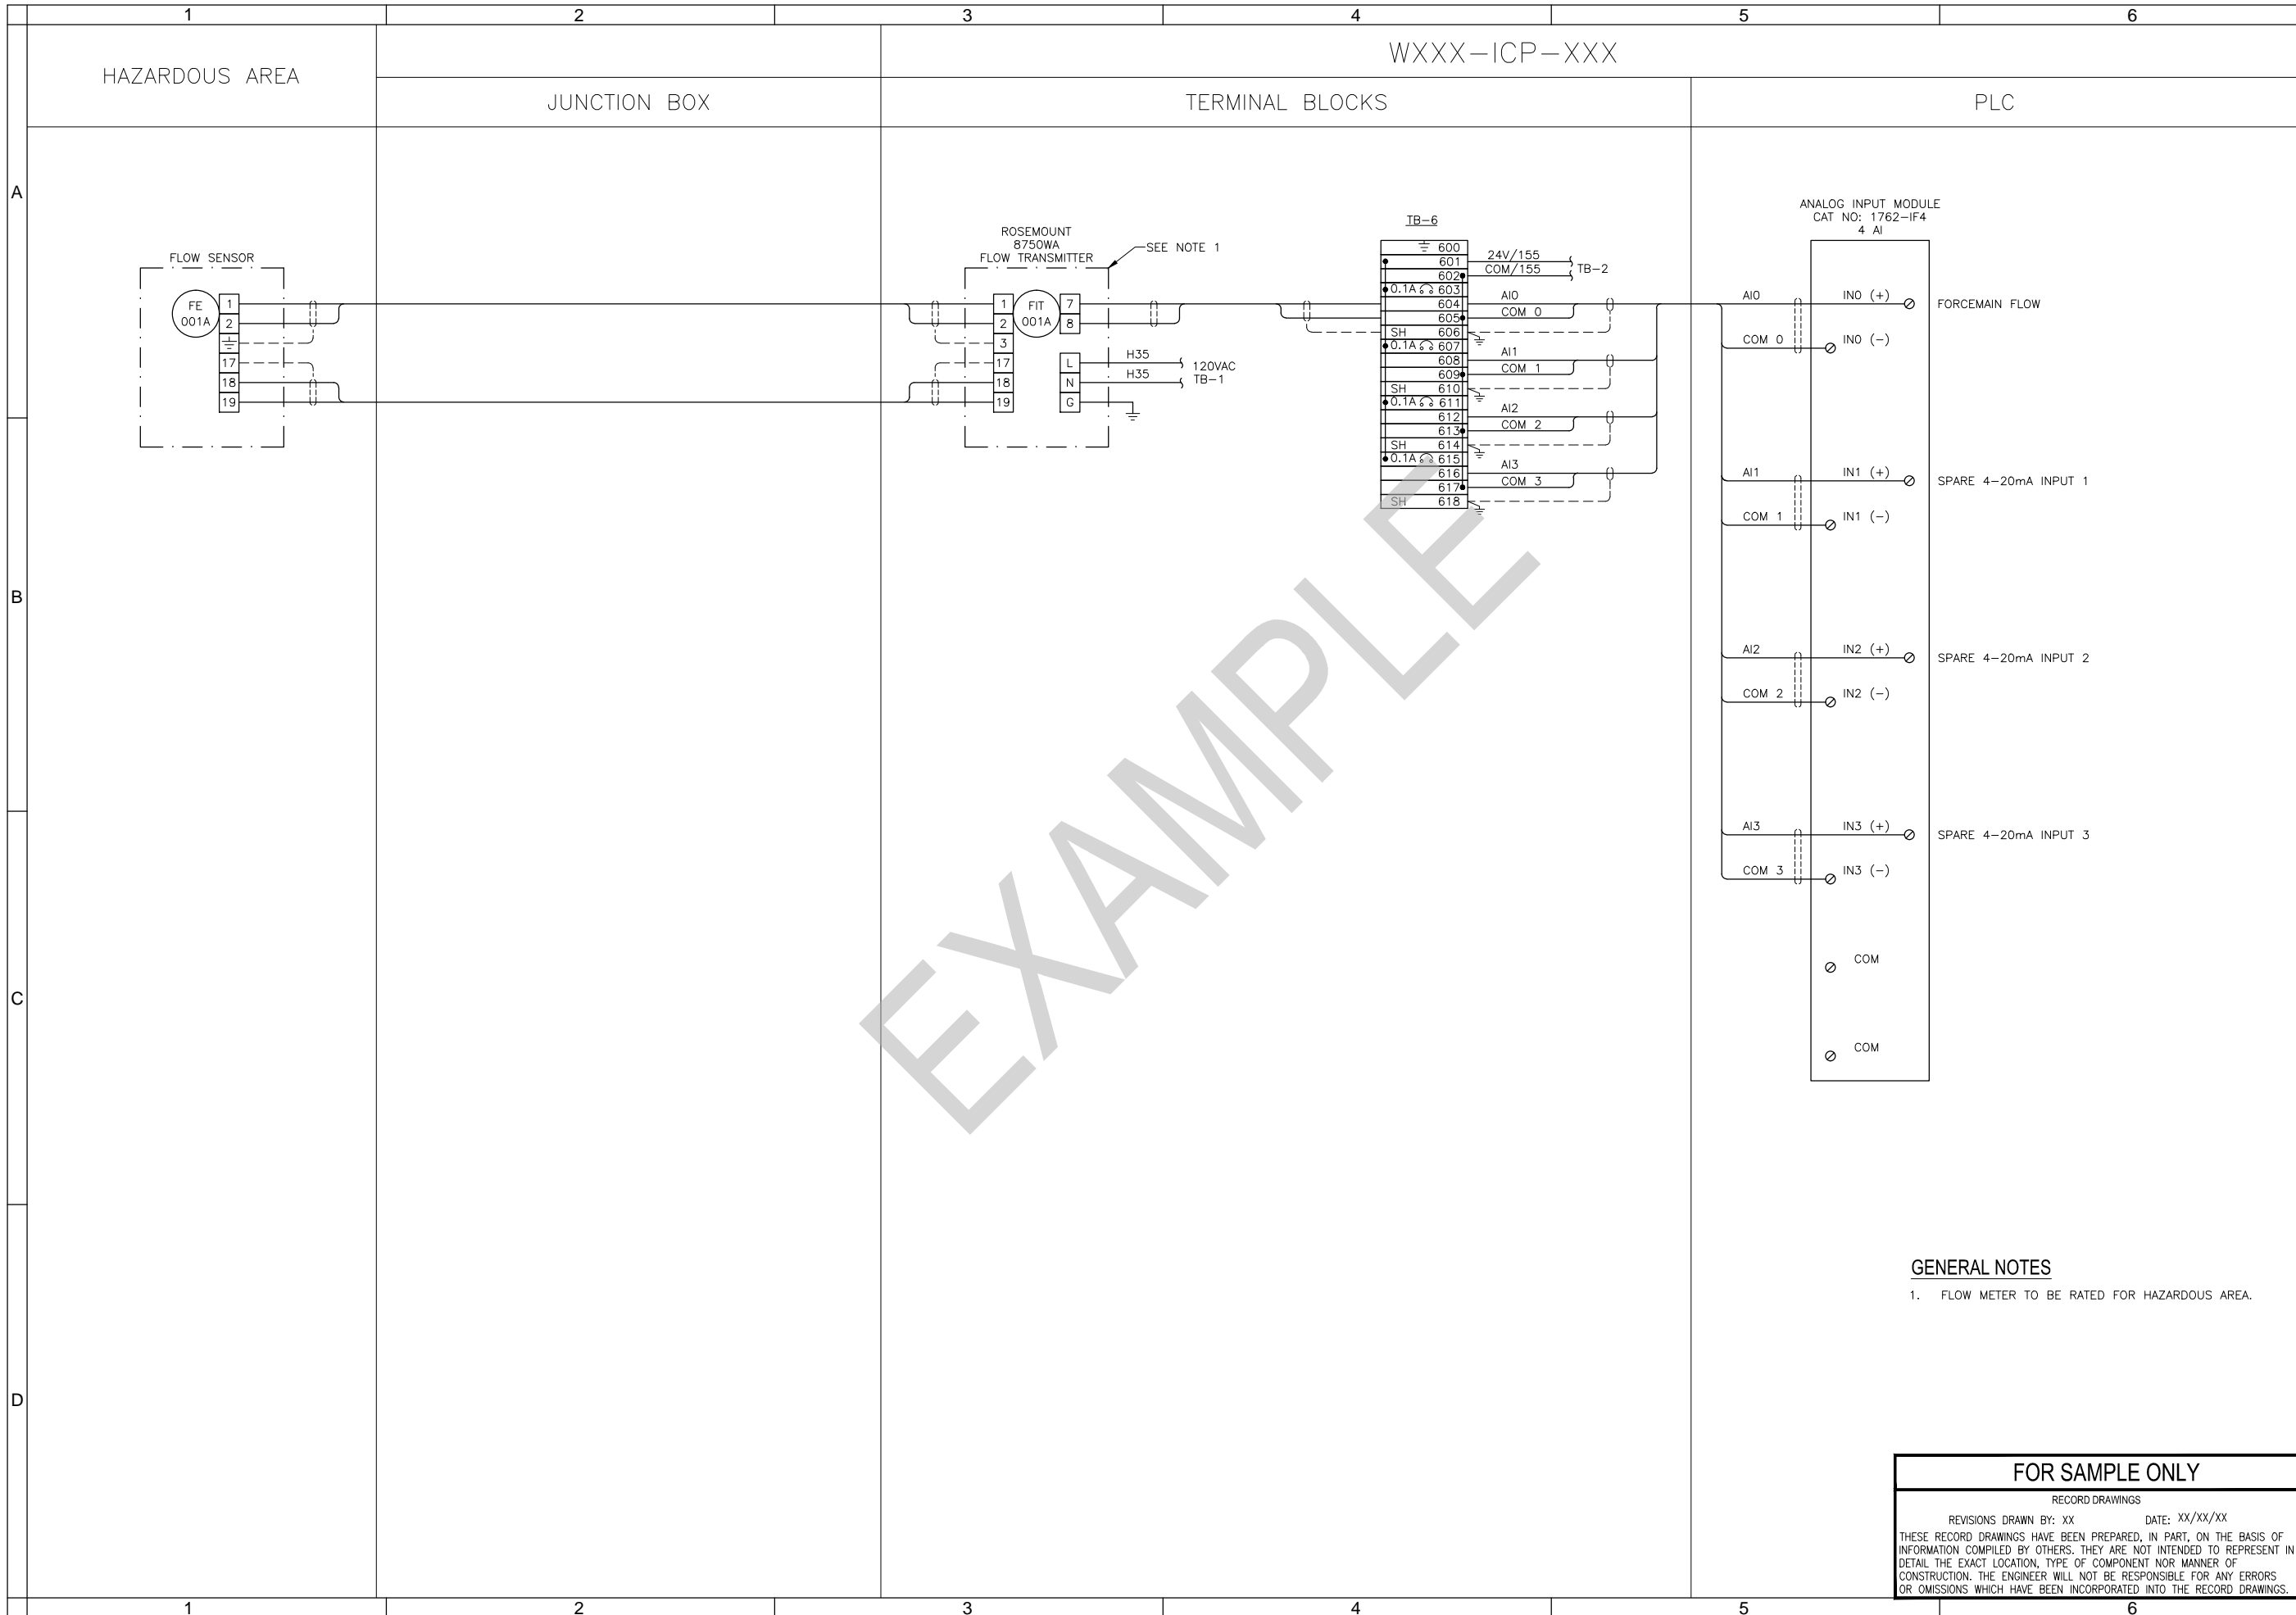

FOR SEALS
AND SIGNATURES


(PROJECT NAME)
CNTR PNL TYPE B TEMPLATE
(50 I/Os) ANALOG INPUT MODULE
DESCHUTES COUNTY, OREGON



REVISIONS:

(CONSULTANT
ENGINEER
NAME, ADDRESS
& PHONE
NUMBER)


DESIGNED BY: XXX
DRAWN BY: XXX
SCALE: NONE
FILE: I-008.dwg
DATE: _____

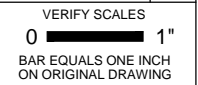

SHEET:
I-008
COB # (XXXXXX)

FOR SAMPLE ONLY

RECORD DRAWINGS
REVISIONS DRAWN BY: XX DATE: xx/xx/xx
THESE RECORD DRAWINGS HAVE BEEN PREPARED, IN PART, ON THE BASIS OF
INFORMATION COMPILED BY OTHERS. THEY ARE NOT INTENDED TO REPRESENT IN
DETAIL THE EXACT LOCATION, TYPE OF COMPONENT NOR MANNER OF
CONSTRUCTION. THE ENGINEER WILL NOT BE RESPONSIBLE FOR ANY ERRORS
OR OMISSIONS WHICH HAVE BEEN INCORPORATED INTO THE RECORD DRAWINGS.

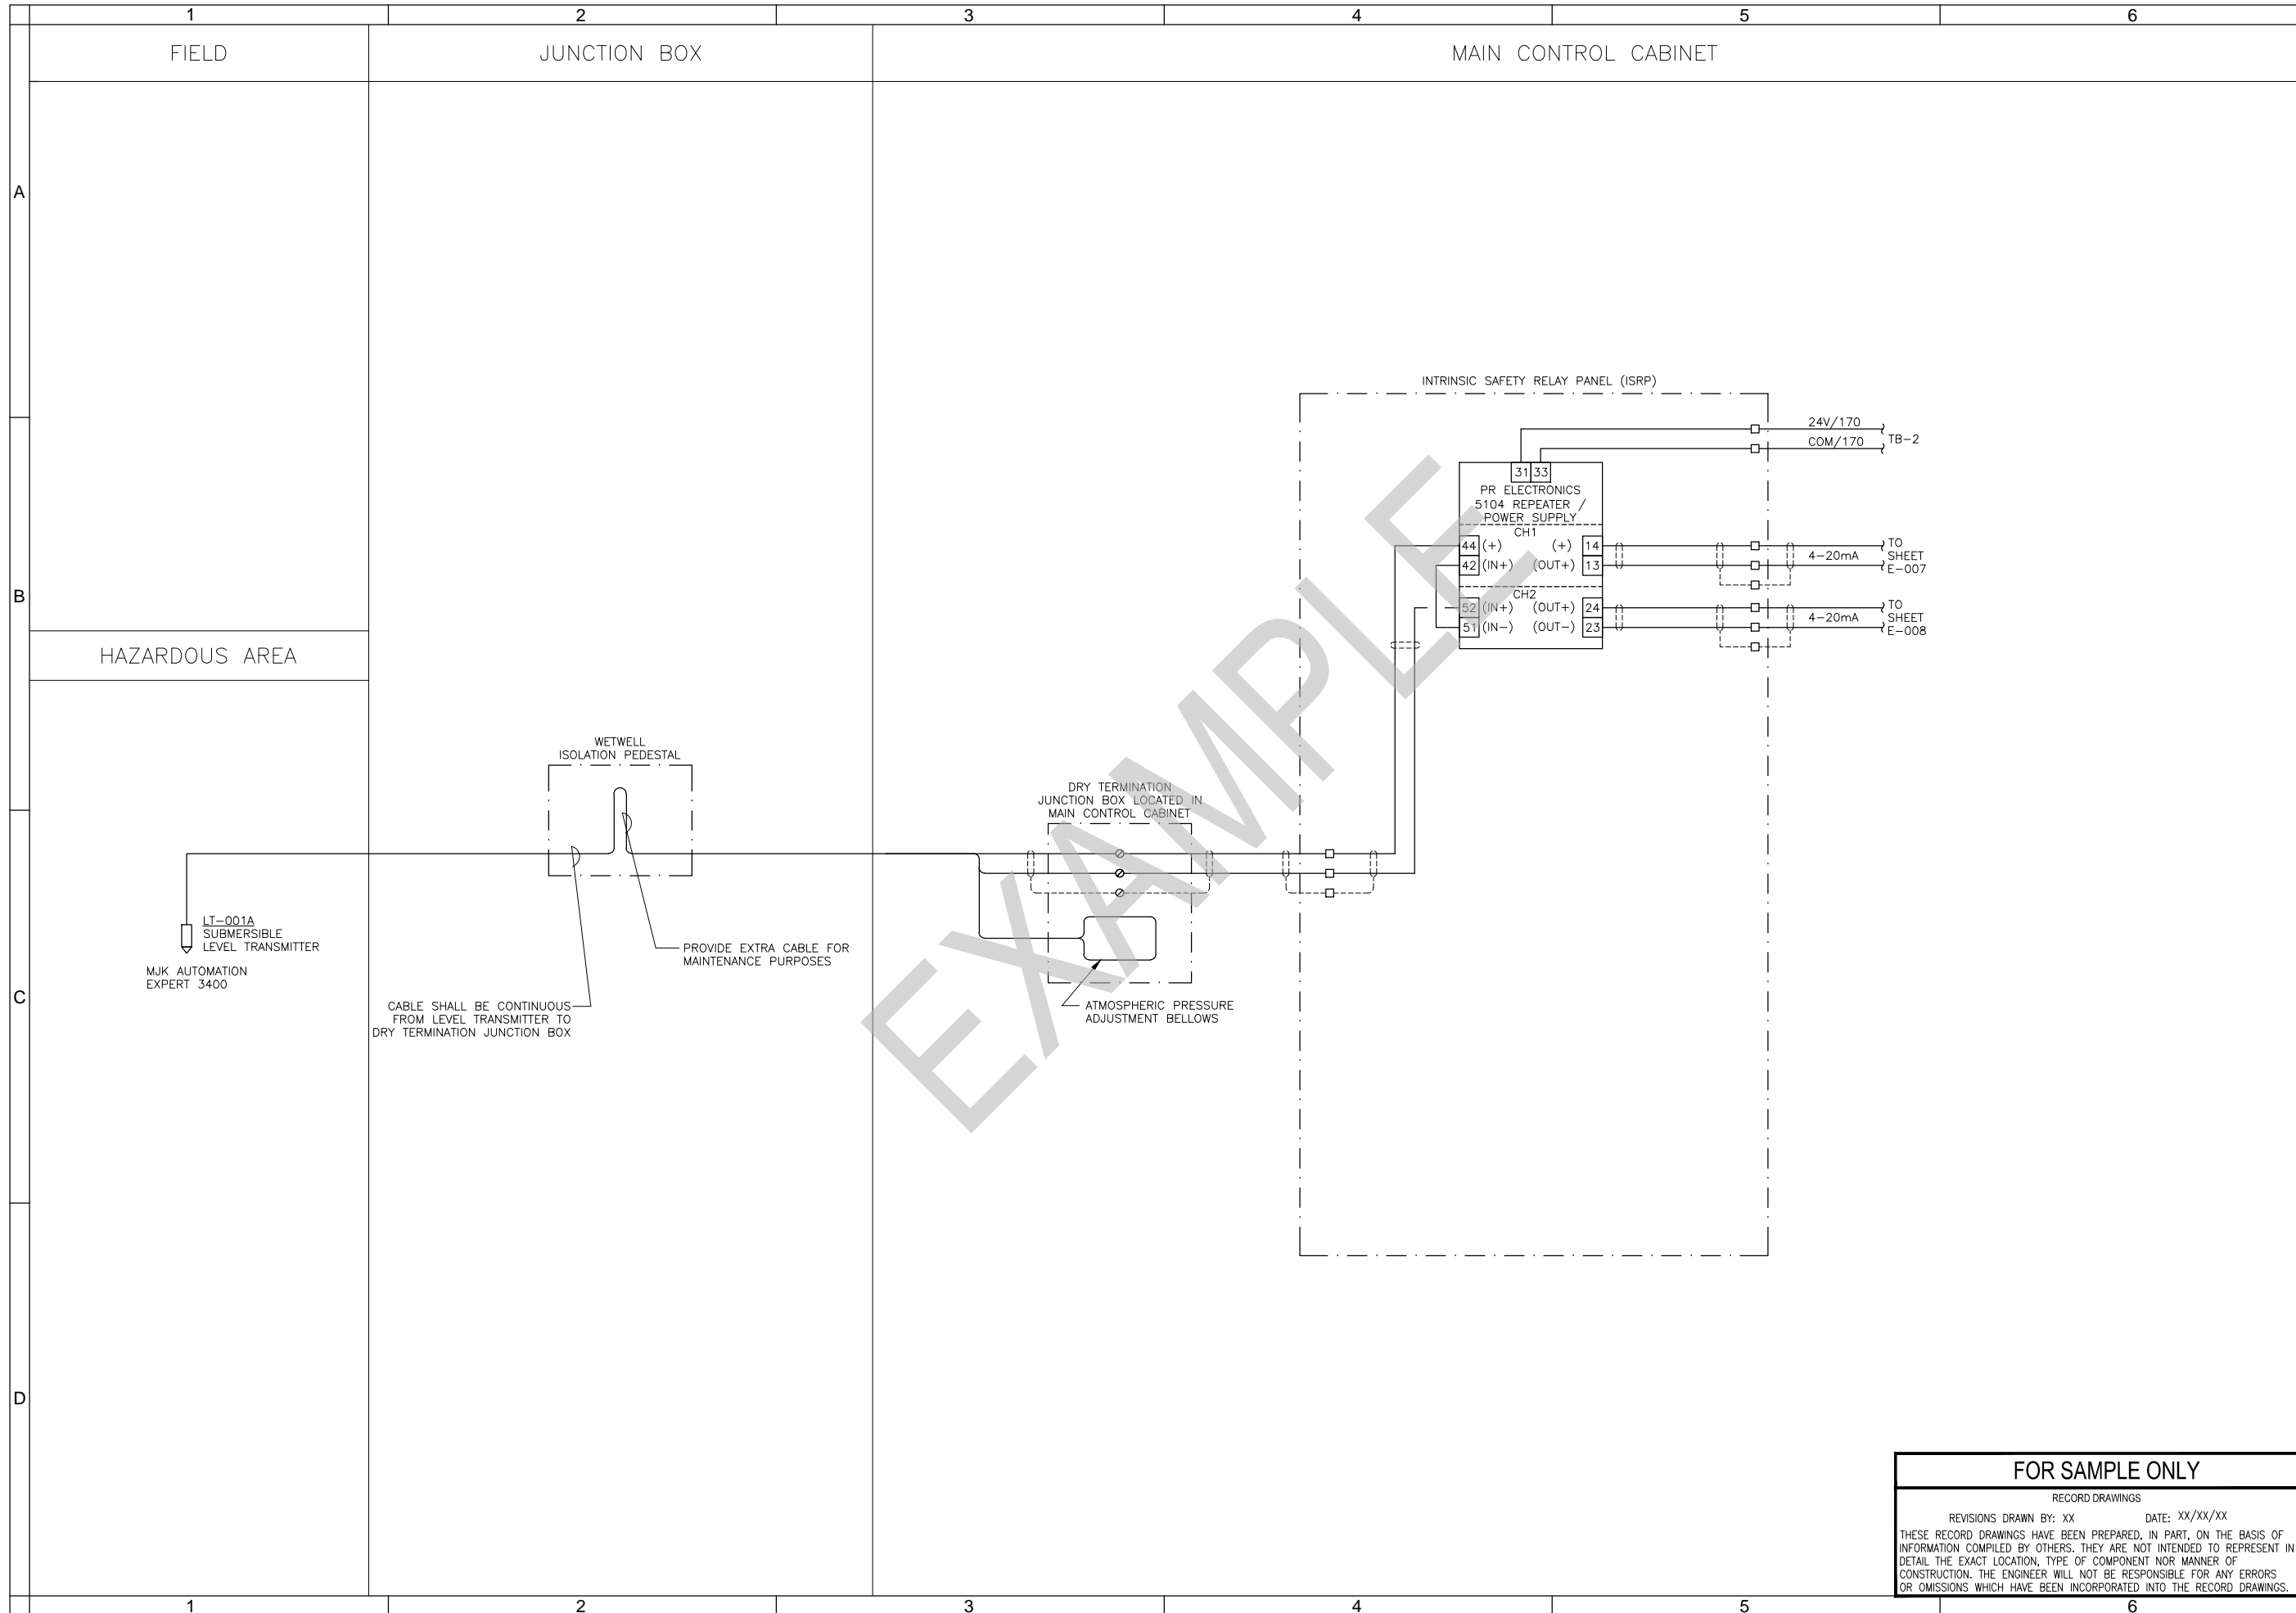

FOR SEALS AND SIGNATURES

(PROJECT NAME)
INSTRUMENTATION & CONTROLS
INTRINSIC SAFETY RELAY PANEL (ISRP)
 DESCHUTES COUNTY, OREGON



REVISIONS:


(CONSULTANT ENGINEER NAME, ADDRESS & PHONE NUMBER)

DESIGNED BY: XXX
 DRAWN BY: XXX
 SCALE: NONE
 FILE: I-009.dwg
 DATE: _____

VERIFY SCALES
 0 1"
 BAR EQUALS ONE INCH ON ORIGINAL DRAWING

SHEET:
I-009
 COB # (XXXXXX)

FOR SAMPLE ONLY
 RECORD DRAWINGS
 REVISIONS DRAWN BY: XX DATE: xx/xx/xx
 THESE RECORD DRAWINGS HAVE BEEN PREPARED, IN PART, ON THE BASIS OF INFORMATION COMPILED BY OTHERS. THEY ARE NOT INTENDED TO REPRESENT IN DETAIL THE EXACT LOCATION, TYPE OF COMPONENT NOR MANNER OF CONSTRUCTION. THE ENGINEER WILL NOT BE RESPONSIBLE FOR ANY ERRORS OR OMISSIONS WHICH HAVE BEEN INCORPORATED INTO THE RECORD DRAWINGS.

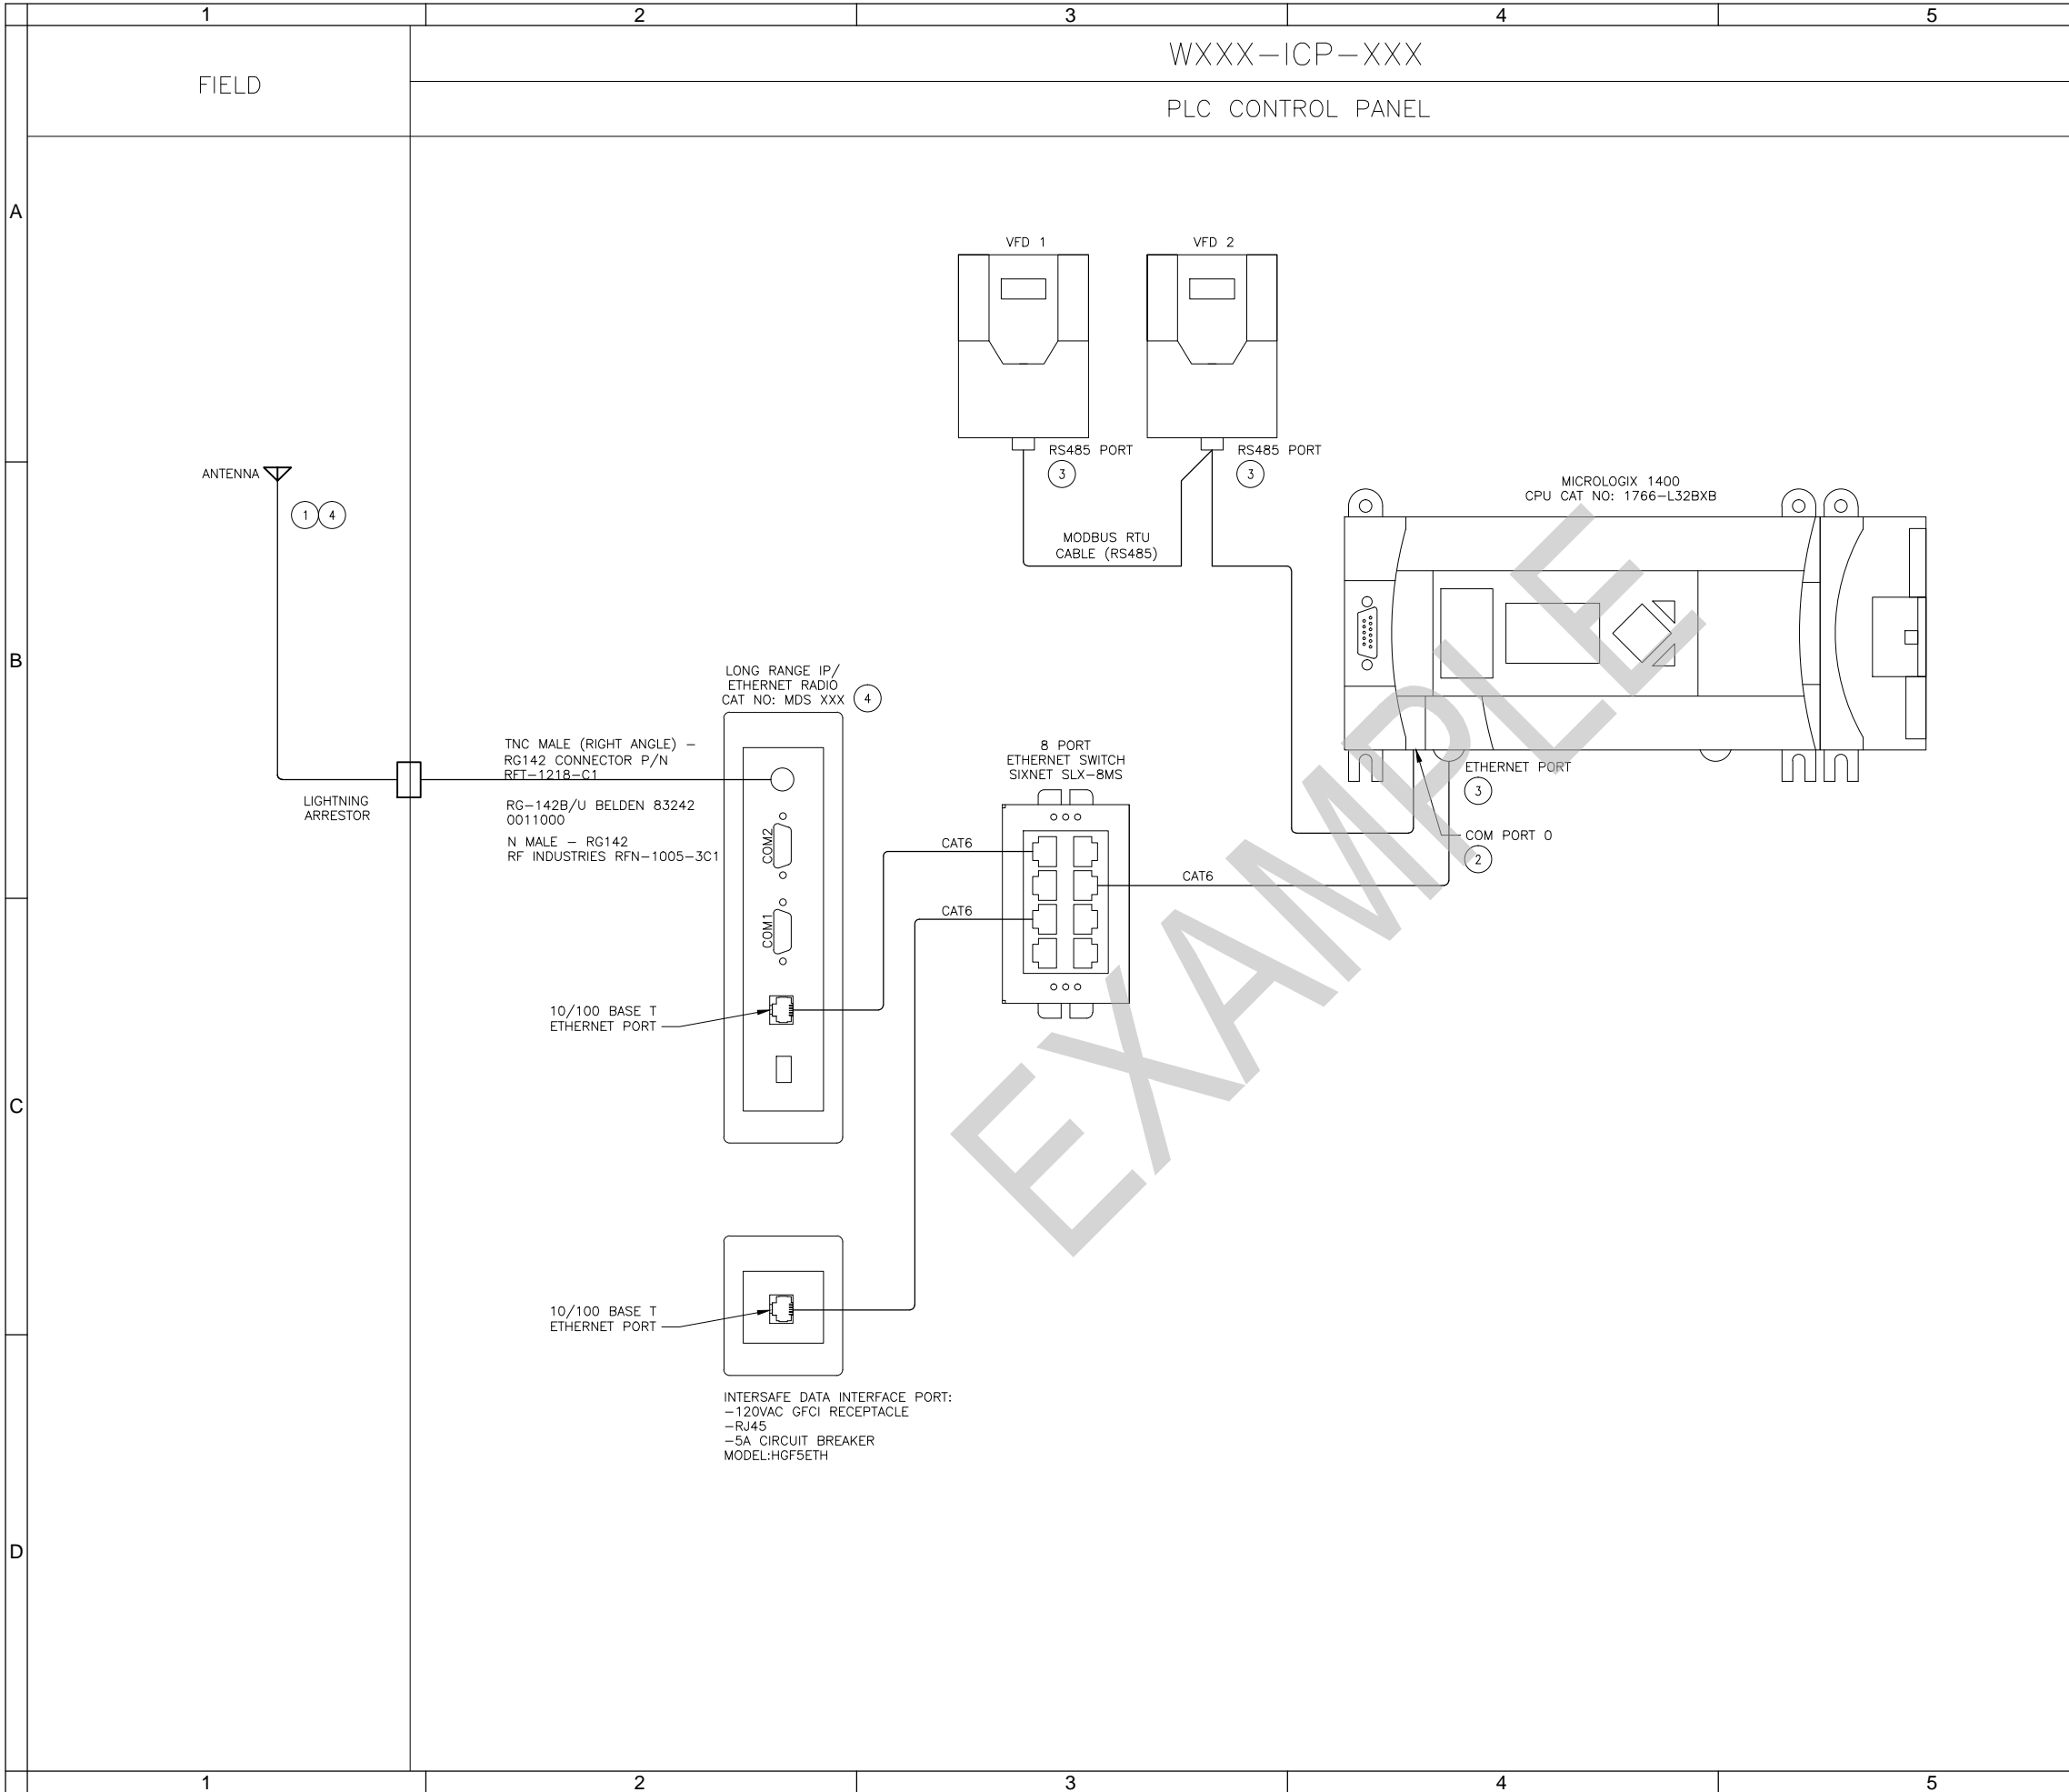

LEGEND:
 COMMUNICATION WIRING

GENERAL NOTES:

- PANEL FABRICATOR TO PROVIDE AND INSTALL ALL CABLES AS SHOWN ON DIAGRAM.
- FOR DRAWING INDEX, SEE DRAWING X-XXX.
- FOR GENERAL NOTES, ABBREVIATIONS, AND SYMBOL LEGENDS, SEE DRAWINGS X-XXX.

KEY NOTES:

- PULL ANTENNA GROUND WIRE IN MAST WITH ANTENNA COAX CABLE. TERMINATE ANTENNA GROUND ON MAIN CONTROL CABINET GROUND BUS.
- 8-PIN MINI DIN RS-232C/RS-485 CONNECTOR.
- RJ485 CONNECTOR. COMMUNICATIONS CABLE INTERCONNECTIONS SHALL BE AS REQUIRED TO MEET MANUFACTURER REQUIREMENTS.
- RADIO MAKE, MODEL, ANTENNA TYPE, AND ANTENNA CABLES TO BE DETERMINED BY CITY STAFF AND IS DEPENDENT ON SITE CONDITIONS AND LOCATION.

FOR SEALS AND SIGNATURES

(PROJECT NAME)
CONTROL PANEL
 COMMUNICATION NETWORK DIAGRAM
 DESCHUTES COUNTY, OREGON



REVISIONS:

(CONSULTANT ENGINEER NAME, ADDRESS & PHONE NUMBER)


DESIGNED BY: XXX
 DRAWN BY: XXX
 SCALE: NONE
 FILE: I-010.dwg
 DATE:

VERIFY SCALES
 0 1"
 BAR EQUALS ONE INCH ON ORIGINAL DRAWING

FOR SAMPLE ONLY

RECORD DRAWINGS
 REVISIONS DRAWN BY: XX DATE: XX/XX/XX
 THESE RECORD DRAWINGS HAVE BEEN PREPARED, IN PART, ON THE BASIS OF INFORMATION COMPILED BY OTHERS. THEY ARE NOT INTENDED TO REPRESENT IN DETAIL THE EXACT LOCATION, TYPE OF COMPONENT NOR MANNER OF CONSTRUCTION. THE ENGINEER WILL NOT BE RESPONSIBLE FOR ANY ERRORS OR OMISSIONS WHICH HAVE BEEN INCORPORATED INTO THE RECORD DRAWINGS.

SHEET:
I-010
 COB# (XXXXXX)

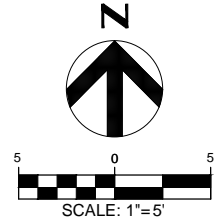

GENERAL NOTES:

1. ALL GROUNDING SHALL BE DONE IN ACCORDANCE WITH THE LATEST EDITION AND REVISION OF THE NATIONAL ELECTRIC CODE AND THE REGULATIONS OF THE STATE AND LOCAL CODES. ALL EQUIPMENT SHALL BE UNDERWRITER'S LABORATORY APPROVED. WHERE GROUND CABLES ARE EXPOSED THEY SHALL BE INSTALLED IN 1" DIA PVC SCHEDULE 80 CONDUIT FOR PHYSICAL PROTECTION.
2. PROVIDE #2/0 BARE COPPER GROUND WIRE UNLESS OTHERWISE NOTED.
3. (X) NOTES, SEE E-004

KEY NOTES:

- ① MAIN CONTROL CABINET. SEE DWG E-002.
- ② WETWELL ISOLATION PEDESTAL. SEE DWG E-005.
- ③ STANDBY GENERATOR WITH WEATHERPROOF, SOUND ATTENUATING ENCLOSURE. PROVIDE LOAD CALCULATION.
- ④ ODOR CONTROL VAULT. SEE CIVIL DRAWINGS.
- ⑤ SITE LIGHTING. LED AREA LIGHT WITH FOUNDATION AND SQUARE POLE. MAXIMUM FIXTURE HEIGHT OF 14 FT. CREE EDGW SERIES LOW PROFILE WITH 100 LED COUNT AND TYPE III MEDIUM DISTRIBUTION, OR APPROVED EQUAL.
- ⑥ ELECTRIC UTILITY METER AND MAIN CIRCUIT BREAKER.
- ⑦ VALVE VAULT, PRESSURE TRANSDUCER AND FLOW METER. SEE CIVIL DRAWINGS.
- ⑧ GROUND TEST WELL.
- ⑨ BOND GROUND WIRE TO GENERATOR PAD REBAR AND TO THE GENERATOR ENCLOSURE.
- ⑩ BOND GROUND WIRE TO EQUIPMENT PAD REBAR.
- ⑪ BOND GROUND WIRE.
- ⑫ BOND GROUND WIRE TO EQUIPMENT PANEL.
- ⑬ EXISTING UTILITY POLE.
- ⑭ CONTRACTOR SHALL COORDINATE WITH THE UTILITY COMPANY TO INSTALL THE ELECTRICAL SERVICE.
- ⑮ WET WELL IS CLASS I DIVISION I. ALL ELECTRICAL WIRING SHALL COMPLY WITH NEC ARTICLE 500.

HAZARDOUS AREAS:

- WET WELL INTERIOR - CLASS I, DIVISION 1
- WET WELL HATCH - CLASS I, DIVISION 2 (3' HORIZONTAL X 1.5' VERTICAL)
- WIRE TRAY INTERIOR - CLASS I, DIVISION 1
- WIRE TRAY EXTERIOR - CLASS I, DIVISION 2 (3' HORIZONTAL X 1.5' VERTICAL)
- VALVE VAULT INTERIOR - CLASS I, DIVISION 1
- SUBSURFACE AREAS ARE CONSIDERED UNCLASSIFIED UNLESS OTHERWISE NOTED

FOR SAMPLE ONLY

RECORD DRAWINGS

DESIGNED BY: XXX DRAWN BY: XXX SCALE: NONE FILE: E-001.dwg DATE: _____

REVISIONS DRAWN BY: XX DATE: XX/XX/XX

THESE RECORD DRAWINGS HAVE BEEN PREPARED, IN PART, ON THE BASIS OF INFORMATION COMPILED BY OTHERS. THEY ARE NOT INTENDED TO REPRESENT IN DETAIL THE EXACT LOCATION, TYPE OF COMPONENT NOR MANNER OF CONSTRUCTION. THE ENGINEER WILL NOT BE RESPONSIBLE FOR ANY ERRORS OR OMISSIONS WHICH HAVE BEEN INCORPORATED INTO THE RECORD DRAWINGS.



(PROJECT NAME)
ELECTRICAL
ELECTRICAL SITE PLAN
 DESCHUTES COUNTY, OREGON



REVISIONS:


(CONSULTANT ENGINEER NAME, ADDRESS & PHONE NUMBER)

DESIGNED BY: XXX
 DRAWN BY: XXX
 SCALE: NONE
 FILE: E-001.dwg
 DATE: _____


VERIFY SCALES
 0 1" BAR EQUALS ONE INCH ON ORIGINAL DRAWING

SHEET: **E-001**


COB # (XXXXXX)

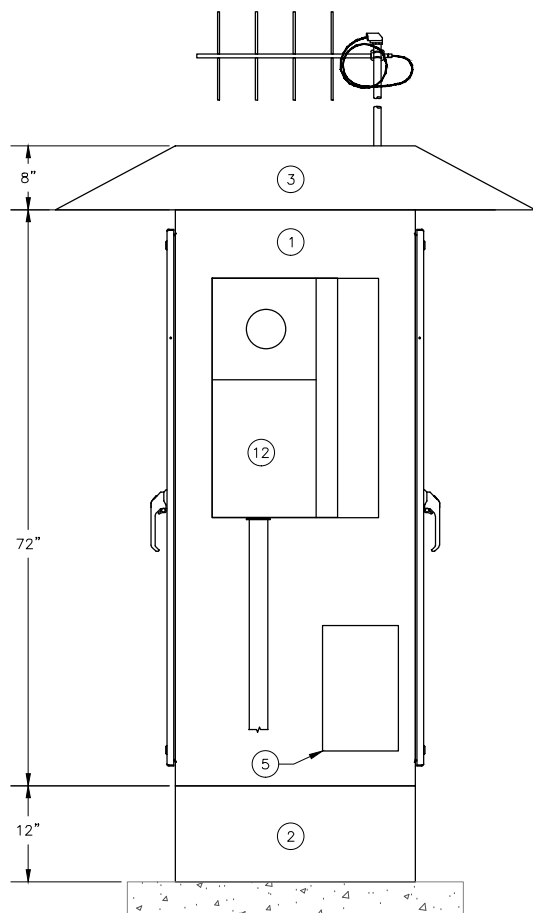


**CABINET
LEFT EXTERIOR ELEVATION**

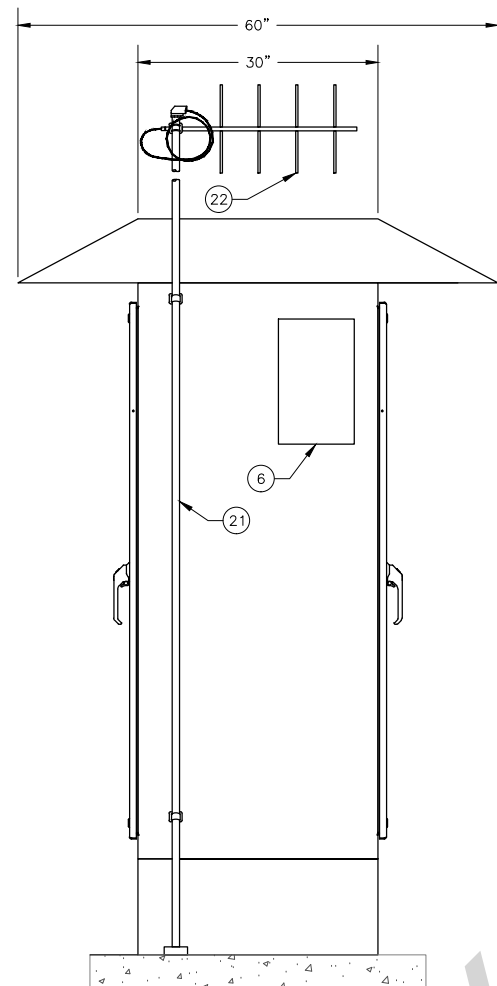

**CABINET
RIGHT EXTERIOR ELEVATION**

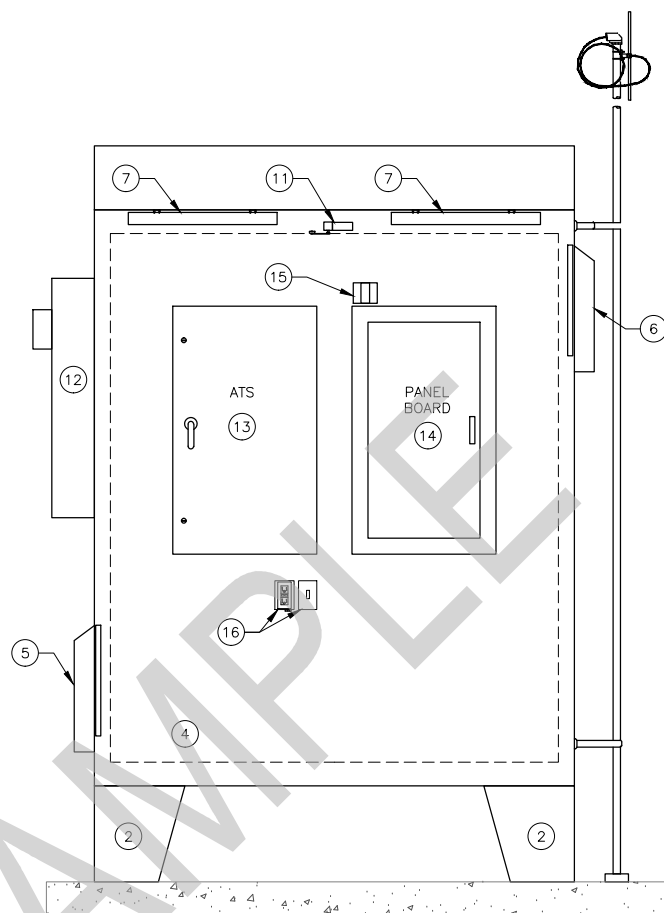

**CABINET
FRONT INTERIOR ELEVATION**

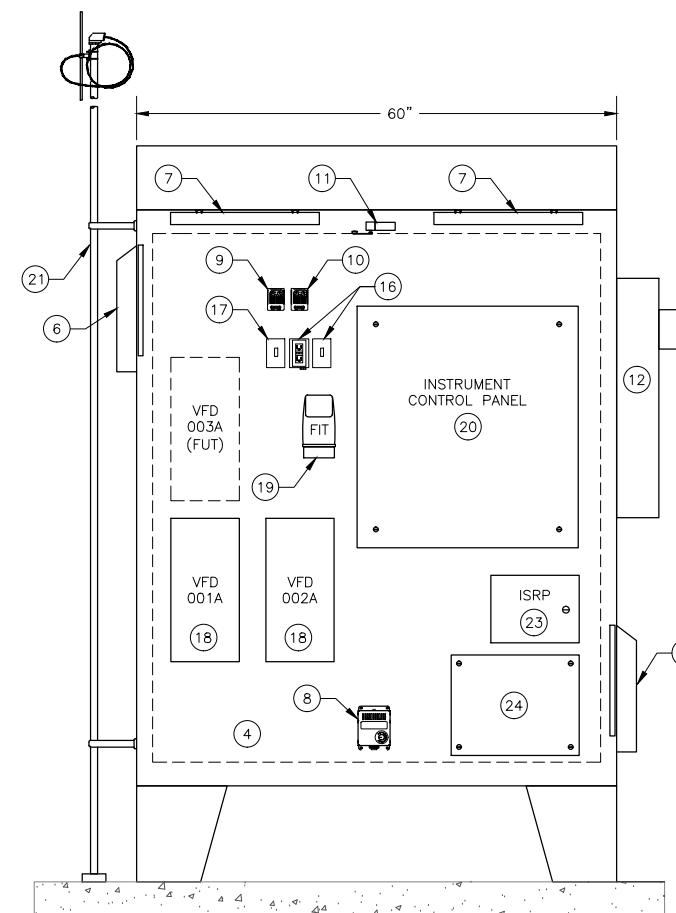

**CABINET
BACK INTERIOR ELEVATION**

KEY NOTES:

- ① ENCLOSURE, 2-DOOR DUAL ACCESS
- ② FLOOR STAND
- ③ RAINHOOD / SUNHOOD
- ④ MOUNTING PAN
- ⑤ COOLING FAN WITH FILTER
- ⑥ LOUVER WITH FILTER
- ⑦ CABINET LIGHT
- ⑧ CABINET HEATER
- ⑨ THERMOSTAT, COOLING
- ⑩ THERMOSTAT, HEATING
- ⑪ INTRUSION SWITCH
- ⑫ ELECTRIC SERVICE METER WITH MAIN BREAKER
- ⑬ AUTOMATIC TRANSFER SWITCH
- ⑭ PANEL BOARD
- ⑮ SURGE PROTECTION DEVICE
- ⑯ DUPLEX RECEPTACLE AND CABINET LIGHT SWITCH
- ⑰ LIGHT SWITCH, SITE LIGHT
- ⑱ SMARTRUN VFD

- ⑲ FLOW TRANSMITTER
- ⑳ INSTRUMENT CONTROL PANEL (ICP)
- ㉑ ANTENNA MAST, THREADED AT TOP WITH WEATHERHEAD
- ㉒ ANTENNA, NOTE 5
- ㉓ INTRINSIC SAFETY RELAY PANEL
- ㉔ LEVEL TRANSMITTER DRY TERMINATION J-BOX

CONSTRUCTION NOTES:

1. MAIN CONTROL CABINET SHALL BE NEMA 12 RATED, PAINTED STEEL WITH FLOOR STAND. CABINET DOORS SHALL BE FITTED WITH GASKETS, PADLOCKABLE HASPS, AND DOORS THAT LATCH OPEN. RAINHOOD/SUNHOOD SHALL BE CUSTOM FABRICATED FROM 12 GAUGE STEEL PAINTED WITH ANSI 61 LIGHT GREY POLYESTER POWDER FINISH TO MATCH ENCLOSURE.
2. PANEL CONSTRUCTION PER NEC AND UL508A REQUIREMENTS. FOLLOW NFPA 79 WHERE APPLICABLE. THE INTERIOR OF THE MAIN CONTROL CABINET SHALL BE DESIGNED AND FABRICATED TO MEET IP20 "FINGER-SAFE" REQUIREMENTS IN ACCORDANCE WITH IEC 60529; THERE SHALL BE NO EXPOSED LIVE PARTS AS DEFINED BY NFPA 70E. ALL INTERCONNECTIONS BETWEEN PANEL COMPONENTS INSIDE THE LARGER ELECTRICAL ENCLOSURE SHALL BE INSTALLED IN EMT, RGS, METAL WIREWAY, OR LIQUID TIGHT METALLIC FLEXIBLE CONDUIT.
3. NO PENETRATIONS THROUGH THE TOP OF THE ENCLOSURE ARE ALLOWED. ALL PENETRATIONS SHALL BE MADE WITH AN APPROVED FITTING AND GASKET.
4. DO NOT ROUTE 120VAC WIRING WITHING THE SAME RACEWAY AS DC ANALOG SIGNAL CABLES.
5. THE CITY OF BEND WILL DETERMINE THE RADIO TYPE, ANTENNA TYPE, MOUNTING HEIGHT, AND CABLE TYPE TO BE PROVIDED AND INSTALLED BY THE DEVELOPER. AT THE PRE-DESIGN STAGE, THE DEVELOPER SHALL COORDINATE FOR A TELEMETRY SIGNAL SURVEY TO BE PERFORMED WITH THE CITY OF BEND UTILITY DEPARTMENT AS REQUIRED TO DETERMINE RADIO COMMUNICATION EQUIPMENT REQUIREMENTS.
6. ALL UTILIZATION AND DISTRIBUTION EQUIPMENT, INCLUDING LIGHTING AND HEATING, SHALL BE WIRED FROM OR TO A SOURCE OTHER THAN THE PLC CONTROL PANEL. THIS REQUIRES A LOAD CENTER INSIDE THE MAIN CONTROL CABINET FOR POWER DISTRIBUTION.
7. EXCEPT AS OTHERWISE NOTED, PANEL WIRING SHALL BE AS FOLLOWS:
 - SINGLE WIRES SHALL BE THHN #16 AWG, EXCEPT WHERE INTENDED FOR POWER OR MOTOR CIRCUITS WHICH SHALL BE #14 AWG, MINIMUM.
 - COLOR CODE SHALL FOLLOW UL508A.
 - TWISTED PAIR ANALOG SIGNAL CABLE SHALL BE BELDEN 8760, OR EQUAL.
 - EACH WIRE SHALL BE IDENTIFIED WITH A PERMANENT WIRE LABEL, BRADY LAT-18-361.

**MAIN CONTROL CABINET
LAYOUT ELEVATION**

1
N.T.S.

FOR SAMPLE ONLY

RECORD DRAWINGS

DESIGNED BY: XXX DATE: XX/XX/XX
 DRAWN BY: XXX
 SCALE: NONE
 FILE: E-002.dwg
 DATE:

REVISIONS DRAWN BY: XX DATE: XX/XX/XX

THESE RECORD DRAWINGS HAVE BEEN PREPARED, IN PART, ON THE BASIS OF INFORMATION COMPILED BY OTHERS. THEY ARE NOT INTENDED TO REPRESENT IN DETAIL THE EXACT LOCATION, TYPE OF COMPONENT NOR MANNER OF CONSTRUCTION. THE ENGINEER WILL NOT BE RESPONSIBLE FOR ANY ERRORS OR OMISSIONS WHICH HAVE BEEN INCORPORATED INTO THE RECORD DRAWINGS.

FOR SEALS
AND SIGNATURES

(PROJECT NAME)
INSTRUMENTATION & CONTROLS
MAIN CONTROL CABINET LAYOUT
DESCHUTES COUNTY, OREGON



REVISIONS:

(CONSULTANT
ENGINEER
NAME, ADDRESS
& PHONE
NUMBER)

DESIGNED BY: XXX
DRAWN BY: XXX
SCALE: NONE
FILE: E-002.dwg
DATE:

VERIFY SCALES
0 1"
BAR EQUALS ONE INCH
ON ORIGINAL DRAWING

SHEET:
E-002
COB # (XXXXXX)

GENERAL NOTES:

1. ELECTRICAL SERVICE AND ELECTRICAL EQUIPMENT SHALL HAVE A MINIMUM OF 25% SPARE CAPACITY FOR FUTURE LOADS.
2. PANEL BOARD SHALL HAVE A MINIMUM OF 25% PREPARED CIRCUIT BREAKER SPACE FOR FUTURE LOADS.
3. POWER SUPPLY VOLTAGE AND PHASE SHALL BE SITE SPECIFIC AND BE APPROVED BY CITY STAFF.
4. VFD'S TO PROVIDE 3-PHASE POWER TO THE MOTOR FROM A SINGLE PHASE SOURCE.



(PROJECT NAME)
INSTRUMENTATION & CONTROLS
ELECTRICAL ONE LINE DIAGRAM
 DESCHUTES COUNTY, OREGON



REVISIONS:


(CONSULTANT ENGINEER NAME, ADDRESS & PHONE NUMBER)

DESIGNED BY: XXX
 DRAWN BY: XXX
 SCALE: NONE
 FILE: E-003.dwg
 DATE: _____

VERIFY SCALES
 0 1"
 BAR EQUALS ONE INCH ON ORIGINAL DRAWING

SHEET: **E-003**
 COB # (XXXXXX)

FOR SAMPLE ONLY
 RECORD DRAWINGS
 REVISIONS DRAWN BY: XX DATE: XX/XX/XX
 THESE RECORD DRAWINGS HAVE BEEN PREPARED, IN PART, ON THE BASIS OF INFORMATION COMPILED BY OTHERS. THEY ARE NOT INTENDED TO REPRESENT IN DETAIL THE EXACT LOCATION, TYPE OF COMPONENT NOR MANNER OF CONSTRUCTION. THE ENGINEER WILL NOT BE RESPONSIBLE FOR ANY ERRORS OR OMISSIONS WHICH HAVE BEEN INCORPORATED INTO THE RECORD DRAWINGS.

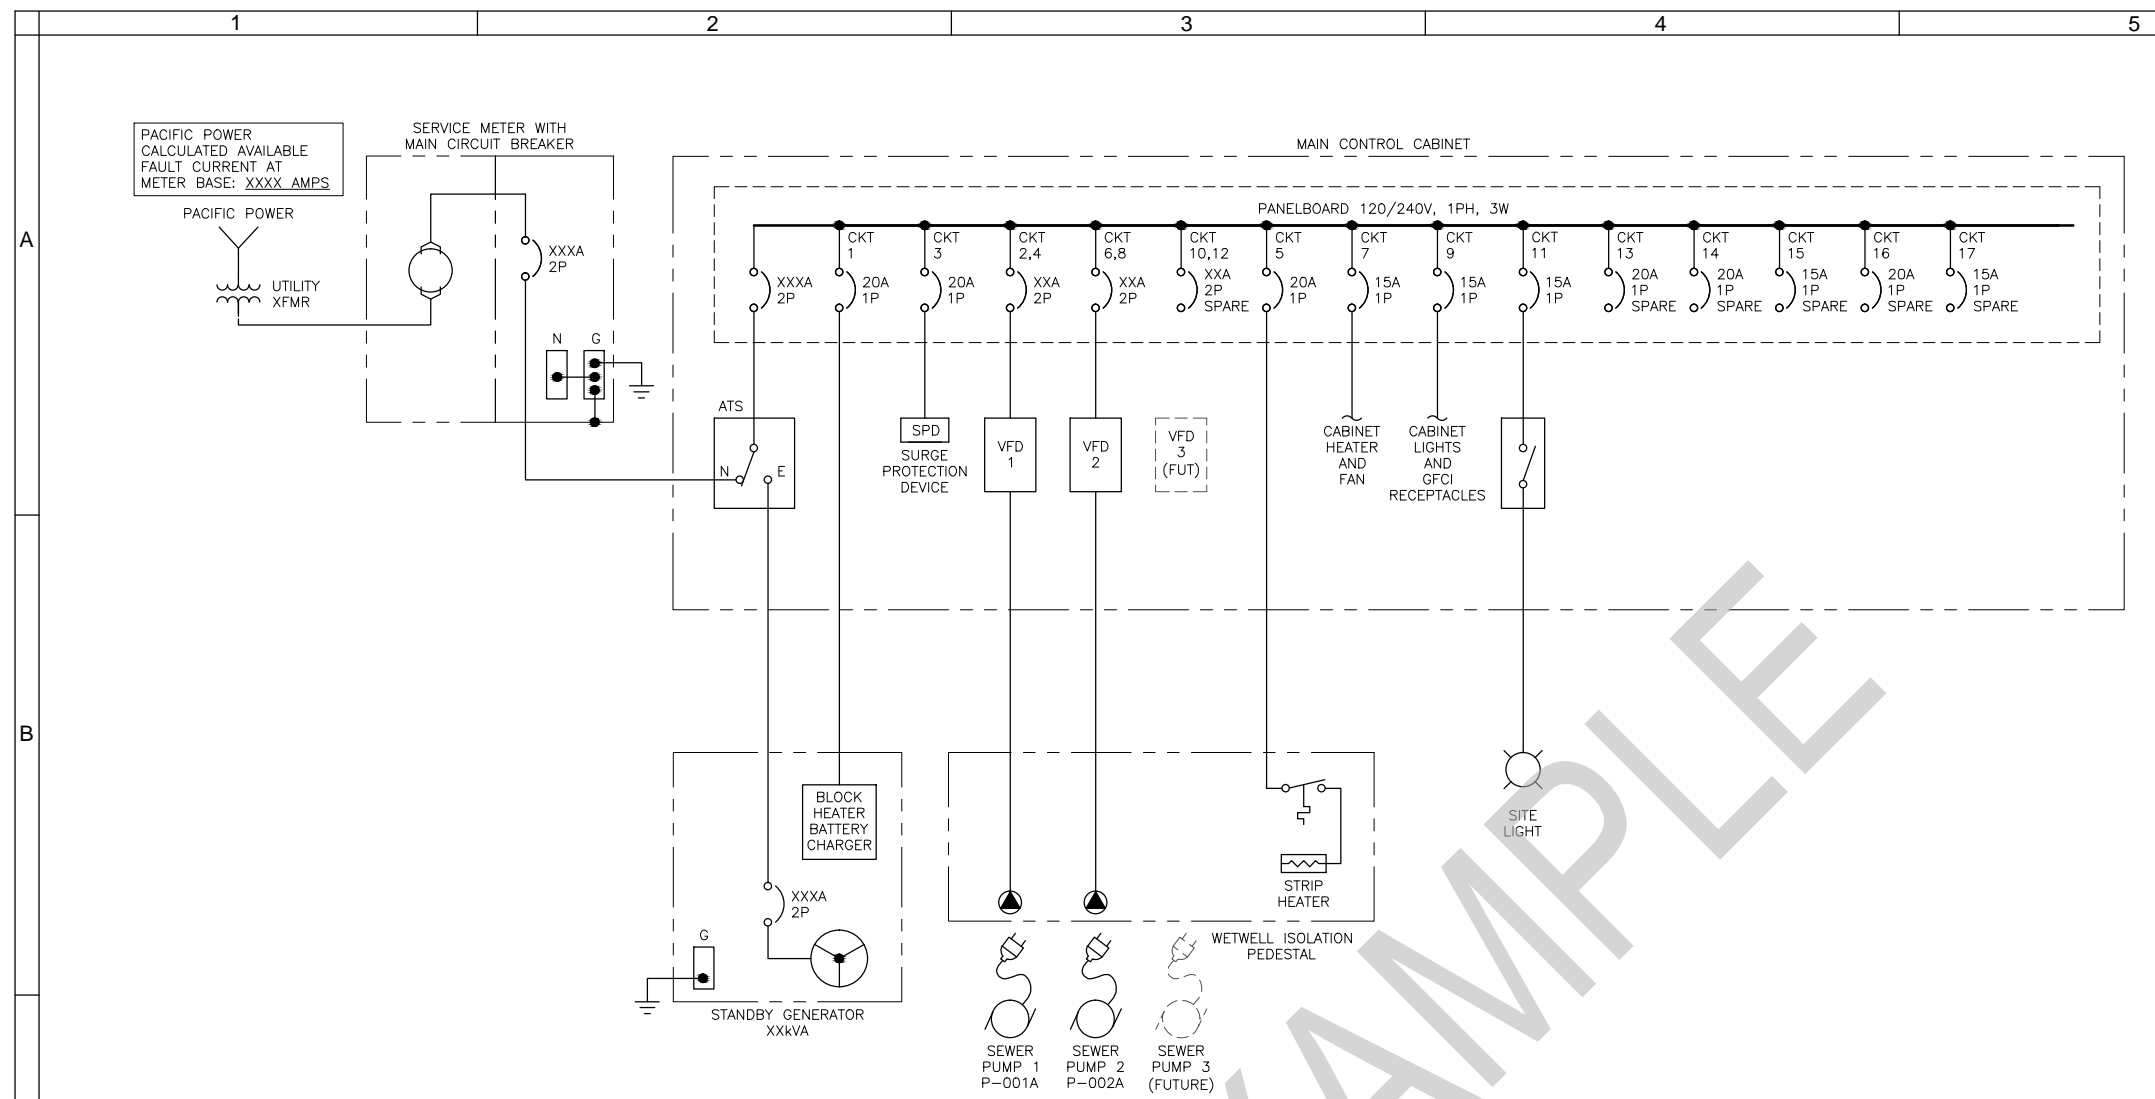

LOAD DESCRIPTION	DUTY NO.	HP EACH	kVA EACH	TOTAL DUTY kVA	PLANT LOAD NO. kVA
PUMP 1	1	XX	XXX	XXX	XXX
PUMP 2	1	XX	XXX	XXX	XXX
PUMP 3 (FUTURE)		XX	XXX	XXX	XXX
GENERATOR BLOCK HEATER			XXX	XXX	XXX
CONTROL CABINET HEATER			XXX	XXX	XXX
ISOLATION HEAT			XXX	XXX	XXX
LOAD BANK HEAT			XXX	XXX	XXX
MISC LOAD			XXX	XXX	XXX
				TOTAL DUTY	DESIGN TOTAL
kVA SUBTOTAL				XXX	XXX
AMPS @240V, 3PH				XXX	XXX

LOAD REQUIREMENTS		PERFORMANCE REQUIREMENTS	
RUNNING kW	XXX	120/240V, 1PH, 3W	
RUNNING kVA	XXX	MAX VOLTAGE DIP	10%
RUNNING P.F.	XXX	MAX FREQUENCY DIP	2%
MAX START kW	XXX IN STEP 2	MAX VOLTAGE HARMONIC DISTORTION	5%
MAX START kVA	XXX IN STEP 2	MIN GENERATOR LOADED	30%
		MAX GENERATOR LOADED	100%
		TOTAL kW REQUIRED	XXX
		TOTAL AMPS REQUIRED	XXX

CONDUIT AND WIRE SCHEDULE						
CONDUIT USE	CONDUIT DESIGNATION	CONDUIT SIZE	CONDUIT TYPE	CONDUCTOR SIZE AND NUMBER OF CONDUCTORS	CONDUIT FROM	CONDUIT TO
FLOAT SWITCH LSHH WETWELL HATCH LIMIT SWITCH	(A)	1 INCH	PVC	6#14	THE MAIN CONTROL CABINET	THE ISOLATION PEDESTAL
FLOW SENSOR	(B)	1 INCH	PVC	MANUFACTURER CABLE	THE MAIN CONTROL CABINET	THE FLOW METER VAULT
SUBMERSIBLE LEVEL TRANSMITTER	(C)	3/4 INCH	PVC	MANUFACTURER CABLE	THE MAIN CONTROL CABINET	THE ISOLATION PEDESTAL
VALVE VAULT HATCH LIMIT SWITCH	(D)	1 INCH	PVC	3#14	THE MAIN CONTROL CABINET	THE FLOW METER VAULT
SEAL FAIL / OVER TEMP	(E)	1 INCH	PVC	8#14	THE MAIN CONTROL CABINET	THE ISOLATION PEDESTAL
GENERATOR CONTROL SIGNALS (ATS)	(F)	1 INCH	PVC	8#14	THE MAIN CONTROL CABINET	THE GENERATOR
OUTSIDE AREA LIGHT	(G)	1 INCH	PVC	2#12, 1#12G	THE MAIN CONTROL CABINET	THE LIGHT POLE
VALVE VAULT SPARE	(H)	1 INCH	PVC	PULL CORD	THE MAIN CONTROL CABINET	THE VALVE VAULT
GENERATOR BATTERY CHARGER / BLOCK HEATER	(I)	1 INCH	PVC	4#10, 2#10G	THE MAIN CONTROL CABINET	THE GENERATOR
ISOLATION PEDESTAL HEATER	(J)	1 INCH	PVC	2#12, 1#12G	THE MAIN CONTROL CABINET	THE ISOLATION PEDESTAL
PUMP #1	(K)	1 INCH	PVC	3#8, 1#10G	THE MAIN CONTROL CABINET	THE ISOLATION PEDESTAL
PUMP #2	(L)	1 INCH	PVC	3#8, 1#10G	THE MAIN CONTROL CABINET	THE ISOLATION PEDESTAL
PUMP #3 (FUTURE)	(M)	1 INCH	PVC	3#8, 1#10G	THE MAIN CONTROL CABINET	THE ISOLATION PEDESTAL
GENERATOR MONITORING SIGNALS (PLC)	(N)	1 INCH	PVC	8#14	THE MAIN CONTROL CABINET	THE GENERATOR
GENERATOR POWER	(O)	2 INCH	PVC	3#1/0, 1#6G	THE MAIN CONTROL CABINET	THE GENERATOR
UNDERGROUND SERVICE	(P)	3 INCH	PVC	PULL ROPE	UNDERGROUND SERVICE	MAIN CONTROL ENCLOSURE PAD
SUBMERSIBLE LEVEL TRANSMITTER	(Q)	1 INCH	PGRC	MANUFACTURER CABLE	THE WET WELL	THE ISOLATION PEDESTAL
FLOAT SWITCH LSHH	(R)	3/4 INCH	PGRC	MANUFACTURER CABLE	THE WET WELL	THE ISOLATION PEDESTAL
ANTENNA SUPPORT	(W)	2 INCH	PGRC	MANUFACTURER CABLE	THE MAIN CONTROL CABINET	WEATHER HEAD

GENERAL NOTES: (CONDUIT INSTALLATION)

- ALL STRUT AND MOUNTING HARDWARE MUST BE STAINLESS STEEL.
- MYERS HUB FITTING MUST BE USED ON ALL CONDUIT PENETRATIONS.
- ALL CONDUIT MUST BE SCHEDULE 80 PVC.
- THE PROPER TOOLS MUST BE USED WHILE CUTTING, THREADING, BENDING, AND TIGHTENING ANY PVC COATED CONDUIT.
- THE PVE COATING MUST REMAIN INTACT ONLY 1 INCH OF THE COATING MAY BE REMOVED AT THE END OF THE CONDUIT TO ALLOW FOR THE THREAD.
- ANY CONDUIT WITH THE DAMAGED COATING MUST BE REPLACED.
- THE COATING TOUCH UP PAINT IS ONLY TO BE USED FOR COSMETIC BLEMISHES.
- ALL THREADED CONNECTIONS MUST BE COPPER COATED AND TIGHTENED APPROPRIATELY.
- ALL UNDERGROUND CONDUIT RUNS MUST BE INSPECTED PRIOR TO BACKFILL.



(PROJECT NAME)
INSTRUMENTATION & CONTROLS
CONDUIT AND WIRE SCHEDULE
 DESCHUTES COUNTY, OREGON



REVISIONS:

(CONSULTANT ENGINEER NAME, ADDRESS & PHONE NUMBER)


DESIGNED BY: XXX
 DRAWN BY: XXX
 SCALE: NONE
 FILE: E-004.dwg
 DATE: _____

VERIFY SCALES
 0 1"
 BAR EQUALS ONE INCH ON ORIGINAL DRAWING

SHEET:
E-004
 COB # (XXXXXX)

FOR SAMPLE ONLY

RECORD DRAWINGS
 REVISIONS DRAWN BY: XX DATE: XX/XX/XX
 THESE RECORD DRAWINGS HAVE BEEN PREPARED, IN PART, ON THE BASIS OF INFORMATION COMPILED BY OTHERS. THEY ARE NOT INTENDED TO REPRESENT IN DETAIL THE EXACT LOCATION, TYPE OF COMPONENT NOR MANNER OF CONSTRUCTION. THE ENGINEER WILL NOT BE RESPONSIBLE FOR ANY ERRORS OR OMISSIONS WHICH HAVE BEEN INCORPORATED INTO THE RECORD DRAWINGS.

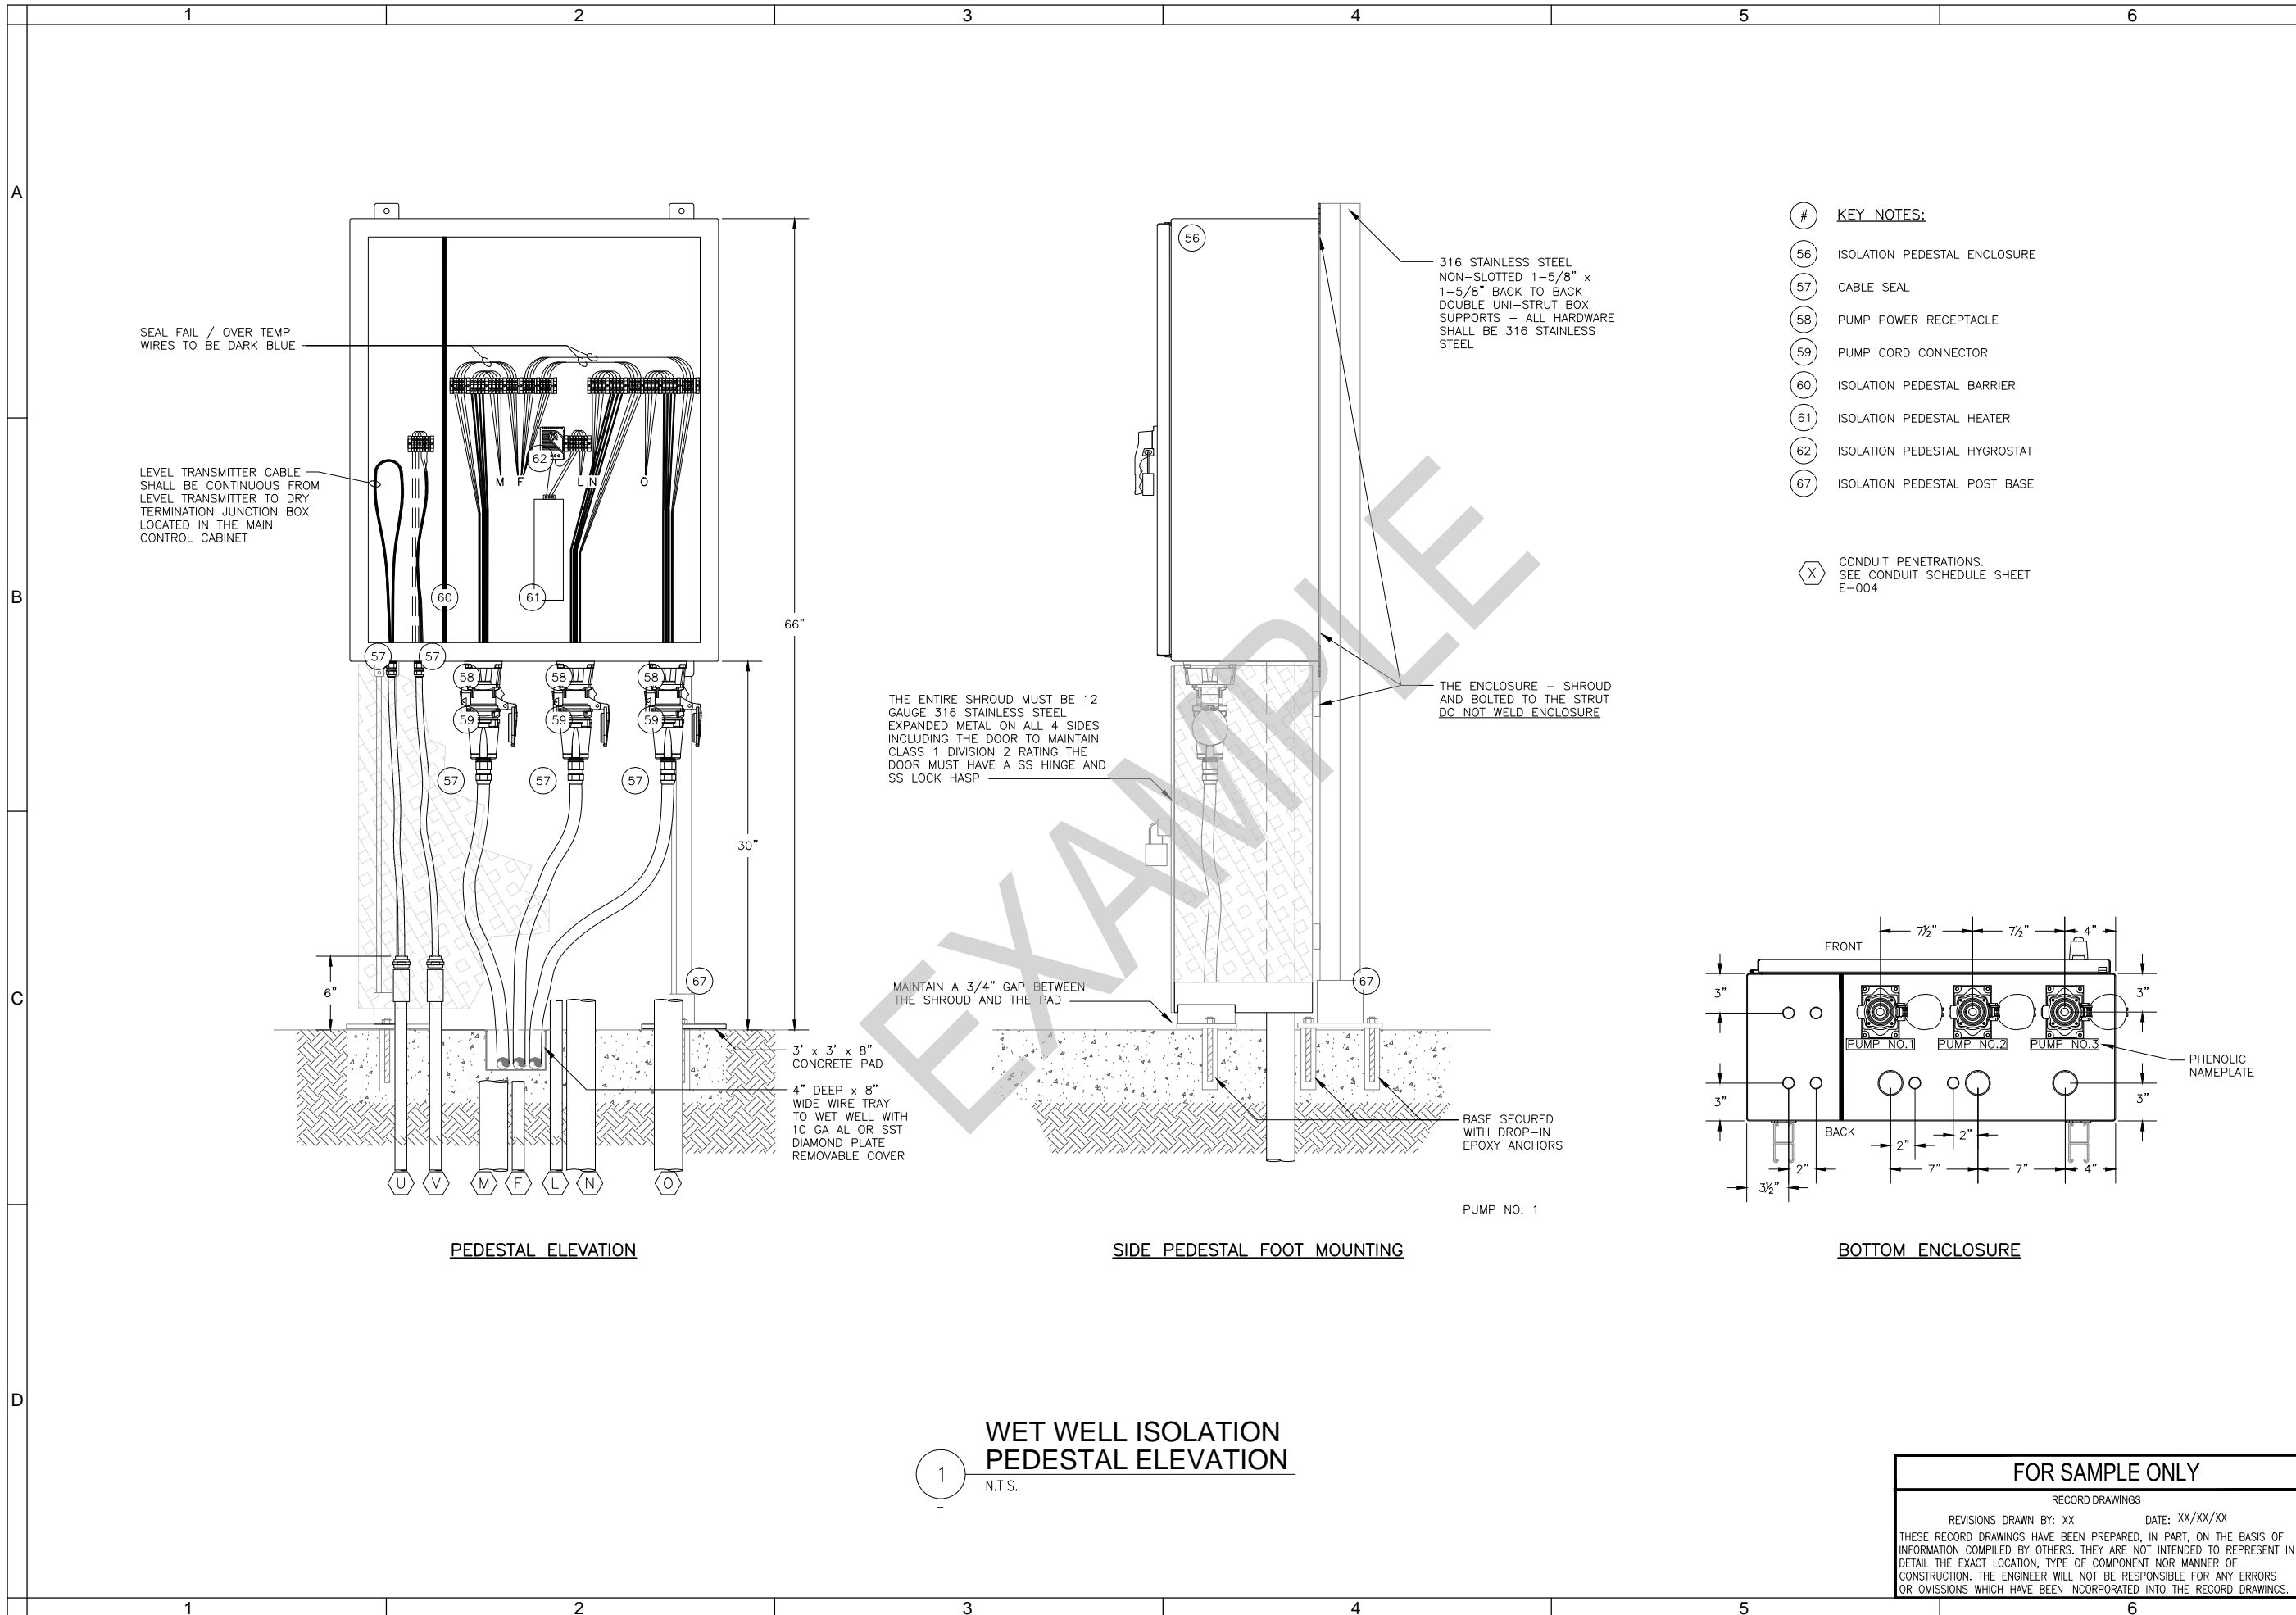

WET WELL ISOLATION PEDESTAL ELEVATION

1 N.T.S.

FOR SEALS AND SIGNATURES

(PROJECT NAME)
INSTRUMENTATION & CONTROLS
WETWELL ISOLATION PEDESTAL
 DESCHUTES COUNTY, OREGON



REVISIONS:

(CONSULTANT ENGINEER NAME, ADDRESS & PHONE NUMBER)


DESIGNED BY: XXX
 DRAWN BY: XXX
 SCALE: NONE
 FILE: E-005.dwg
 DATE: _____

VERIFY SCALES
 0 1"
 BAR EQUALS ONE INCH ON ORIGINAL DRAWING

SHEET: **E-005**
 COB # (XXXXXX)


FOR SAMPLE ONLY

RECORD DRAWINGS
 REVISIONS DRAWN BY: XX DATE: XX/XX/XX
 THESE RECORD DRAWINGS HAVE BEEN PREPARED, IN PART, ON THE BASIS OF INFORMATION COMPILED BY OTHERS. THEY ARE NOT INTENDED TO REPRESENT IN DETAIL THE EXACT LOCATION, TYPE OF COMPONENT NOR MANNER OF CONSTRUCTION. THE ENGINEER WILL NOT BE RESPONSIBLE FOR ANY ERRORS OR OMISSIONS WHICH HAVE BEEN INCORPORATED INTO THE RECORD DRAWINGS.

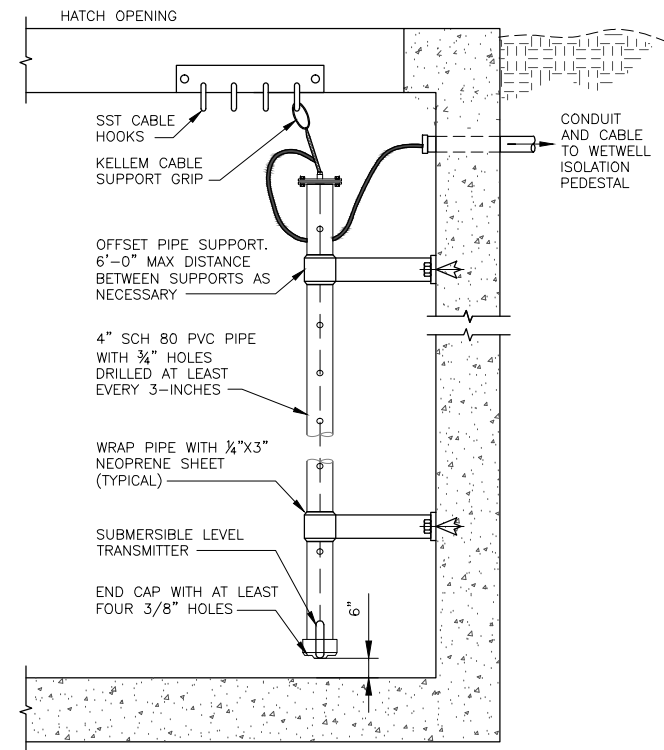

1 SUBMERSIBLE LEVEL TRANSMITTER


N.T.S.

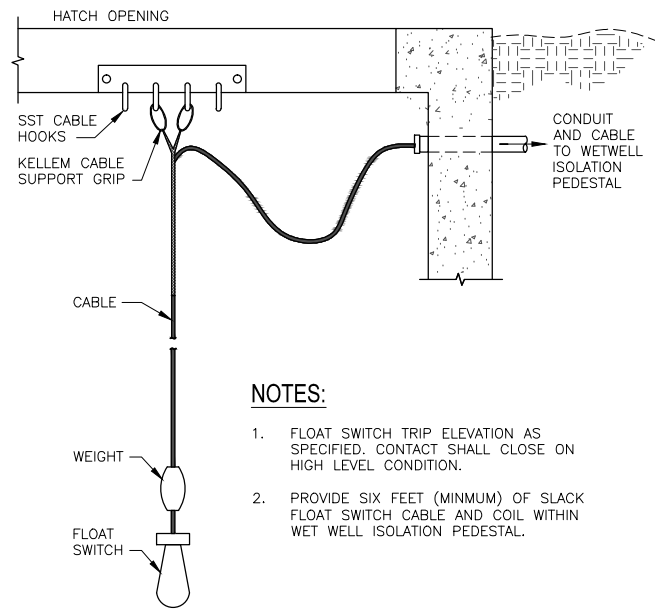

2 SUSPENDED FLOAT SWITCH

N.T.S.


- NOTES:**
- FLOAT SWITCH TRIP ELEVATION AS SPECIFIED. CONTACT SHALL CLOSE ON HIGH LEVEL CONDITION.
 - PROVIDE SIX FEET (MINIMUM) OF SLACK FLOAT SWITCH CABLE AND COIL WITHIN WET WELL ISOLATION PEDESTAL.

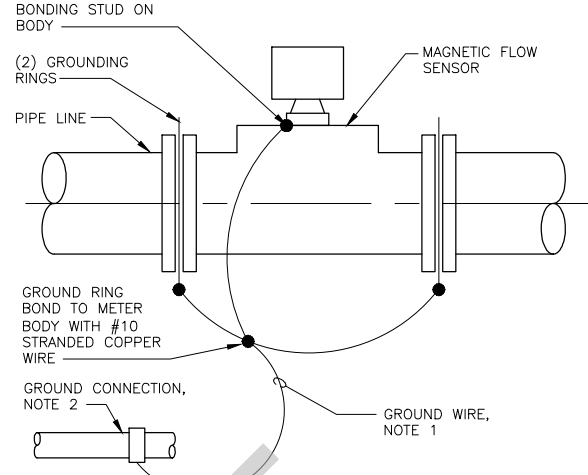

3 MAGNETIC FLOW METER GROUNDING RING BONDING

N.T.S.

- NOTES:**
- NO. 10 AWG INSULATED IF LENGTH IS LESS THAN 6'. IF MORE THAN 6', INSTALL CONDUCTOR IN 3/4" CONDUIT.
 - BOND MAGMETER TO ONE OF THE FOLLOWING ACCEPTABLE GROUNDS:
A. POWER CIRCUIT GROUND CONDUCTOR AT TRANSMITTER.
B. NEAREST AVAILABLE EQUIPMENT GROUND CONNECTION POINT.
C. SEPARATE TAIL FROM EMBEDDED GROUND MAT.

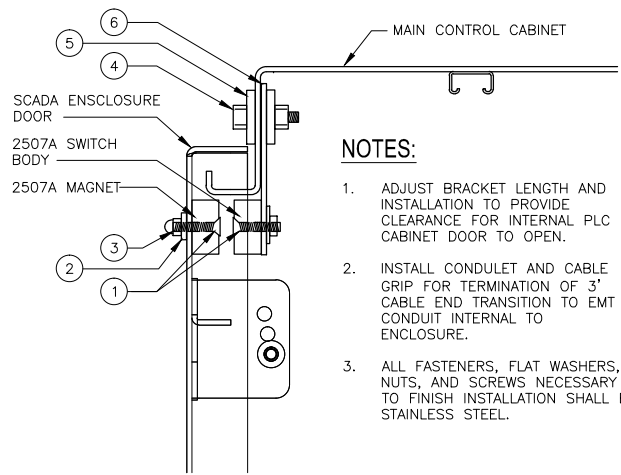


4 MAIN CONTROL CABINET INTRUSION SWITCH

N.T.S.

- NOTES:**
- ADJUST BRACKET LENGTH AND INSTALLATION TO PROVIDE CLEARANCE FOR INTERNAL PLC CABINET DOOR TO OPEN.
 - INSTALL CONDULET AND CABLE GRIP FOR TERMINATION OF 3' CABLE END TRANSITION TO EMT CONDUIT INTERNAL TO ENCLOSURE.
 - ALL FASTENERS, FLAT WASHERS, NUTS, AND SCREWS NECESSARY TO FINISH INSTALLATION SHALL BE STAINLESS STEEL.


BILL OF MATERIALS	
ITEM	DESCRIPTION
1	8-32 7/8" FLATHEAD MACHINE SCREW, STAINLESS STEEL
2	#8 BONDED SEALING WASHER, STAINLESS STEEL
3	8-32 ACORN NUT, STAINLESS STEEL
4	1/4"-28 x 3/4" HEX CAP SCREW, STAINLESS STEEL
5	1/4" BONDED SEALING WASHER, STAINLESS STEEL
6	ALUMINUM BRACKET, SHOP SUPPLIED

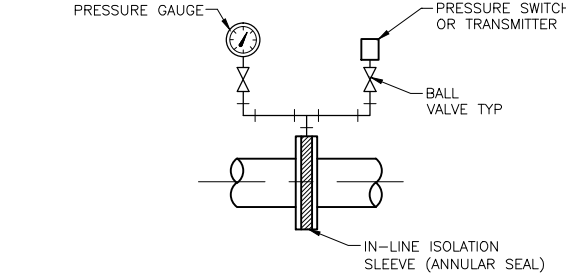

5 IN-LINE ISOLATION SLEEVE PRESSURE SWITCH/TRANSMITTER

N.T.S.


- NOTES:**
- MOUNT PRESSURE GAUGE IN VERTICAL FOR VIEWING.
 - INDICATOR AND PRESSURE SWITCH INSTALLATION AS SPECIFIED FOR SINGLE INSTRUMENT INSTALLATIONS, MOUNT DEVICE DIRECTLY TO ANNULAR SEAL.

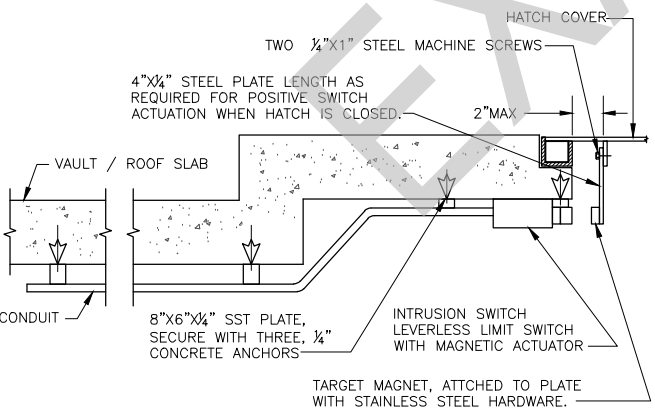

6 HATCH INTRUSION SWITCH INSTALLATION

N.T.S.


- NOTES:**
- THE INSTALLATION DETAIL SHOWN IS GENERIC. ACTUAL INSTALLATIONS MAY VARY.

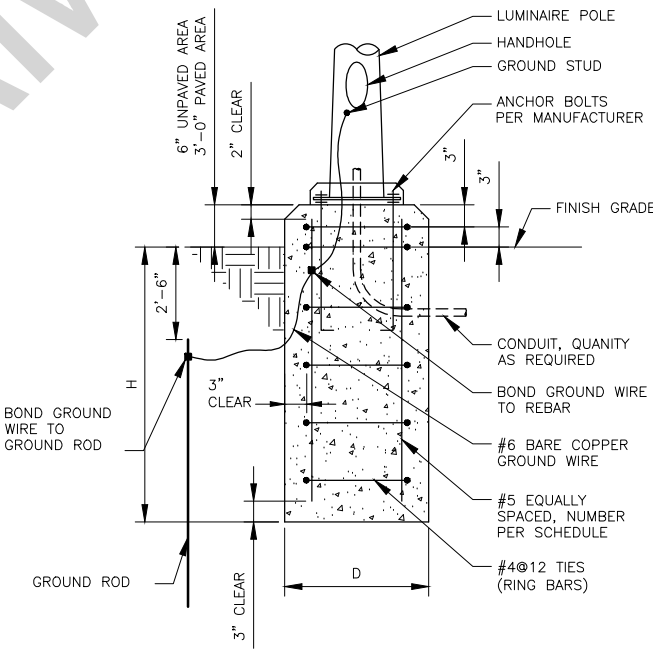

DIMENSION SCHEDULE			
POLE HEIGHT	MINIMUM D	MINIMUM H	VERTICAL REBAR EACH
UP TO 10'	2'-0"	4'-6"	6
11' TO 20'	2'-0"	6'-6"	6

7 LIGHT STANDARD BASE

N.T.S.

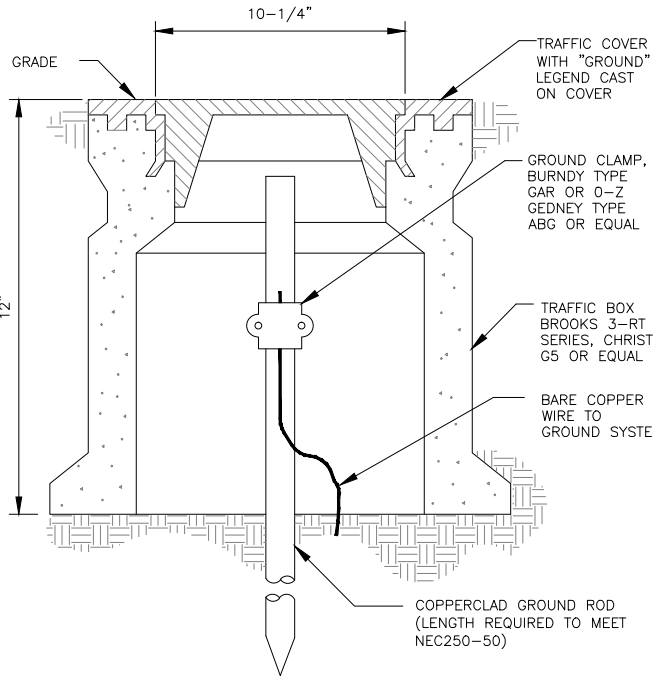

8 GROUND WELL AND ROD DETAIL

N.T.S.

FOR SAMPLE ONLY

RECORD DRAWINGS

DESIGNED BY: XXX
DRAWN BY: XXX
SCALE: NONE
FILE: E-006.dwg
DATE:

REVISIONS DRAWN BY: XX DATE: XX/XX/XX

THESE RECORD DRAWINGS HAVE BEEN PREPARED, IN PART, ON THE BASIS OF INFORMATION COMPILED BY OTHERS. THEY ARE NOT INTENDED TO REPRESENT IN DETAIL THE EXACT LOCATION, TYPE OF COMPONENT NOR MANNER OF CONSTRUCTION. THE ENGINEER WILL NOT BE RESPONSIBLE FOR ANY ERRORS OR OMISSIONS WHICH HAVE BEEN INCORPORATED INTO THE RECORD DRAWINGS.

FOR SEALS AND SIGNATURES

(PROJECT NAME)
INSTRUMENTATION & CONTROLS
ELECTRICAL DETAILS
DESCHUTES COUNTY, OREGON




REVISIONS:

(CONSULTANT ENGINEER NAME, ADDRESS & PHONE NUMBER)

DESIGNED BY: XXX
DRAWN BY: XXX
SCALE: NONE
FILE: E-006.dwg
DATE:

VERIFY SCALES
0 1" BAR EQUALS ONE INCH ON ORIGINAL DRAWING

SHEET: **E-006**
COB# (XXXXXX)

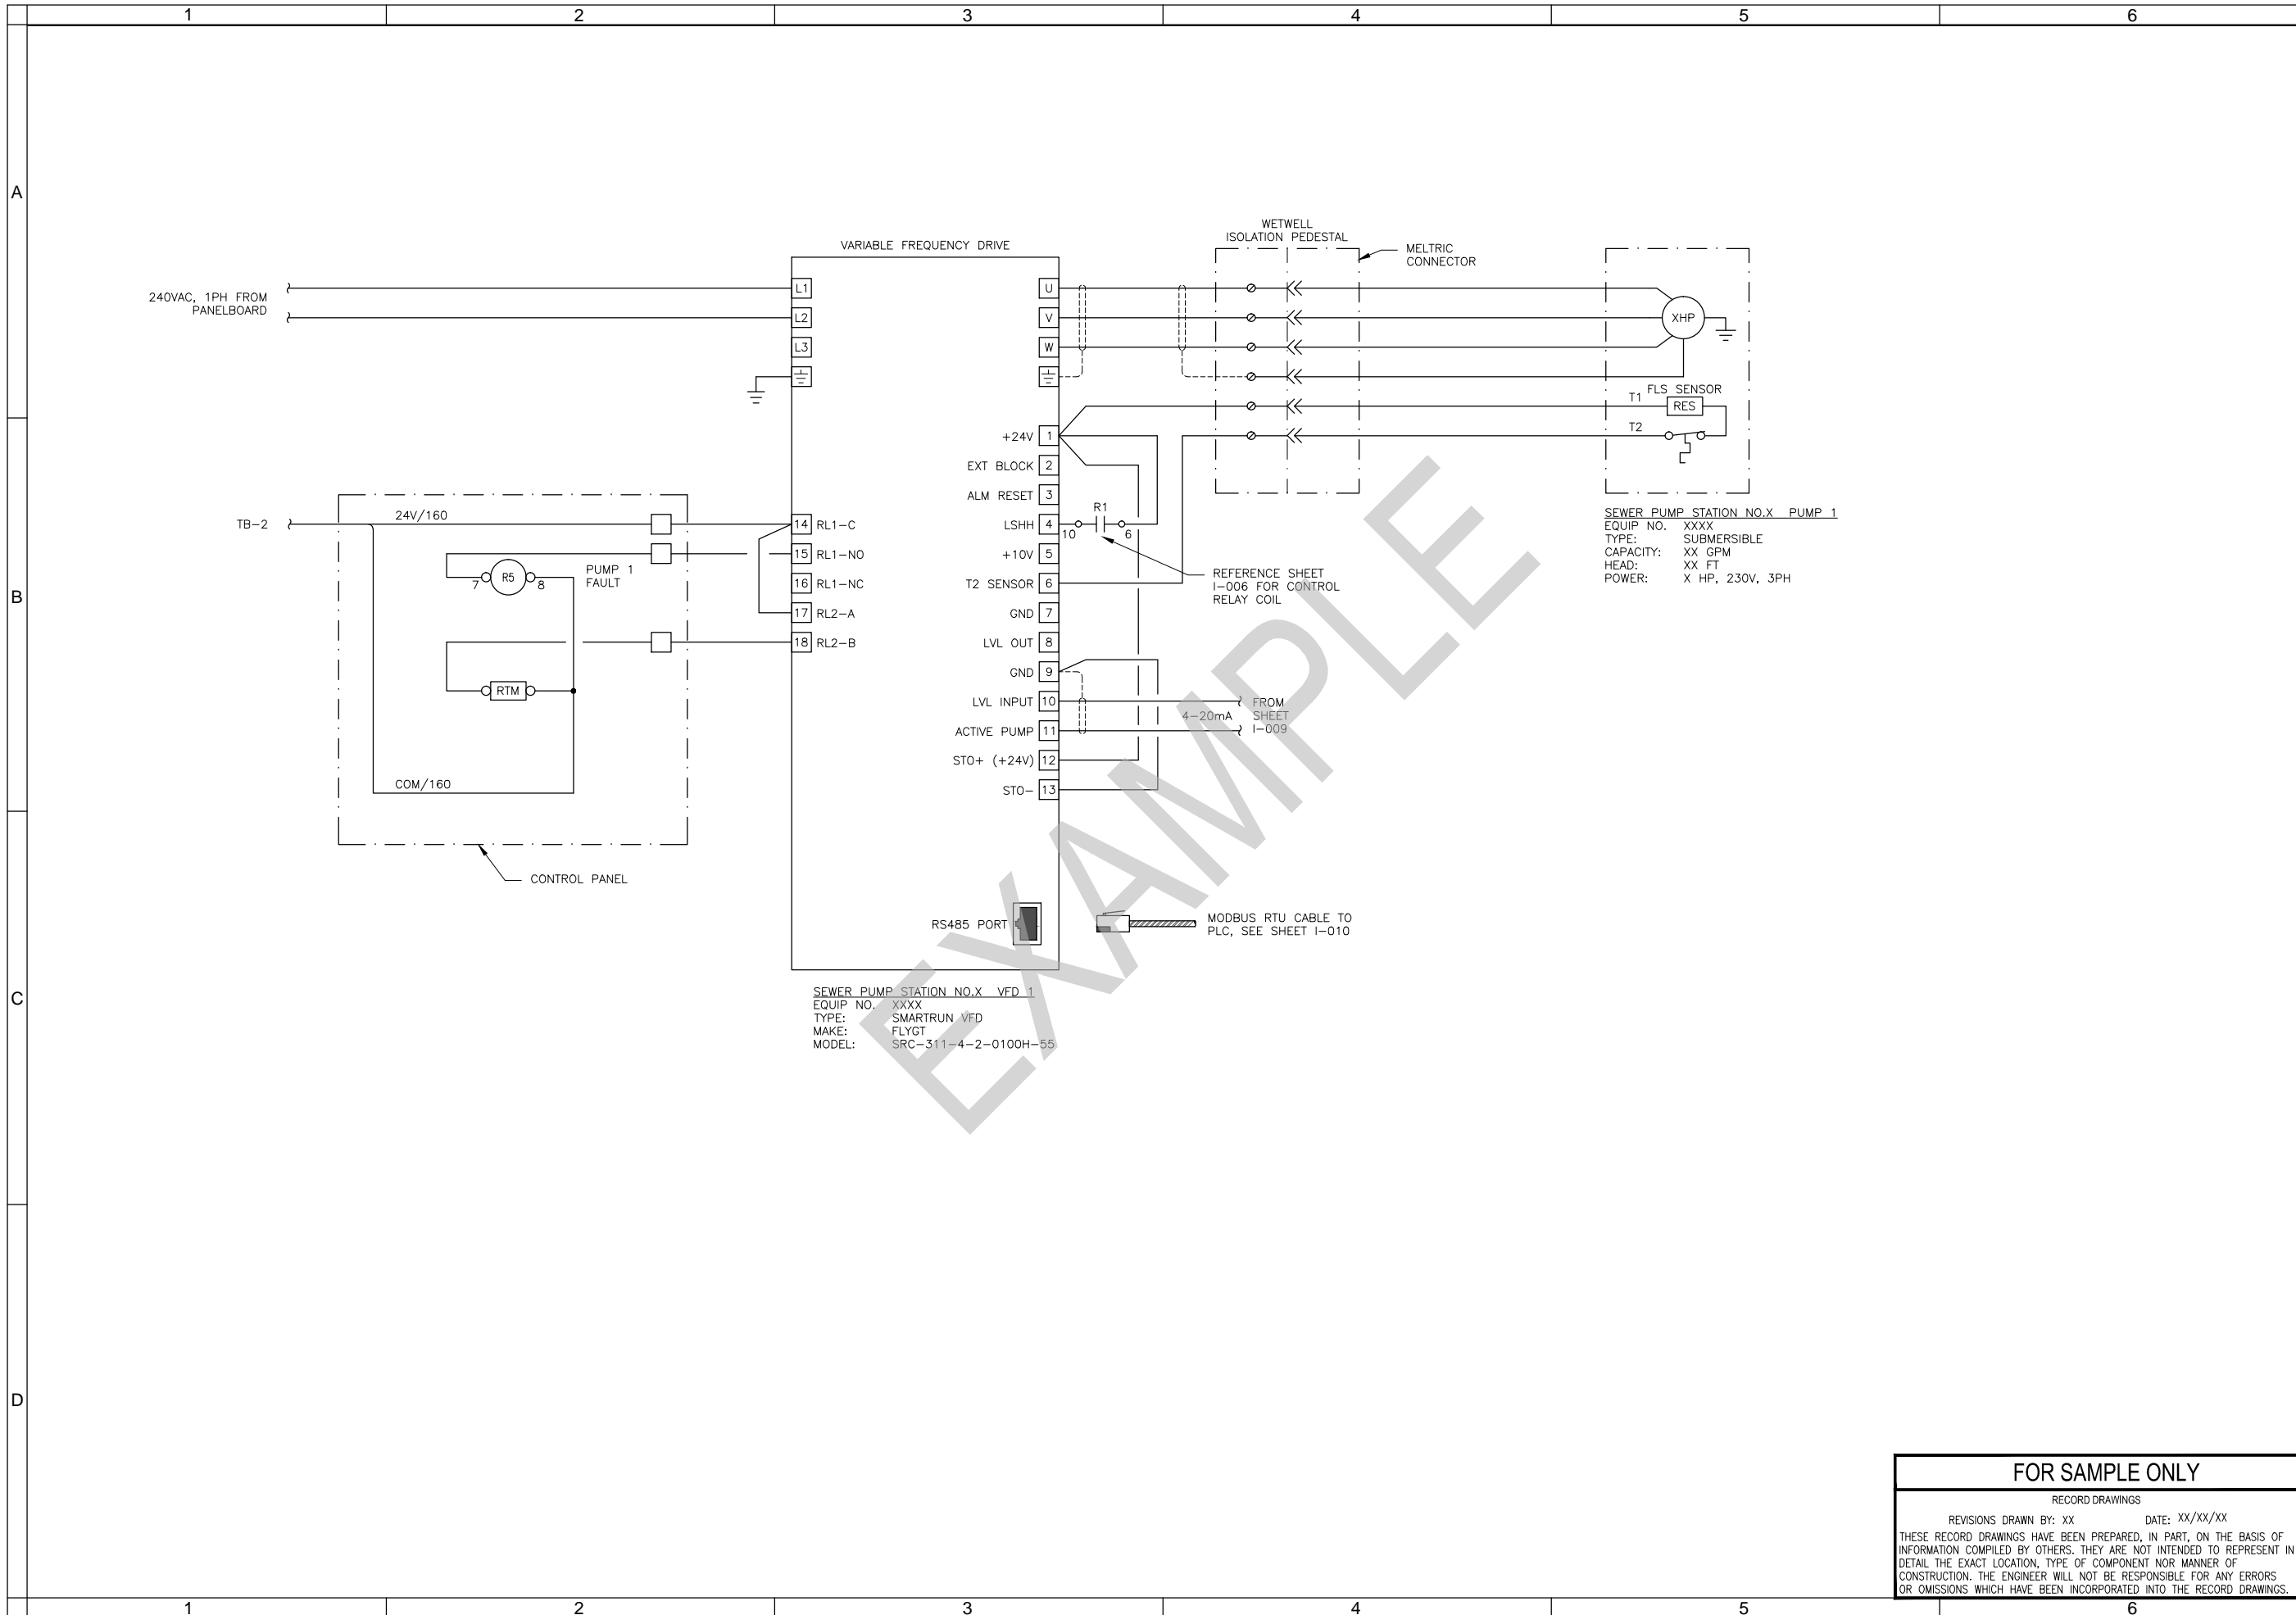

FOR SEALS
AND SIGNATURES

(PROJECT NAME)
SEWER PUMP STATION NO. X
PUMP 1 WIRING DIAGRAM
 DESCHUTES COUNTY, OREGON



REVISIONS:


(CONSULTANT
 ENGINEER
 NAME, ADDRESS
 & PHONE
 NUMBER)

DESIGNED BY: XXX
 DRAWN BY: XXX
 SCALE: NONE
 FILE: E-007.dwg
 DATE:

VERIFY SCALES
 0 1"
 BAR EQUALS ONE INCH
 ON ORIGINAL DRAWING

SHEET:
E-007
 COB# (XXXXXX)

FOR SAMPLE ONLY
 RECORD DRAWINGS
 REVISIONS DRAWN BY: XX DATE: XX/XX/XX
 THESE RECORD DRAWINGS HAVE BEEN PREPARED, IN PART, ON THE BASIS OF
 INFORMATION COMPILED BY OTHERS. THEY ARE NOT INTENDED TO REPRESENT IN
 DETAIL THE EXACT LOCATION, TYPE OF COMPONENT NOR MANNER OF
 CONSTRUCTION. THE ENGINEER WILL NOT BE RESPONSIBLE FOR ANY ERRORS
 OR OMISSIONS WHICH HAVE BEEN INCORPORATED INTO THE RECORD DRAWINGS.

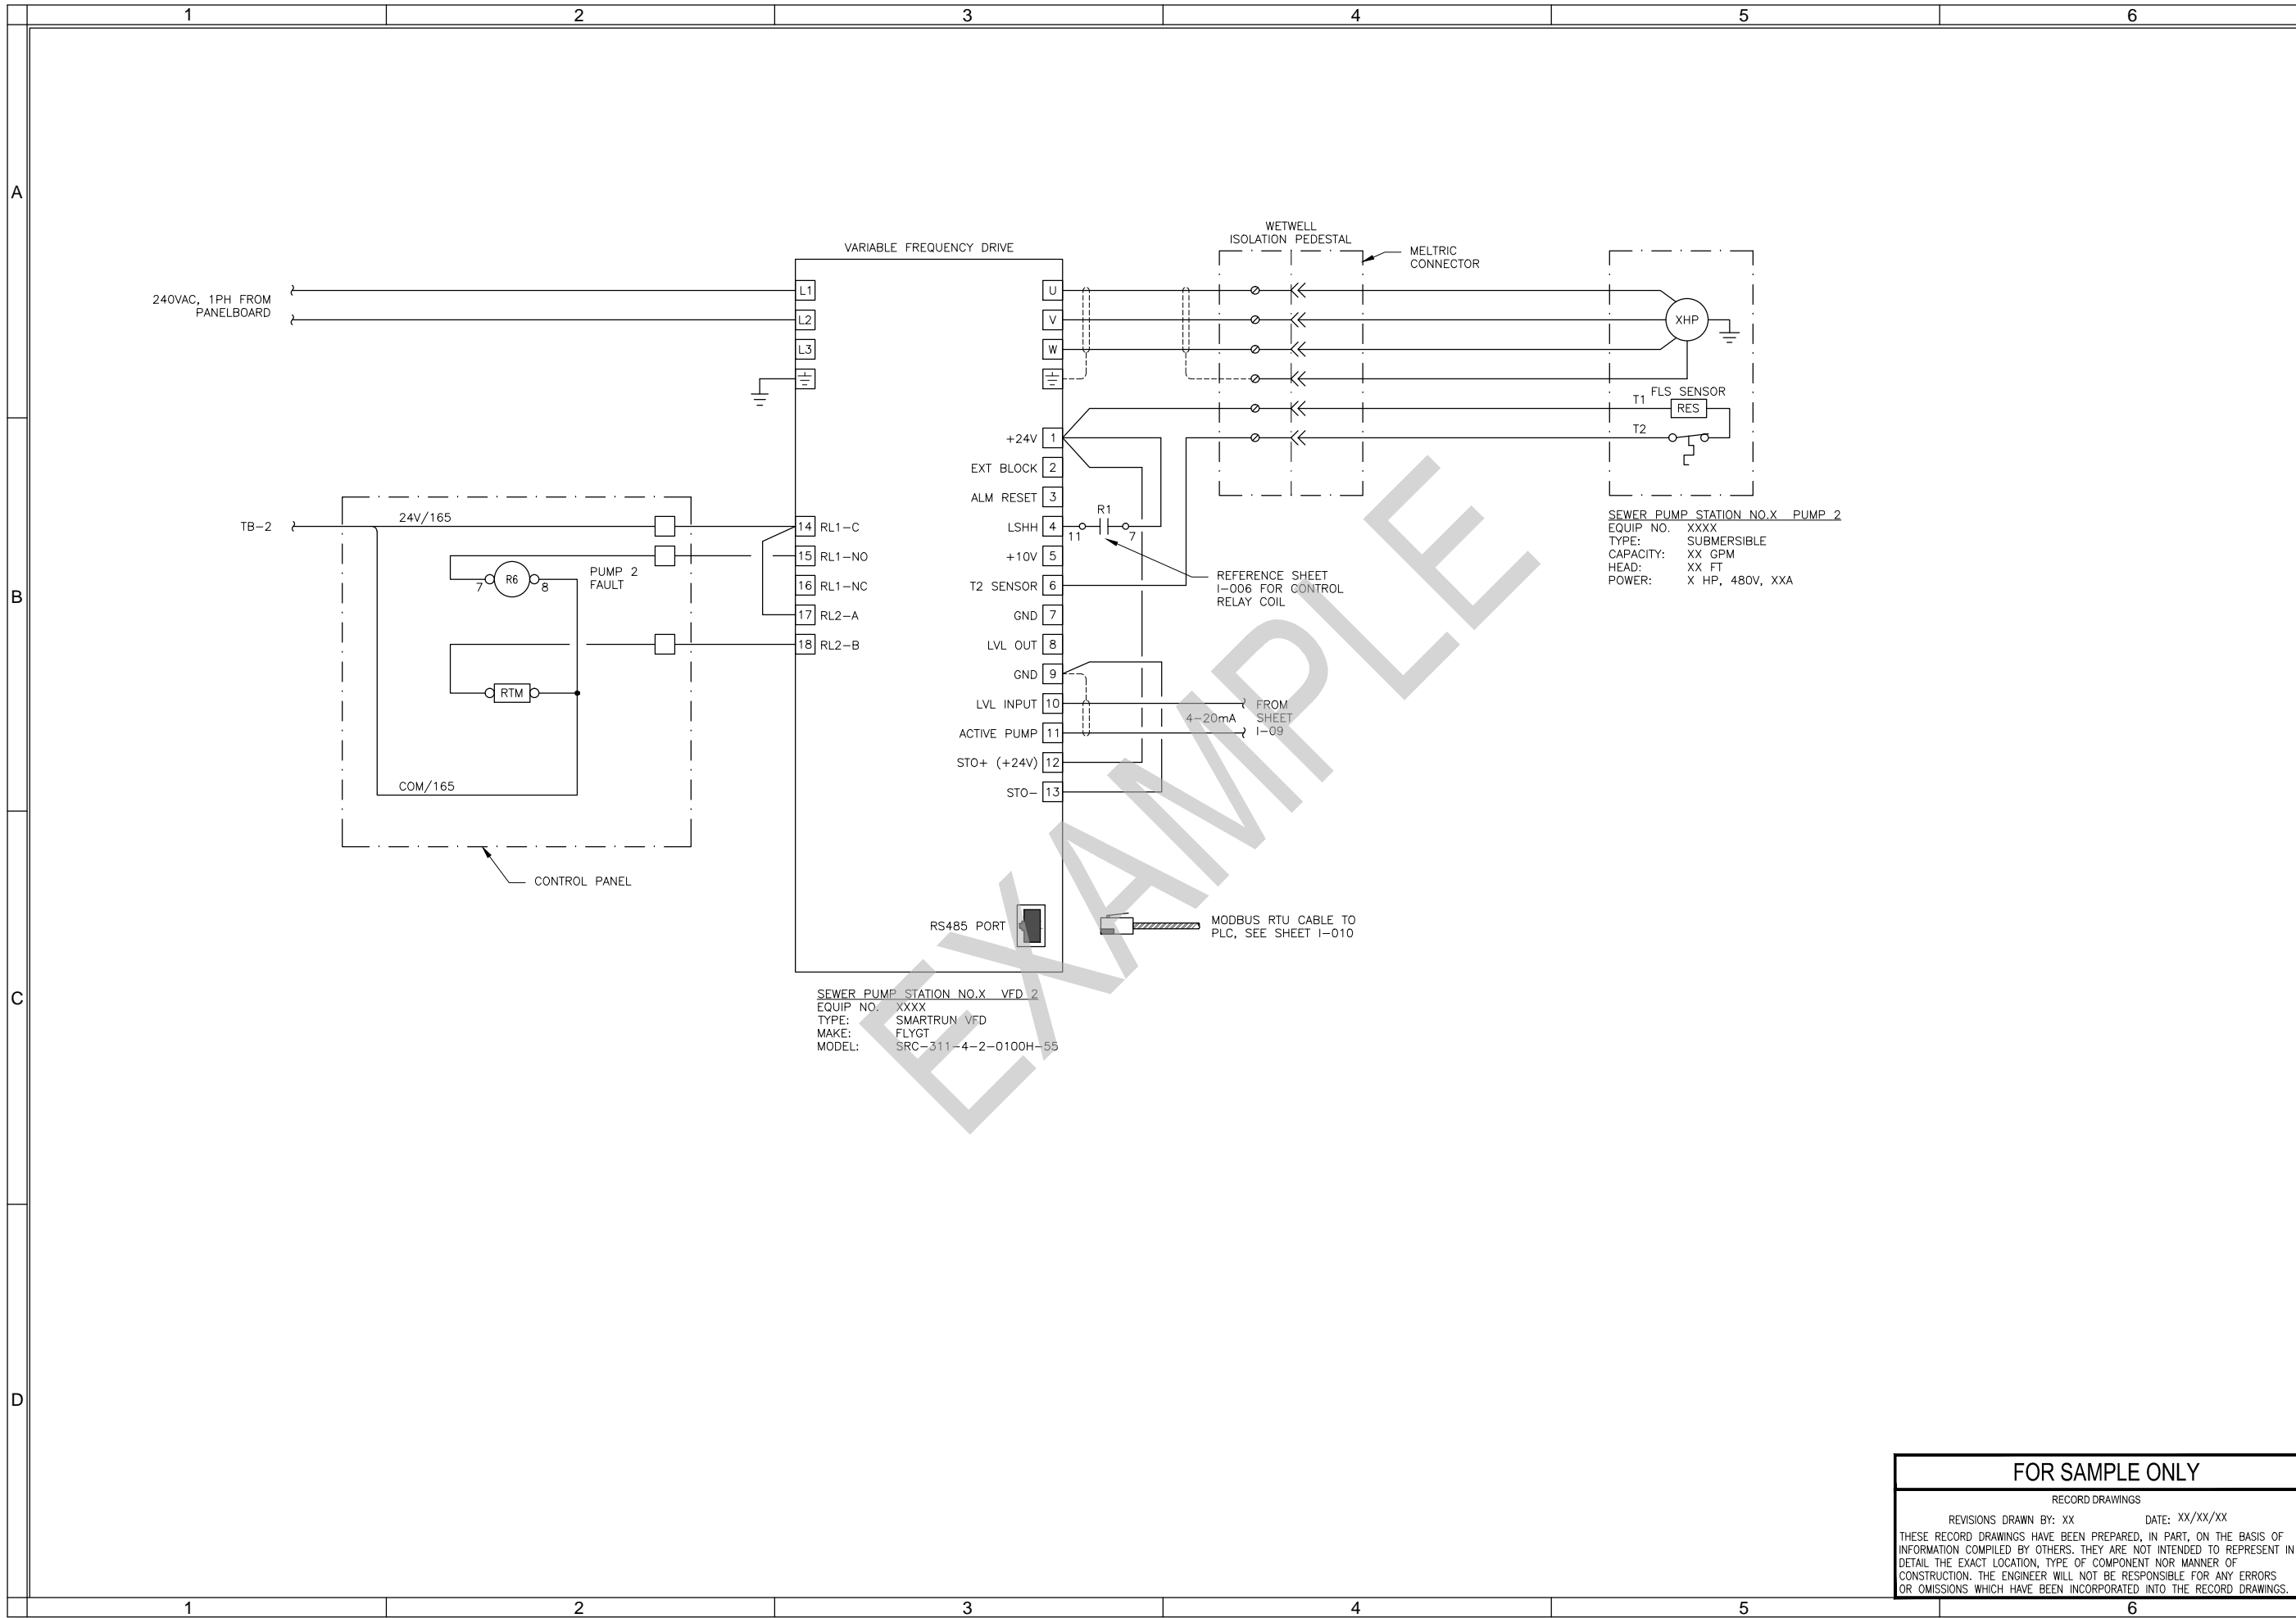

FOR SEALS AND SIGNATURES


(PROJECT NAME)
SEWER PUMP STATION NO. X
PUMP 2 WIRING DIAGRAM
 DESCHUTES COUNTY, OREGON



REVISIONS:


(CONSULTANT ENGINEER NAME, ADDRESS & PHONE NUMBER)

DESIGNED BY: XXX
 DRAWN BY: XXX
 SCALE: NONE
 FILE: E-008.dwg
 DATE: _____

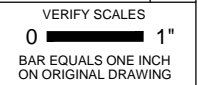

SHEET: **E-008**
 COB# (XXXXXX)

FOR SAMPLE ONLY
 RECORD DRAWINGS
 REVISIONS DRAWN BY: XX DATE: XX/XX/XX
 THESE RECORD DRAWINGS HAVE BEEN PREPARED, IN PART, ON THE BASIS OF INFORMATION COMPILED BY OTHERS. THEY ARE NOT INTENDED TO REPRESENT IN DETAIL THE EXACT LOCATION, TYPE OF COMPONENT NOR MANNER OF CONSTRUCTION. THE ENGINEER WILL NOT BE RESPONSIBLE FOR ANY ERRORS OR OMISSIONS WHICH HAVE BEEN INCORPORATED INTO THE RECORD DRAWINGS.

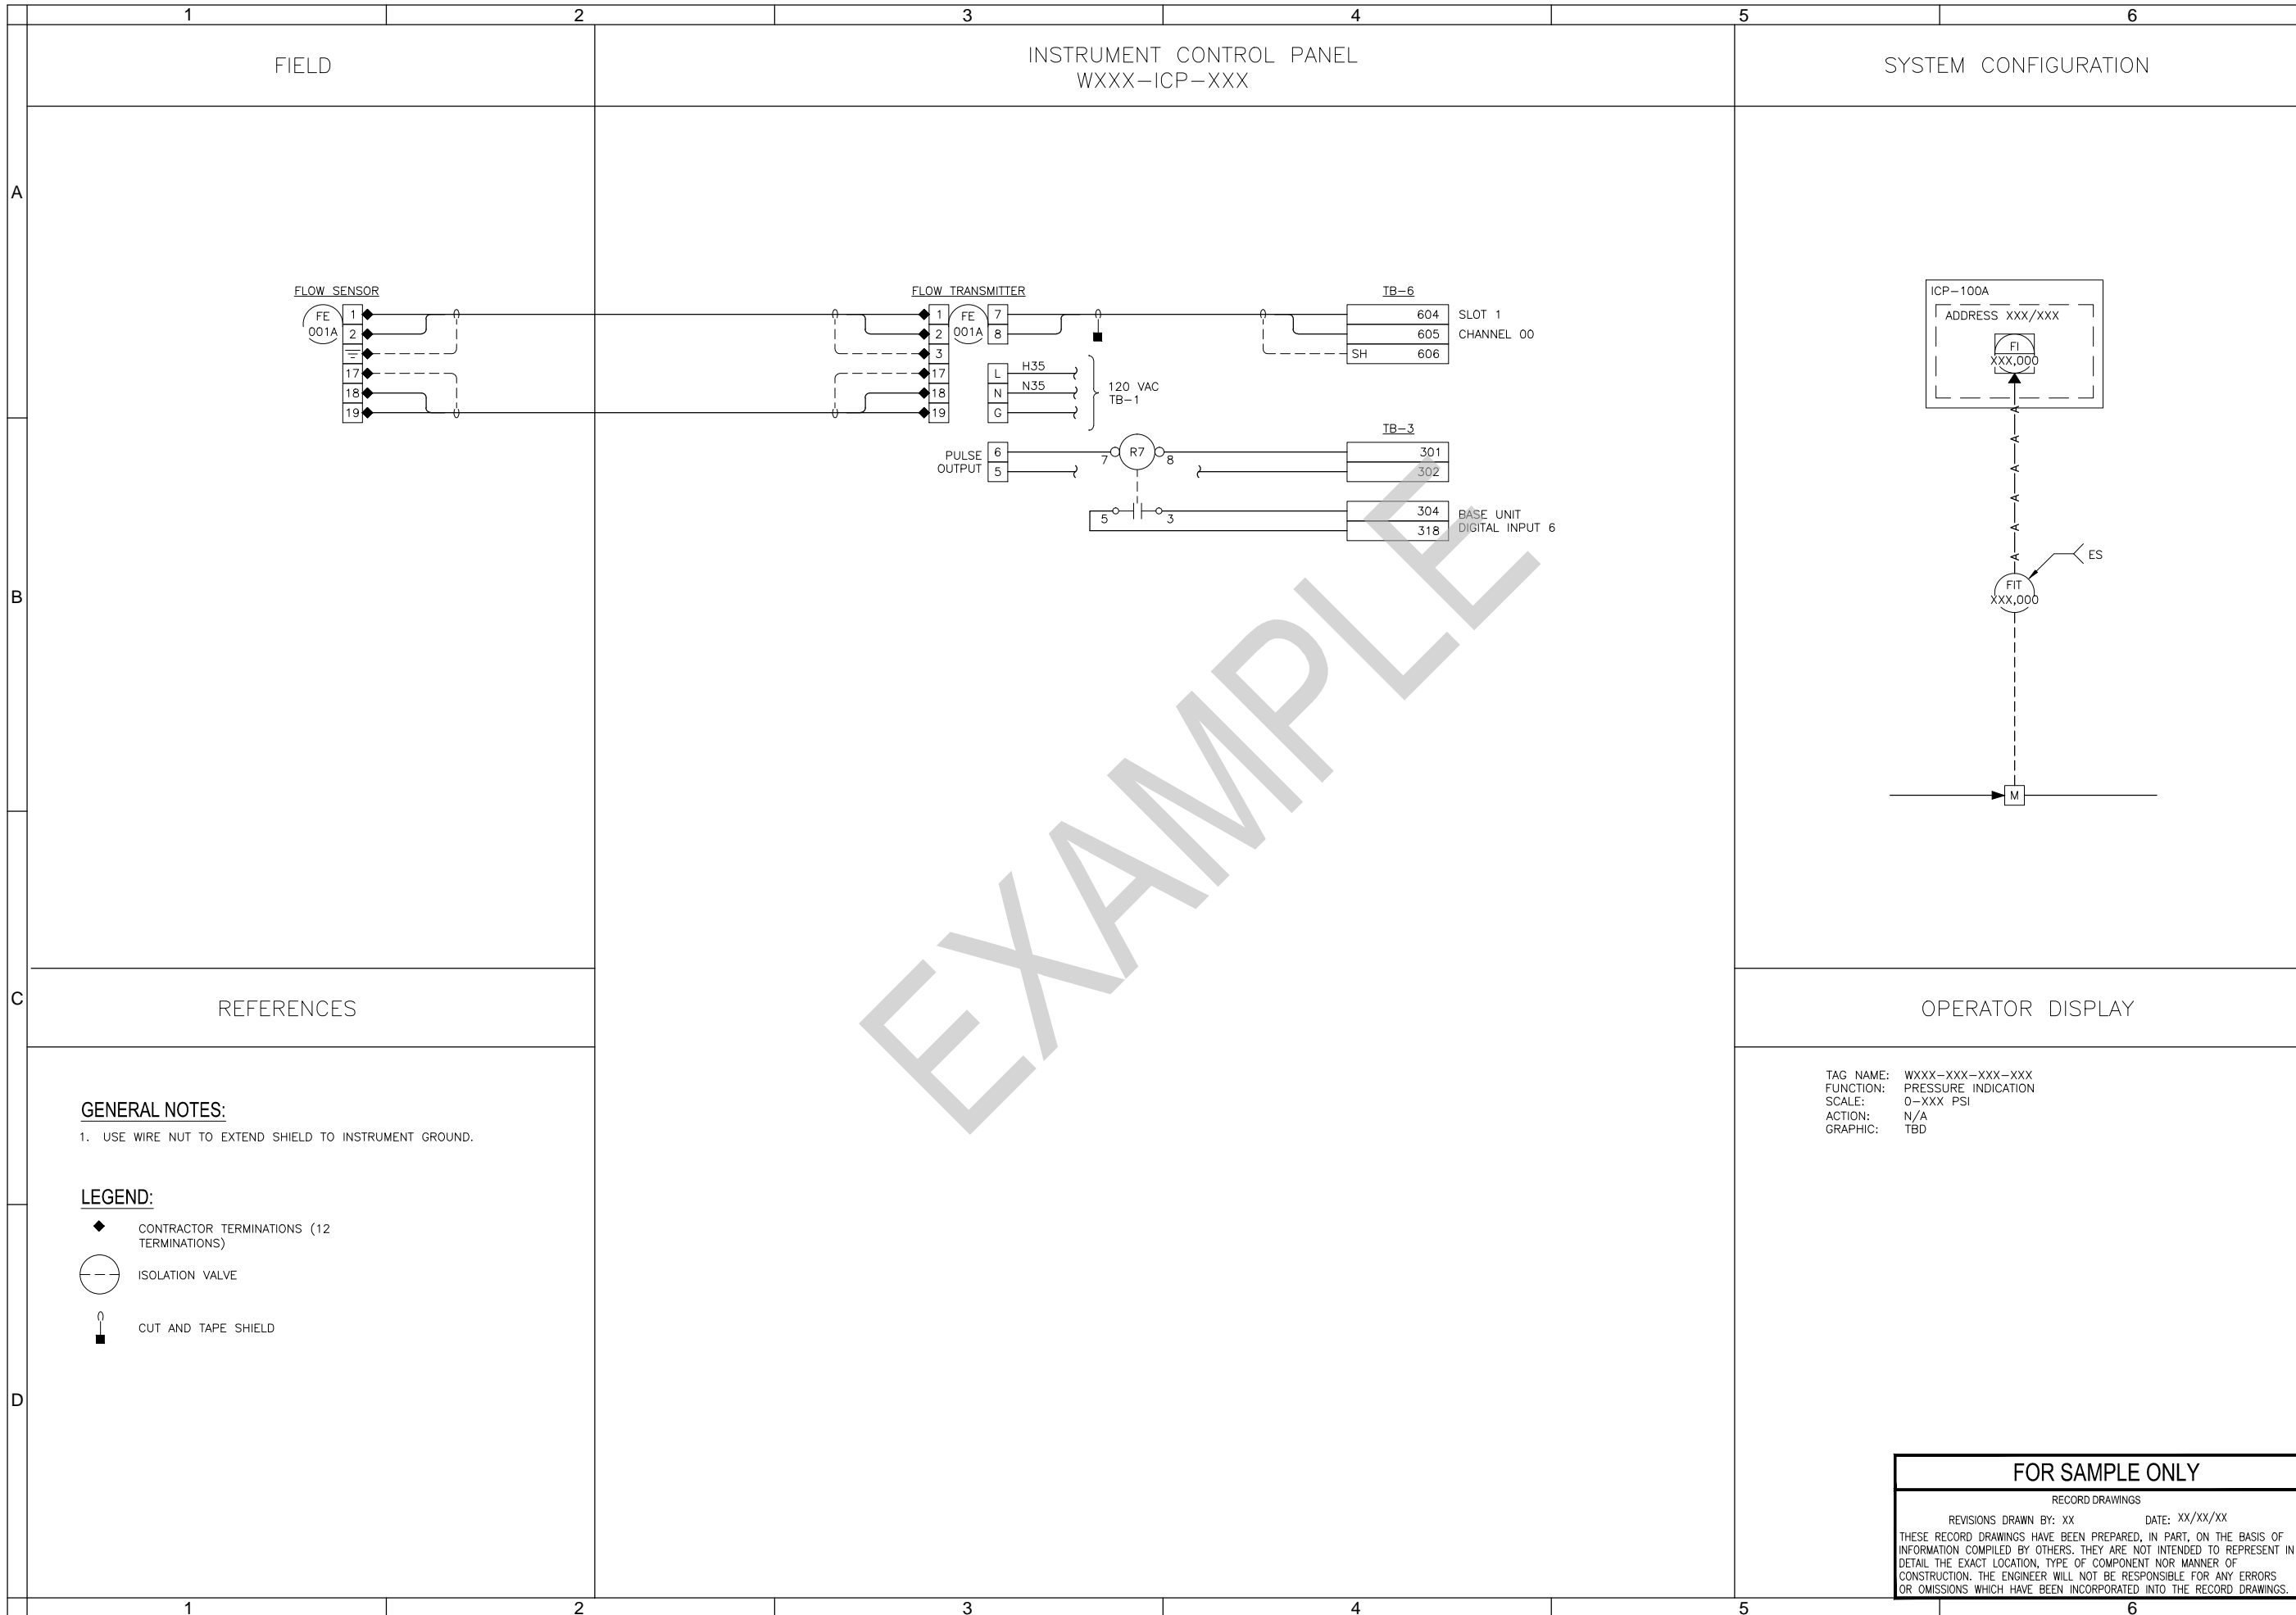


FLOW SENSOR

FLOW TRANSMITTER

INSTRUMENT CONTROL PANEL
WXXX-ICP-XXX

SYSTEM CONFIGURATION

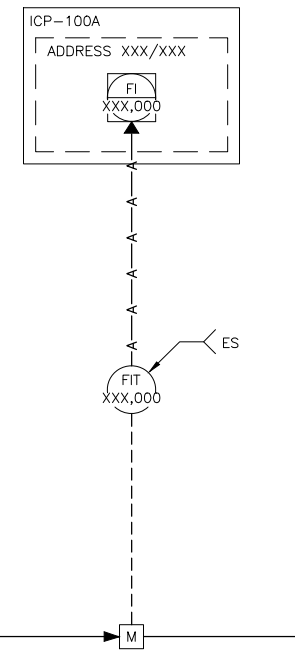

REFERENCES

OPERATOR DISPLAY

GENERAL NOTES:

- 1. USE WIRE NUT TO EXTEND SHIELD TO INSTRUMENT GROUND.

LEGEND:

- ◆ CONTRACTOR TERMINATIONS (12 TERMINATIONS)
- ISOLATION VALVE
- CUT AND TAPE SHIELD

TAG NAME: WXXX-XXX-XXX-XXX
 FUNCTION: PRESSURE INDICATION
 SCALE: 0-XXX PSI
 ACTION: N/A
 GRAPHIC: TBD

FOR SEALS AND SIGNATURES

(PROJECT NAME)
INSTRUMENTATION & CONTROLS
PUMP STATION FLOW LOOP SHEET
 DESCHUTES COUNTY, OREGON



REVISIONS:


(CONSULTANT ENGINEER NAME, ADDRESS & PHONE NUMBER)

DESIGNED BY: XXX
 DRAWN BY: XXX
 SCALE: NONE
 FILE: E-009.dwg
 DATE: _____

VERIFY SCALES
 0 1"
 BAR EQUALS ONE INCH ON ORIGINAL DRAWING

SHEET: **E-009**
 COB# (XXXXXX)

FOR SAMPLE ONLY
 RECORD DRAWINGS
 REVISIONS DRAWN BY: XX DATE: xx/xx/xx
 THESE RECORD DRAWINGS HAVE BEEN PREPARED, IN PART, ON THE BASIS OF INFORMATION COMPILED BY OTHERS. THEY ARE NOT INTENDED TO REPRESENT IN DETAIL THE EXACT LOCATION, TYPE OF COMPONENT NOR MANNER OF CONSTRUCTION. THE ENGINEER WILL NOT BE RESPONSIBLE FOR ANY ERRORS OR OMISSIONS WHICH HAVE BEEN INCORPORATED INTO THE RECORD DRAWINGS.

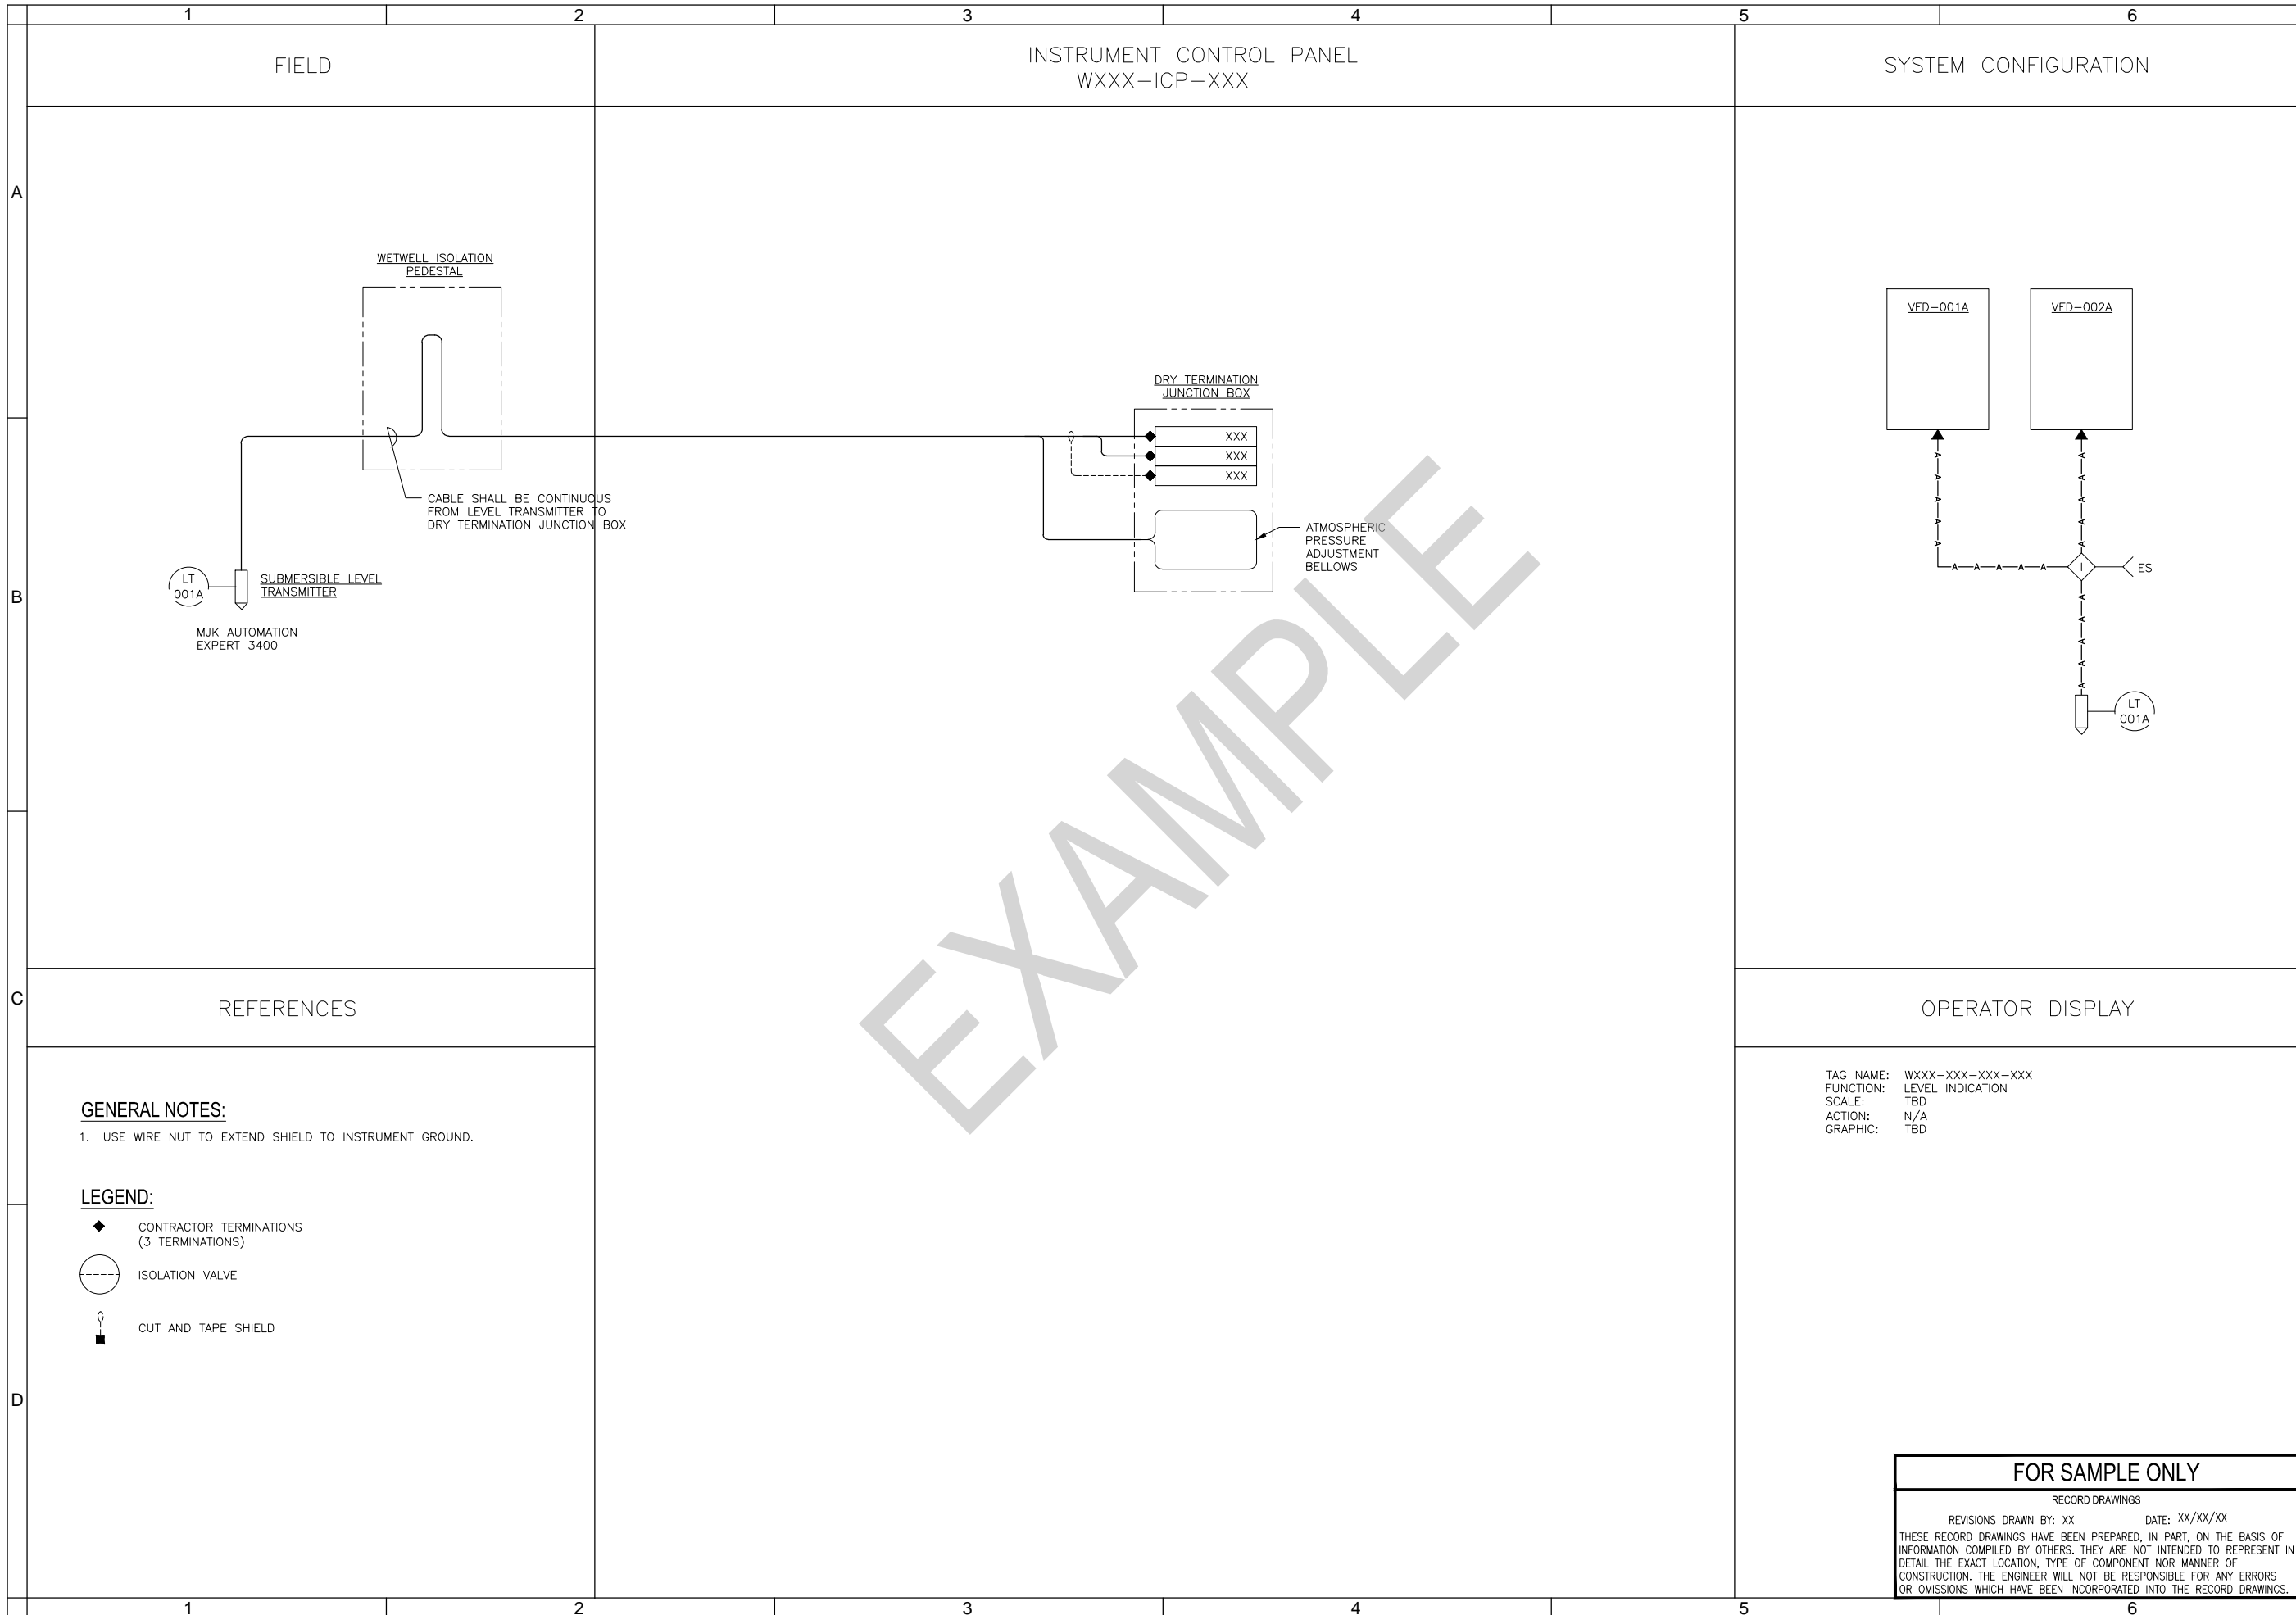

FOR SEALS AND SIGNATURES


(PROJECT NAME)
INSTRUMENTATION & CONTROLS
WETWELL LEVEL LOOP SHEET
 DESCHUTES COUNTY, OREGON



REVISIONS:

(CONSULTANT ENGINEER NAME, ADDRESS & PHONE NUMBER)


DESIGNED BY: XXX
 DRAWN BY: XXX
 SCALE: NONE
 FILE: E-010.dwg
 DATE: _____

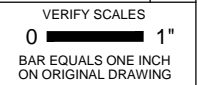

FOR SAMPLE ONLY

RECORD DRAWINGS
 REVISIONS DRAWN BY: XX DATE: xx/xx/xx
 THESE RECORD DRAWINGS HAVE BEEN PREPARED, IN PART, ON THE BASIS OF INFORMATION COMPILED BY OTHERS. THEY ARE NOT INTENDED TO REPRESENT IN DETAIL THE EXACT LOCATION, TYPE OF COMPONENT NOR MANNER OF CONSTRUCTION. THE ENGINEER WILL NOT BE RESPONSIBLE FOR ANY ERRORS OR OMISSIONS WHICH HAVE BEEN INCORPORATED INTO THE RECORD DRAWINGS.

SHEET: **E-010**
 COB# (XXXXXX)

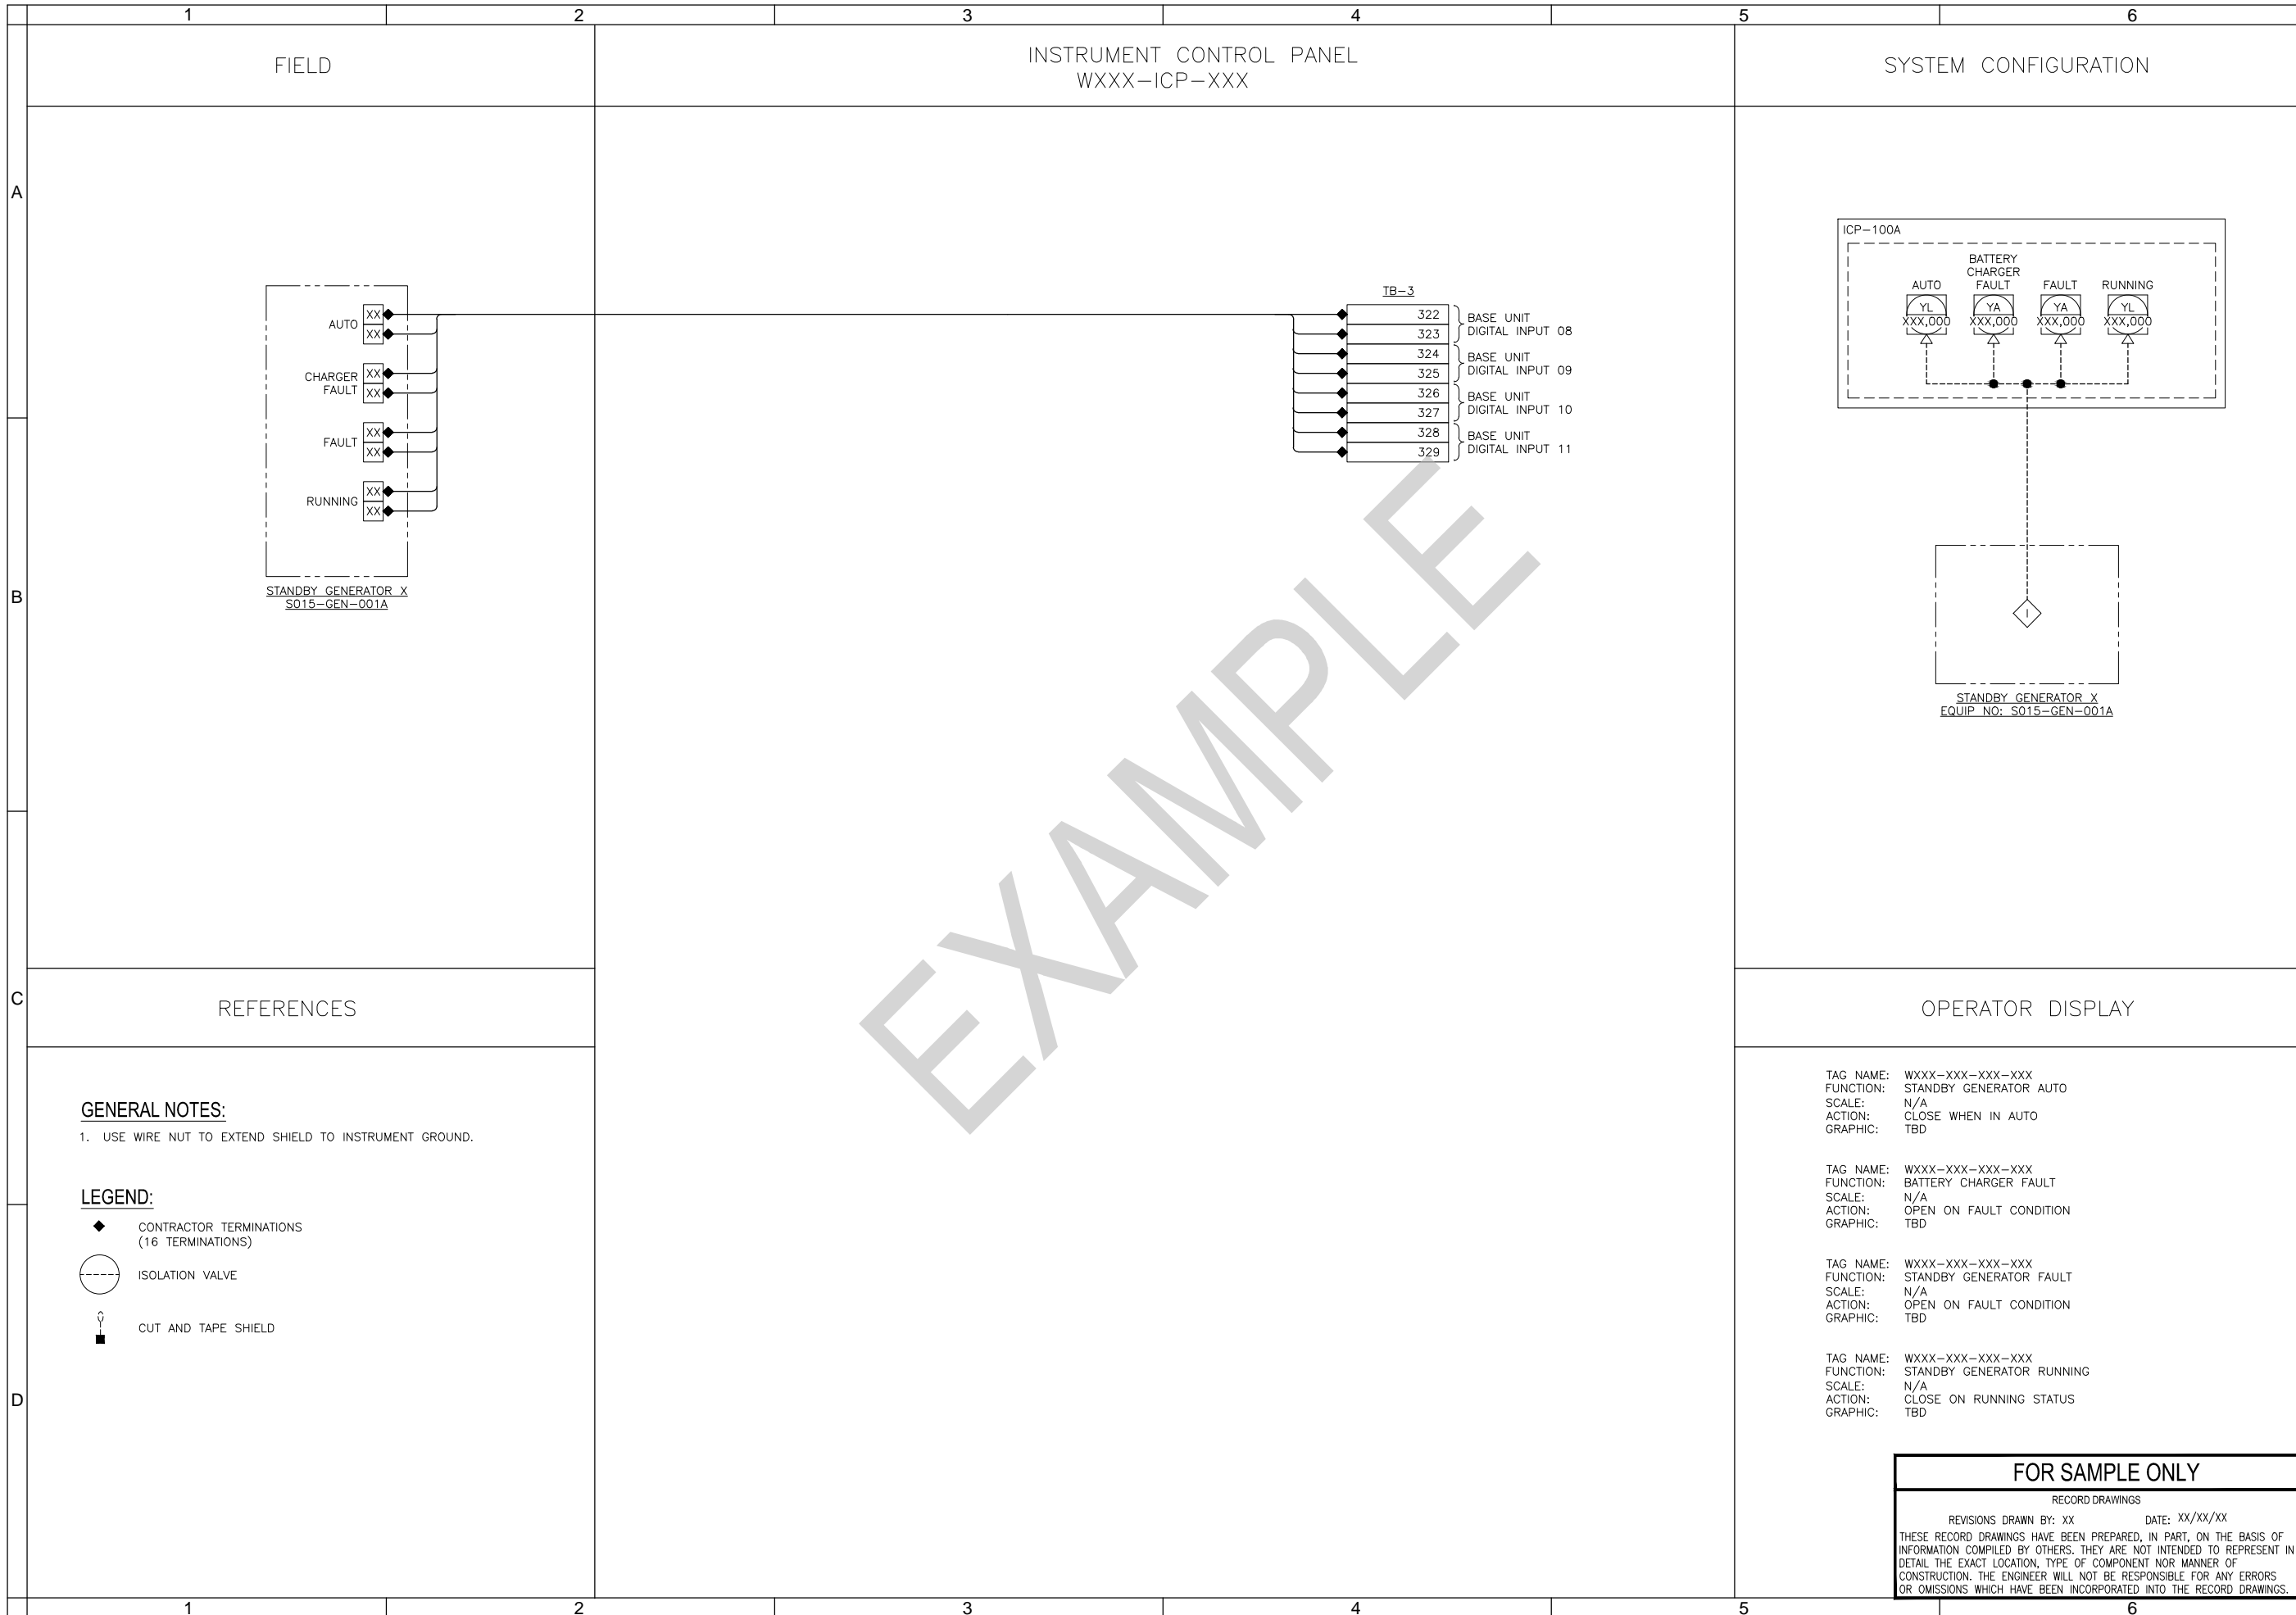

FOR SEALS AND SIGNATURES

(PROJECT NAME)
INSTRUMENTATION & CONTROLS
STANDBY GENERATOR LOOP SHEET
 DESCHUTES COUNTY, OREGON



REVISIONS:

(CONSULTANT ENGINEER NAME, ADDRESS & PHONE NUMBER)

DESIGNED BY: XXX
 DRAWN BY: XXX
 SCALE: NONE
 FILE: E-011.dwg
 DATE: _____

VERIFY SCALES
 0 1"
 BAR EQUALS ONE INCH ON ORIGINAL DRAWING

SHEET: **E-011**
 COB # (XXXXXX)

REFERENCES


GENERAL NOTES:
 1. USE WIRE NUT TO EXTEND SHIELD TO INSTRUMENT GROUND.

- LEGEND:**
- ◆ CONTRACTOR TERMINATIONS (16 TERMINATIONS)
 - ◇ ISOLATION VALVE
 - CUT AND TAPE SHIELD

OPERATOR DISPLAY

- TAG NAME: WXXX-XXX-XXX-XXX
 FUNCTION: STANDBY GENERATOR AUTO
 SCALE: N/A
 ACTION: CLOSE WHEN IN AUTO
 GRAPHIC: TBD
- TAG NAME: WXXX-XXX-XXX-XXX
 FUNCTION: BATTERY CHARGER FAULT
 SCALE: N/A
 ACTION: OPEN ON FAULT CONDITION
 GRAPHIC: TBD
- TAG NAME: WXXX-XXX-XXX-XXX
 FUNCTION: STANDBY GENERATOR FAULT
 SCALE: N/A
 ACTION: OPEN ON FAULT CONDITION
 GRAPHIC: TBD
- TAG NAME: WXXX-XXX-XXX-XXX
 FUNCTION: STANDBY GENERATOR RUNNING
 SCALE: N/A
 ACTION: CLOSE ON RUNNING STATUS
 GRAPHIC: TBD

FOR SAMPLE ONLY
 RECORD DRAWINGS
 REVISIONS DRAWN BY: XX DATE: XX/XX/XX
 THESE RECORD DRAWINGS HAVE BEEN PREPARED, IN PART, ON THE BASIS OF INFORMATION COMPILED BY OTHERS. THEY ARE NOT INTENDED TO REPRESENT IN DETAIL THE EXACT LOCATION, TYPE OF COMPONENT NOR MANNER OF CONSTRUCTION. THE ENGINEER WILL NOT BE RESPONSIBLE FOR ANY ERRORS OR OMISSIONS WHICH HAVE BEEN INCORPORATED INTO THE RECORD DRAWINGS.

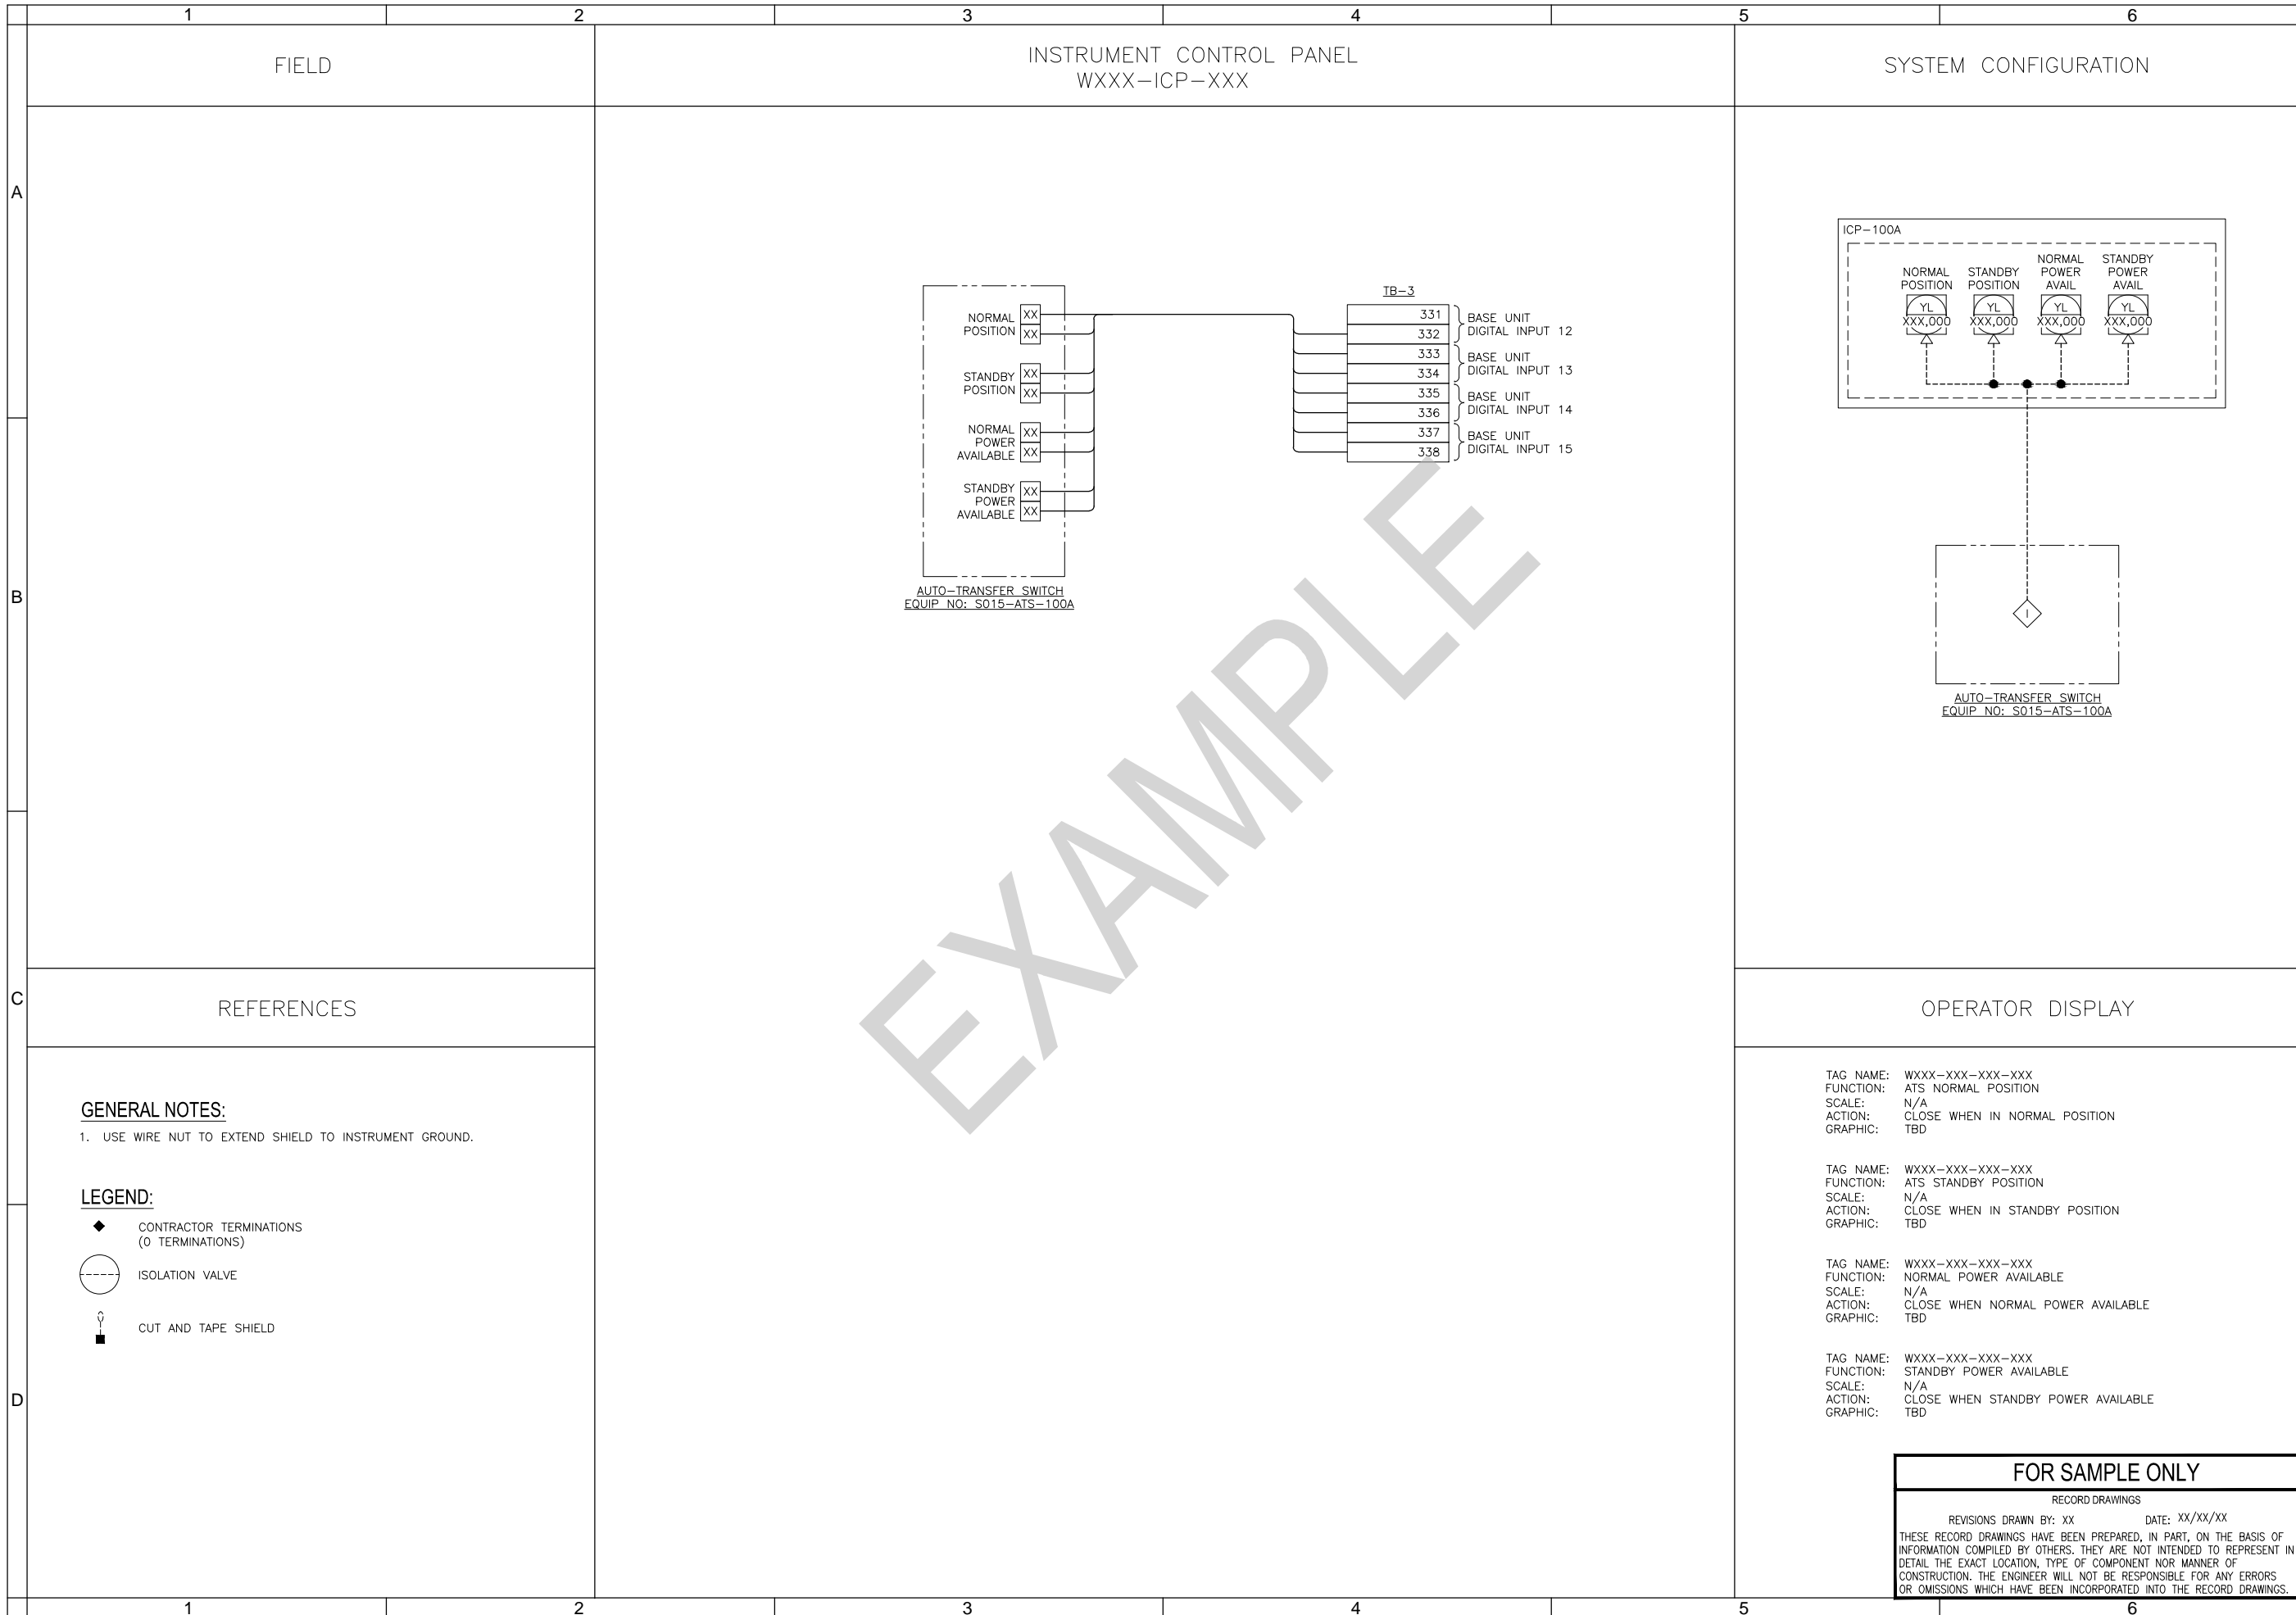

FOR SEALS AND SIGNATURES

(PROJECT NAME)
INSTRUMENTATION & CONTROLS
AUTO-TRANSFER SWITCH LOOP SHEET
 DESCHUTES COUNTY, OREGON



REVISIONS:


(CONSULTANT ENGINEER NAME, ADDRESS & PHONE NUMBER)

DESIGNED BY: XXX
 DRAWN BY: XXX
 SCALE: NONE
 FILE: E-012.dwg
 DATE: _____

VERIFY SCALES
 0 1"
 BAR EQUALS ONE INCH ON ORIGINAL DRAWING

SHEET: **E-012**

COB# (XXXXXX)

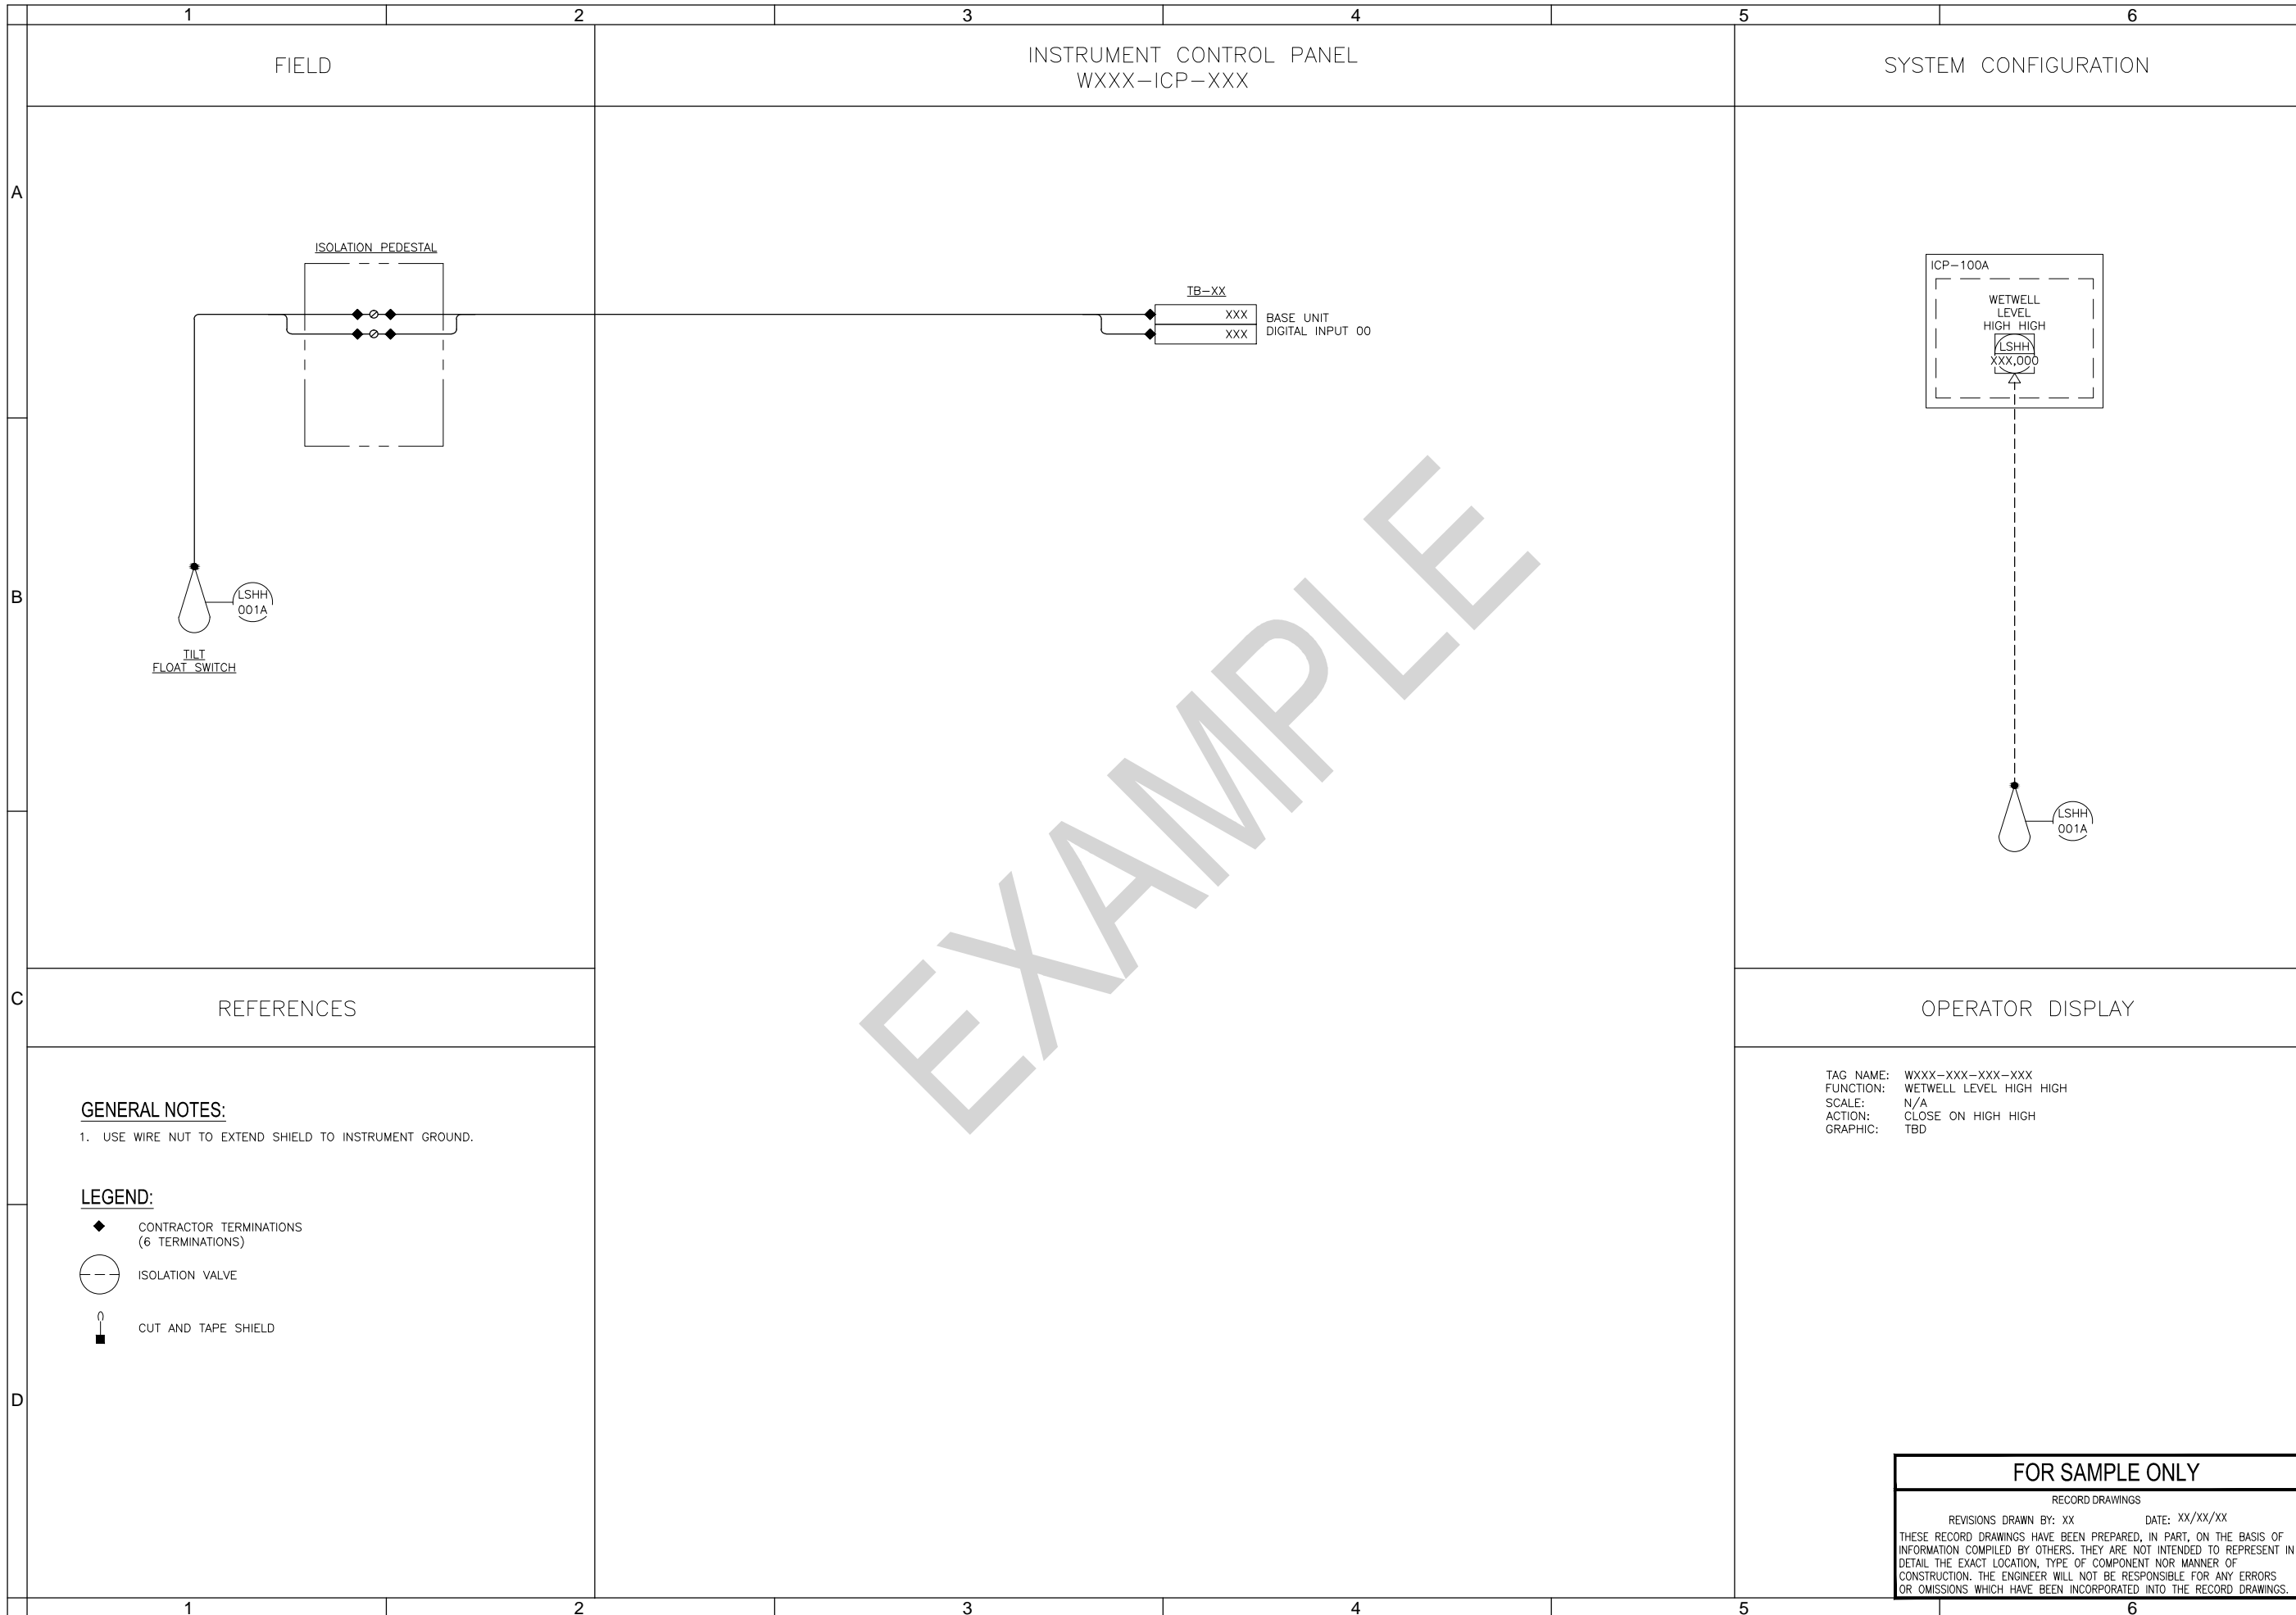

FOR SEALS AND SIGNATURES


(PROJECT NAME)
INSTRUMENTATION & CONTROLS
 WETWELL HIGH HIGH LEVEL LOOP SHEET
 DESCHUTES COUNTY, OREGON



REVISIONS:

(CONSULTANT ENGINEER NAME, ADDRESS & PHONE NUMBER)

DESIGNED BY: XXX
 DRAWN BY: XXX
 SCALE: NONE
 FILE: E-013.dwg
 DATE: _____

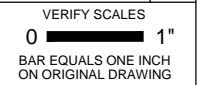


FOR SAMPLE ONLY

RECORD DRAWINGS

REVISIONS DRAWN BY: XX DATE: xx/xx/xx

THESE RECORD DRAWINGS HAVE BEEN PREPARED, IN PART, ON THE BASIS OF INFORMATION COMPILED BY OTHERS. THEY ARE NOT INTENDED TO REPRESENT IN DETAIL THE EXACT LOCATION, TYPE OF COMPONENT NOR MANNER OF CONSTRUCTION. THE ENGINEER WILL NOT BE RESPONSIBLE FOR ANY ERRORS OR OMISSIONS WHICH HAVE BEEN INCORPORATED INTO THE RECORD DRAWINGS.

SHEET: **E-013**
 COB# (XXXXXX)

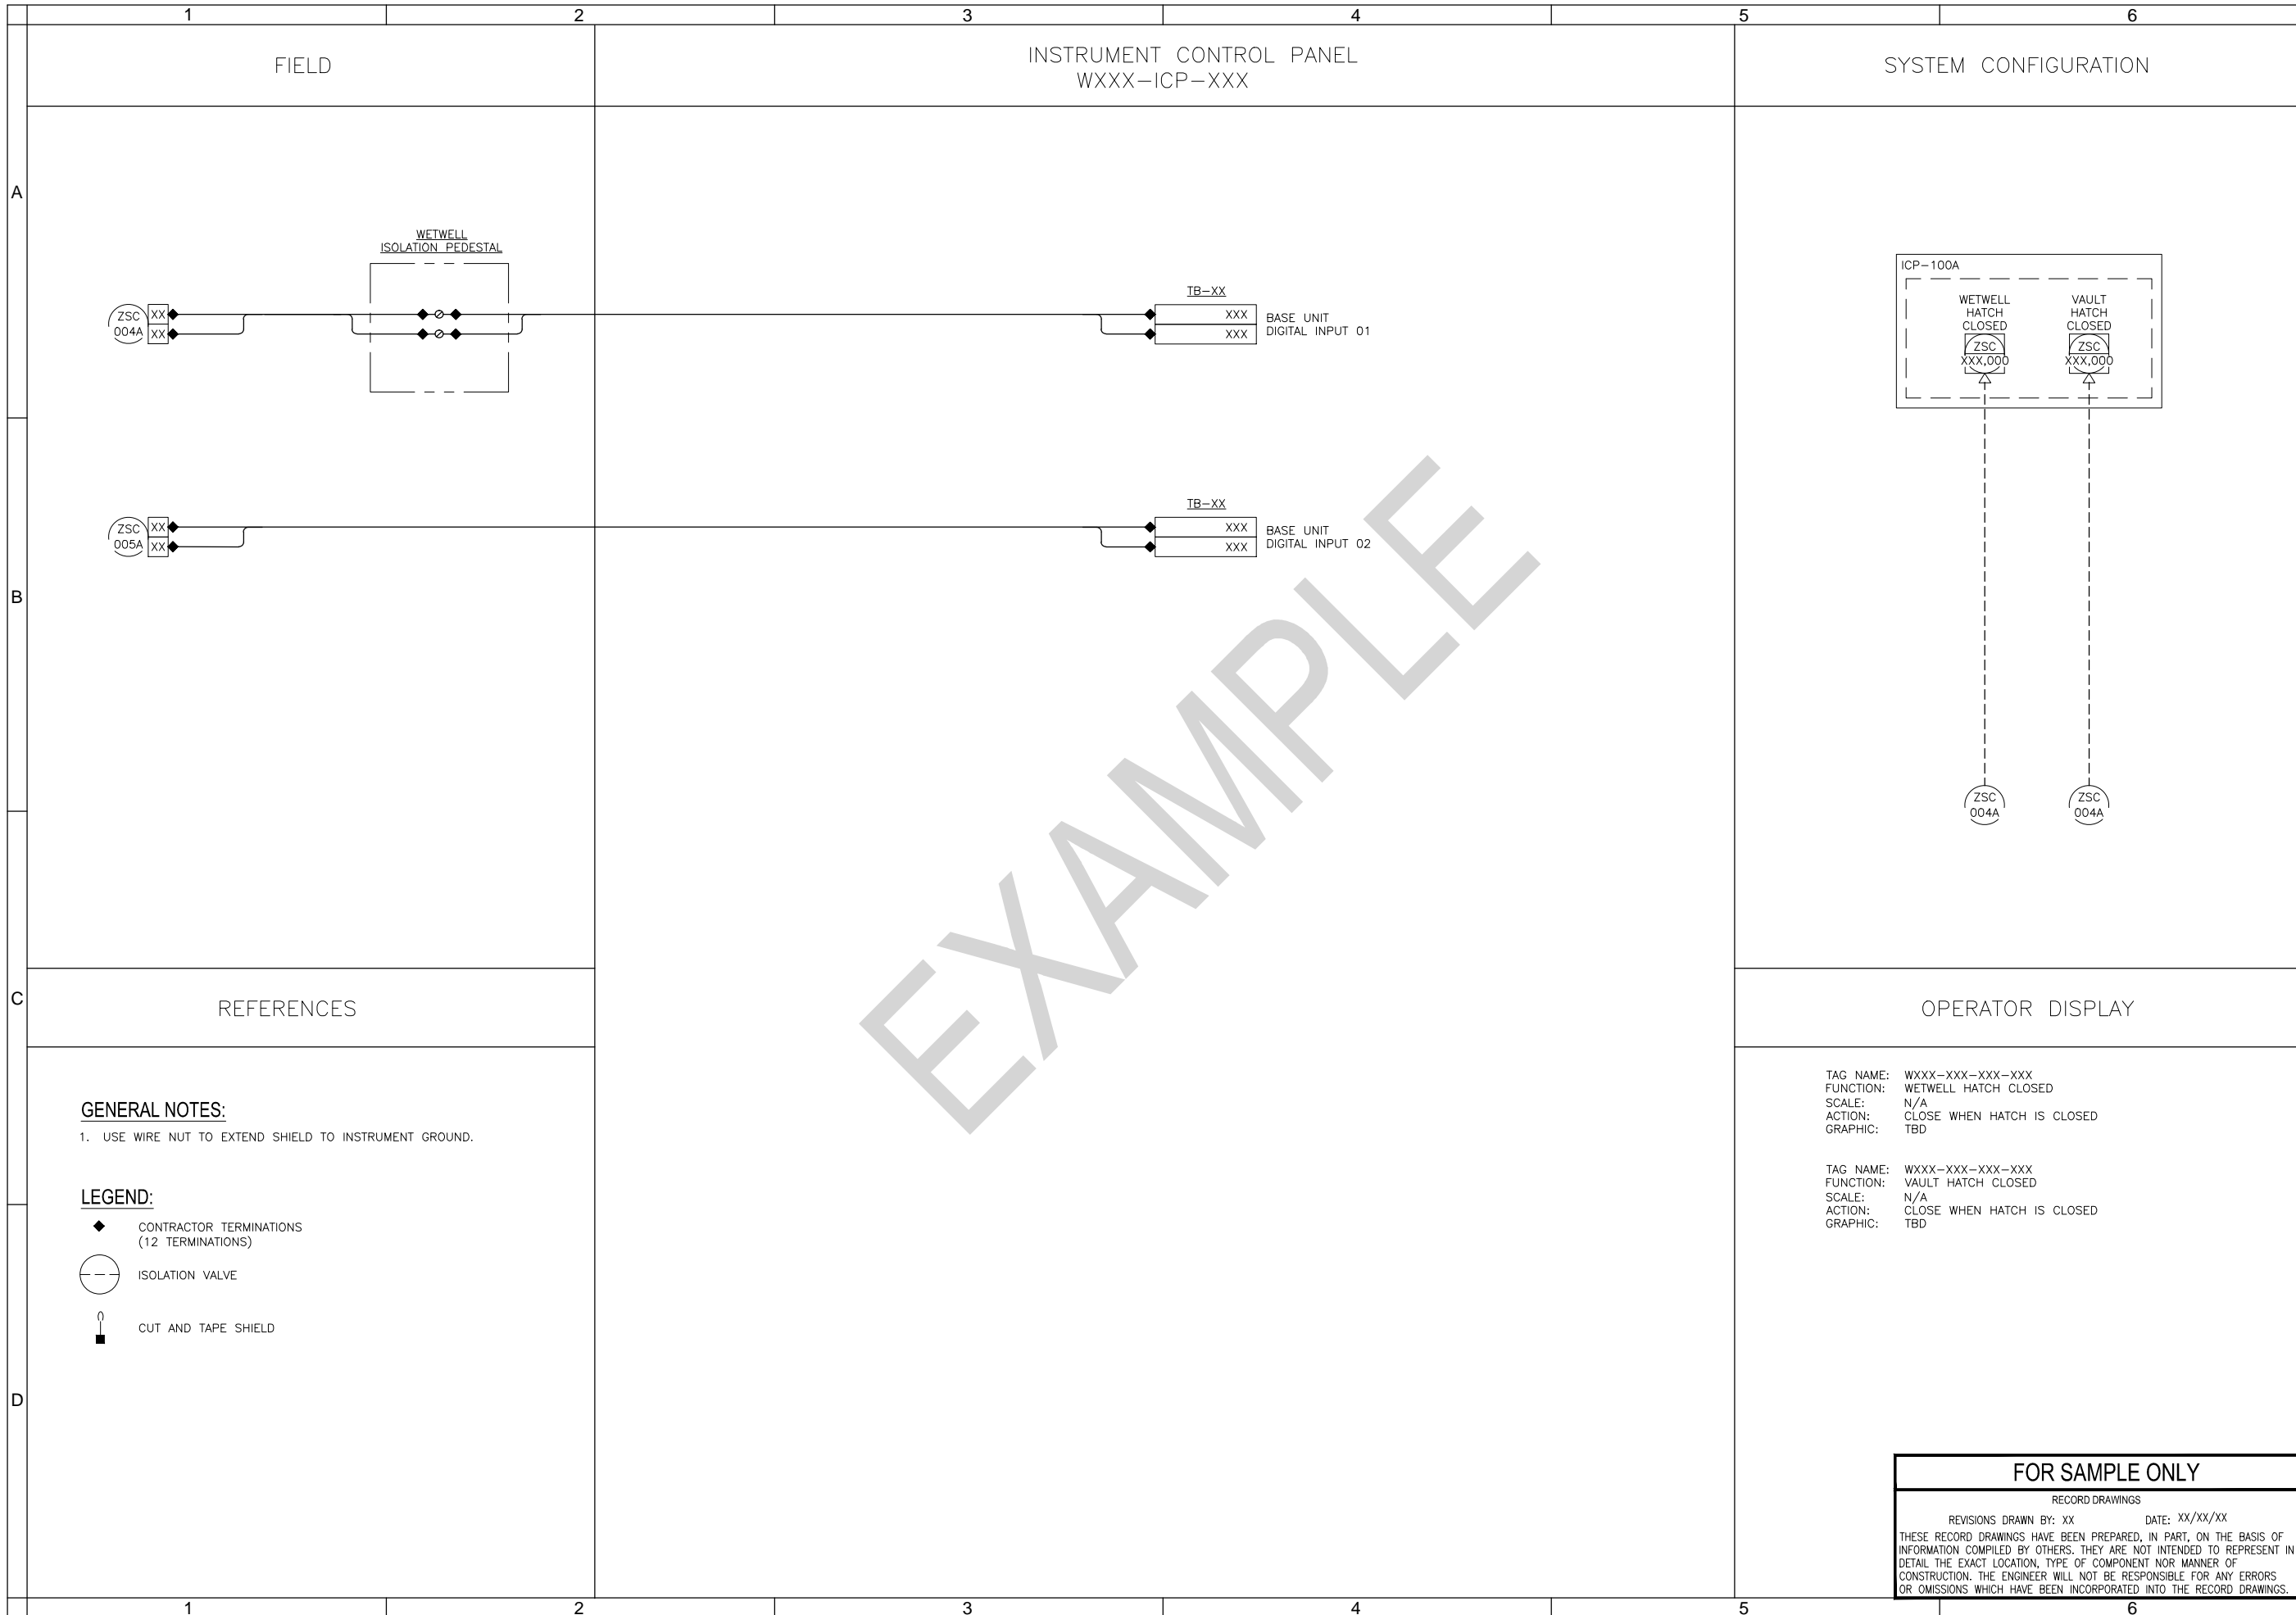

FOR SEALS AND SIGNATURES


(PROJECT NAME)
INSTRUMENTATION & CONTROLS
HATCH INTRUSION LOOP SHEET
DESCHUTES COUNTY, OREGON



REVISIONS:

(CONSULTANT ENGINEER NAME, ADDRESS & PHONE NUMBER)

DESIGNED BY: XXX
DRAWN BY: XXX
SCALE: NONE
FILE: E-014.dwg
DATE:

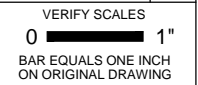


FOR SAMPLE ONLY

RECORD DRAWINGS

REVISIONS DRAWN BY: XX DATE: xx/xx/xx

THESE RECORD DRAWINGS HAVE BEEN PREPARED, IN PART, ON THE BASIS OF INFORMATION COMPILED BY OTHERS. THEY ARE NOT INTENDED TO REPRESENT IN DETAIL THE EXACT LOCATION, TYPE OF COMPONENT NOR MANNER OF CONSTRUCTION. THE ENGINEER WILL NOT BE RESPONSIBLE FOR ANY ERRORS OR OMISSIONS WHICH HAVE BEEN INCORPORATED INTO THE RECORD DRAWINGS.

SHEET: **E-014**
COB# (XXXXXX)

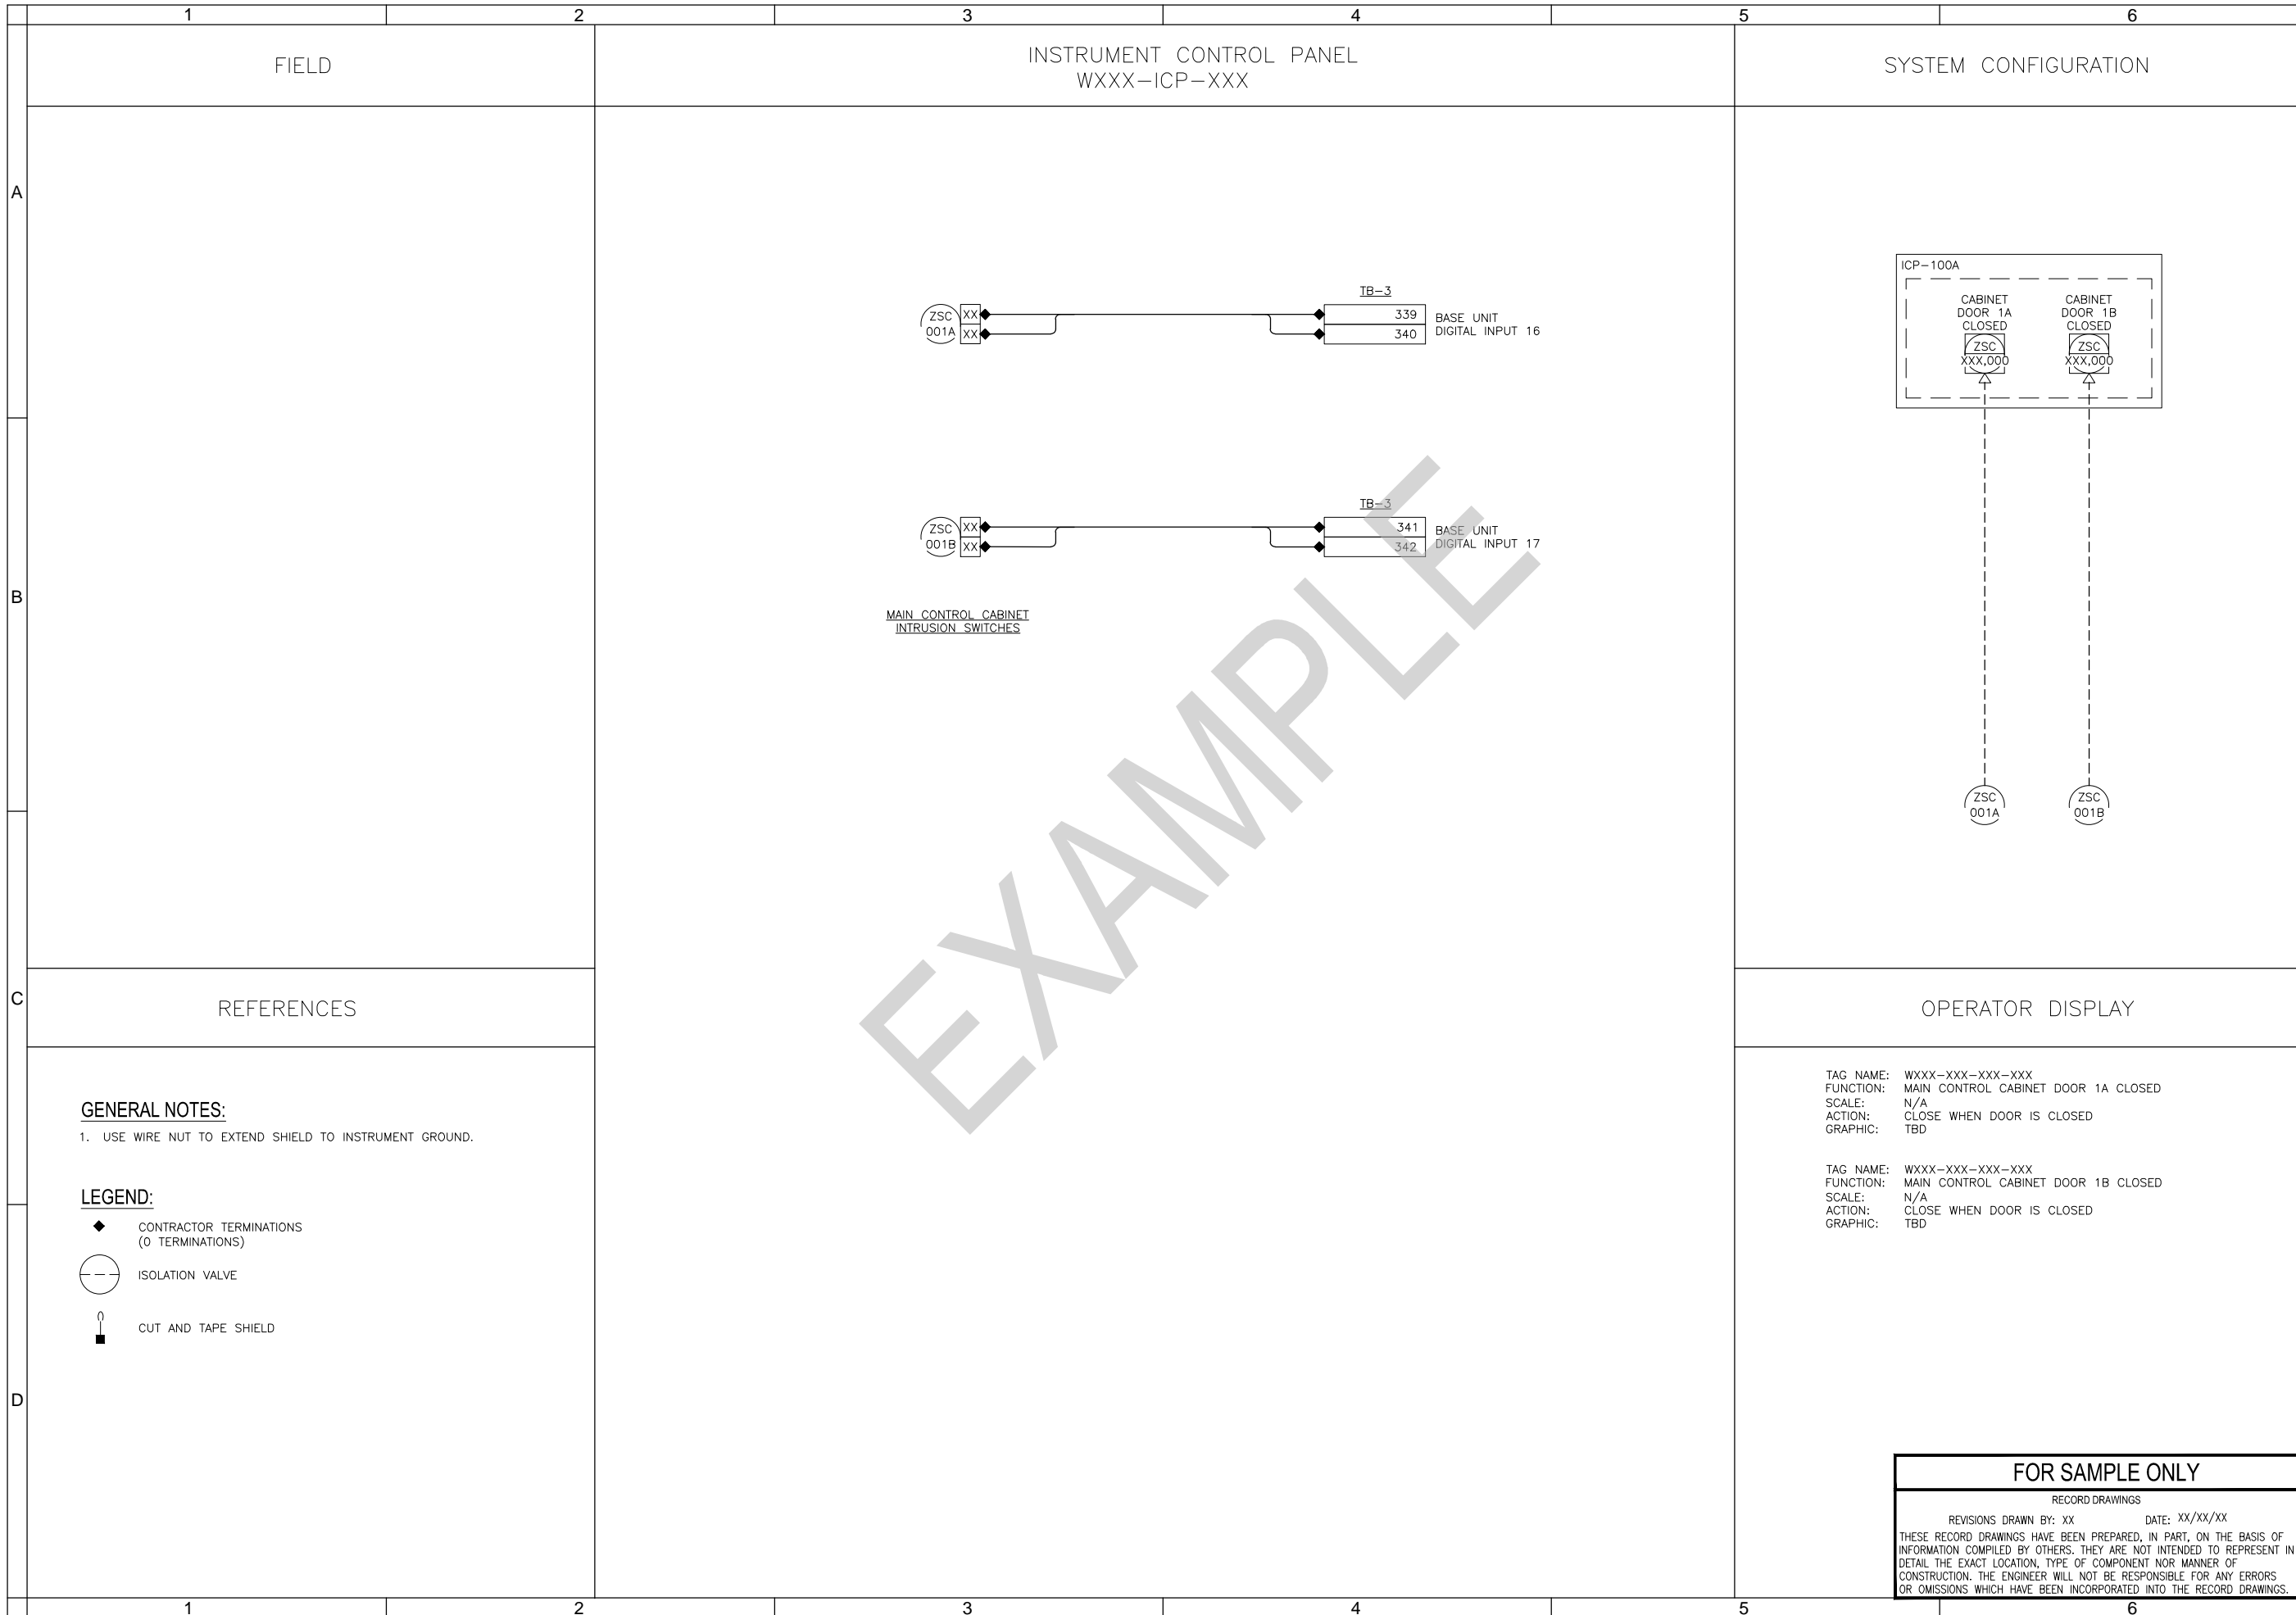

FIELD

INSTRUMENT CONTROL PANEL
WXXX-ICP-XXX

SYSTEM CONFIGURATION

REFERENCES

OPERATOR DISPLAY

GENERAL NOTES:


1. USE WIRE NUT TO EXTEND SHIELD TO INSTRUMENT GROUND.

LEGEND:

- ◆ CONTRACTOR TERMINATIONS (O TERMINATIONS)
- ISOLATION VALVE
- ⊥ CUT AND TAPE SHIELD

TAG NAME: WXXX-XXX-XXX-XXX
 FUNCTION: MAIN CONTROL CABINET DOOR 1A CLOSED
 SCALE: N/A
 ACTION: CLOSE WHEN DOOR IS CLOSED
 GRAPHIC: TBD

TAG NAME: WXXX-XXX-XXX-XXX
 FUNCTION: MAIN CONTROL CABINET DOOR 1B CLOSED
 SCALE: N/A
 ACTION: CLOSE WHEN DOOR IS CLOSED
 GRAPHIC: TBD

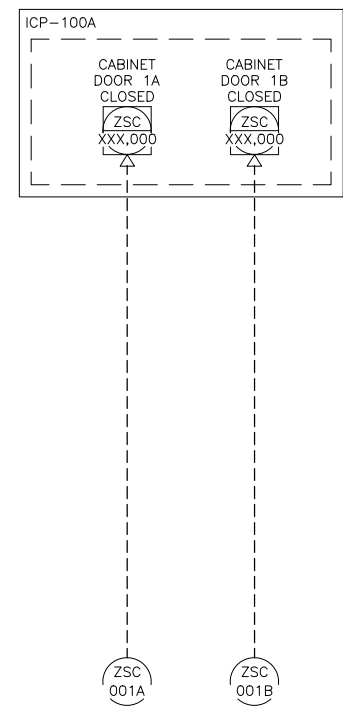

FOR SEALS
AND SIGNATURES

(PROJECT NAME)
INSTRUMENTATION & CONTROLS
 MAIN CONTROL CAB INTRUSION LOOP SHEET
 DESCHUTES COUNTY, OREGON



REVISIONS:

(CONSULTANT
 ENGINEER
 NAME, ADDRESS
 & PHONE
 NUMBER)

DESIGNED BY: XXX
 DRAWN BY: XXX
 SCALE: NONE
 FILE: E-015.dwg
 DATE: _____


VERIFY SCALES
 0 1"
 BAR EQUALS ONE INCH
 ON ORIGINAL DRAWING

FOR SAMPLE ONLY
 RECORD DRAWINGS
 REVISIONS DRAWN BY: XX DATE: xx/xx/xx
 THESE RECORD DRAWINGS HAVE BEEN PREPARED, IN PART, ON THE BASIS OF
 INFORMATION COMPILED BY OTHERS. THEY ARE NOT INTENDED TO REPRESENT IN
 DETAIL THE EXACT LOCATION, TYPE OF COMPONENT NOR MANNER OF
 CONSTRUCTION. THE ENGINEER WILL NOT BE RESPONSIBLE FOR ANY ERRORS
 OR OMISSIONS WHICH HAVE BEEN INCORPORATED INTO THE RECORD DRAWINGS.

SHEET:
E-015
 COB# (XXXXXX)

PART VI
APPENDIX C

Connector Routes and Crossings
Map

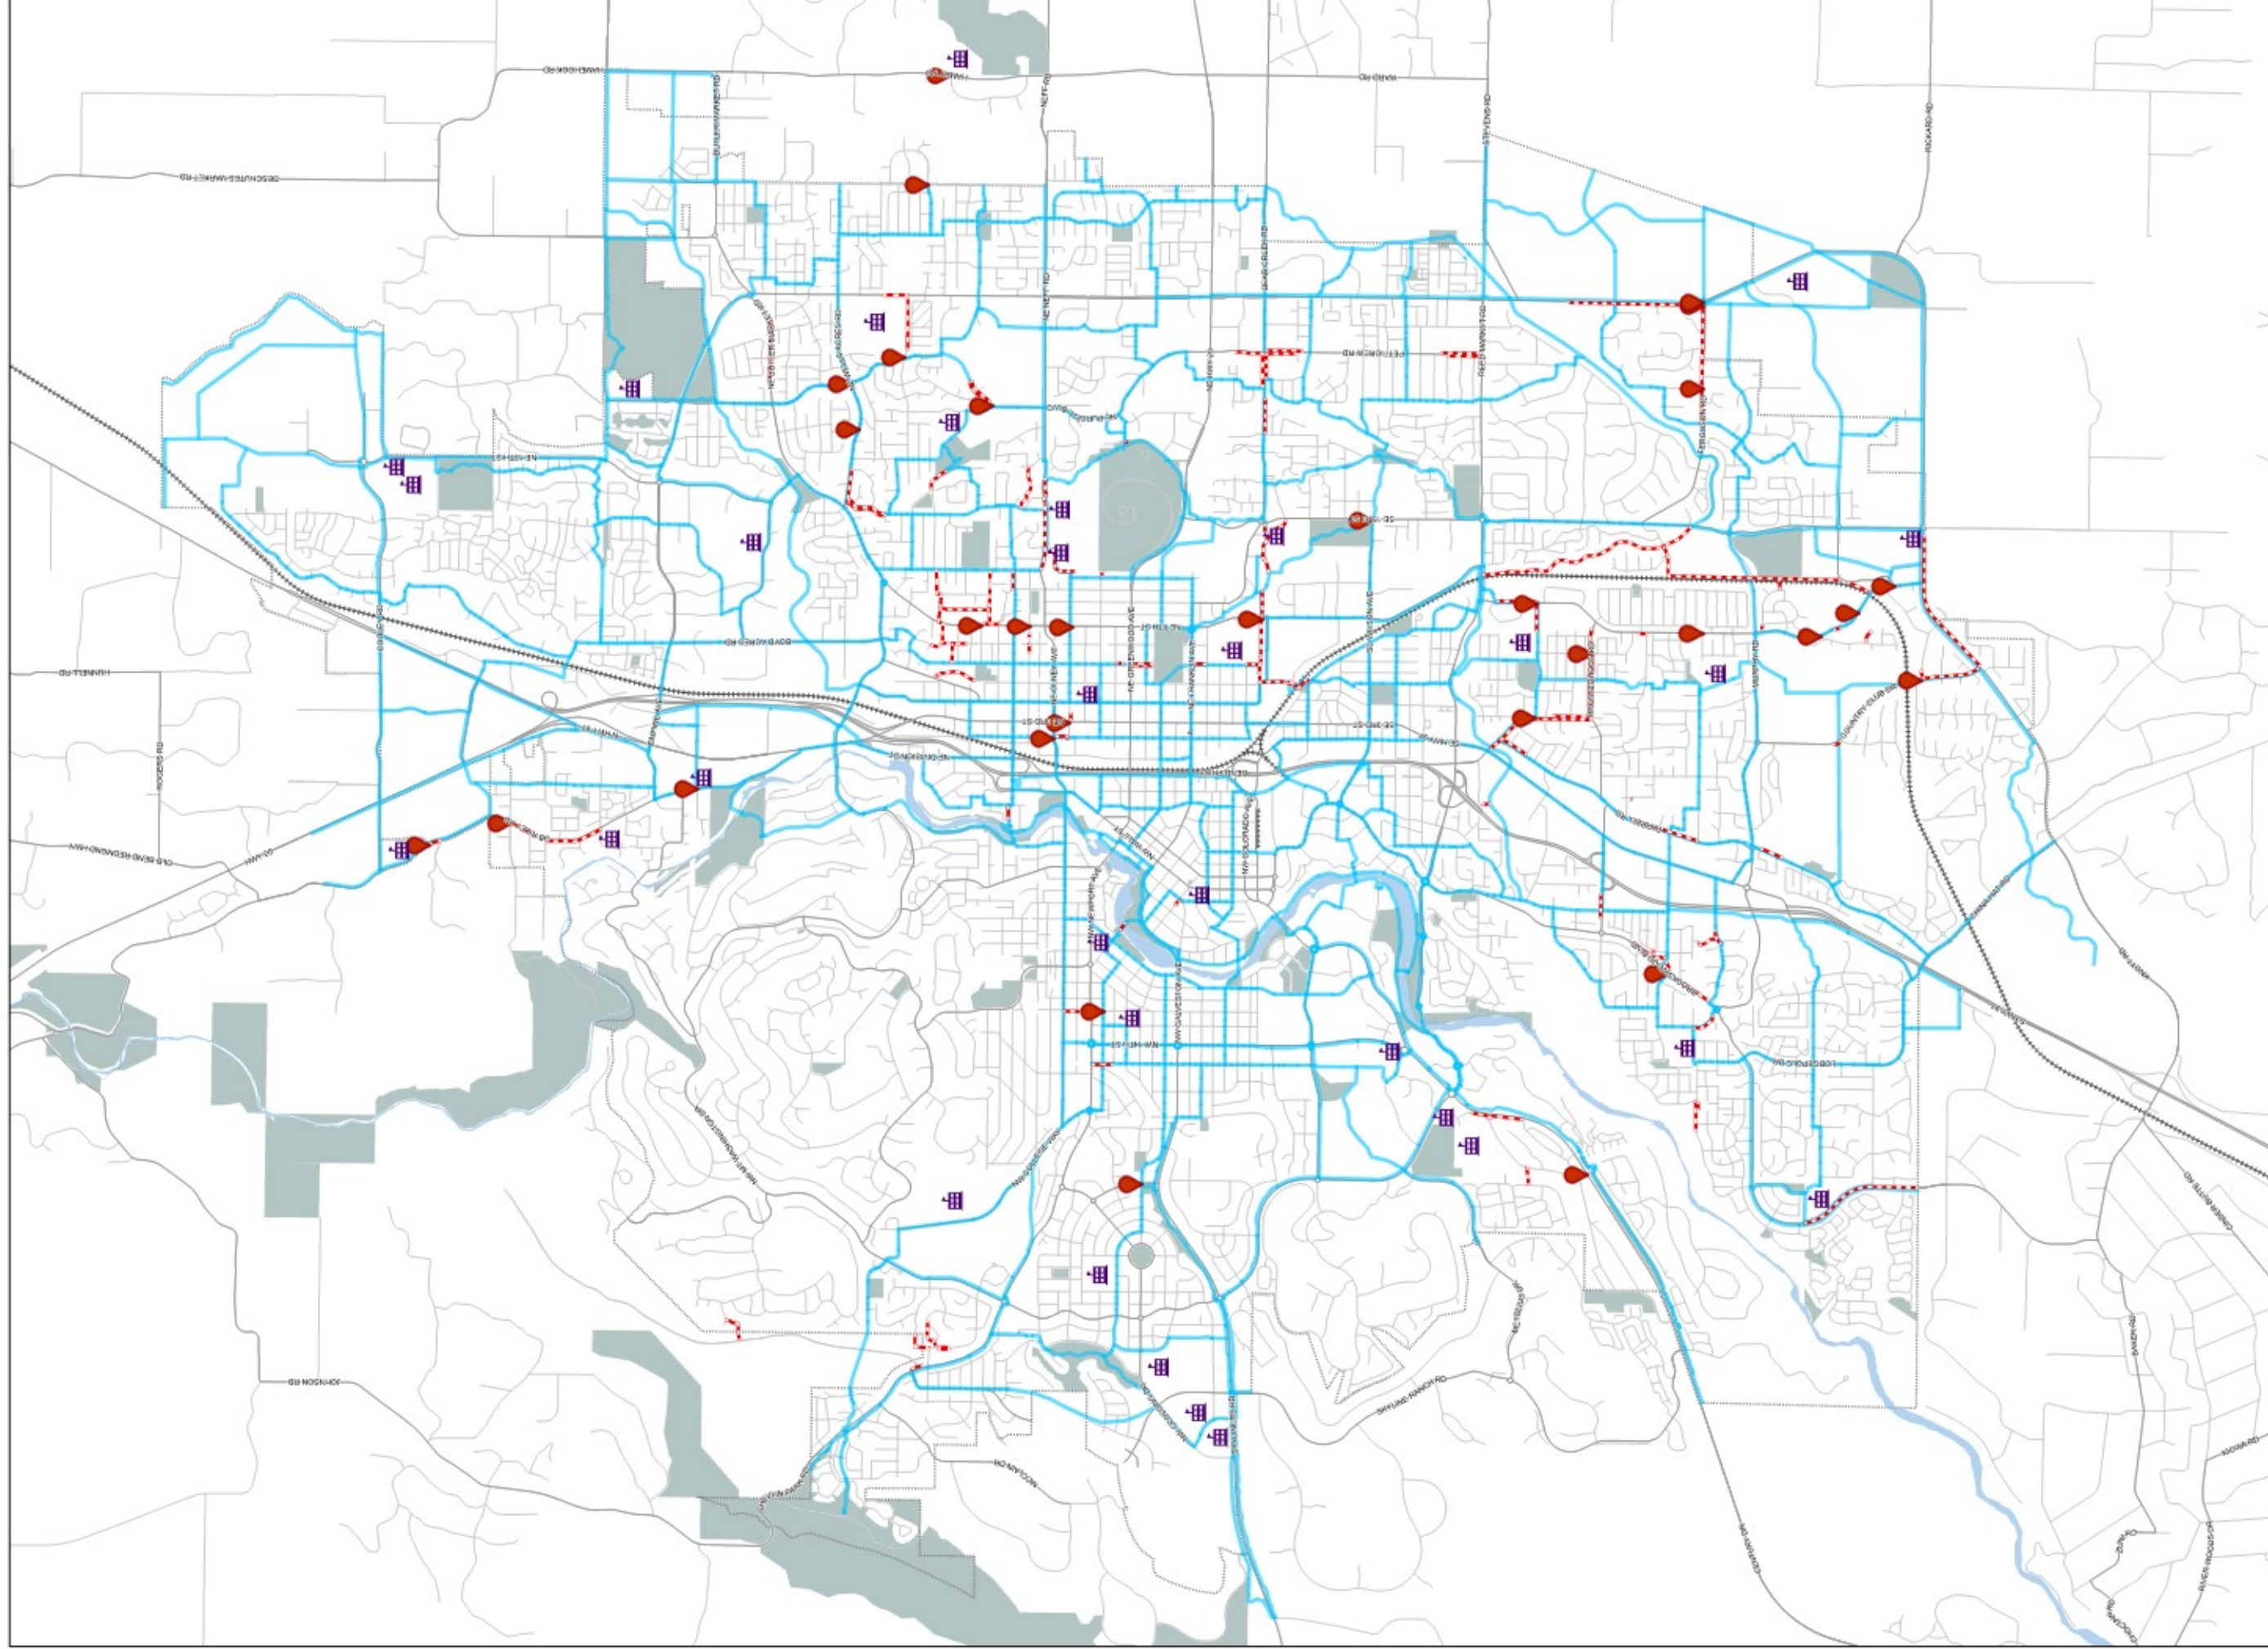

**CITY OF BEND DESIGN STANDARDS PART VI
APPENDIX C, CONNECTOR ROUTES AND CROSSINGS MAP VERSION 1**

- Crosswalk Enhancement Needs
- Schools
- Low Stress Network
- Infill Needs
- Parks



Map prepared by S. Layne, City of Bend
 Print Date: Jan 31, 2022
 Sources: City of Bend, Deschutes County



CITY OF BEND

This map is for reference purposes only. City staff takes no responsibility for the accuracy of the map. A disclaimer is provided for the City of Bend to verify map information or to report any errors.