

[NORTH ARROW]



CITY OF BEND

[PROJECT NAME]

[MONTH, YEAR]

[CITY PROJECT OR FILE NUMBER]

CITY OF BEND, DESCHUTES COUNTY, OREGON

OWNER:
[NAME]
[ADDRESS]
[CITY, STATE & ZIP]
[PHONE NUMBER]

SCHEDULE OF IMPROVEMENTS:

- CITY OF BEND:**
- # LF FULL STREET IMPROVEMENT
 - # LF SIDEWALK
 - # LF #\" CURB
 - # CURB RAMPS
 - # STREET LIGHTS
 - # LF #\" PVC-3034 SEWER MAIN
 - # MANHOLES
 - #4\" SEWER SERVICES
 - # STORM CATCH BASINS
 - # DRYWELLS
 - # LF #\" STORM PIPE
 - # LF #\" DI WATER MAIN
 - # LF #\" DI WATER MAIN
 - # FIRE HYDRANTS
 - # #\" WATER SERVICES
- PRIVATE:**
- # LF #\" DI WATER MAIN
 - # LF #\" DI WATER MAIN
 - # FIRE HYDRANTS
 - # #\" WATER SERVICES

VICINITY MAP

VICINITY MAP

SCALE:

[NORTH ARROW]

SITE PLAN (AREA CAN BE RESIZED TO FIT PROJECT)

SITE PLAN

SCALE:

LEGEND:

	BENCHMARK (FOUND)		BANK (BOTTOM)
	BENCHMARK (SET)		BANK (TOP)
	CATCH BASIN		CABLE TV
	CLEANOUT		CANAL
	CONCRETE		CENTERLINE
	CONIFEROUS TREE		DITCH (CENTER)
	CONTROL MON CULVERT		EDGE OF CONCRETE
	DECIDUOUS TREE		EDGE OF GRAVEL
	DITCH INLET		EDGE OF PAVEMENT
	DRYWELL		EASEMENT
	GAS METER		FENCE (OTHER)
	GAS VALVE		FENCE (SILT)
	GRAVEL		FENCE (STEEL)
	GUY WIRE		FENCE (WOOD)
	HANDICAP		FIBER OPTICS
	MAILBOX		FORCE MAIN
	MONUMENT (FOUND)		GAS
	MONUMENT (SET)		GRADE BREAK
	RAILROAD CROSSING ARM		GUARDRAIL
	SANITARY MANHOLE		IRRIGATION
	SIDEWALK		JERSEY BARRIER
	SIGN		PAVEMENT REPAIR
	STORM MANHOLE		PROPERTY BOUNDARY
	TELEPHONE RISER		PROPERTY SETBACKS
	TELEPHONE MANHOLE		POWER
	TRAFFIC SIGNAL CONTROL BOX		POWER (OVERHEAD)
	TRAFFIC SIGNAL W/ MAST ARM		RAILROAD
	UTILITY POLE		RIVER
	UTILITY POLE/LIGHT		SANITARY SEWER
	UTILITY VAULT W/ MANHOLE		STORM DRAIN
	WATER AIR RELEASE VALVE		STRIPPING
	WATER BELL JOINT		TELEPHONE
	WATER BLIND FLANGE		WATER
	WATER BLOW OFF VALVE		
	WATER BUTTERFLY VALVE		
	WATER CHECK VALVE		
	WATER COMBINATION AIR RELEASE VALVE		
	WATER DOUBLE DETECTOR CHECK VALVE		
	WATER FIRE DEPT CONNECTION		
	WATER FIRE HYDRANT		
	WATER FLANGED GATE VALVE		
	WATER FLANGED BY MECHANICAL JOINT GATE VALVE		
	WATER GATE VALVE		
	WATER MECHANICAL JOINT		
	WATER METER		
	WATER PRESSURE REDUCING VALVE		
	WATER PRESSURE REGULATOR/SUSTAINING		
	WATER PRESSURE RELIEF VALVE		
	WATER RESTRAINED MECHANICAL JOINT		
	WATER SAMPLE STATION		
	WATER SINGLE DETECTOR CHECK VALVE		
	WATER THRUST BLOCK (STRADDLE)		
	WATER THRUST BLOCK		

FADED BLACK FEATURES ARE EXISTING (EXCEPT FOR FOUND MONUMENTS)

[ON COVER SHEET IF APPLICABLE]

APPROVALS:

CITY OF BEND ENGINEER: _____

NOTE: SIGNATURE DOES NOT GRANT APPROVAL TO COMMENCE CONSTRUCTION.

[REQUIRED UTILITY: _____]

[REQUIRED UTILITY: _____]

[REQUIRED UTILITY: _____]

[REQUIRED UTILITY: _____]

PERMANENT BENCH MARKS USED:

IDENTIFICATION	DESCRIPTION

SHEET INDEX:

- SHEET 1 COVER
- SHEET 2 CONTRUCTION NOTES
- SHEET 3 SITE PLAN & PROFILE
- SHEET 4 GRADING PLAN & PROFILE
- SHEET 5 DETAILS
- SHEET 6 EROSION CONTROL

STAMP
[ENGINEERS]

[PROJECT NAME]
[PROJECT NAME 2ND LINE]
COVER
DESCHUTES COUNTY, OREGON



REVISIONS:
1. _____
2. _____
3. _____

[COMPANY NAME]
[COMPANY ADDRESS]

DESIGNED BY: _____
DRAWN BY: _____
SCALE: _____
FILE: _____
DATE: ____/____/____

VERIFY SCALES
0 1"
BAR EQUALS ONE INCH
ON ORIGINAL DRAWING

SHEET:
1/6

COB #

GENERAL NOTES:

- NO CONSTRUCTION SHALL BE STARTED WITHOUT A NOTICE TO PROCEED BY THE CITY ENGINEERING DEPARTMENT. THE CITY ENGINEERING DEPARTMENT AND THE DESIGN ENGINEER SHALL BE NOTIFIED AT LEAST 24 HOURS PRIOR TO THE START OF CONSTRUCTION. ANY CONSTRUCTION WORK DONE PRIOR TO NOTICE TO PROCEED BEING ISSUED OR WITHOUT INSPECTION WILL BE REJECTED.
- CONTRACTOR SHALL VERIFY ALL CONDITIONS ON THE JOB SITE INCLUDING BUT NOT LIMITED TO, ALL DIMENSIONS, GRADES, ELEVATIONS, EXTENT AND COMPATIBILITY TO THE EXISTING SITE CONDITIONS, AND WITH THE WORK DESCRIBED ON THE ENGINEER'S DRAWINGS, ANY DISCREPANCIES OR UNEXPECTED CONDITIONS THAT AFFECT OR CHANGE THE WORK DESCRIBED IN THE CONTRACT DOCUMENTS SHALL BE BROUGHT TO THE ENGINEER'S ATTENTION IMMEDIATELY. CONTRACTOR SHALL NOT PROCEED WITH ANY OF THE WORK IN THE AREA OF DISCREPANCIES UNTIL ALL SUCH DISCREPANCIES ARE RESOLVED. IF THE CONTRACTOR CHOOSES TO DO SO, THEN IT IS UNDERSTOOD THAT THE CONTRACTOR IS CHOOSING TO PROCEED AT THE CONTRACTOR'S OWN RISK AND SHALL BOURN ALL COSTS, IF ANY TO RESOLVE THE ISSUES TO THE SATISFACTION OF THE ENGINEER.
- A CITY INSPECTOR ACTING ON BEHALF OF THE CITY MAY REQUIRE REVISIONS IN PLANS TO SOLVE UNFORESEEN PROBLEMS THAT MAY ARISE IN THE FIELD.
- ALL CONSTRUCTION WORK AND INSTALLATIONS SHALL CONFORM TO THE CITY STANDARDS AND SPECIFICATIONS, AND ALL WORK SHALL BE SUBJECT TO THE APPROVAL OF THE CITY.
- IT SHALL BE THE RESPONSIBILITY OF THE CONTRACTOR TO CONTACT "UNDERGROUND LOCATE SERVICE" AT 1-800-332-2344 AT LEAST 48 BUSINESS-DAY HOURS PRIOR TO THE START OF CONSTRUCTION FOR THE LOCATION OF POWER, GAS, CABLE TV AND TELEPHONE UNDERGROUND FACILITIES. THE CONTRACTOR WILL ALSO BE RESPONSIBLE FOR CONTACTING THE APPROPRIATE PUBLIC AGENCY FOR THE LOCATION OF UNDERGROUND FACILITIES.
- ALL UTILITIES SHOWN ARE ACCURATE TO THE EXTENT OF AVAILABLE RECORDS AND KNOWLEDGE. NO POTHOLES TO VERIFY LOCATIONS AND ELEVATIONS WAS AUTHORIZED BY THE OWNER. THE CONTRACTOR HAS THE TOTAL RESPONSIBILITY TO VERIFY THE LOCATION OF EXISTING UNDERGROUND UTILITIES AND TO NOTIFY THE UTILITY COMPANIES WHEN WORKING IN THEIR PROXIMITY. CONTRACTOR TO VERIFY LOCATION OF EXISTING UTILITIES PRIOR TO CONSTRUCTION. OREGON LAW REQUIRES YOU TO FOLLOW RULES ADOPTED BY THE OREGON UTILITY NOTIFICATION CENTER. THOSE RULES ARE SET FORTH IN OAR 952-001-0010 THROUGH 952-001-0090. YOU MAY OBTAIN COPIES OF THE RULES BY CALLING THE CENTER. THE TELEPHONE NUMBER FOR THE OREGON UTILITY NOTIFICATION CENTER IS (503)232-2987.
- ALL GRADING SHALL BE IN CONFORMANCE WITH THE CURRENT CITY STANDARDS AND SPECIFICATIONS AND CURRENT GRADING ORDINANCE. ALL SUBGRADE MATERIAL SHALL BE CONSIDERED CLASS A AND COMPACTED TO 95% OF OPTIMUM DENSITY. AS SPECIFIED IN THESE PLANS, ALL FILL MATERIAL SHALL BE COMPACTED TO 95% RELATIVE COMPACTION PER THE CITY TESTING REQUIREMENTS.
- ALL FINAL CUT AND FILL SLOPES SHALL NOT EXCEED A GRADE OF 2 HORIZONTAL TO 1 VERTICAL UNLESS OTHERWISE APPROVED.
- ALL UNSUITABLE SOILS MATERIALS, RUBBISH AND DEBRIS RESULTING FROM GRADING OPERATIONS SHALL BE REMOVED FROM THE JOB SITE AND DISPOSED OF PROPERLY.
- THE CONTRACTOR SHALL EMPLOY ALL LABOR, EQUIPMENT, AND METHODS REQUIRED TO PREVENT DUST IN AMOUNTS DAMAGING TO PROPERTY, CULTIVATED VEGETATION AND DOMESTIC ANIMALS OR CAUSING A NUISANCE TO PERSONS OCCUPYING BUILDINGS IN THE VICINITY OF THE JOB SITE. THE CONTRACTOR SHALL BE RESPONSIBLE FOR ANY DAMAGE CAUSED BY DUST RESULTING FROM CONSTRUCTION.
- THE CONTRACTOR SHALL FOLLOW ALL APPLICABLE INDUSTRIAL SAFETY REGULATIONS, THE CITY AND DESCHUTES COUNTY AND THEIR OFFICIALS, THE ENGINEER, AND THE OWNER SHALL NOT BE RESPONSIBLE FOR ENFORCING SAFETY REGULATIONS.
- MATERIAL QUANTITIES USED, NOTED, OR PROVIDED IN A SEPARATE ITEMIZED QUANTITY TAKE-OFF ARE AN ENGINEER'S OPINION OF PROBABLE MATERIAL REQUIREMENTS, AND IS AN ESTIMATE ONLY. CONTRACTORS HAVE THE SOLE RESPONSIBILITY OF MAKING THEIR OWN QUANTITY TAKE-OFF AND COST ESTIMATE.
- ALL WORK IN THE PUBLIC RIGHT OF WAY SHALL BE PERFORMED BY A CITY APPROVED CONTRACTOR (INCLUDING SUBCONTRACTORS).
- UTILITIES SHALL HAVE THE RIGHT TO INSTALL, MAINTAIN, AND OPERATE THEIR EQUIPMENT ABOVE AND BELOW GROUND AND ALL OTHER RELATED FACILITIES WITHIN THE PUBLIC UTILITY EASEMENTS (PUE) IDENTIFIED ON THIS PLAT MAP AS MAY BE NECESSARY OR DESIRABLE IN SERVING THE LOTS IDENTIFIED HEREIN, INCLUDING THE RIGHT OF ACCESS TO SUCH FACILITIES AND THE RIGHT TO REQUIRE THE REMOVAL OF ANY OBSTRUCTIONS INCLUDING TREES AND VEGETATION THAT MAY BE PLACED WITHIN THE PUE AT THE LOT OWNERS EXPENSE. AT NO TIME MAY ANY PERMANENT STRUCTURES BE PLACED WITHIN THE PUE OR ANY OTHER OBSTRUCTION WHICH INTERFERES WITH THE USE OF THE PUE WITHOUT PRIOR WRITTEN APPROVAL OF THE UTILITIES AND FACILITIES IN THE PUE.
- CITY ENGINEER'S SIGNATURE DOES NOT CONSTITUTE APPROVAL OF FACILITIES PROPOSED ON PRIVATE PROPERTY. SEPARATE PERMITS ISSUED BY THE BUILDING DEPARTMENT ARE REQUIRED AND SHALL BE OBTAINED BY THE DEVELOPER FOR FACILITIES LOCATED OUTSIDE OF THE PUBLIC RIGHT-OF-WAY.
- ANY WORK WITHIN EXISTING PUBLIC RIGHT-OF-WAY OR DEDICATED CITY EASEMENTS REQUIRES A SEPARATE RIGHT-OF-WAY EXCAVATION PERMIT OBTAINED FROM THE CITY ENGINEERING DIVISION.
- ALL WATER MAIN CONNECTION TO BE DESIGNED AND CONSTRUCTED WITH CROSS CONNECTION PROTECTION.
- CONTRACTOR SHALL OBTAIN HYDRANT METER PERMIT FOR USE OF TESTING WATER MAIN. A MINIMUM OF 48 HOURS ADVANCED NOTICE IS REQUIRED TO THE CITY OF BEND UTILITIES DEPARTMENT.
- ALL RESTORATION TO BE COMPLETED AS SOON AS POSSIBLE UPON COMPLETION AND APPROVAL FROM THE INSPECTOR FOR ON-SITE WORK AND UNDERGROUND WORK.
- ALL RESTORATION SHALL COMPLY WITH CITY OF BEND STANDARDS AND SPECIFICATIONS AND FOLLOW THE BMP PAVING GUIDELINES ESTABLISHED BY STREET DEPARTMENT.
- PRIOR TO IMPLEMENTING ANY TRAFFIC CONTROL PLANS, NOTIFICATION AND APPROVAL IS REQUIRED BY THE CITY OF BEND PRIVATE DEVELOPMENT ENGINEERING DEPARTMENT.
- THESE PLANS WILL EXPIRE ONE YEAR FROM THE "CITY OF BEND ENGINEER" SIGNATURE DATE ON THE COVER.
- PRIVATE INSPECTIONS WILL BE REQUIRED PER PART V OF THE CITY OF BEND STANDARDS AND SPECIFICATIONS UNLESS SPECIFIED OTHERWISE.

TRAFFIC CONTROL NOTES:

- THE CONTRACTOR IS RESPONSIBLE FOR IMPLEMENTING THE APPROVED TRAFFIC CONTROL PLAN (TCP) TO PROVIDE SAFE AND EFFICIENT VEHICULAR, BICYCLE AND PEDESTRIAN MOVEMENT IN AND AROUND THE WORK ZONES. CERTIFIED TRAFFIC CONTROL FLAGGERS AND PROFESSIONALS MAY BE REQUIRED PER THE CONDITIONS OF THE PERMIT. THE CITY OF BEND RESERVES THE RIGHT TO MODIFY THE TCP AT ANY TIME BASED ON FIELD CONDITIONS.
- THE CONTRACTOR SHALL COMPLY WITH ALL PERMIT REQUIREMENTS INCLUDING THE MANUAL OF UNIFORM TRAFFIC CONTROL DEVICES (MUTCD) AND THE OREGON TEMPORARY TRAFFIC CONTROL HANDBOOK FOR OPERATIONS OF THREE DAYS OR LESS, DATED DECEMBER 2011 AND PREPARED BY ODOT (ORANGE BOOK).
- UNLESS APPROVED BY THE CITY ENGINEER, ARTERIAL ROADS SHALL HAVE NO LANE RESTRICTIONS FROM 6:30 TO 9:00 AM AND FROM 3:30 TO 6:30 PM. COLLECTORS AND LOCAL NEIGHBORHOOD MAIN ROUTES SHALL HAVE NO LANE RESTRICTIONS FROM 7:00 AM TO 8:30 AM AND FROM 4:00 PM TO 6:00 PM.
- TCP SHALL BE SUBMITTED TO THE CITY OF BEND A MINIMUM OF 14 DAYS PRIOR TO IMPLEMENTATION FOR REVIEW. 48 HOURS PRIOR TO IMPLANTATION THE CITY OF BEND SHALL BE NOTIFIED IN ORDER TO PROVIDE ADEQUATE PUBLIC NOTIFICATION.

UTILITIES NOTES:

- UTILITIES CROSSING SHALL BE PERPENDICULAR (90 DEGREES) TO THE CITY WATER, STORM, AND SEWER LINES.
- UTILITY CROSSINGS SHALL MAINTAIN A MINIMUM VERTICAL SEPARATION OF 12 INCHES FROM ALL WATER AND SEWER MAIN LINES.
- ANY UTILITY THAT IS LOCATED PARALLEL TO A CITY WATER OR SEWER MAIN LINE SHALL MAINTAIN A MINIMUM OF 10-FT OF HORIZONTAL SEPARATION.
- THE CITY REQUIRES VISUAL INSPECTION (POT HOLING) OF ALL UTILITY CROSSINGS OF CITY WATER, STORM, AND SEWER LINES. SEWER LINES MAY BE INSPECTED BY CLOSED CIRCUIT CAMERA AT THE APPROVAL OF THE CITY ENGINEER.
- EXCAVATION AND DIRECTIONAL DRILLING REQUIRES POT HOLING PRIOR TO ANY WORK BEING CONDUCTED AND DURING DRILLING
- DIRECTIONAL DRILLING REQUIRES ADVANCED PROFILING OF THE CROSSING BEFORE WORK CAN BE PERMITTED.
- NO EXCAVATION IS PERMITTED WITHIN 10 FT BEHIND A FORCE MAINS, PRESSURE MAINS, FIRE HYDRANT OR WATER MAINS THRUST BLOCK.
- UTILITY CROSSINGS SHALL MAINTAIN 2 FT CLEARANCE HORIZONTALLY FROM CITY UTILITIES SUCH AS MANHOLES, VALVE CANS, INLETS, CATCH BASINS, ETC.
- UTILITY LINES SHALL NOT BE PLACED IN THE ROOT AREAS OF TREES AND SHALL MAINTAIN 5 FT CLEARANCE FROM THE DRIPLINE OF TREES OR AS DIRECTED BY THE CITY ENGINEER. ANY TREES DAMAGED ARE TO BE REPLACED
- COMPACTION IS REQUIRED AND TESTING PER SECTION 06046.46 (C) OR AT THE DISCRETION OF THE CITY ENGINEER. ALL LIFTS MUST BE MECHANICALLY COMPACTED WITH ADEQUATE COMPACTION EQUIPMENT, WITH A MINIMUM OF 5 PASSES FOR EACH LIFT OR AS DIRECTED BY THE CITY.

STREET NOTES:

- IF ANY WORK (NEW CONSTRUCTION OR RECONSTRUCTION) IMPACTS A CURB WHERE THERE IS A PEDESTRIAN WALKWAY (E.G. A SIDEWALK OR TRAIL/PATH) INTERSECTING A ROADWAY THEN A NEW RAMP OR REPLACEMENT OF AN EXISTING NON-COMPLIANT CURB RAMP MUST BE CONSTRUCTED.
- IF ANY NEW WORK INCLUDES RESURFACING THROUGH A STREET LEVEL PEDESTRIAN WALKWAY (E.G. MARKED OR UNMARKED CROSSWALK), EVEN IF THE WORK IS NOT THE FULL WIDTH OF THE ROADWAY, CURB RAMPS MUST BE BUILT OR RECONSTRUCTED ON BOTH ENDS OF THE CROSSWALK.
- IF ANY NEW SIDEWALK WORK CONNECTING TO AN EXISTING NON-COMPLIANT RAMP THAT REQUIRES ANY MODIFICATION TO ANY PORTION OF THE RAMP TO MEET CURRENT SIDEWALK DESIGN STANDARDS, THEN THE ENTIRE RAMP SHALL BE RECONSTRUCTED TO CURRENT STANDARDS.
- IF ANY UTILITY TRENCH WORK IMPACTS A CURB AT A CROSS WALK, WITH OR WITHOUT A RAMP, THE REPLACEMENT OF AN EXISTING NON-COMPLIANT CURB RAMP MUST BE CONSTRUCTED.
- IF UTILITY TRENCH WORK DOES NOT IMPACT A CURB RAMP BUT IS "LIMITED TO A PORTION OF THE PAVEMENT, INCLUDING A PORTION OF THE CROSS WALK" REPLACEMENT OF AN EXISTING NON-COMPLIANT CURB RAMP MAY NOT BE REQUIRED (DEPENDENT ON OVERALL PROJECT SCOPE AND REQUIRED PAVEMENT RESTORATION LIMITS).
- ANY WORK WITHIN THE PUBLIC RIGHT-OF-WAY THAT DISTURBS A PEDESTRIAN SIDEWALK OR TRAIL REQUIRES THE REPLACEMENT OF THAT FACILITY TO CURRENT CITY AND PROWAG STANDARDS. THIS INCLUDES BUT IS NOT LIMITED TO ALL ADA RAMPS, CONCRETE SIDEWALKS, ASPHALT TRAILS, DRIVEPADS, CROSSWALKS, AND SIGNAGE.
- IF ANY ADA RAMPS ARE IDENTIFIED TO BE CONSTRUCTED, THE CONTRACTOR SHALL CONSTRUCT PERPENDICULAR RAMPS PER CITY STANDARDS. DIAGONAL OR PARALLEL RAMPS SHALL ONLY BE USED IF THERE ARE UNIQUE SITE CONSTRAINTS THAT PROHIBIT CONSTRUCTION OF PERPENDICULAR RAMPS. ALL VARIATIONS FROM PERPENDICULAR RAMPS ARE AT THE DISCRETION OF THE CITY ENGINEER.
- THE CITY PREFERS THAT VACTOR EXCAVATION AND ASPHALT CORE SAW BE USED TO POT HOLE UTILITIES. ALTERNATE METHODS MAY BE ALLOWED, BUT REQUIRE APPROVAL AS A CONDITION OF THE PERMIT.
- ASPHALT RESTORATION LIMITS WILL BE DETERMINED AFTER PERMIT SCOPE IS COMPLETED.

CONSTRUCTION, INSPECTION, AND NOTIFICATION NOTES:

- PERMITTEE SHALL REQUEST INSPECTIONS A MINIMUM OF 24 HOURS IN ADVANCE.
- THE PERMITTEE SHALL REQUEST FINAL INSPECTION 48 HOURS AFTER THE WORK IS COMPLETE.
- THE CITY CAN INSPECT ANY PORTION OF THE PROJECT AT ANY TIME. THE INSPECTION SHALL BE PERFORMED BY CITY INSPECTORS AND MAY REQUIRE INSPECTION BY THE ENGINEER OF RECORD (THIRD PARTY INSPECTORS). PRIOR TO CONSTRUCTION, A PRE-CONSTRUCTION MEETING MAY BE REQUIRED. THE PERMITTEE CONTRACTOR IS REQUIRED TO CALL IN ALL INSPECTIONS PER THE REQUIREMENTS OF THE PERMIT
- CONTRACTOR SHALL PROVIDE THE CITY A MINIMUM OF 48 HRS NOTICE PRIOR TO ANY TRAFFIC CONTROL BEING IMPLEMENTED. NOTICE TO THE CITY AND THE INSPECTOR BY EMAIL IS PREFERRED (COMDEVENG@BENDOREGON.GOV)
- INSPECTIONS ARE REQUIRED FOR CITY UTILITY CROSSINGS AND FINAL STREET RESTORATION.
- OUTSTANDING AND INCOMPLETE PERMITS MAY CONSTITUTE RESTRICTED PERMITTING TO THE APPLICANT AND CONTRACTOR(S).
- THE PERMITTEE AND CONTRACTOR ARE RESPONSIBLE FOR ANY DAMAGE TO PUBLIC AND PRIVATE PROPERTY. ALL DAMAGE SHALL BE REPAIRED TO PRE-CONSTRUCTION CONDITIONS AND TO THE SATISFACTION OF THE PROPERTY OWNER.

GRADING AND ESC NOTES:

- THE ENGINEER OF RECORD CAN PROVIDE ADDITIONAL BEST MANAGEMENT PRACTICES (BMP) FROM SECTION 9.4.3 IN THE CENTRAL OREGON STORMWATER MANUAL (COSM) THAT APPLY TO THE PROJECT.
- HOLD A PRE-CONSTRUCTION MEETING THAT INCLUDES THE CITY OF BEND INSPECTOR, EOR AND CONTRACTOR TO DISCUSS EROSION AND SEDIMENT CONTROL MEASURES AND CONSTRUCTION LIMITS.
- THE EROSION AND SEDIMENT CONTROL (ESC) PLAN MUST BE KEPT ONSITE AT ALL TIMES WHEN WORK IS OCCURRING.
- THE ESC MEASURES SHOWN ON THIS PLAN ARE MINIMUM REQUIREMENTS FOR ANTICIPATED SITE CONDITIONS. DURING THE CONSTRUCTION PERIOD, THE MEASURES MUST BE UPGRADED AS NEEDED TO COMPLY WITH ALL APPLICABLE LOCAL, STATE, AND FEDERAL EROSION AND SEDIMENT CONTROL REGULATIONS.
- THE FOLLOWING CONSTRUCTION SEQUENCE SHALL BE FOLLOWED IN ORDER TO BEST MINIMIZE THE POTENTIAL FOR EROSION AND SEDIMENTATION CONTROL PROBLEMS:
 - FENCE OR FLAG AREAS TO BE PROTECTED OR LEFT UNDISTURBED DURING CONSTRUCTION
 - INSTALL GRAVELED OR PAVED CONSTRUCTION ENTRANCES, EXITS, AND PARKING AREAS TO REDUCE THE TRACKING OF SEDIMENT ONTO PUBLIC AND PRIVATE ROADS
 - CLEAR AND GRUB SUFFICIENTLY FOR INSTALLATION OF TEMPORARY ESC BMPS
 - INSTALL TEMPORARY ESC BMPS, CONSTRUCTING SEDIMENT TRAPPING BMPS AS ONE OF THE FIRST STEPS PRIOR TO GRADING
 - CLEAR, GRUB AND GRADE INDIVIDUAL AND ROUGH GRADE FOR ROADS AND UTILITY LOCATIONS
 - CLEAR, GRUB AND GRADE INDIVIDUAL LOTS OR GROUPS OF LOTS
 - TEMPORARILY STABILIZE A LOT OR GROUPS OF LOTS, THROUGH RE-VEGETATION OR OTHER APPROPRIATE BMPS, WHERE SUBSTANTIAL CUT OR FILL SLOPES ARE RESULT OF SITE GRADING
 - CONSTRUCT ROADS, BUILDINGS, PERMANENT STORMWATER FACILITIES (I.E. INLETS, PONDS, UIC FACILITIES, ETC.)
 - PROTECT ALL PERMANENT STORMWATER FACILITIES UTILIZING THE APPROPRIATE BMPS
 - REMOVE TEMPORARY ESC CONTROLS WHEN PERMANENT STORMWATER FACILITIES HAVE BEEN INSTALLED, ALL LAND-DISTURBING ACTIVITIES HAVE CEASED, AND VEGETATION HAS BEEN ESTABLISHED IN THE AREAS NOTED ON THE ACCEPTED ESC PLANS)
- RETAIN THE DUFF LAYER, NATIVE TOPSOIL, AND NATURAL VEGETATION IN AN UNDISTURBED STATE TO THE MAXIMUM EXTENT AND DURATION PRACTICAL.
- INSPECT ALL ROADWAYS ADJACENT TO THE CONSTRUCTION ACCESS ROUTE AT THE END OF EACH DAY. SIGNIFICANT AMOUNTS OF SEDIMENT THAT LEAVES THE CONSTRUCTION SITE MUST BE CLEANED UP WITHIN 24 HOURS. VACUUMING OR DRY SWEEPING MUST BE USED TO CLEAN UP RELEASED SEDIMENT AND SEDIMENT MUST NOT BE INTENTIONALLY WASHED INTO STORM SEWERS, DRAINAGE WAYS, OR WATER BODIES.
- COVER AND SECURE ALL DUMP TRUCK LOADS LEAVING THE CONSTRUCTION SITE TO MINIMIZE SPILLAGE ON ROADS.
- RESTORE CONSTRUCTION ACCESS ROUTE EQUAL TO OR BETTER THAN THE PRE-CONSTRUCTION CONDITION. CONTROL FUGITIVE DUST FROM CONSTRUCTION ACTIVITY.
- STABILIZE EXPOSED UNWORKED SOILS (INCLUDING STOCKPILES), WHETHER AT FINAL GRADE OR NOT, WITHIN 10 CALENDAR DAYS DURING THE REGIONAL DRY SEASON (JULY 1 THROUGH SEPTEMBER 30) AND WITHIN 5 CALENDAR DAYS DURING THE REGIONAL WET SEASON (OCTOBER 1 THROUGH JUNE 30).
- PROTECT INLETS, DRYWELLS, CATCH BASINS AND OTHER STORMWATER MANAGEMENT FACILITIES FROM SEDIMENT, WHETHER OR NOT FACILITIES ARE OPERABLE.
- KEEP ROADS ADJACENT TO INLETS CLEAN.
- INSPECT INLETS WEEKLY AT A MINIMUM AND DAILY DURING STORM EVENTS. CLEAN OR REMOVE AND REPLACE INLET PROTECTION DEVICES BEFORE SIX INCHES OF SEDIMENT CAN ACCUMULATE.
- INSTALL SEDIMENT CONTROLS ALONG THE SITE PERIMETER ON ALL DOWN GRADIENT SIDES OF THE CONSTRUCTION SITE BEFORE COMMENCING EARTH DISTURBING ACTIVITIES.
- WHENEVER POSSIBLE, CONSTRUCT STORMWATER CONTROL FACILITIES (DETENTION/RETENTION STORAGE POND OR SWALES) BEFORE GRADING BEGINS. THESE FACILITIES SHOULD BE OPERATIONAL BEFORE THE CONSTRUCTION OR IMPERVIOUS SITE IMPROVEMENTS.
- STOCKPILE MATERIALS (SUCH AS TOPSOIL) ONSITE MUST BE KEPT OFF OF ROADWAY AND SIDEWALKS.
- COVER, CONTAIN AND PROTECT ALL CHEMICALS, LIQUID PRODUCTS, PETROLEUM PRODUCT, AND NON-INERT WASTES PRESENT ONSITE FROM VANDALISM. MAINTAIN A SUPPLY OF MATERIALS ON HAND TO ADDRESS AND CONTAIN SPILLS.
- LOCATE DESIGNATED VEHICLE AND EQUIPMENT SERVICE AREAS, FUEL, AND MATERIALS AWAY FROM DRAINAGE INLETS, WATER COURSES, AND CANALS. PROPERLY CONTAIN AREAS USING BERMS, SAND BAGS, OR OTHER BARRIERS.
- REGULARLY INSPECT AND MAINTAIN EQUIPMENT, ESPECIALLY FOR DAMAGED HOSES AND LEAKY GASKETS. CONDUCT MAINTENANCE AND REPAIR OF HEAVY EQUIPMENT AND VEHICLES (I.E. OIL CHANGES, FUEL TANK DRAIN DOWN, ETC) THAT MAY RESULT IN DISCHARGE OR SPILLAGE OF POLLUTANTS USING SPILL PREVENTION MEASURES, SUCH AS DRIP PANS. CLEAN ALL CONTAMINATED SURFACES IMMEDIATELY FOLLOWING ANY DISCHARGE OR SPILL INCIDENT. PERFORM REPAIRS ONSITE USING TEMPORARY PLASTIC OR OIL ABSORBING BLANKETS BENEATH THE VEHICLE.
- DESIGNATE AN AREA FOR CLEANING PAINTING EQUIPMENT AND TOOLS. NEVER CLEAN BRUSHES OR RINSE CONTAINERS INTO THE STREET, GUTTER, DRAINAGE INLET, OR WATERWAY.
- APPLY LANDSCAPING OR AGRICULTURAL CHEMICALS, INCLUDING FERTILIZERS AND PESTICIDES, IN SUCH A MANNER, AND AT APPLICATIONS RATES, THAT INHIBITS THE LOSS OF CHEMICALS INTO STORMWATER RUNOFF FACILITIES.
- INSPECT ON A REGULAR BASIS (AT A MINIMUM WEEKLY, AND DAILY DURING/AFTER A RUNOFF PRODUCING STORM EVENT) AND MAINTAIN ALL EROSION AND SEDIMENT CONTROL BMPS TO ENSURE SUCCESSFUL PERFORMANCE OF THE BMPS.
- REMOVE TEMPORARY ESC BMPS WITHIN 30 DAYS AFTER THE TEMPORARY BMPS ARE NO LONGER NEEDED. PERMANENTLY STABILIZE AREAS THAT ARE DISTURBED DURING THE REMOVAL PROCESS.
- KEEP SEDIMENT ON THE PROJECT SITE, TO THE MAXIMUM EXTENT PRACTICAL.
- CONTROL FUGITIVE DUST FROM CONSTRUCTION ACTIVITY. DUST CONTROL MUST BE CONTINUOUS, PARTICULARLY DURING THE DRY SEASON.
- DESIGNATE THE LOCATION OF A SLURRY PIT WHERE CONCRETE TRUCKS AND EQUIPMENT CAN BE WASHED OUT. SLURRY PITS ARE NOT TO BE LOCATED IN, OR UPSTREAM OF, A SWALE, DRAINAGE AREA, STORMWATER FACILITY, WATER BODY, OR IN AN AREA WHERE A STORMWATER FACILITY EXISTS OR IS PROPOSED.

[STAMP]
[ENGINEERS]

[PROJECT NAME]
[PROJECT NAME 2ND LINE]
CONSTRUCTION NOTES
DESCHUTES COUNTY, OREGON



REVISIONS:	1.	2.	3.


[COMPANY NAME]
[COMPANY ADDRESS]

DESIGNED BY:	DATE: / /
DRAWN BY:	
SCALE:	
FILE:	

VERIFY SCALES
0 1"
BAR EQUALS ONE INCH
ON ORIGINAL DRAWING

SHEET:
2/7

COB #

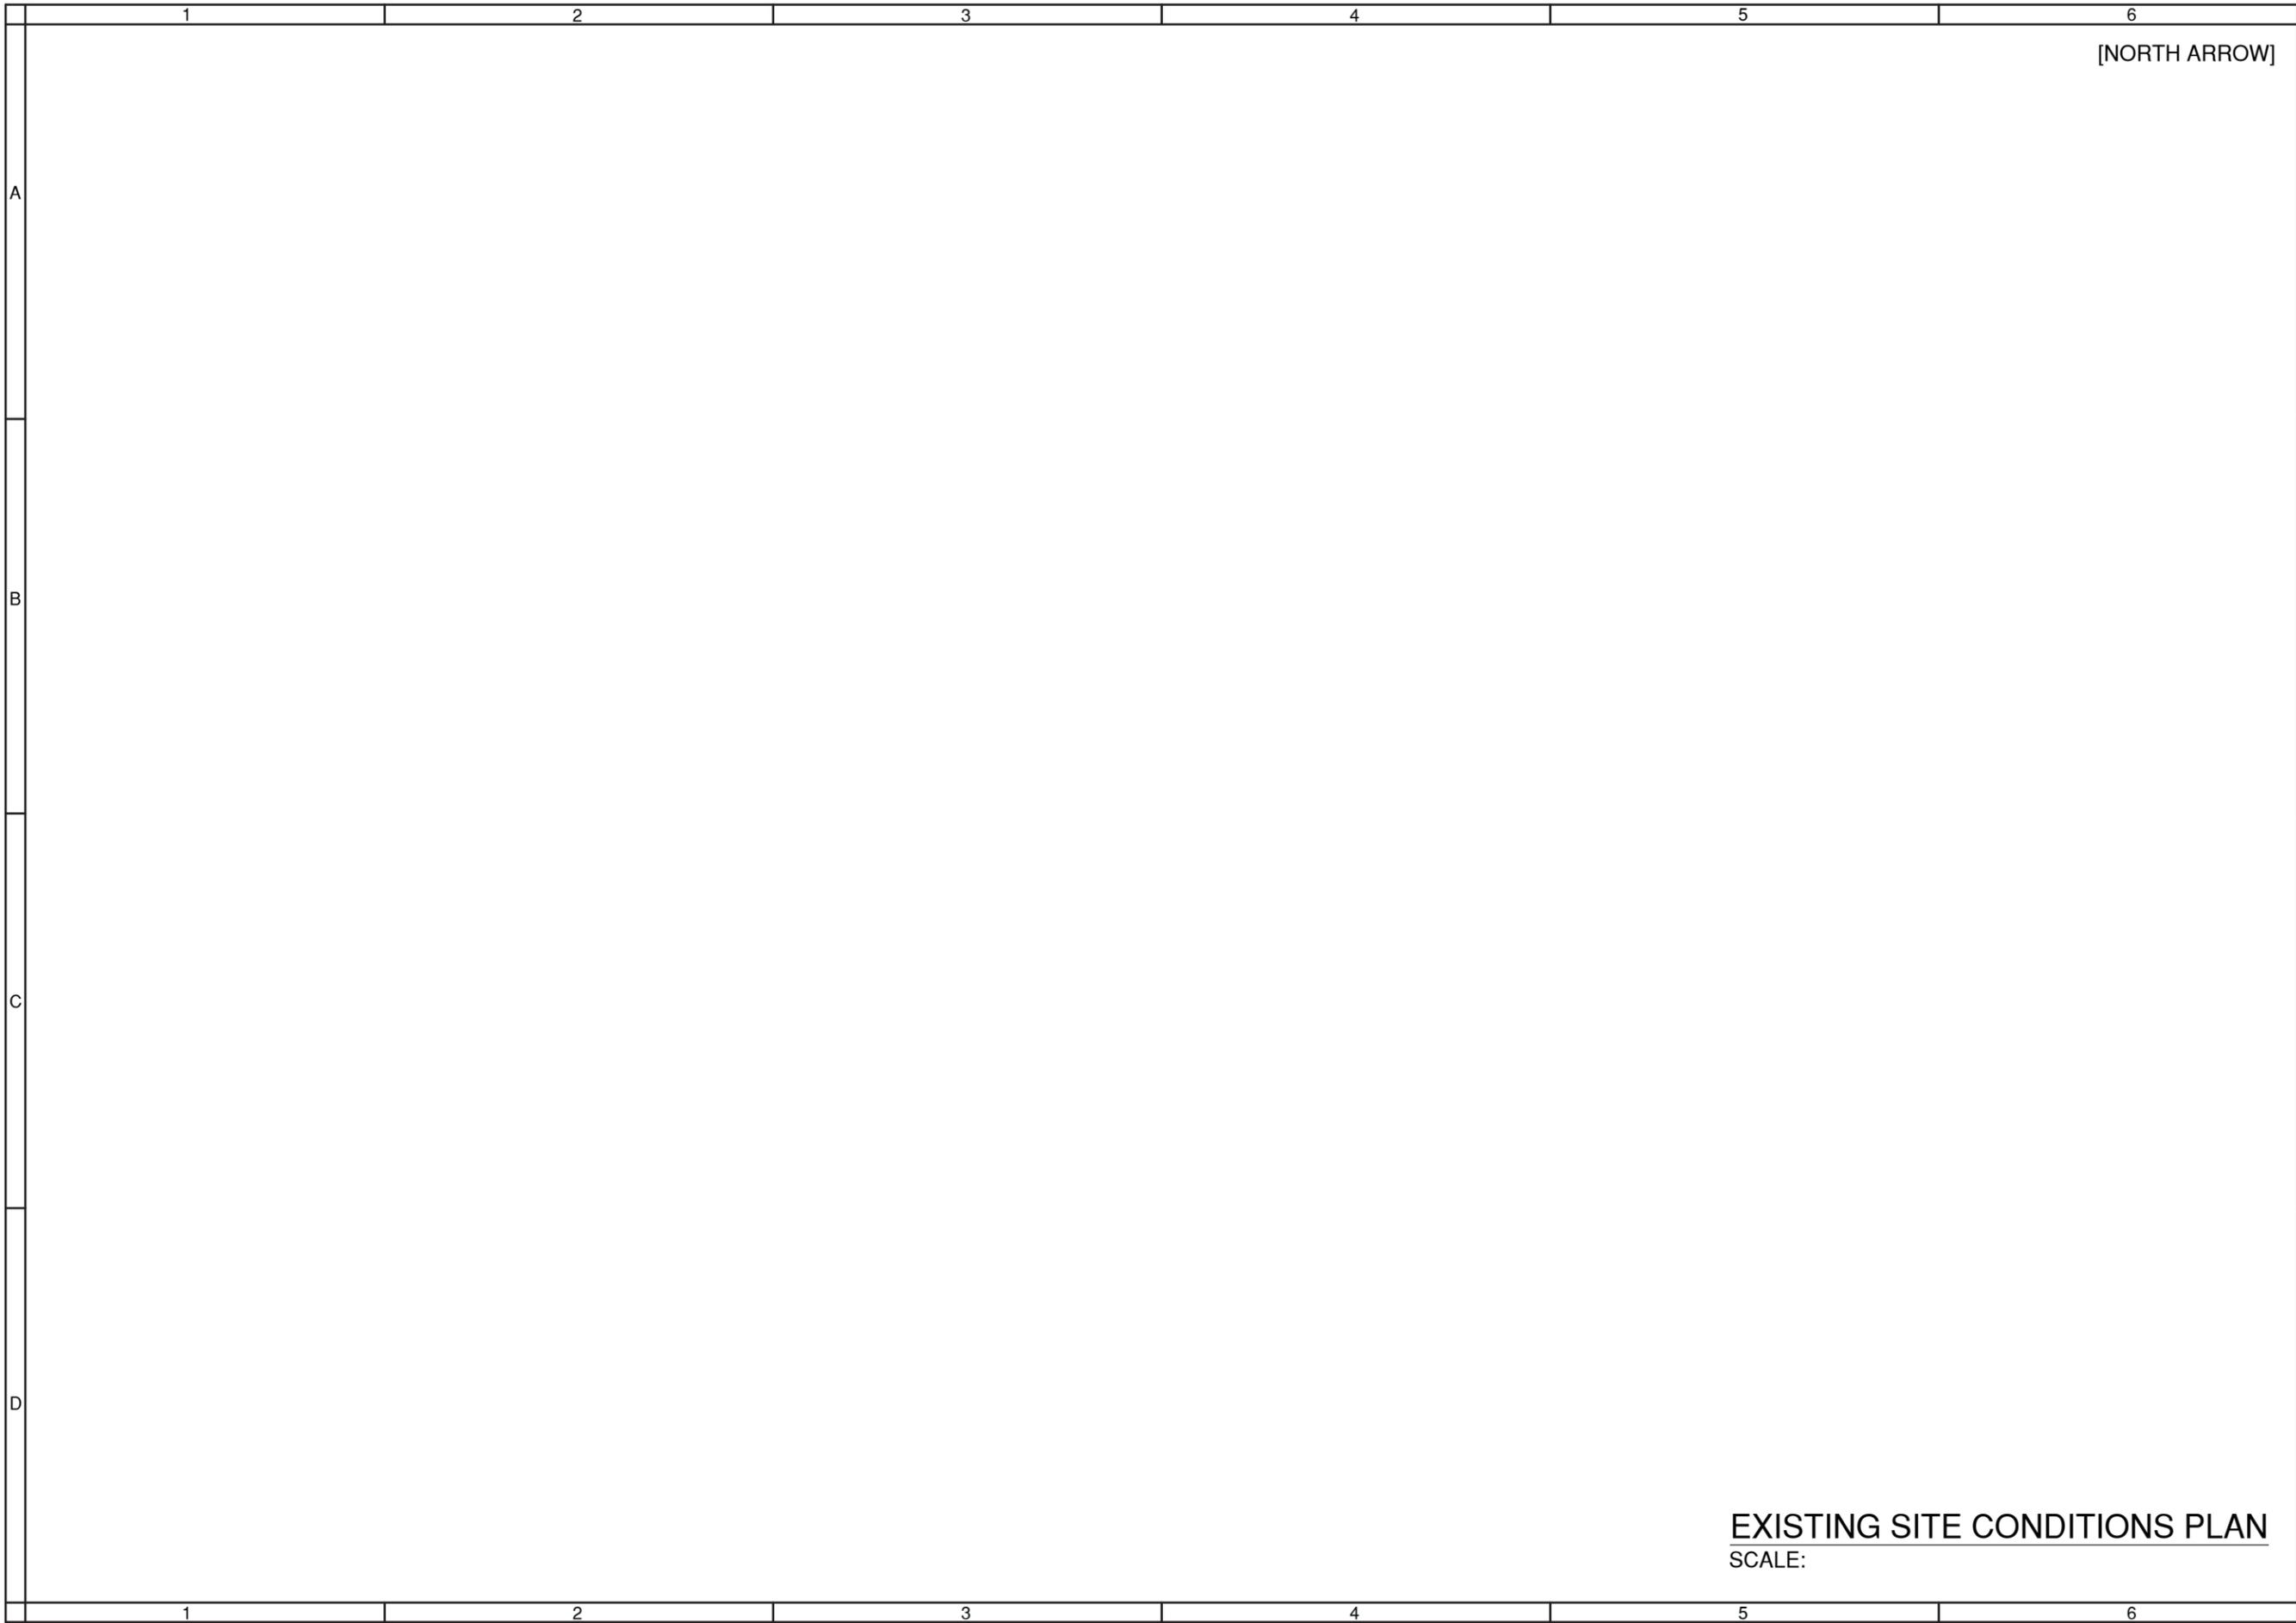

[NORTH ARROW]

STAMP
[ENGINEERS]

[PROJECT NAME]
[PROJECT NAME 2ND LINE]
EXISTING CONDITIONS
DESCHUTES COUNTY, OREGON



CITY OF BEND

REVISIONS:
1. _____
2. _____
3. _____

[COMPANY NAME]
[COMPANY ADDRESS]

 
DESIGNED BY: _____
DRAWN BY: _____
SCALE: _____
FILE: _____
DATE: / /

VERIFY SCALES
0 1"
BAR EQUALS ONE INCH
ON ORIGINAL DRAWING

SHEET:
3/7

COB #

EXISTING SITE CONDITIONS PLAN
SCALE:



[NORTH ARROW]

STAMP
[ENGINEERS]

[PROJECT NAME]
[PROJECT NAME 2ND LINE]
EROSION CONTROL
DESCHUTES COUNTY, OREGON



CITY OF BEND

REVISIONS:
1. _____
2. _____
3. _____

[COMPANY NAME]
[COMPANY ADDRESS]

DESIGNED BY: _____
DRAWN BY: _____
SCALE: _____
FILE: _____
DATE: ____/____/____

VERIFY SCALES
0 1"
BAR EQUALS ONE INCH
ON ORIGINAL DRAWING

SHEET:
4/7

COB #

	1	2	3	4	5	6
A	[NORTH ARROW]					
B	<p>SITE PLAN SCALE:</p>					

C	<p>CROSS SECTION</p> <p>DETAIL TITLE 2 NOT TO SCALE</p>					
D	<p>TYPICAL SECTION</p> <p>DETAIL TITLE 2 NOT TO SCALE</p>					
	1	2	3	4	5	6

STAMP
[ENGINEERS]

[PROJECT NAME]
[PROJECT NAME 2ND LINE]
SITE PLAN & PROFILE
DESCHUTES COUNTY, OREGON




REVISIONS:

1.	
2.	
3.	


[COMPANY NAME]
[COMPANY ADDRESS]

DESIGNED BY: _____
DRAWN BY: _____
SCALE: _____
FILE: _____
DATE: / /

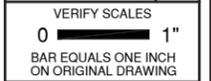

SHEET:
5/7

COB #

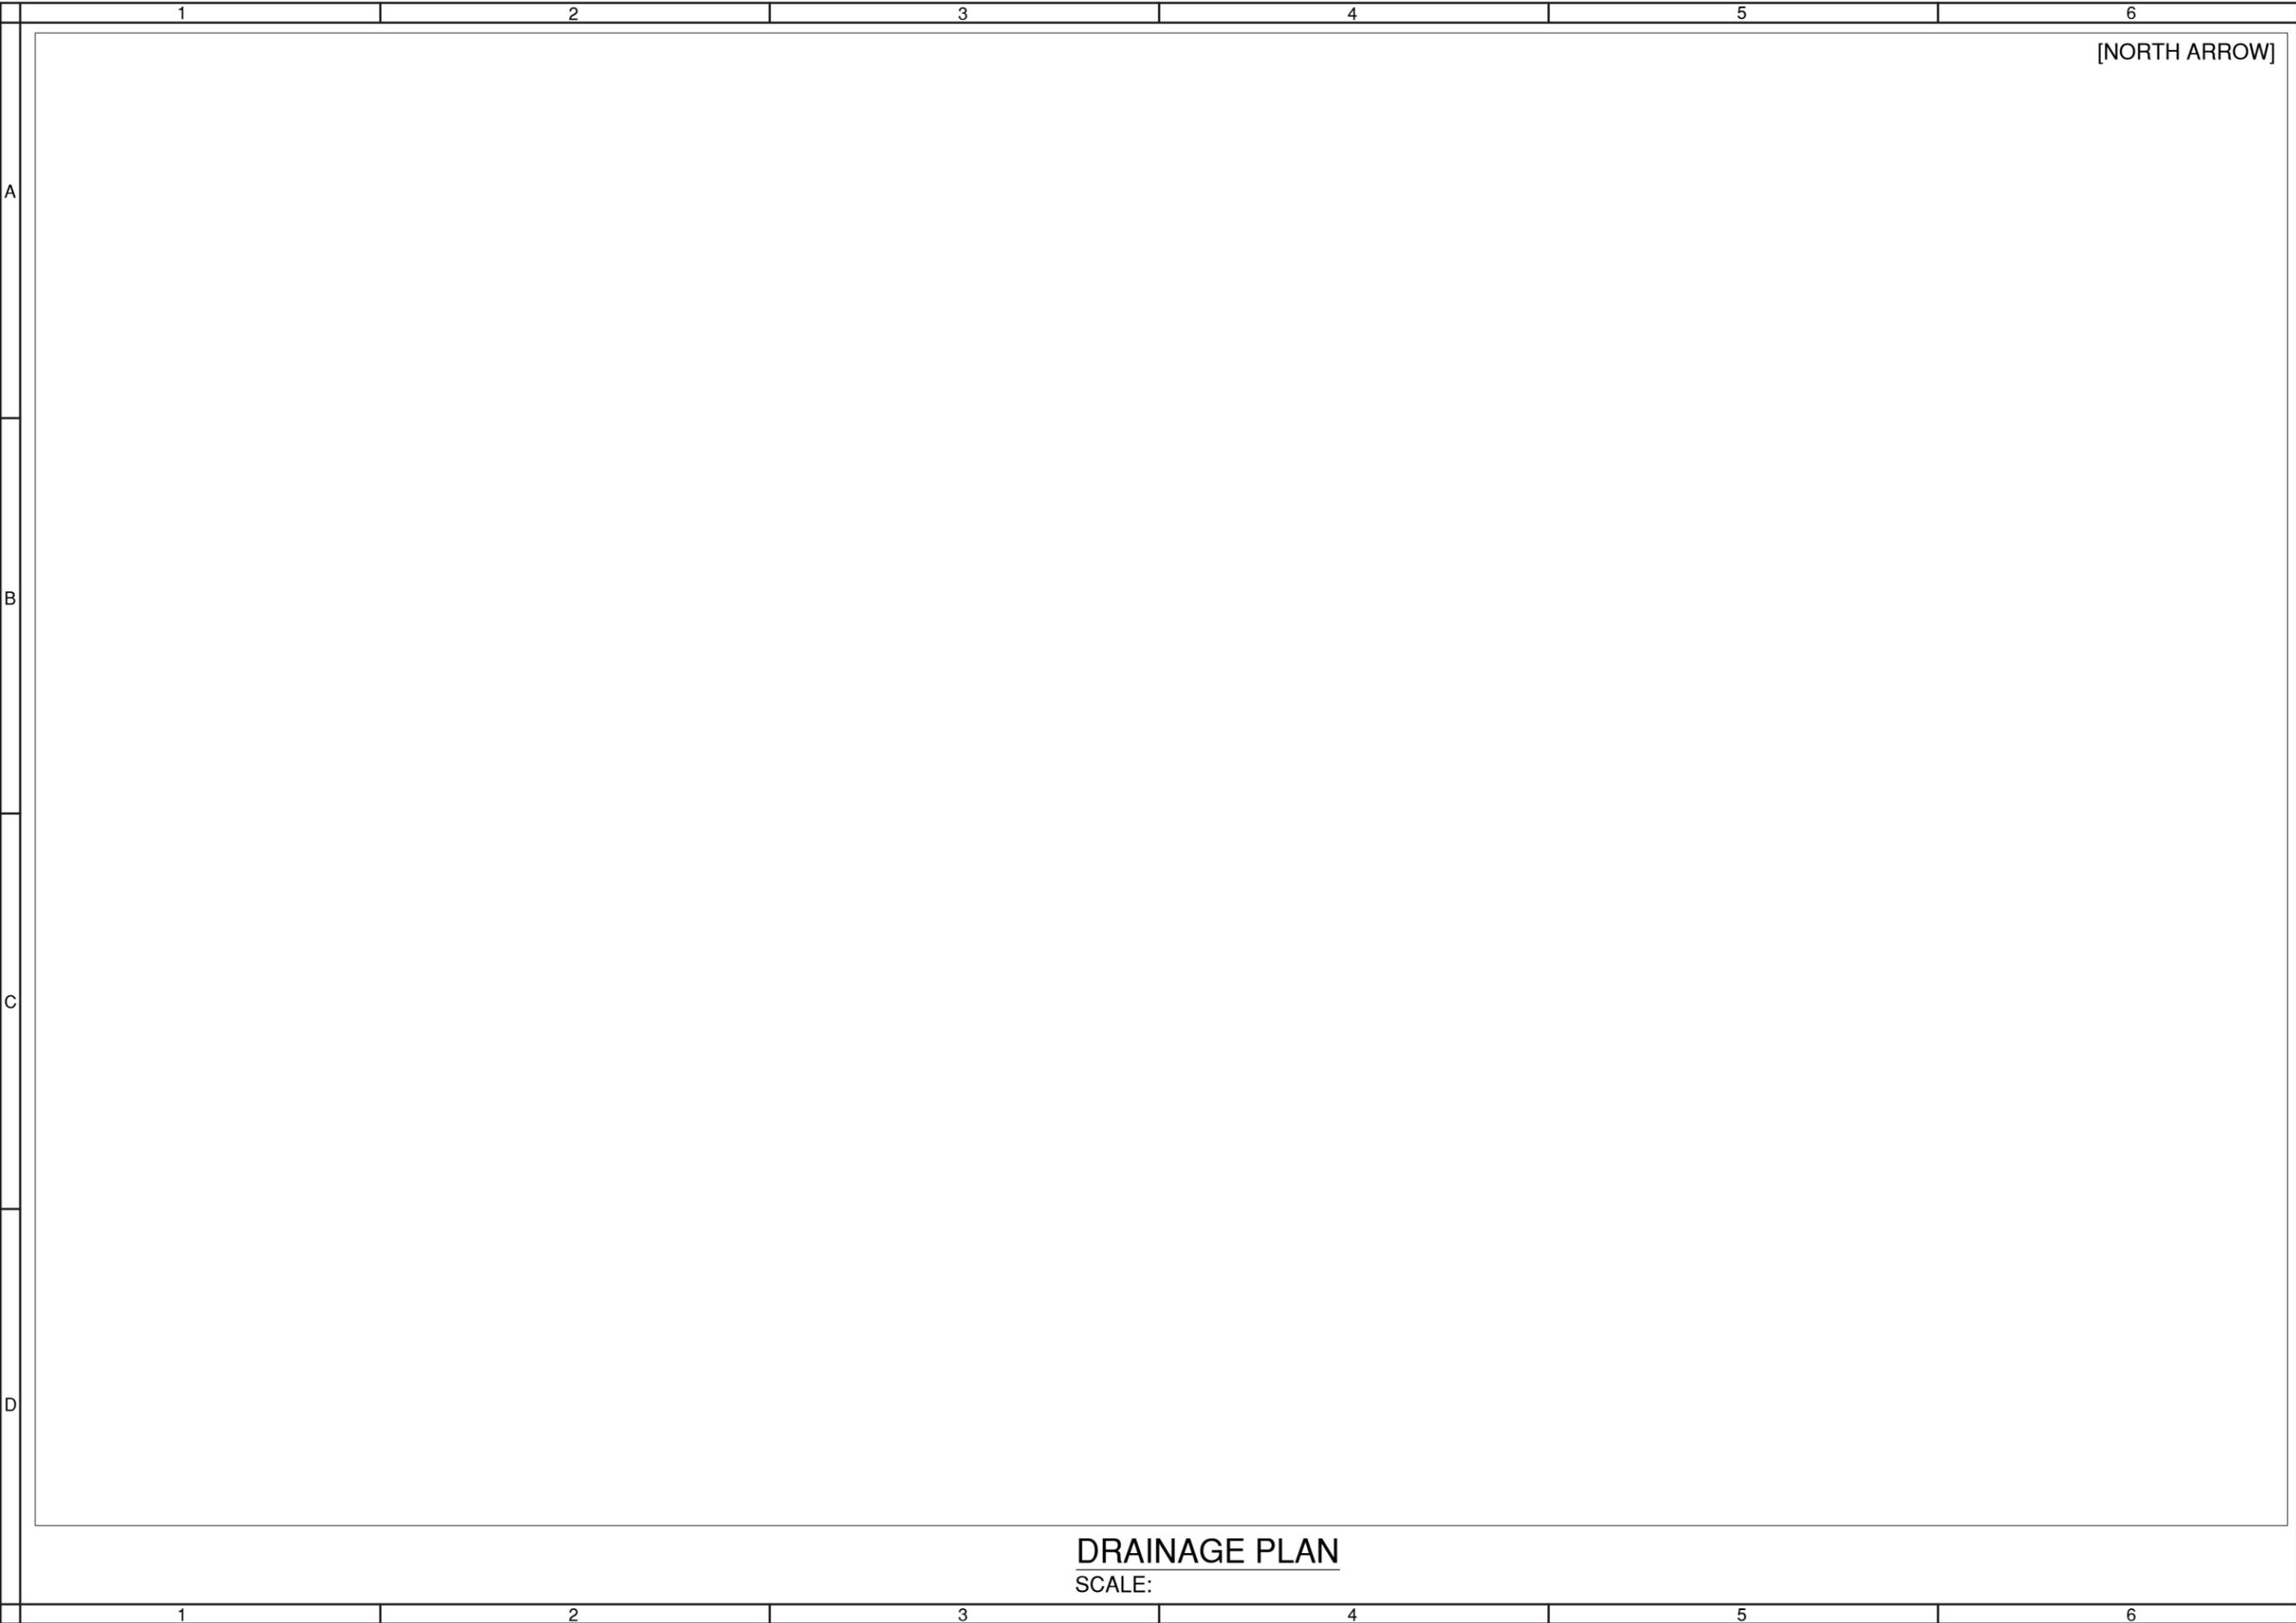

[NORTH ARROW]

A
B
C
D

1 2 3 4 5 6

1 2 3 4 5 6

DRAINAGE PLAN
SCALE:

STAMP
[ENGINEERS]

[PROJECT NAME]
[PROJECT NAME 2ND LINE]
GRADING PLAN & PROFILE
DESCHUTES COUNTY, OREGON



REVISIONS:

1.	
2.	
3.	

[COMPANY NAME]
[COMPANY ADDRESS]

DESIGNED BY: _____
DRAWN BY: _____
SCALE: _____
FILE: _____
DATE: / /




VERIFY SCALES
0 1"
BAR EQUALS ONE INCH
ON ORIGINAL DRAWING

SHEET:
6/7

COB #

1	2	3	4	5	6																													
A					A																													
B					B																													
C					C																													
D					D																													
<table border="1" style="width: 100%; border-collapse: collapse;"> <tr> <td style="width: 10%; font-size: 8px;">DRAWN</td> <td style="width: 10%; font-size: 8px;">BY: WAT/SEW/STORM</td> <td style="width: 50%; text-align: center;">CITY OF BEND STANDARDS AND SPECIFICATIONS <small>710 NW WALL ST., BEND, OREGON 97701</small></td> <td style="width: 20%; font-size: 8px;">SCALE: NTS</td> </tr> <tr> <td style="font-size: 8px;">REV</td> <td style="font-size: 8px;">DATE</td> <td style="font-size: 8px;">APPR</td> <td style="font-size: 8px;">DATE: 6/5/2009</td> </tr> <tr> <td colspan="2" style="text-align: center;">DETAIL TITLE</td> <td style="font-size: 8px;">APPR</td> <td style="font-size: 8px;">DRW NO</td> </tr> </table>		DRAWN	BY: WAT/SEW/STORM	CITY OF BEND STANDARDS AND SPECIFICATIONS <small>710 NW WALL ST., BEND, OREGON 97701</small>	SCALE: NTS	REV	DATE	APPR	DATE: 6/5/2009	DETAIL TITLE		APPR	DRW NO	<p style="font-size: 14px; margin: 0;">SPECIAL DETAIL</p> <p style="font-size: 10px; margin: 5px 0;">DETAIL TITLE 1 NOT TO SCALE</p>		<p style="font-size: 10px; margin: 0;">STAMP [ENGINEERS]</p>																		
DRAWN	BY: WAT/SEW/STORM	CITY OF BEND STANDARDS AND SPECIFICATIONS <small>710 NW WALL ST., BEND, OREGON 97701</small>	SCALE: NTS																															
REV	DATE	APPR	DATE: 6/5/2009																															
DETAIL TITLE		APPR	DRW NO																															
<table border="1" style="width: 100%; border-collapse: collapse;"> <tr> <td style="width: 10%; font-size: 8px;">DRAWN</td> <td style="width: 10%; font-size: 8px;">BY: WAT/SEW/STORM</td> <td style="width: 50%; text-align: center;">CITY OF BEND STANDARDS AND SPECIFICATIONS <small>710 NW WALL ST., BEND, OREGON 97701</small></td> <td style="width: 20%; font-size: 8px;">SCALE: NTS</td> </tr> <tr> <td style="font-size: 8px;">REV</td> <td style="font-size: 8px;">DATE</td> <td style="font-size: 8px;">APPR</td> <td style="font-size: 8px;">DATE: 6/5/2009</td> </tr> <tr> <td colspan="2" style="text-align: center;">DETAIL TITLE</td> <td style="font-size: 8px;">APPR</td> <td style="font-size: 8px;">DRW NO</td> </tr> </table>		DRAWN	BY: WAT/SEW/STORM	CITY OF BEND STANDARDS AND SPECIFICATIONS <small>710 NW WALL ST., BEND, OREGON 97701</small>	SCALE: NTS	REV	DATE	APPR	DATE: 6/5/2009	DETAIL TITLE		APPR	DRW NO	<p style="font-size: 14px; margin: 0;">SPECIAL DETAIL</p> <p style="font-size: 10px; margin: 5px 0;">DETAIL TITLE 2 NOT TO SCALE</p>		<p style="font-size: 10px; margin: 0;">[PROJECT NAME] [PROJECT NAME 2ND LINE] DETAILS DESCHUTES COUNTY, OREGON</p>  <p style="font-size: 8px; margin: 0;">CITY OF BEND</p> <table border="1" style="width: 100%; border-collapse: collapse; font-size: 6px;"> <tr> <td style="width: 10%;">REVISIONS:</td> <td style="width: 10%;">1</td> <td style="width: 10%;">2</td> <td style="width: 10%;">3</td> </tr> <tr> <td style="border: none;"></td> <td style="border: none;"></td> <td style="border: none;"></td> <td style="border: none;"></td> </tr> </table> <p style="font-size: 10px; margin: 5px 0;">[COMPANY NAME] [COMPANY ADDRESS]</p> <table border="1" style="width: 100%; border-collapse: collapse; font-size: 8px;"> <tr> <td style="width: 20%;">DESIGNED BY:</td> <td style="width: 20%;">DRAWN BY:</td> <td style="width: 20%;">SCALE:</td> <td style="width: 20%;">FILER:</td> <td style="width: 20%;">DATE: / /</td> </tr> <tr> <td style="border: none;"></td> </tr> </table> <p style="font-size: 8px; margin: 0;">VERIFY SCALES 0 1" BAR EQUALS ONE INCH ON ORIGINAL DRAWING</p> <p style="font-size: 12px; margin: 0;">SHEET: 7/7</p> <p style="font-size: 8px; margin: 0;">COB #</p>	REVISIONS:	1	2	3					DESIGNED BY:	DRAWN BY:	SCALE:	FILER:	DATE: / /					
DRAWN	BY: WAT/SEW/STORM	CITY OF BEND STANDARDS AND SPECIFICATIONS <small>710 NW WALL ST., BEND, OREGON 97701</small>	SCALE: NTS																															
REV	DATE	APPR	DATE: 6/5/2009																															
DETAIL TITLE		APPR	DRW NO																															
REVISIONS:	1	2	3																															
DESIGNED BY:	DRAWN BY:	SCALE:	FILER:	DATE: / /																														
<table border="1" style="width: 100%; border-collapse: collapse;"> <tr> <td style="width: 10%; font-size: 8px;">DRAWN</td> <td style="width: 10%; font-size: 8px;">BY: WAT/SEW/STORM</td> <td style="width: 50%; text-align: center;">CITY OF BEND STANDARDS AND SPECIFICATIONS <small>710 NW WALL ST., BEND, OREGON 97701</small></td> <td style="width: 20%; font-size: 8px;">SCALE: NTS</td> </tr> <tr> <td style="font-size: 8px;">REV</td> <td style="font-size: 8px;">DATE</td> <td style="font-size: 8px;">APPR</td> <td style="font-size: 8px;">DATE: 6/5/2009</td> </tr> <tr> <td colspan="2" style="text-align: center;">DETAIL TITLE</td> <td style="font-size: 8px;">APPR</td> <td style="font-size: 8px;">DRW NO</td> </tr> </table>		DRAWN	BY: WAT/SEW/STORM	CITY OF BEND STANDARDS AND SPECIFICATIONS <small>710 NW WALL ST., BEND, OREGON 97701</small>	SCALE: NTS	REV	DATE	APPR	DATE: 6/5/2009	DETAIL TITLE		APPR	DRW NO	<p style="font-size: 14px; margin: 0;">SPECIAL DETAIL</p> <p style="font-size: 10px; margin: 5px 0;">DETAIL TITLE 3 NOT TO SCALE</p>		<p style="font-size: 10px; margin: 0;">[PROJECT NAME] [PROJECT NAME 2ND LINE] DETAILS DESCHUTES COUNTY, OREGON</p>  <p style="font-size: 8px; margin: 0;">CITY OF BEND</p> <table border="1" style="width: 100%; border-collapse: collapse; font-size: 6px;"> <tr> <td style="width: 10%;">REVISIONS:</td> <td style="width: 10%;">1</td> <td style="width: 10%;">2</td> <td style="width: 10%;">3</td> </tr> <tr> <td style="border: none;"></td> <td style="border: none;"></td> <td style="border: none;"></td> <td style="border: none;"></td> </tr> </table> <p style="font-size: 10px; margin: 5px 0;">[COMPANY NAME] [COMPANY ADDRESS]</p> <table border="1" style="width: 100%; border-collapse: collapse; font-size: 8px;"> <tr> <td style="width: 20%;">DESIGNED BY:</td> <td style="width: 20%;">DRAWN BY:</td> <td style="width: 20%;">SCALE:</td> <td style="width: 20%;">FILER:</td> <td style="width: 20%;">DATE: / /</td> </tr> <tr> <td style="border: none;"></td> </tr> </table> <p style="font-size: 8px; margin: 0;">VERIFY SCALES 0 1" BAR EQUALS ONE INCH ON ORIGINAL DRAWING</p> <p style="font-size: 12px; margin: 0;">SHEET: 7/7</p> <p style="font-size: 8px; margin: 0;">COB #</p>	REVISIONS:	1	2	3					DESIGNED BY:	DRAWN BY:	SCALE:	FILER:	DATE: / /					
DRAWN	BY: WAT/SEW/STORM	CITY OF BEND STANDARDS AND SPECIFICATIONS <small>710 NW WALL ST., BEND, OREGON 97701</small>	SCALE: NTS																															
REV	DATE	APPR	DATE: 6/5/2009																															
DETAIL TITLE		APPR	DRW NO																															
REVISIONS:	1	2	3																															
DESIGNED BY:	DRAWN BY:	SCALE:	FILER:	DATE: / /																														
<table border="1" style="width: 100%; border-collapse: collapse;"> <tr> <td style="width: 10%; font-size: 8px;">DRAWN</td> <td style="width: 10%; font-size: 8px;">BY: WAT/SEW/STORM</td> <td style="width: 50%; text-align: center;">CITY OF BEND STANDARDS AND SPECIFICATIONS <small>710 NW WALL ST., BEND, OREGON 97701</small></td> <td style="width: 20%; font-size: 8px;">SCALE: NTS</td> </tr> <tr> <td style="font-size: 8px;">REV</td> <td style="font-size: 8px;">DATE</td> <td style="font-size: 8px;">APPR</td> <td style="font-size: 8px;">DATE: 6/5/2009</td> </tr> <tr> <td colspan="2" style="text-align: center;">DETAIL TITLE</td> <td style="font-size: 8px;">APPR</td> <td style="font-size: 8px;">DRW NO</td> </tr> </table>		DRAWN	BY: WAT/SEW/STORM	CITY OF BEND STANDARDS AND SPECIFICATIONS <small>710 NW WALL ST., BEND, OREGON 97701</small>	SCALE: NTS	REV	DATE	APPR	DATE: 6/5/2009	DETAIL TITLE		APPR	DRW NO	<p style="font-size: 14px; margin: 0;">SPECIAL DETAIL</p> <p style="font-size: 10px; margin: 5px 0;">DETAIL TITLE 4 NOT TO SCALE</p>		<p style="font-size: 10px; margin: 0;">[PROJECT NAME] [PROJECT NAME 2ND LINE] DETAILS DESCHUTES COUNTY, OREGON</p>  <p style="font-size: 8px; margin: 0;">CITY OF BEND</p> <table border="1" style="width: 100%; border-collapse: collapse; font-size: 6px;"> <tr> <td style="width: 10%;">REVISIONS:</td> <td style="width: 10%;">1</td> <td style="width: 10%;">2</td> <td style="width: 10%;">3</td> </tr> <tr> <td style="border: none;"></td> <td style="border: none;"></td> <td style="border: none;"></td> <td style="border: none;"></td> </tr> </table> <p style="font-size: 10px; margin: 5px 0;">[COMPANY NAME] [COMPANY ADDRESS]</p> <table border="1" style="width: 100%; border-collapse: collapse; font-size: 8px;"> <tr> <td style="width: 20%;">DESIGNED BY:</td> <td style="width: 20%;">DRAWN BY:</td> <td style="width: 20%;">SCALE:</td> <td style="width: 20%;">FILER:</td> <td style="width: 20%;">DATE: / /</td> </tr> <tr> <td style="border: none;"></td> </tr> </table> <p style="font-size: 8px; margin: 0;">VERIFY SCALES 0 1" BAR EQUALS ONE INCH ON ORIGINAL DRAWING</p> <p style="font-size: 12px; margin: 0;">SHEET: 7/7</p> <p style="font-size: 8px; margin: 0;">COB #</p>	REVISIONS:	1	2	3					DESIGNED BY:	DRAWN BY:	SCALE:	FILER:	DATE: / /					
DRAWN	BY: WAT/SEW/STORM	CITY OF BEND STANDARDS AND SPECIFICATIONS <small>710 NW WALL ST., BEND, OREGON 97701</small>	SCALE: NTS																															
REV	DATE	APPR	DATE: 6/5/2009																															
DETAIL TITLE		APPR	DRW NO																															
REVISIONS:	1	2	3																															
DESIGNED BY:	DRAWN BY:	SCALE:	FILER:	DATE: / /																														
1	2	3	4	5	6																													

DRAWING INDEX	
1	G-000 COVER
2	G-001 INDEX, SIGNATURE BLOCK, AND NOTES
3	G-002 GENERAL LEGEND AND PIPING SYMBOLS
4	G-003 PROCESS EQUIPMENT LEGEND AND PIPING SYMBOLS
5	G-004 INSTRUMENTATION LEGEND AND SYMBOLS
6	G-005 ELECTRICAL NOTES AND STANDARD SYMBOLS
7	G-006 ELECTRICAL NOTES AND STANDARD SYMBOLS
8	G-007 GENERAL STRUCTURAL NOTES
9	G-008 BASIS OF DESIGN
1	C-001 DEMOLITION AND EROSION CONTROL PLAN
11	C-002 SITE PLAN
12	C-003 GRADING AND DRAINAGE
13	C-004 GRAVITY SEWER PLAN AND PROFILE
14	C-005 FORCE MAIN SEWER PLAN AND PROFILE
15	C-006 CIVIL DETAILS
16	L-001 LANDSCAPE PLAN AND DETAILS (INCLUDE IF REQUIRED)
17	L-002 IRRIGATION PLAN AND DETAILS (INCLUDE IF REQUIRED)
18	M-101 LIFT STATION MECHANICAL PLAN
19	M-102 LIFT STATION MECHANICAL SECTION
20	M-103 MECHANICAL DETAILS
21	M-104 MECHANICAL DETAILS
22	I-001 STANDARD P&ID CONSTANT
24	I-002 TEMPLATE (50 I/Os) PANEL LAYOUT
25	I-003 (50 I/Os) BILL OF MATERIALS
26	I-004 (50 I/Os) PWR WIRING SCHEMATIC
27	I-005 (50 I/Os) PWR WIRING SCHEMATIC
28	I-006 (50 I/Os) DIGITAL INPUT MODULE 1
29	I-007 (50 I/Os) DIGITAL INPUT MODULE 2
30	I-008 (50 I/Os) ANALOG INPUT MODULE
31	I-009 INTRINSIC SAFETY RELAY PANEL (ISRP)
32	I-010 COMMUNICATION NETWORK DIAGRAM
33	E-001 ELECTRICAL SITE PLAN
34	E-002 MAIN CONTROL CABINET LAYOUT
35	E-003 ELECTRICAL ONE LINE DIAGRAM
36	E-004 CONDUIT AND WIRE SCHEDULE
37	E-005 WETWELL ISOLATION PEDESTAL
38	E-006 ELECTRICAL DETAILS
39	E-007 PUMP 1 WIRING DIAGRAM
40	E-008 PUMP 2 WIRING DIAGRAM
41	E-009 PUMP STATION FLOW LOOP SHEET
42	E-010 WETWELL LEVEL LOOP SHEET
43	E-011 STANDBY GENERATOR LOOP SHEET
44	E-012 AUTO-TRANSFER SWITCH LOOP SHEET
45	E-013 WETWELL HIGH HIGH LEVEL LOOP SHEET
46	E-014 HATCH INTRUSION LOOP SHEET
47	E-015 MAIN CONTROL CAB INSTRUSION LOOP SHEET

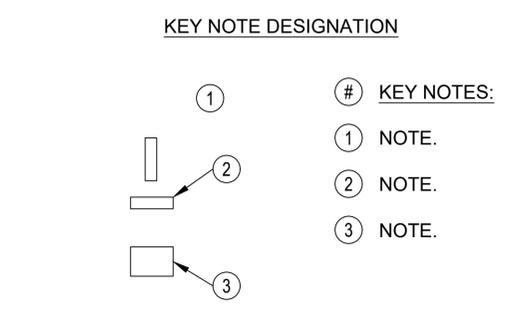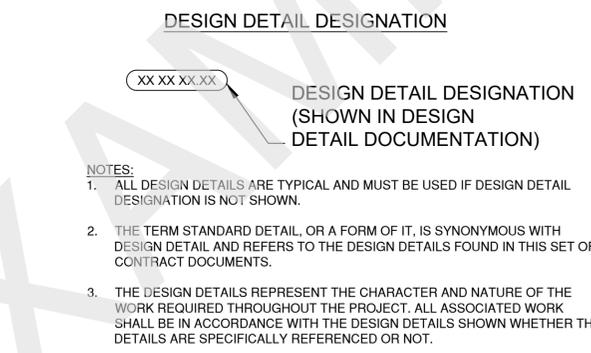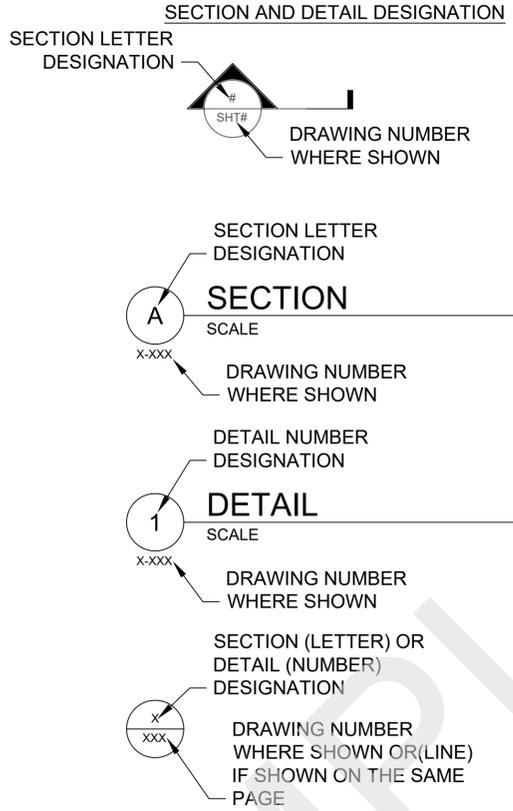

CONSTRUCTION NOTES:

- NO CONSTRUCTION SHALL BE STARTED WITHOUT A NOTICE TO PROCEED BY THE CITY ENGINEERING DEPARTMENT. THE CITY ENGINEERING DEPARTMENT AND THE DESIGN ENGINEER SHALL BE NOTIFIED AT LEAST 24 HOURS PRIOR TO THE START OF CONSTRUCTION. ANY CONSTRUCTION WORK DONE PRIOR TO NOTICE TO PROCEED BEING ISSUED OR WITHOUT INSPECTION WILL BE REJECTED.
- CONTRACTOR SHALL VERIFY ALL CONDITIONS ON THE JOB SITE INCLUDING BUT NOT LIMITED TO, ALL DIMENSIONS, GRADES, ELEVATIONS, EXTENT AND COMPATIBILITY TO THE EXISTING SITE CONDITIONS, AND WITH THE WORK DESCRIBED ON THE ENGINEER'S DRAWINGS. ANY DISCREPANCIES OR UNEXPECTED CONDITIONS THAT AFFECT OR CHANGE THE WORK DESCRIBED IN THE CONTRACT DOCUMENTS SHALL BE BROUGHT TO THE ENGINEER'S ATTENTION IMMEDIATELY. CONTRACTOR SHALL NOT PROCEED WITH ANY OF THE WORK IN THE AREA OF DISCREPANCIES UNTIL ALL SUCH DISCREPANCIES ARE RESOLVED. IF THE CONTRACTOR CHOOSES TO DO SO, THEN IT IS UNDERSTOOD THAT THE CONTRACTOR IS CHOOSING TO PROCEED AT THE CONTRACTOR'S OWN RISK AND SHALL INCUR ALL COSTS, IF ANY TO RESOLVE THE ISSUES TO THE SATISFACTION OF THE ENGINEER.
- A CITY INSPECTOR ACTING ON BEHALF OF THE CITY MAY REQUIRE REVISIONS IN PLANS TO SOLVE UNFORESEEN PROBLEMS THAT MAY ARISE IN THE FIELD.
- ALL CONSTRUCTION WORK AND INSTALLATIONS SHALL CONFORM TO THE CITY STANDARDS AND SPECIFICATIONS, AND ALL WORK SHALL BE SUBJECT TO THE APPROVAL OF THE CITY.
- IT SHALL BE THE RESPONSIBILITY OF THE CONTRACTOR TO CONTACT "UNDERGROUND LOCATE SERVICE" AT 1-800-332-2344 AT LEAST 48 BUSINESS-DAY HOURS PRIOR TO THE START OF CONSTRUCTION FOR THE LOCATION OF POWER, GAS, CABLE TV AND TELEPHONE UNDERGROUND FACILITIES. THE CONTRACTOR WILL ALSO BE RESPONSIBLE FOR CONTACTING THE APPROPRIATE PUBLIC AGENCY FOR THE LOCATION OF UNDERGROUND FACILITIES.
- ALL UTILITIES SHOWN ARE ACCURATE TO THE EXTENT OF AVAILABLE RECORDS AND KNOWLEDGE. NO POTHOLING TO VERIFY LOCATIONS AND ELEVATIONS WAS AUTHORIZED BY THE OWNER. THE CONTRACTOR HAS THE TOTAL RESPONSIBILITY TO VERIFY THE LOCATION OF EXISTING UNDERGROUND UTILITIES AND TO NOTIFY THE UTILITY COMPANIES WHEN WORKING IN THEIR PROXIMITY. CONTRACTOR TO VERIFY LOCATION OF EXISTING UTILITIES PRIOR TO CONSTRUCTION. OREGON LAW REQUIRES YOU TO FOLLOW RULES ADOPTED BY THE OREGON UTILITY NOTIFICATION CENTER. THOSE RULES ARE SET FORTH IN OAR 952-001-0010 THROUGH 952-001-0090. YOU MAY OBTAIN COPIES OF THE RULES BY CALLING THE CENTER. THE TELEPHONE NUMBER FOR THE OREGON UTILITY NOTIFICATION CENTER IS (503)232-2987.
- ALL GRADING SHALL BE IN CONFORMANCE WITH THE CURRENT CITY STANDARDS AND SPECIFICATIONS AND CURRENT GRADING ORDINANCE. ALL SUBGRADE MATERIAL SHALL BE CONSIDERED CLASS A AND COMPACTED TO 95% OF OPTIMUM DENSITY, AS SPECIFIED IN THESE PLANS. ALL FILL MATERIAL SHALL BE COMPACTED TO 95% RELATIVE COMPACTION PER THE CITY TESTING REQUIREMENTS.
- ALL FINAL CUT SLOPES SHALL NOT EXCEED A GRADE OF 2 TO 1 VERTICAL UNLESS OTHERWISE APPROVED. FILL SLOPES SHALL NOT EXCEED A GRADE OF 2 HORIZONTAL TO 1 VERTICAL UNLESS OTHERWISE APPROVED BY THE ENGINEER.
- ALL UNSUITABLE SOILS MATERIALS, RUBBISH AND DEBRIS RESULTING FROM GRADING OPERATIONS SHALL BE REMOVED FROM THE JOB SITE AND DISPOSED OF PROPERLY.
- THE CONTRACTOR SHALL EMPLOY ALL LABOR, EQUIPMENT, AND METHODS REQUIRED TO PREVENT DUST IN AMOUNTS DAMAGING TO PROPERTY, CULTIVATED VEGETATION AND DOMESTIC ANIMALS OR CAUSING A NUISANCE TO PERSONS OCCUPYING BUILDINGS IN THE VICINITY OF THE JOB SITE. THE CONTRACTOR SHALL BE RESPONSIBLE FOR ANY DAMAGE CAUSED BY DUST RESULTING FROM CONSTRUCTION.
- THE CONTRACTOR SHALL FOLLOW ALL APPLICABLE INDUSTRIAL SAFETY REGULATIONS. THE CITY AND DESCHUTES COUNTY AND THEIR OFFICIALS, THE ENGINEER, AND THE OWNER SHALL NOT BE RESPONSIBLE FOR ENFORCING SAFETY REGULATIONS.
- MATERIAL QUANTITIES USED, NOTED, OR PROVIDED IN A SEPARATE ITEMIZED QUANTITY TAKE-OFF ARE AN ENGINEER'S OPINION OF PROBABLE MATERIAL REQUIREMENTS, AND IS AN ESTIMATE ONLY. CONTRACTOR'S HAVE THE SOLE RESPONSIBILITY OF MAKING THEIR OWN QUANTITY TAKE-OFF AND COST ESTIMATE.
- ALL WORK SHALL BE PERFORMED BY A CITY APPROVED CONTRACTOR.
- UTILITIES SHALL HAVE THE RIGHT TO INSTALL, MAINTAIN, AND OPERATE THEIR EQUIPMENT ABOVE AND BELOW GROUND AND ALL OTHER RELATED FACILITIES WITHIN THE PUBLIC UTILITY EASEMENTS (PUE) IDENTIFIED ON THIS PLAT MAP AS MAY BE NECESSARY OR DESIRABLE IN SERVING THE LOTS IDENTIFIED HEREIN, INCLUDING THE RIGHT OF ACCESS TO SUCH FACILITIES AND THE RIGHT TO REQUIRE THE REMOVAL OF ANY OBSTRUCTIONS INCLUDING TREES AND VEGETATION THAT MAY BE PLACED WITHIN THE PUE AT THE LOT OWNERS EXPENSE. AT NO TIME MAY ANY PERMANENT STRUCTURES BE PLACED WITHIN THE PUE OR ANY OTHER OBSTRUCTION WHICH INTERFERES WITH THE USE OF THE PUE WITHOUT PRIOR WRITTEN APPROVAL OF THE UTILITIES AND FACILITIES IN THE PUE.
- CITY ENGINEER'S SIGNATURE DOES NOT CONSTITUTE APPROVAL OF FACILITIES PROPOSED ON PRIVATE PROPERTY. SEPARATE PERMITS ISSUED BY THE BUILDING DEPARTMENT ARE REQUIRED AND SHALL BE OBTAINED BY THE DEVELOPER FOR FACILITIES LOCATED OUTSIDE OF THE PUBLIC RIGHT-OF-WAY.
- ANY WORK WITHIN EXISTING PUBLIC RIGHT-OF-WAY OR DEDICATED CITY EASEMENTS REQUIRES A SEPARATE RIGHT-OF-WAY EXCAVATION PERMIT OBTAINED FROM THE CITY ENGINEERING DIVISION.

SANITARY SEWER SYSTEM

APPROVED FOR CONSTRUCTION

DATE

FOR SAMPLE ONLY

RECORD DRAWINGS

REVISIONS DRAWN BY: XX DATE: XX/XX/XX

THESE RECORD DRAWINGS HAVE BEEN PREPARED, IN PART, ON THE BASIS OF INFORMATION COMPILED BY OTHERS. THEY ARE NOT INTENDED TO REPRESENT IN DETAIL THE EXACT LOCATION, TYPE OF COMPONENT NOR MANNER OF CONSTRUCTION. THE ENGINEER WILL NOT BE RESPONSIBLE FOR ANY ERRORS OR OMISSIONS WHICH HAVE BEEN INCORPORATED INTO THE RECORD DRAWINGS.

STAMP
[ENGINEERS]

(PROJECT NAME)
GENERAL
INDEX, NOTES, AND SIGNATURE BLOCK
DESCHUTES COUNTY, OREGON

[COMPANY NAME]
[COMPANY ADDRESS
AND PHONE NUMBER]

DESIGNED BY: _____
DRAWN BY: _____
SCALE: _____
FILE: _____
DATE: _____

VERIFY SCALES
0 1"
BAR EQUALS ONE INCH
ON ORIGINAL DRAWING

SHEET:
G-001

COB # (XXXXXX)

1	2	3	4	5	6
ABBREVIATIONS			INSTRUMENTATION EQUIPMENT ABBREVIATIONS LIST		
@ AT A/B AERATION BASIN AB ANCHOR BOLT ABND ABANDONED ACBD ACOUSTICAL BOARD ACST ACOUSTICAL TILE AD AREA DRAIN ADDL ADDITIONAL ADJ ADJACENT AFF ABOVE FINISH FLOOR AHR ANCHOR AL ALUMINUM ALTN ALTERNATE APPROX APPROXIMATE APVD APPROVED ARCH. ARCHITECTURAL ASSY ASSEMBLY AVG AVERAGE BD BOARD BETW BETWEEN BF BOTTOM FACE BLDG BUILDING BM BEAM BOD BOTTOM OF DUCT BOT BOTTOM BRG BEARING BST BOTTOM OF STEEL CAB. CABINET CCP CONCRETE CYLINDER PIPE C/C CHLORINE CONTACT CEM PLAS CEMENT PLASTER CHEM CHEMICAL CHKD PL CHECKERED PLATE CFM CUBIC FEET PER MINUTE CI CAST IRON CIP CAST IN PLACE CJ CONSTRUCTION JOINT Q/OR CL CENTER LINE CL 2 CHLORINE CLG CEILING CLR CLEAR CMP CORRUGATED METAL PIPE CMU CONCRETE MASONARY UNITS COB CITY OF BEND COL COLUMN CONC CONCRETE CONN CONNECTION CONST CONSTRUCTION CONT CONTINUOUS COR CORNER CPLG COUPLING CPVC CHLORINATED POLYVINYL CHLORIDE C TO C CENTER TO CENTER CTR CENTER CTRD CENTERED CU FT CUBIC FEET ∩ CENTRAL ANGLE DAFD DISSOLVED AERATION FLOTATION THICKENING DBA DEFORMED BAR ANCHOR DBL DOUBLE DET DETAIL DIA DIAMETER DIAG DIAGONAL DIM DIMENSION DIP. DUCTILE IRON PIPE DIR DIRECTION DISCH DISCHARGE DN DOWN DS DOWN SPOUT DWG DRAWING DWL DOWEL E EAST EA EACH ECC ECCENTRIC EF EACH FACE EFL EFFLUENT EL ELEVATION ELB ELBOW ELEC ELECTRICAL EP EDGE OF PAVEMENT EQL EQUAL EQL SP EQUALLY SPACED EQPT EQUIPMENT EW EACH WAY EXP JT EXPANSION JOINT EXT EXTERIOR, EXTERNAL, EXTENSION EXST EXISTING	FA FIRST AID KIT FAB FABRICATION FFE FINISHED FLOOR ELEVATION FACIL FACILITY FCA FLANGED COUPLING ADAPTER FCTY FACTORY FD FLOOR DRAIN FDN FOUNDATION FEXT FIRE EXTINGUISHER FFL FINISHED FLOOR FLL FLOW LINE ELEVATION FLEX FLEXIBLE FLG FLANGE FL FLOOR FNSH FINISH FOT FLAT ON TOP GA GAUGE, GAGE GB GRAB BAR GAL GALLON GALV GALVANIZED GALVS GALVANIZED STEEL GPD GALLONS PER DAY GRD GROUND GRTG GRATING GVL GRAVEL GWB GYPSUM WALLBOARD GYP PLAS GYPSUM PLASTER H.A.S HEADED ANCHOR STUD HD HUB DRAIN HDNR HARDNER HDR HEADER HGT HEIGHT HM HOLLOW METAL HORIZ HORIZONTAL HPT HIGH POINT HR HANDRAIL HR HOUR HS HIGH STRENGTH I&C INSTRUMENTATION AND CONTROL ID INSIDE DIAMETER IE INVERT ELEVATION I.F. INSIDE FACE INFL INFLUENT INSTL INSTALL INSUL INSULATION INTR INTERIOR INVT INVERT ITG INSULATED TEMPERED GLASS JT JOINT L LENGTH OF CURVE LB POUNDS LB/D POUNDS PER DAY LG LONG LLV LONG LEG VERTICAL LNTL LINTEL LONG. LONGITUDINAL LPT LOW POINT LT LIGHT MATL MATERIAL MAX MAXIMUM MB MACHINE BOLT MCC MOTOR CONTROL CENTER MECH MECHANICAL MFR MANUFACTURER MGD MILLION GALLONS PER DAY MG/L MILLIGRAMS PER LITRE MH MANHOLE MIN MINIMUM MISC MISCELLANEOUS MLSS MIXED LIQUOR SUSPENDED SOLIDS MLVSS MIXED LIQUOR VOLATILE SUSPENDED SOLIDS MO MASONARY OPENING MON MONUMENT MTG MOUNTING MTL METAL MTR METERING N NORTH NIC NOT IN CONTRACT NO. NUMBER NOM NOMINAL NORM NORMAL NTS NOT TO SCALE	OC ON CENTER OD OUTSIDE DIAMETER, OVERFLOW DRAIN O.F. OUTSIDE FACE OFE OWNER-FURNISHED EQUIPMENT OVHD OVERHEAD O TO O OUT TO OUT OPNG OPENING OPP OPPOSITE PC POINT OF CURVATURE PCV PRESSURE CONTROL VALVE P/C PRIMARY CLARIFIERS PD PEAK DAY PHF PEAK HOUR FLOW PI POINT OF INTERSECTION P&ID PROCESS AND INSTRUMENTATION DIAGRAM PJF PREMOLDED JOINT FILLER PL PLATE PLAM PLASTIC LAMINATE PLYWD PLYWOOD POC POINT ON CURVE POT POINT ON TANGENT PR PAIR PRV PRESSURE REDUCING VALVE PS PUMP STATION PSF POUNDS PER SQUARE FOOT PSI POUNDS PER SQUARE INCH PT POINT OF TANGENCY PTD PAPER TOWEL DISPENSER PTD/R PAPER TOWEL DISPENSER/RECPACLE PTRD PRESSURE TREATED POINT OF VERTICAL CURVATURE PVC POLYVINYL CHLORIDE PVI POINT OF VERTICAL INTERSECTION PVMT PAVEMENT PVT POINT OF VERTICAL TANGENCY R R-VALUE (INSULATION) R OR RAD RADIUS RISER RC REINFORCED CONCRETE RCP REINFORCED CONCRETE PIPE RD ROOF DRAIN RDCR REDUCER REHAB REHABILITATE REINF REINFORCE, REINFORCED, REINFORCING REQD REQUIRED RESIL RESILIENT RM ROOM RO ROUGH OPENING RST REINFORCING STEEL S SOUTH S.A.T. SUSPENDED ACOUSTICAL TILE S/C SECONDARY CLARIFIERS SCBA SELF CONTAINED BREATHING APPARATUS SCHED SCHEDULE SD SOAP DISPENSER, STORM DRAIN SECT SECTION SG SAFETY GLASS SH SHEET SHTG SHEETING SIM SIMILAR SLV SHORT LEG VERTICAL S.O. SHUTOFF SPECD SPECIFIED SPECS SPECIFICATIONS SPG SPACING SQ SQUARE SST STAINLESS STEEL STA STATION STD STANDARD STIF STIFFENER STOR STORAGE STR STRAIGHT STRUCT STRUCTURAL, STRUCTURE STL STEEL SWD SIDE WATER DEPTH SYMM SYMMETRICAL T TINTED T TANGENT LENGTH T&B TOP AND BOTTOM TAS THREADED ANCHOR STUD TC TOP OF CONCRETE, TOP OF CURB TEMP TEMPERED, TEMPERATURE TF TOP FACE	TG TEMPERD GLASS THK THICK THRD THREADED T.O. TOP OF TOG TOP OF GROUT TPD TONS PER DAY TPI TURNOUT POINT OF INTERSECTION TRANSV TRANSVERSE TRD TREAD TSS TOTAL SUSPENDED SOLIDS TST TOP OF STEEL TTD TOILET TISSUE DISPENSER TW TOP OF WALL TYP TYPICAL UBC UNIFORM BUILDING CODE UH UNIT HEATER UON UNLESS OTHERWISE NOTED UNO UNLESS NOTED OTHERWISE UR URINAL V VENT, VOLT VAC VACUUM V.A.T. VINYL ASBESTOS TILE VC VERTICAL VERT VERTICAL VCP VITRIFIED CLAY PIPE VTR VENT THRU ROOF VWC VINYL WALL COVERING W WEST, WIDE FLANGE (BEAM) W WITH WAS WASTE ACTIVATED SLUDGE WC WATER CLOSET WD WOOD WG WIRE GLASS WH WATER HEATER WK WEEK WP WORKING POINT WR GWB WATER RESISTANT GYPSUM WALLBOARD WR WASTE RECEPTACLE WS WATER STOP, WATERSURFACE, WELDED STEEL WTR WATER WWM WELDED WIRE MESH XFMR TRANSFORMER YD YARD YR YEAR	ACV ANALYZER CONTROL VALVE AE ANALYZER ELEMENT AI ANALYZER INDICATOR AIC ANALYZER INDICATING CONTROLLER AIT ANALYZER INDICATING TRANSMITTER ANT ANTENNA AR ANALYZER RECORDER ARC ANALYZER RECORDING CONTROLLER ASH ANALYZER SWITCH HIGH ASH HIGH ANALYZER SWITCH HIGH HIGH ASL ANALYZER SWITCH LOW ASLL ANALYZER SWITCH LOW LOW ARIC ANALYTICAL RATIO INDICATING CONTROLLER AT ANALYZER TRANSMITTER CAB CABINET EXI VOLTS/MILLIVOLTS TO CURRENT TRANSDUCER EXP VOLTS TO PRESSURE TRANSDUCER FCV FLOW CONTROL VALVE FE FLOW ELEMENT FI FLOW INDICATOR FIC FLOW INDICATING CONTROLLER FIR FLOW INDICATING RECORDER FIT FLOW INDICATING TRANSMITTER FQ FLOW TOTALIZER/INTEGRATOR FOI FLOW TOTALIZER INDICATOR FQIT FLOW TOTALIZER INDICATING TRANSMITTER FR FLOW RECORDER FSH FLOW SWITCH HIGH FSHH FLOW SWITCH HIGH HIGH FSHL FLOW SWITCH HIGH LOW FSL FLOW SWITCH LOW FSSL FLOW SWITCH LOW LOW FT FLOW TRANSMITTER GWY GATEWAY HC HAND CONTROLLER HIC HAND INDICATING CONTROLLER HS HAND SWITCH HOA HAND-OFF-AUTO SWITCH ICI INFINET TO COMPUTER INTERFACE KY TIME RELAY L/R LOCAL/REMOTE SWITCH LC LEVEL CONTROLLER LCV LEVEL CONTROL VALVE LE LEVEL ELEMENT LG LEVEL GAUGE LI LEVEL INDICATOR LIC LEVEL INDICATING CONTROLLER LISH LEVEL INDICATING SWITCH HIGH LIT LEVEL INDICATING TRANSMITTER LR LEVEL RECORDER LRC LEVEL RATIO CONTROLLER LSH LEVEL SWITCH HIGH LSHH LEVEL SWITCH HIGH HIGH LSHL LEVEL SWITCH HIGH LOW LSL LEVEL SWITCH LOW LSLL LEVEL SWITCH LOW LOW LSM LEVEL SWITCH MIDDLE LT LEVEL TRANSMITTER MCD MOTORIZED CONTROL DAMPER MPA ANALOG MARSHALLING PANEL MPC MARSHALLING PANEL CONTROL MPD DIGITAL MARSHALLING PANEL MSL MOTION SWITCH NE MOISTURE PROBE NI MOISTURE INDICATOR NSH MOISTURE SWITCH HIGH OJB OPTICAL JUNCTION BOX	PCU PROCESS CONTROL UNIT PCV PRESSURE CONTROL VALVE PDI PRESSURE DIFFERENTIAL INDICATOR PDIC PRESSURE DIFF. INDICATING CONTROLLER PDIT PRESSURE DIFF. INDICATING TRANSMITTER PDS PRESSURE DIFFERENTIAL SWITCH PDSH PRESSURE DIFFERENTIAL SWITCH HIGH PDSL PRESSURE DIFFERENTIAL SWITCH LOW PDT PRESSURE DIFFERENTIAL TRANSMITTER PE PRESSURE ELEMENT PHE pH ELEMENT PHR pH RECORDER PI PRESSURE INDICATOR PIC PRESSURE INDICATING CONTROLLER PIT PRESSURE INDICATING TRANSMITTER PR PRESSURE RECORDER PRN PRINTER PSH PRESSURE SWITCH HIGH PSHH PRESSURE SWITCH HIGH HIGH PSHL PRESSURE SWITCH HIGH LOW PSL PRESSURE SWITCH LOW PSLL PRESSURE SWITCH LOW LOW PT PRESSURE TRANSMITTER PXI PRESSURE TO CURRENT TRANSDUCER PXP PRESSURE TO PRESSURE TRANSDUCER PY PRESSURE CONVERTER (SIGNAL BOOST) PZ PRESSURE POSITIONER (ADJUST FOR PRESSURE CONTROL VALVE) RIO REMOTE INPUT/OUTPUT PROCESSOR SAMP SAMPLER SE SPEED ELEMENT SI SPEED INDICATOR (TACHOMETER) ST SPEED TRANSMITTER SV SOLENOID VALVE SWR SWITCHER SY SPEED CONVERTER (TRANSDUCER) SZ SPEED ACTUATOR (ENGINE) TC TEMPERATURE CONTROLLER TCV TEMPERATURE CONTROL VALVE TE TEMPERATURE ELEMENT TI TEMPERATURE INDICATOR TIC TEMPERATURE INDICATING CONTROL TIS TEMPERATURE INDICATING SWITCH TIT TEMPERATURE INDICATING TRANSMITTER TQI TORQUE INDICATOR TQIC TORQUE INDICATING CONTROL TQIT TORQUE INDICATING TRANSMITTER TQR TORQUE RECORDER TQS TORQUE SWITCH TQSH TORQUE SWITCH HIGH TOT TORQUE TRANSMITTER TR TEMPERATURE RECORDER TSH TEMPERATURE SWITCH HIGH TSHH TEMPERATURE SWITCH HIGH HIGH TSL TEMPERATURE SWITCH LOW TSLL TEMPERATURE SWITCH LOW LOW TT TEMPERATURE TRANSMITTER TW THERMAL WELL TY TEMPERATURE SELECT UI MULTIVARIABLE INDICATOR UR MULTIVARIABLE RECORDER USH MULTIVARIABLE SWITCH HIGH VDT VIDEO DISPLAY WI WEIGHT INDICATOR WIT WEIGHT INDICATING TRANSMITTER XV REMOTELY CONTROLLED ON-OFF VALVE ZI POSITION INDICATOR ZIS POSITION INDICATING SWITCH ZIT POSITION INDICATING TRANSMITTER ZS POSITION SWITCH ZSC POSITION SWITCH CLOSED ZSO POSITION SWITCH OPEN ZT POSITION TRANSMITTER

STAMP
[ENGINEERS]

(PROJECT NAME)
GENERAL

GENERAL LEGEND AND PIPING SYMBOLS
DESCHUTES COUNTY, OREGON



ENGINEERING

DESIGNED BY: _____
 DRAWN BY: _____
 SCALE: _____
 FILE: _____
 DATE: _____


[COMPANY NAME]
[COMPANY ADDRESS AND PHONE NUMBER]

VERIFY SCALES
0 1"
BAR EQUALS ONE INCH ON ORIGINAL DRAWING

SHEET: **G-002**

RECORD DRAWINGS
 REVISIONS DRAWN BY: XX DATE: XX/XX/XX
 THESE RECORD DRAWINGS HAVE BEEN PREPARED, IN PART, ON THE BASIS OF INFORMATION COMPILED BY OTHERS. THEY ARE NOT INTENDED TO REPRESENT IN DETAIL THE EXACT LOCATION, TYPE OF COMPONENT NOR MANNER OF CONSTRUCTION. THE ENGINEER WILL NOT BE RESPONSIBLE FOR ANY ERRORS OR OMISSIONS WHICH HAVE BEEN INCORPORATED INTO THE RECORD DRAWINGS.

COB # (XXXXXX)

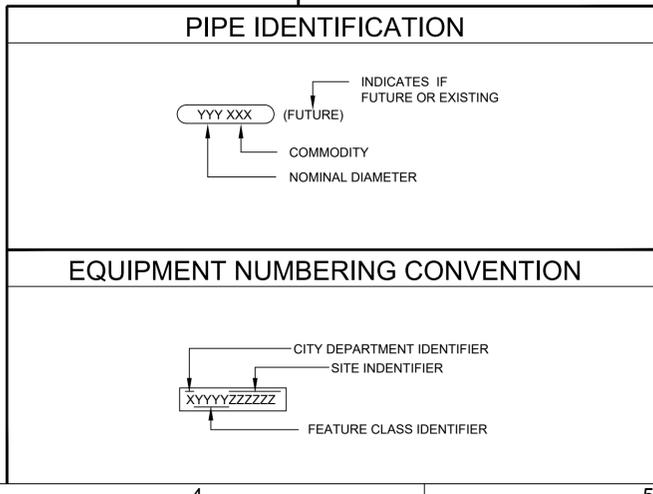

GENERAL NOTES

- THIS DRAWING IS GENERAL IN NATURE, SOME ABBREVIATIONS SHOWN HERE MAY NOT BE USED.
- SEE DRAWING G-04 FOR PROCESS EQUIPMENT LEGEND AND PIPING SYMBOLS.
- SEE DRAWING G-05 FOR INSTRUMENTATION SYMBOLS.
- SEE DRAWING G-06 AND G-07 FOR ELECTRICAL SYMBOLS.
- SEE DRAWING G-08 FOR STRUCTURAL NOTES.
- ADDITIONAL ABBREVIATIONS FOR INSTRUMENTATION EQUIPMENT CAN BE FOUND USING THE FUNCTIONAL IDENTIFICATION MATRIX ON DRAWING G-05.

FUNCTIONAL IDENTIFICATION				
FIRST LETTER		SUCCEEDING-LETTERS		
MEASURED OR INITIATING VARIABLE	MODIFIER	READOUT OR PASSIVE FUNCTION	OUTPUT FUNCTION	MODIFIER
A	ANALYSIS	ALARM		
B	BURNER, COMBUSTION		CLOSE-STOP DECREASE	
C	CONDUCTIVITY, pH (ACIDITY)	CLOSE	CONTROL OR CONTROLLER	
D	DENSITY	DIFFERENTIAL	OPEN-START-INCREASE	
E	VOLTAGE	SENSOR (PRIMARY ELEMENT)		
F	FLOW RATE	RATIO (FRACTION)		FAIL
G	GAS		GLASS VIEWING DEVICE	
H	HAND			H-HIGH-(ALARM) HH-HIGH-(SHUTDOWN)
I	CURRENT (ELECTRICAL)	INDICATE		
J	POWER	SCAN		
K	TIME, TIME SCHEDULE	TIME RATE OF CHANGE		CONTROL STATION
L	LEVEL		LIGHT	L-LOW-(ALARM) LL-LOW-(SHUTDOWN)
M	MOISTURE	MOMENTARY	ON OR OPERATE	MIDDLE, INTERMEDIATE
N			SET POINT	
O	UNCLASSIFIED		OPEN ORIFICE, RESTRICTION POINT (TEST) CONNECTION	OVERLOAD
P	PRESSURE, VACUUM			PNEUMATIC
Q	QUANTITY	INTEGRATE, TOTALIZE		INTEGRATE OR TOTALIZE
R	RADIATION		RECORD	
S	SPEED, FREQUENCY, SOLENOID	SAFETY		SWITCH, OR SAFETY
T	TEMPERATURE			TRANSMIT
U	MULTIVARIABLE		MULTIFUNCTION	MULTIFUNCTION
V	VIBRATION, MECHANICAL ANALYSIS		VALVE, DAMPER, LOUVRE	MULTIFUNCTION
W	WEIGHT, FORCE		WELL	
X	ON/OFF	X AXIS	UNCLASSIFIED	UNCLASSIFIED
Y	EVENT, STATE, PRESENCE	Y AXIS	UNCLASSIFIED	UNCLASSIFIED
Z	POSITION, DIMENSION	Z AXIS	DRIVER, ACTUATOR, UNCLASSIFIED - FINAL CONTROL ELEMENT	UNCLASSIFIED

INSTRUMENT AND FUNCTION SYMBOLS	
	FIELD MOUNTED INSTRUMENT
	LOCAL PANEL - MOUNTED INSTRUMENT. ACCESSIBLE
	INSTRUMENT MOUNTED BEHIND LOCAL CONTROL PANEL. NOT READILY ACCESSIBLE
	INSTRUMENT MOUNTED ON MAIN PANEL. ACCESSIBLE
	INSTRUMENT MOUNTED BEHIND MAIN PANEL. NOT READILY ACCESSIBLE
	FIELD MOUNT ANNUNCIATOR POINT
	MAIN PANEL MOUNT ANNUNCIATOR POINT
	LOCAL PANEL MOUNT ANNUNCIATOR POINT
	SPECIAL PURPOSE DIGITAL DEVICE FOR PROCESSING MAINLY ANALOG INFORMATION. EG. SLDC (SINGLE LOOP DIGITAL CONTROLLER)
	ANALOG INPUT
	ANALOG OUTPUT
	DISCRETE INPUT
	DISCRETE OUTPUT
	GENERALIZED FOR COMPLEX INTERLOCK LOGIC PERFORMED IN SOFTWARE. SEE SPECIFICATIONS FOR DETAILS.
	SPECIAL PURPOSE DIGITAL DEVICE FOR PROCESSING MAINLY ANALOG INFORMATION. ACCESSIBLE
	CONTROL SYSTEM DIGITAL INPUT/OUTPUT
	COMPUTER - INTERNAL SYSTEM FUNCTION (I.E. COMPUTATION/SIGNAL CONDITIONING)
	COMPUTER - INTERNAL SYSTEM FUNCTION NORMALLY ACCESSIBLE TO OPERATOR
	EQUIPMENT TAG
	PROPOSED NEW INSTRUMENT
	PROPOSED REMOVAL

PRIMARY ELEMENT SYMBOLS	
	ORIFICE PLATE
	VENTURI OR FLOW TUBE
	FLUME
	WEIR
	VARIABLE AREA FLOW INDICATOR (ROTAMETER)
	FLOW ELEMENT INTEGRAL WITH TRANSMITTER (MASS FLOW, ETC)
	DIAPHRAGM SEAL
	IN-LINE PRESSURE SENSOR
	VORTEX FLOW SENSOR
	IN-LINE CAPACITANCE FLOW ELEMENT
	MAGNETIC FLOWMETER
	SONIC FLOWMETER (DOPPLER OR TRANSIT TIME)
	POSITIVE DISPLACEMENT METER
	THERMAL MASS FLOW ELEMENT
	ANNUBAR
	PITOT TUBE
	PROPELLER OR TURBINE METER
	CORIOLIS MASS FLOWMETER
	TILT FLOAT SWITCH
	FLOAT SWITCH
	DISPLACEMENT LEVEL ELEMENT
	ULTRASONIC/MICROWAVE LEVEL ELEMENT
	RADIO FREQUENCY LEVEL ELEMENT
	SUBMERSIBLE LIQUID LEVEL ELEMENT
	THERMAL SENSING RTD STRIP

TYPICAL INSTRUMENT IDENTIFICATION	
<p>FIELD TAG IDENTIFICATION</p> <p>EXAMPLE: WRF-001-PDSHH-001-1010-A1</p> <p>CITY DEPARTMENT IDENTIFIER (3 CHARACTERS)</p> <p>FACILITY IDENTIFIER (UP TO 4 CHARACTERS)</p> <p>WATER RECLAMATION PLANT SPECIFIC (4 CHARACTERS)</p> <p>LOOP NUMBER (4 NUMERALS)</p> <p>SUFFIX (UP TO 2 CHARACTERS)</p>	<p>SCHEMATIC IDENTIFICATION</p> <p>PROCESS FUNCTION CODE *</p> <p>FUNCTIONAL IDENTIFICATION CODE</p> <p>OPERATING FUNCTION *</p> <p>BASIC INSTRUMENT</p> <p>PANEL LOCATION *</p> <p>PROCESS IDENTIFIER</p> <p>* OPTIONAL</p>
<p>1. C - COLLECTIONS OPERATIONS</p> <p>2. W - WATER OPERATIONS</p> <p>3. D - DRAINAGE OPERATIONS</p> <p>4. WRF - WATER RECLAMATION PLANT</p>	<p>1. XXXX - COLLECTION PUMP STATIONS</p> <p>2. XXXX - WATER RESERVOIR</p> <p>3. XXXX - STORM SEWER STATIONS</p> <p>4. XXXX - PRESSURE (XXX)</p>
<p>SEE DWG WPRV015-G002 FOR DETAILS</p>	<p>USED ONLY WHEN 2 OR MORE INSTRUMENTS ARE IN THE LOOP</p>

INSTRUMENT OPERATING FUNCTIONS	
ANALYTICAL FUNCTIONS	
RES C ₂	RESIDUAL CHLORINE
SO ₂	SULFUR DIOXIDE
COMB	COMBUSTIBLE GAS
H ₂ S	HYDROGEN SULFIDE
pH	pH
DO	DISSOLVED OXYGEN
O ₂	OXYGEN
VIB	VIBRATION
CO	CONDUCTIVITY
SWITCHING FUNCTIONS	
3W	THREE-WAY SWITCH
EH	EMERGENCY HIGH (24VDC BACKED)
MS	MOTOR-RATED SWITCH
HA	HAND-AUTO SELECTION
HOA	HAND-OFF-AUTO SELECTION
JOA	JOG-OFF-AUTO SELECTION
S/S	START-STOP
L/L	LEAD-LAG SELECTION
LLCO	LOW LEVEL CUT OFF
F/S	FAST-SLOW SELECTION
OCA	OPEN-CLOSE-AUTO SELECTION
OSC	OPEN-STOP-CLOSE SELECTION
SEL	SELECTOR SWITCH
O/O	ON-OFF SELECTION
M/A	MANUAL-AUTO SELECTION
L/R	LOCAL-REMOTE SELECTION
ESD	EMERGENCY SHUTDOWN
ACK	ACKNOWLEDGE (ALARM)
D/P	DIFFERENTIAL PRESSURE
I/P	CURRENT TO PRESSURE
IBD	INBOARD BEARING
OBD	OUTBOARD BEARING
RSP	REMOTE SET POINT
RST	RESET

INSTRUMENT SIGNAL SYMBOLS	
	INSTRUMENT SUPPLY, PROCESS TAPS
	PNEUMATIC SIGNAL
	ELECTRIC SIGNAL DISCRETE, 120VAC
	ELECTRIC SIGNAL DISCRETE, 24VDC
	ELECTRIC SIGNAL ANALOG
	CAPILLARY TUBE OR FILLED SYSTEM
	ELECTROMAGNETIC OR SONIC SIGNAL (GUIDED)
	ELECTROMAGNETIC OR SONIC SIGNAL (UNGUIDED)
	SOFTWARE AND DATA LINK IN CONTROL SYSTEM
	MECHANICAL LINK
	HYDRAULIC

MISCELLANEOUS SYMBOLS	
	INTERLOCK - SEE CONTROL STRATEGY DESCRIPTION
	RESET FOR LATCH-TYPE OPERATOR
	ANNUNCIATOR HORN
	GROUND
	INSTRUMENT LOOP SHIELD GROUND
	BOND

LINE DESIGNATIONS	
	ELECTRIC POWER SUPPLY 120 VAC 60 HZ (UNLESS OTHERWISE NOTED)
	SERVICE AIR SUPPLY
	INSTRUMENT QUALITY AIR SUPPLY
	WATER SUPPLY C1, C2, C3, ETC.

GENERAL NOTES	
<p>1. THIS DRAWING IS GENERAL IN NATURE. SOME SYMBOLS SHOWN HERE MAY NOT BE USED.</p> <p>2. REFER TO DRAWING G-002 AND G-003 FOR EQUIPMENT AND PIPE COMMODITY DESIGNATIONS.</p> <p>3. TAG NAMING CONVENTION IS NOT FINALIZED IN THIS REVISION.</p>	

FOR SAMPLE ONLY	
DESIGNED BY:	DATE: XX/XX/XX
DRAWN BY:	SCALE: 1" = 1"
FILE:	
REVISIONS DRAWN BY:	DATE: XX/XX/XX
THESE RECORD DRAWINGS HAVE BEEN PREPARED, IN PART, ON THE BASIS OF INFORMATION COMPILED BY OTHERS. THEY ARE NOT INTENDED TO REPRESENT IN DETAIL THE EXACT LOCATION, TYPE OF COMPONENT NOR MANNER OF CONSTRUCTION. THE ENGINEER WILL NOT BE RESPONSIBLE FOR ANY ERRORS OR OMISSIONS WHICH HAVE BEEN INCORPORATED INTO THE RECORD DRAWINGS.	

[PROJECT NAME]
GENERAL

ENGINEERING INSTRUMENTATION LEGEND AND SYMBOLS
DESCHUTES COUNTY, OREGON

[COMPANY NAME]
[COMPANY ADDRESS AND PHONE NUMBER]

DESIGNED BY: _____ DATE: XX/XX/XX
DRAWN BY: _____ SCALE: 1" = 1"
FILE: _____
REVISIONS DRAWN BY: _____ DATE: XX/XX/XX

REVISIONS:

0	1"
---	----


BAR EQUALS ONE INCH ON ORIGINAL DRAWING

SHEET: **G-004**


COB # (XXXXXX)

WASTEWATER PUMP STATION AND FORCE MAIN DESIGN DATA SUMMARY TABLE 1

BASIN CHARACTERISTICS	
LOCAITON	ADDRESS AND CROSS STREET
BASIN AREA	XXX ACRES
EQUIVALENT DWELLING UNITS (EDU) PER ACRE	X.X
PERSON PER EDU	X.X
POPULATION EQUIVALENT	XXXX
AVERAGE PER CAPITA FLOW	XX GPD
INFILTRATION AND INFLOW, PEAK WET WEATHER FLOW (PWWF)	XXX,XXX GPD
AVERAGE DAILY FLOW	XXX,XXX GPD
PEAK HOURLY FLOW	XXX GPM
PUMP STATION	
TYPE	DUPLEX SUBMERSIBLE, NON-CLOG, VARIABLE SPEED PUMPS
CAPACITY (PER PUMP)	XXX GPM @ XX FEET TDH (STATIC HEAD = XX FT)
HORSEPOWER, HP	XX HP EACH WITH VARIABLE FREQUENCY DRIVES
MOTOR DATA	XXV VOLT X PHASE XX CYCLE
FIRM CAPACITY OF PUMP STATION	X.XX MGD (XXX GPM)
MAXIMUM PUMP STARTS PER HOUR	X - SEE NOTE 4
WET WELL VOLUME	XXXX GALLONS (PUMPS OFF TO LEAD PUMP)
LEVEL CONTROL TYPE	PRESSURE SENSORS LEVEL CONTROL
OVERFLOW POINT	MANHOLE NUMBER AND ELEVATION
OVERFLOW LOCATION	DESCRIPTION
AVERAGE TIME TO OVERFLOW	TIME AND DESCRIPTION, XX HOURS AT XX GPM DESIGN AVERAGE INFLUENT FLOW - SEE NOTE 1
TELEMETRY	BY CITY
TRANSFER SWITCH	AUTOMATIC
STANDBY POWER TYPE	XXX KW STATIONARY DIESEL POWERED STANDBY GENERATOR
FUEL TANK CAPACITY	XX HRS/DAYS (XXX GALLONS)
EPA RELIABILITY CLASS	1
FLOW METER	"X" MAGNETIC (DESCRIPTION)
CONTROL	CONSTANT SPEED OR VFD - PER CITY APPROVAL
FORCE MAIN	
TYPE AND LENGTH	XXXX FEET, TYPE
FORCEMAIN VELOCITY	X.X FEET PER SECOND
PROFILE	DESCRIPTION
AIR RELEASE VALVE	QUANTITY, DESCRIPTION
DISCHARGE LOCATION	MANHOLE NUMBER AND ELEVATION
AVERAGE DETENTION TIME	XX HOURS
ODOR CONTROL SYSTEM	DESCRIPTION
OPERATING LEVELS	
GROUND ELEVATION	XXXX.XX
OVERFLOW ALARM ELEVATION	FLOAT CONTROL SYSTEM? (BACKUP)
LAG PUMP ON/HIGH WATER ALARM ELEVATION XXXX.XX	PRESSURE PROBE (PROVIDE DISTANCE FROM WET WELL FLOOR IN FEET) SAME AS LEVEL INDICATOR DIGITAL DISPLAY
LEAD PUMP ON ELEVATION XXXX.XX	PRESSURE PROBE (PROVIDE DISTANCE FROM WET WELL FLOOR IN FEET) SAME AS LEVEL INDICATOR DIGITAL DISPLAY
ALL PUMPS OFF ELEVATION XXXX.XX	PRESSURE PROBE (PROVIDE DISTANCE FROM WET WELL FLOOR IN FEET) SAME AS LEVEL INDICATOR DIGITAL DISPLAY
WETWELL FLOOR ELEVATION XXXX.XX	PRESSURE PROBE (0.00 FEET)
LANDSCAPING	
LANDSCAPING AREA	SQUARE FEET AND DESCRIPTION
IRRIGATION SYSTEM	TYPE
CONTROL VALVES	NUMBER AND TYPE
BACKFLOW DEVICE	SIZE AND TYPE

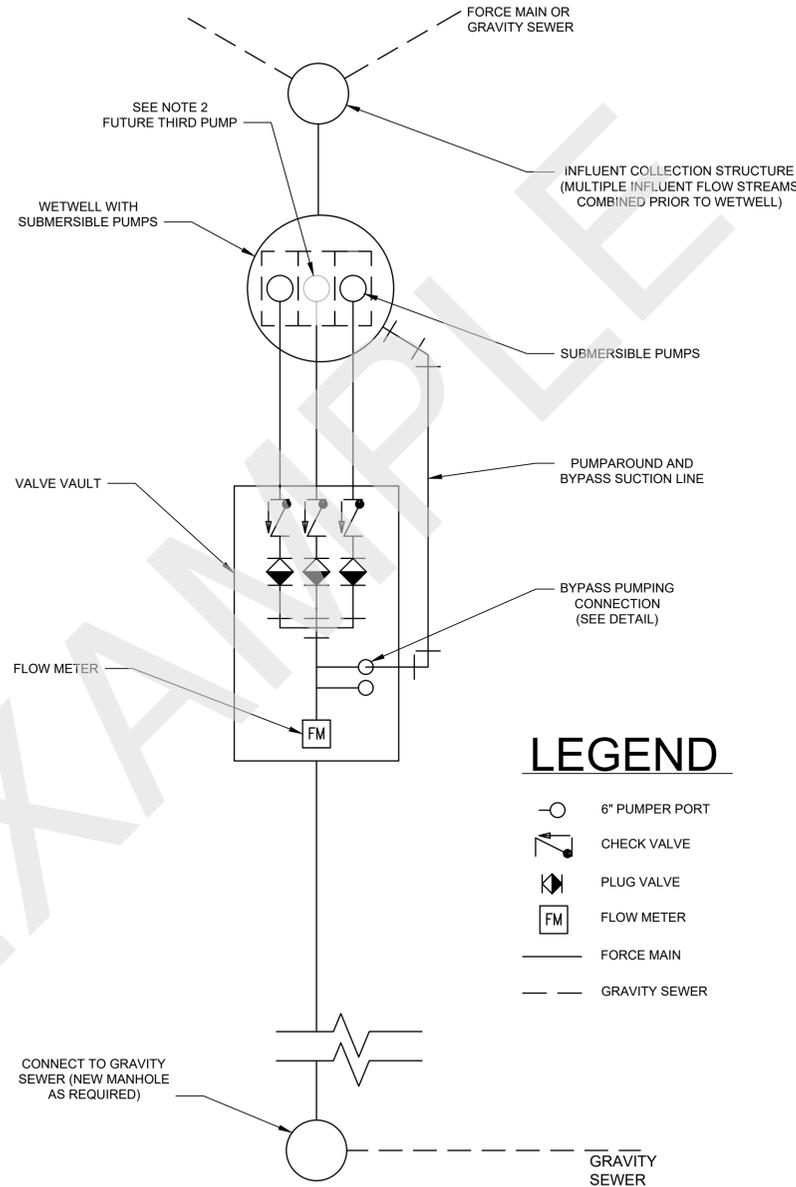

PUMP STATION SCHEMATIC

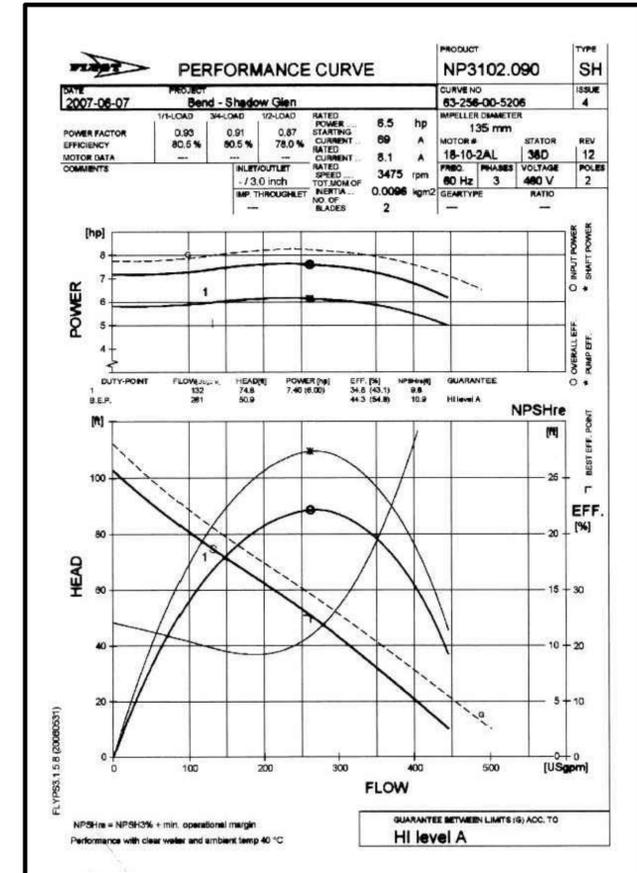

EXAMPLE PUMP PERFORMANCE CURVE

PUMP STATION SCHEMATIC

- DESIGN ENGINEER TO FILL IN DESIGN INFORMATION IN THE TABLE FOR APPROVAL BY CITY OF BEND. PUMP STATION WETWELL SHALL CONFORM TO ANSI/HYDRAULIC INSTITUTE STANDARD 9.8.
- RESERVED FOR FUTURE THIRD PUMP IN PUMP STATION.
- PUMP SELECTION DESIGN POINT SHALL CONFORM TO HYDRAULIC INSTITUTE STANDARDS 9.6.3
- PUMP STATION WETWELL STORAGE VOLUME PER HYDRAULIC INSTITUTE STANDARD 9.8 BASED ON THE MAXIMUM PUMP CYCLE TIME, LESS THAN EIGHT (8) STARTS PER HOUR.

FOR SAMPLE ONLY

RECORD DRAWINGS

DESIGNED BY: XX DATE: XX/XX/XX

THESE RECORD DRAWINGS HAVE BEEN PREPARED, IN PART, ON THE BASIS OF INFORMATION COMPILED BY OTHERS. THEY ARE NOT INTENDED TO REPRESENT IN DETAIL THE EXACT LOCATION, TYPE OF COMPONENT NOR MANNER OF CONSTRUCTION. THE ENGINEER WILL NOT BE RESPONSIBLE FOR ANY ERRORS OR OMISSIONS WHICH HAVE BEEN INCORPORATED INTO THE RECORD DRAWINGS.

STAMP
[ENGINEERS]

(PROJECT NAME)
GENERAL
BASIS OF DESIGN
DESCHUTES COUNTY, OREGON



[COMPANY NAME]
[COMPANY ADDRESS
AND PHONE NUMBER]

DESIGNED BY: _____
DRAWN BY: _____
SCALE: _____
FILE: _____
DATE: _____

VERIFY SCALES
0 1"
BAR EQUALS ONE INCH
ON ORIGINAL DRAWING

SHEET:
G-008

COB # (XXXXXX)

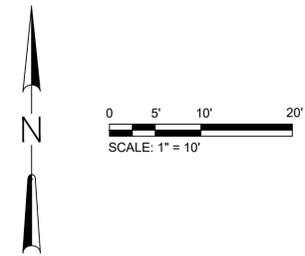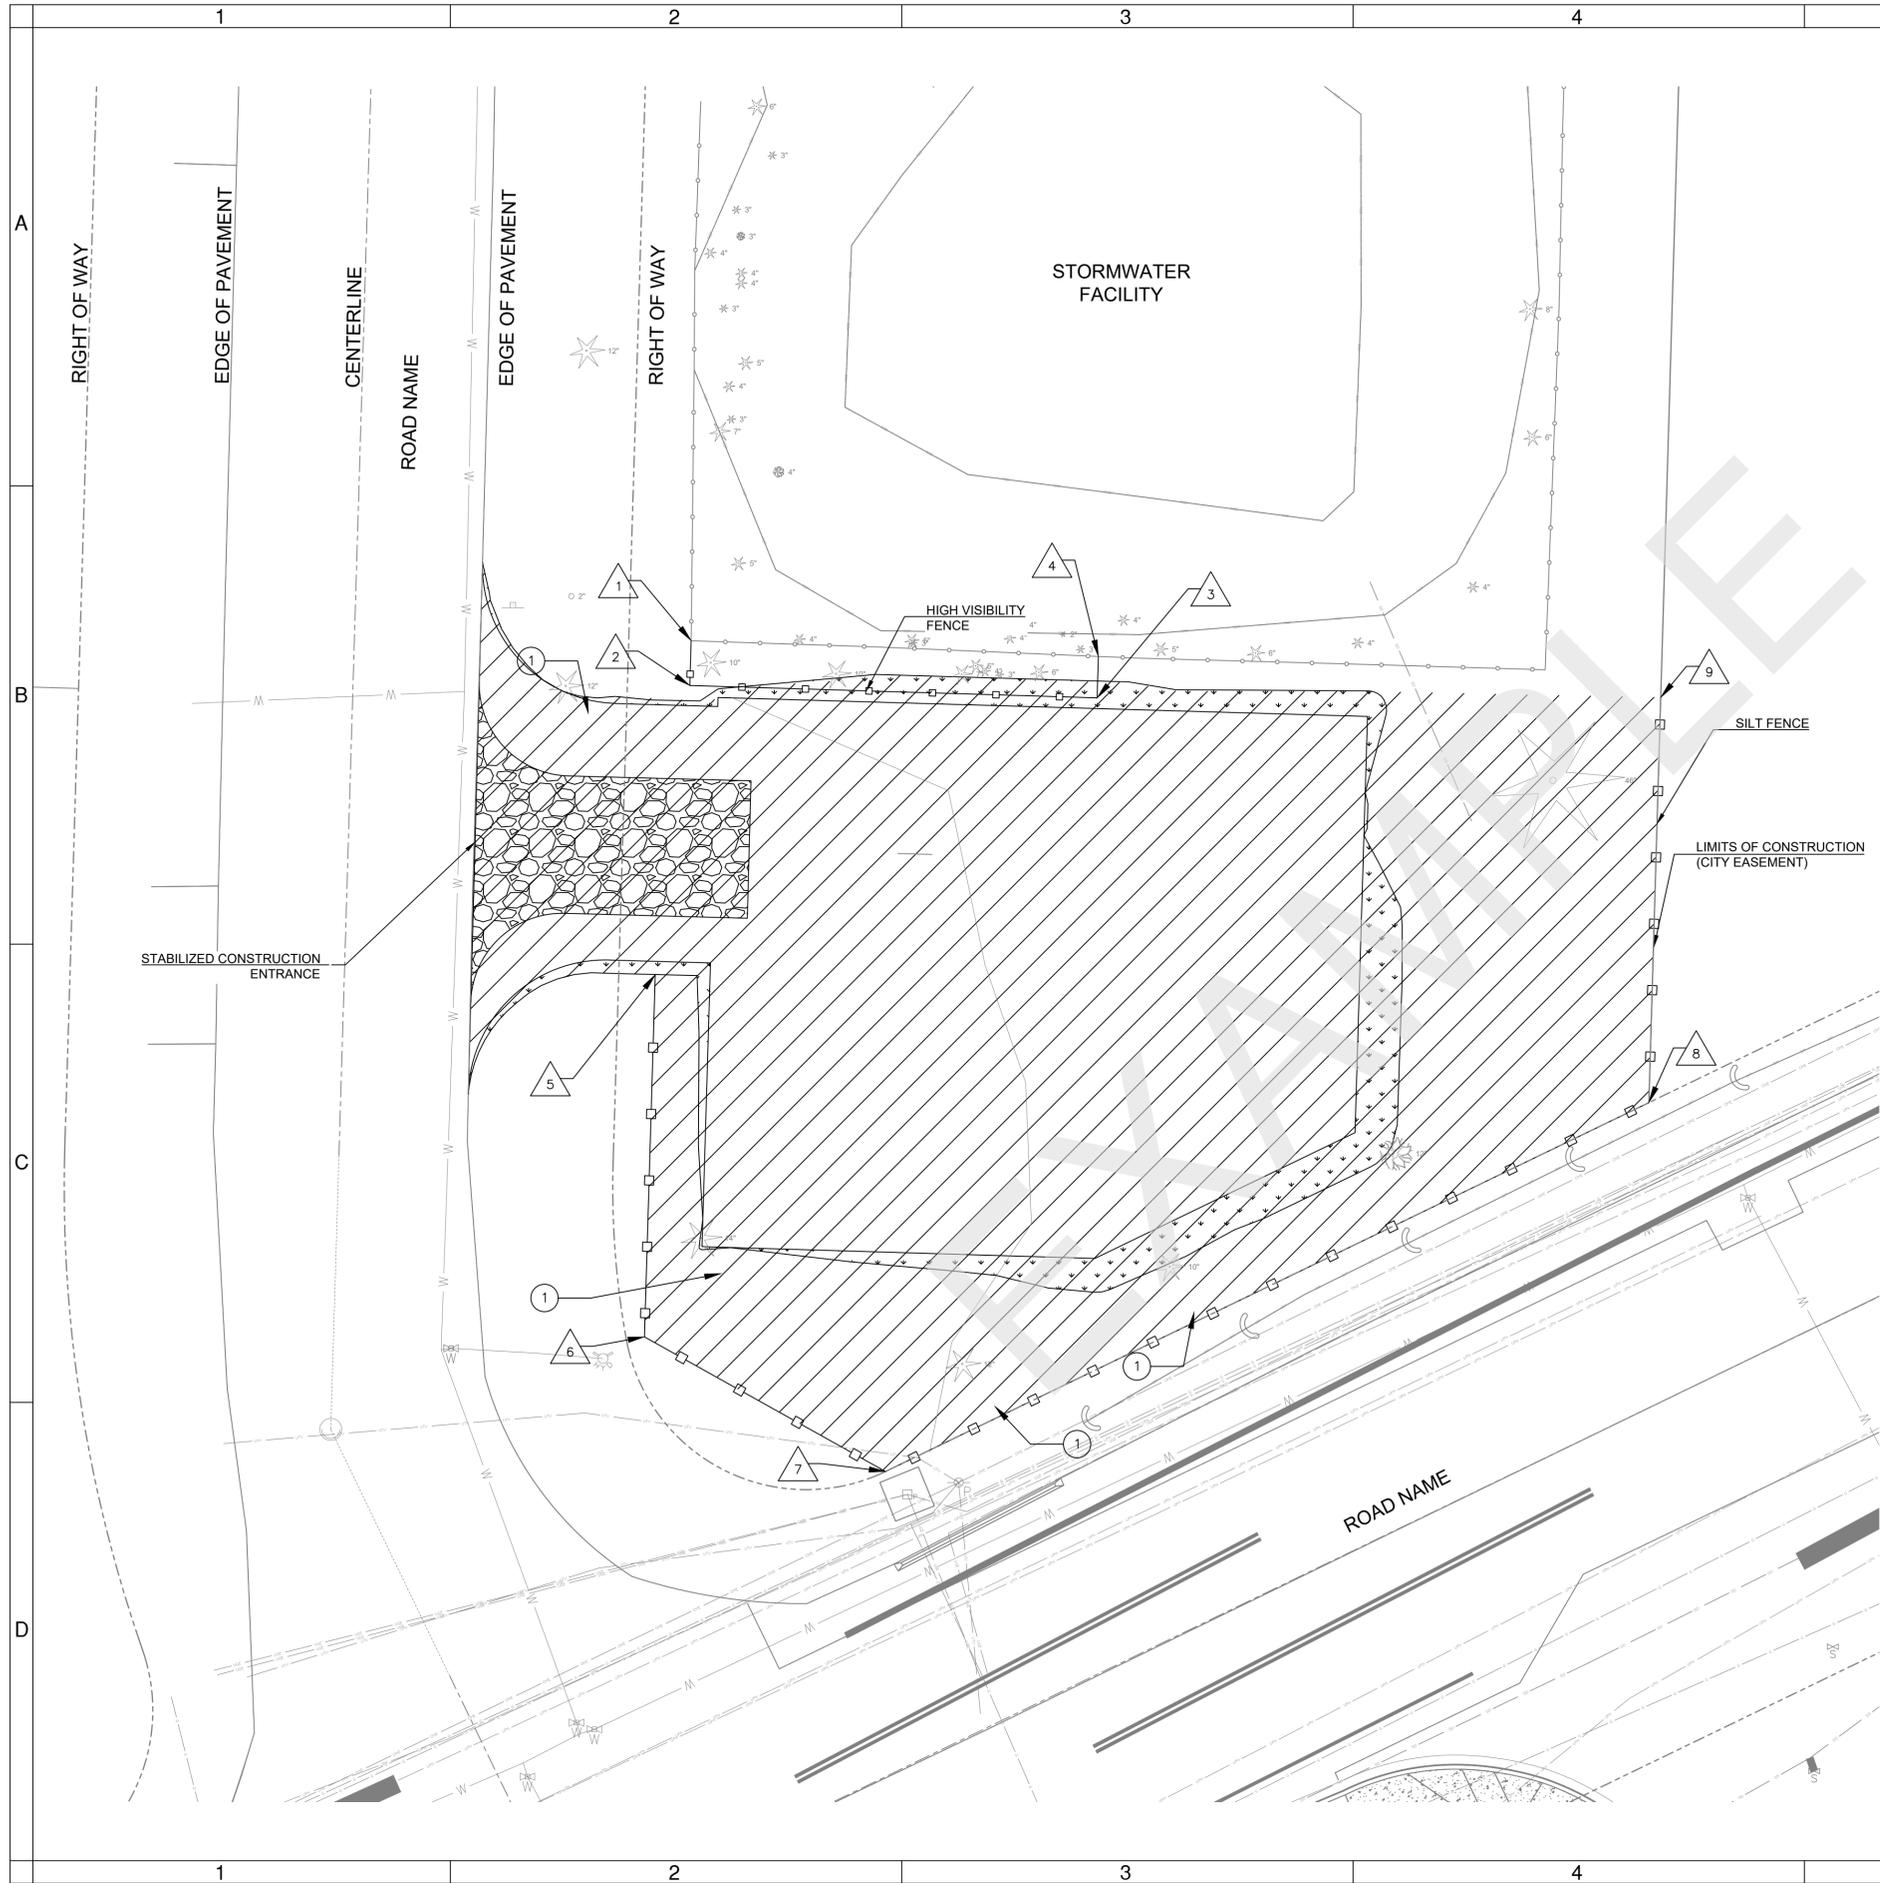

GENERAL NOTES:

- HIGH VISIBILITY FENCE SHALL BE INSTALLED AROUND THE DRIP LINES OF TREES TO BE RETAINED ON SITE. FENCING SHALL BE INSTALLED FOLLOWING THE FELLING OF TREES TO BE REMOVED, AND PRIOR TO ANY LARGE EQUIPMENT ENTERING THE PROPERTY.
- EROSION CONTROL MEASURES SHALL COMPLY WITH CURRENT CITY OF BEND STORM WATER DESIGN MANUAL.

KEY NOTES:

- ① REMOVE EXISTING TREE

POINT TABLE			
#	NORTHING	EASTING	DESCRIPTION
1	633925.41	79082.06	BEGIN HIGH VISIBILITY FENCE

EXAMPLE

FOR SAMPLE ONLY

RECORD DRAWINGS

REVISIONS DRAWN BY: XX DATE: XX/XX/XX

THESE RECORD DRAWINGS HAVE BEEN PREPARED, IN PART, ON THE BASIS OF INFORMATION COMPILED BY OTHERS. THEY ARE NOT INTENDED TO REPRESENT IN DETAIL THE EXACT LOCATION, TYPE OF COMPONENT NOR MANNER OF CONSTRUCTION. THE ENGINEER WILL NOT BE RESPONSIBLE FOR ANY ERRORS OR OMISSIONS WHICH HAVE BEEN INCORPORATED INTO THE RECORD DRAWINGS.

[STAMP]
[ENGINEERS]

(PROJECT NAME)
CIVIL

DEMOLITION & EROSION CONTROL PLAN
DESCHUTES COUNTY, OREGON



[COMPANY NAME]
[COMPANY ADDRESS
AND PHONE NUMBER]

DESIGNED BY: _____
DRAWN BY: _____
SCALE: _____
FILE: _____
DATE: _____

VERIFY SCALES
0 1"
BAR EQUALS ONE INCH
ON ORIGINAL DRAWING

SHEET:
C-001

COB # (XXXXXX)

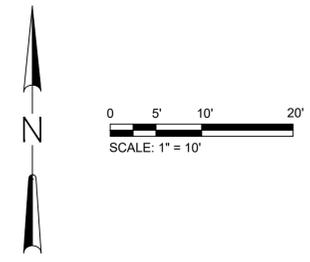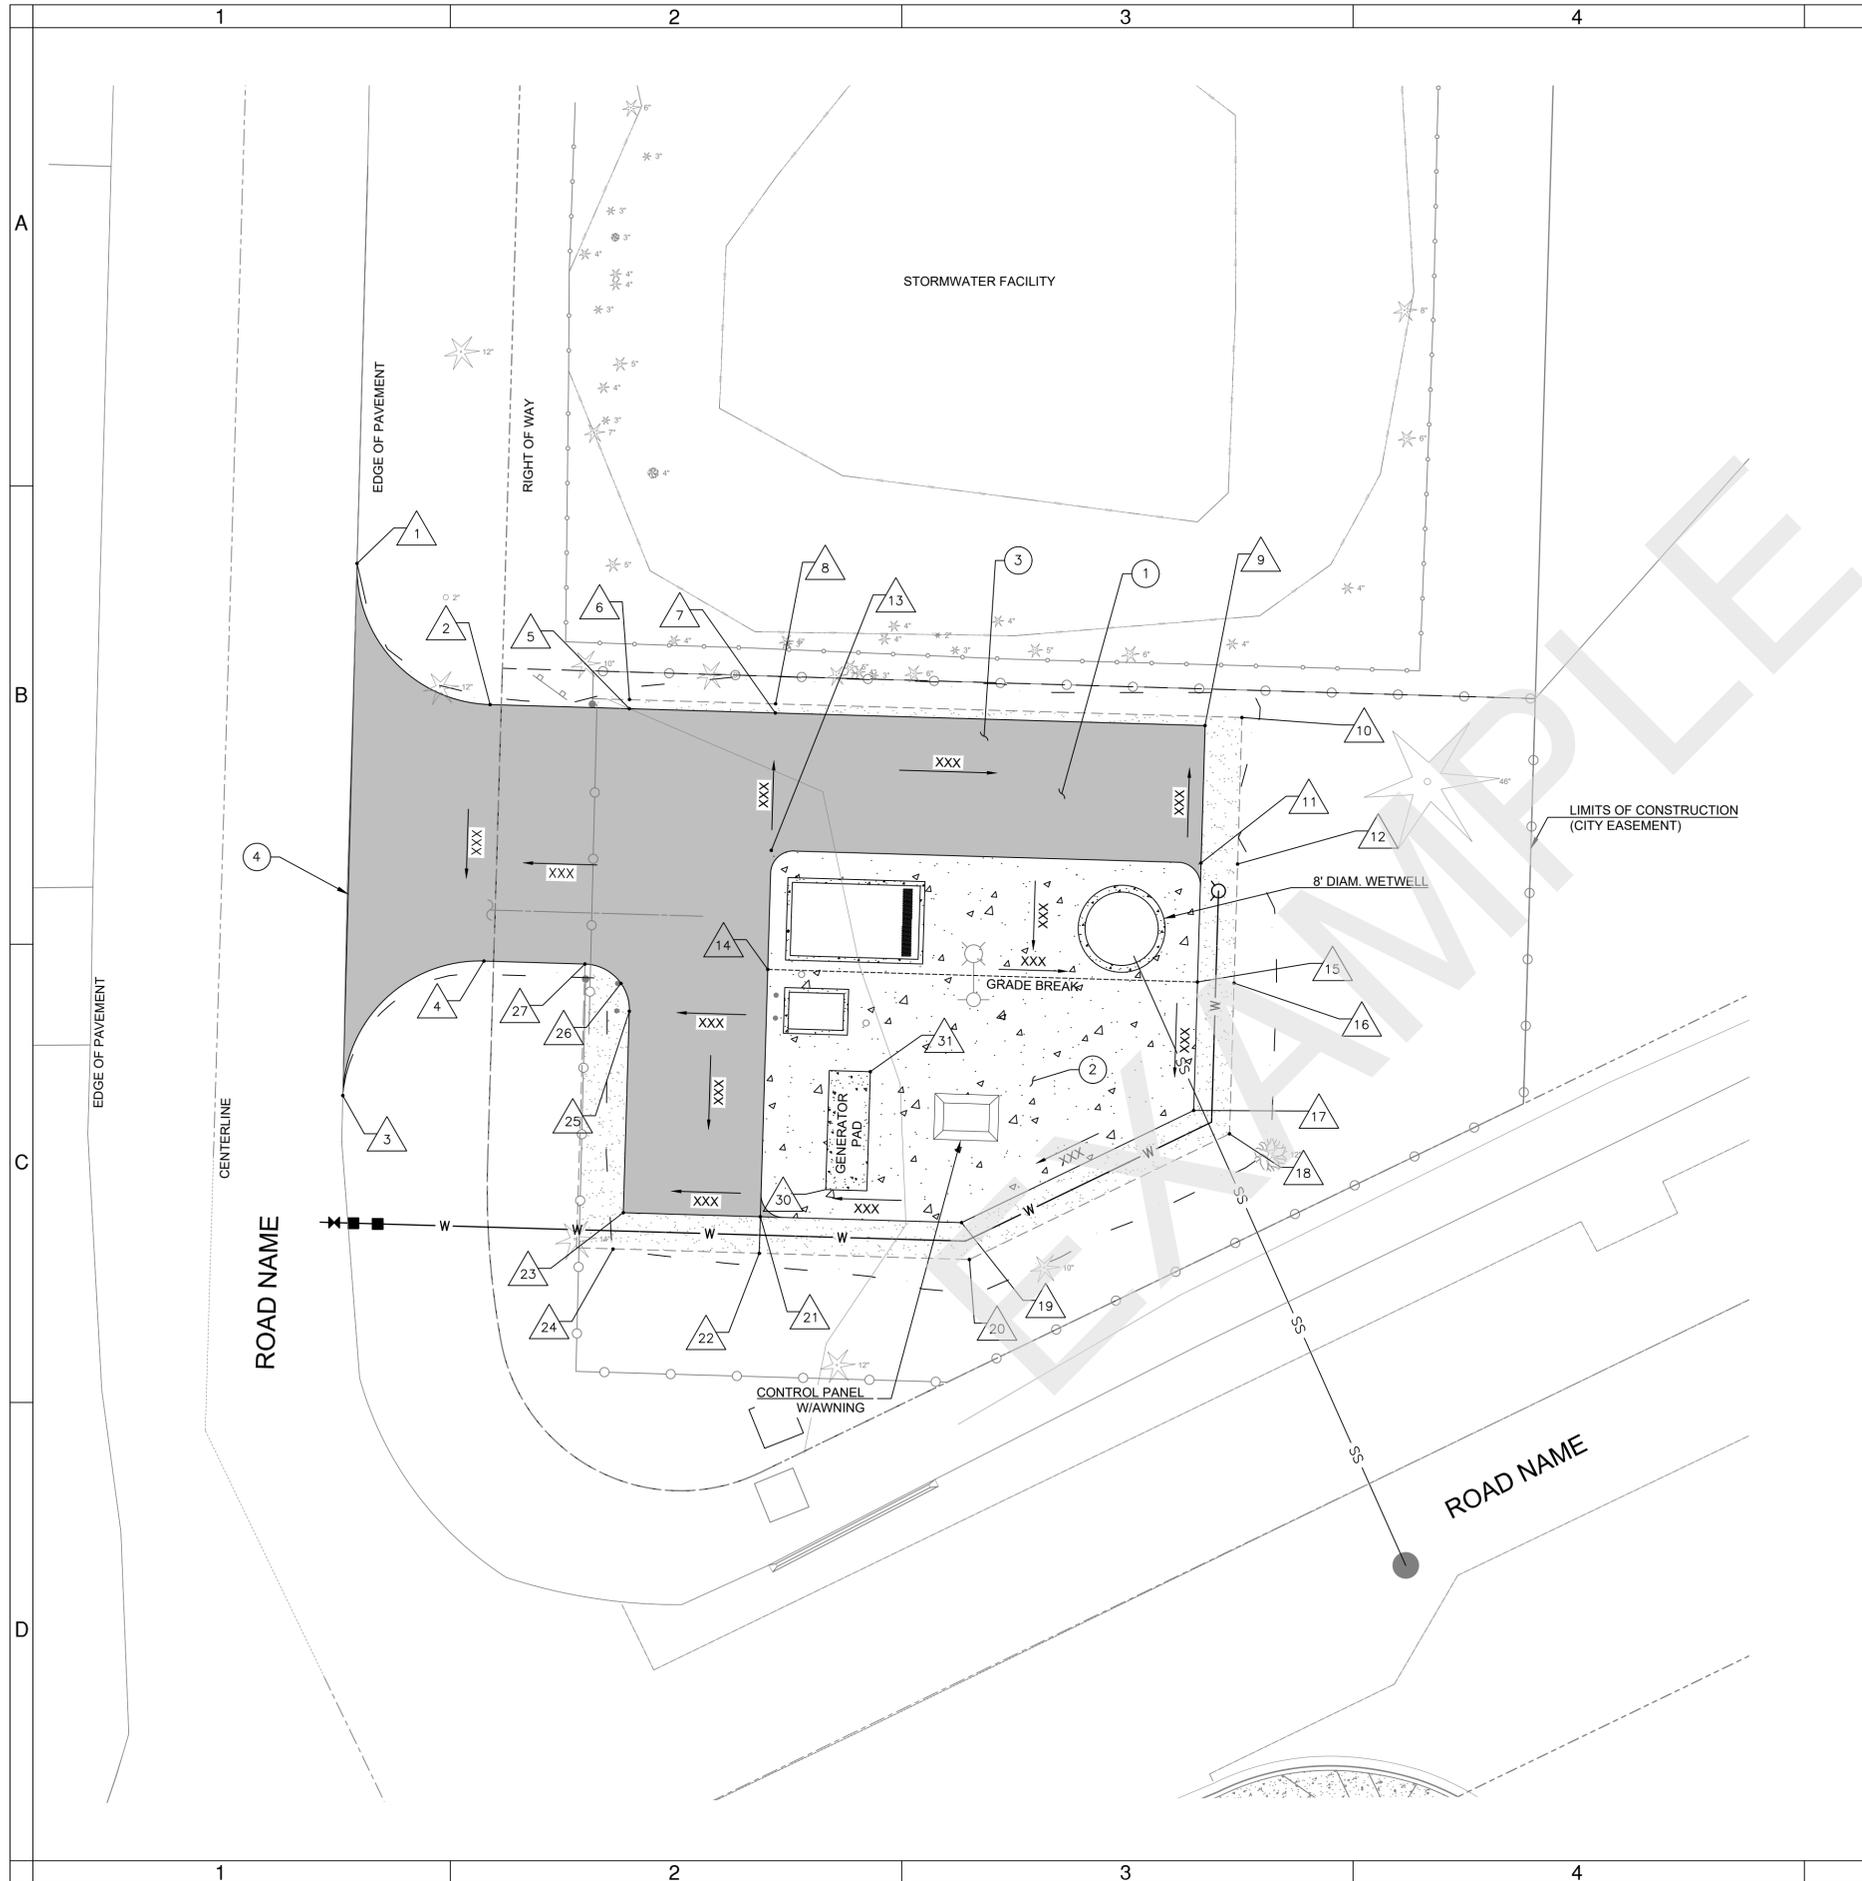

KEY NOTES:

- ① COMMERCIAL HMA
- ② REINFORCED CONCRETE PAD.
- ③ GRAVEL SURFACING SECTION.
- ④ SAWCUT EXISTING ASPHALT CONC. PAVEMENT. TACKCOAT PER ODOT STANDARD.

POINT TABLE			
#	NORTHING	EASTING	DESCRIPTION
1	633933.96	79059.23	BEGIN ASPHALT
2	633918.57	79073.79	PT, ASPHALT
3	633875.90	79057.68	END ASPHALT
4	633890.57	79073.11	PC, ASPHALT
5	633918.13	79089.01	BEGIN GRAVEL
6	633919.12	79089.04	AP, GRAVEL
7	633917.65	79104.99	GRADE BREAK, CONCRETE & GRAVEL
8	633918.65	79105.02	GRADE BREAK, GRAVEL
9	633916.28	79152.00	AP, CONCRETE & GRAVEL
10	633917.16	79156.04	AP, GRAVEL
11	633901.28	79151.56	AP, CONCRETE
12	633901.16	79155.56	GRADE BREAK, GRAVEL
13	633902.66	79104.55	AP, CONCRETE
14	633889.67	79104.16	GRADE BREAK, CONCRETE
15	633888.29	79151.18	GRADE BREAK, CONCRETE
16	633888.17	79155.17	GRADE BREAK, GRAVEL
17	633874.27	79150.75	AP, CONCRETE & GRAVEL
18	633871.73	79154.68	AP, GRAVEL
19	633862.03	79125.36	AP, CONCRETE & GRAVEL
20	633858.01	79126.22	AP, GRAVEL
21	633862.68	79103.35	AP, CONCRETE
22	633858.68	79103.23	GRADE BREAK, GRAVEL
23	633863.12	79088.36	AP, CONCRETE & GRAVEL
24	633859.15	79087.24	AP, GRAVEL
25	633885.10	79089.02	PC, ASPHALT & GRAVEL
26	633888.14	79088.11	END GRAVEL
27	633890.25	79084.17	PT, ASPHALT
28	633894.97	79113.74	VALVE VAULT
29	633894.24	79142.88	WETWELL
30	633867.64	79110.57	GENERATOR PAD
31	633880.50	79115.45	GENERATOR PAD

FOR SAMPLE ONLY
 RECORD DRAWINGS
 REVISIONS DRAWN BY: XX DATE: XX/XX/XX
 THESE RECORD DRAWINGS HAVE BEEN PREPARED, IN PART, ON THE BASIS OF INFORMATION COMPILED BY OTHERS. THEY ARE NOT INTENDED TO REPRESENT IN DETAIL THE EXACT LOCATION, TYPE OF COMPONENT NOR MANNER OF CONSTRUCTION. THE ENGINEER WILL NOT BE RESPONSIBLE FOR ANY ERRORS OR OMISSIONS WHICH HAVE BEEN INCORPORATED INTO THE RECORD DRAWINGS.

STAMP
[ENGINEERS]

(PROJECT NAME)
CIVIL
GRADING AND DRAINAGE PLAN
DESCHUTES COUNTY, OREGON



ENGINEERING

DESIGNED BY: _____
 DRAWN BY: _____
 SCALE: _____
 FILE: _____
 DATE: _____

VERIFY SCALES
 1"
 BAR EQUALS ONE INCH ON ORIGINAL DRAWING

SHEET: **C-003**

COB # (XXXXXX)

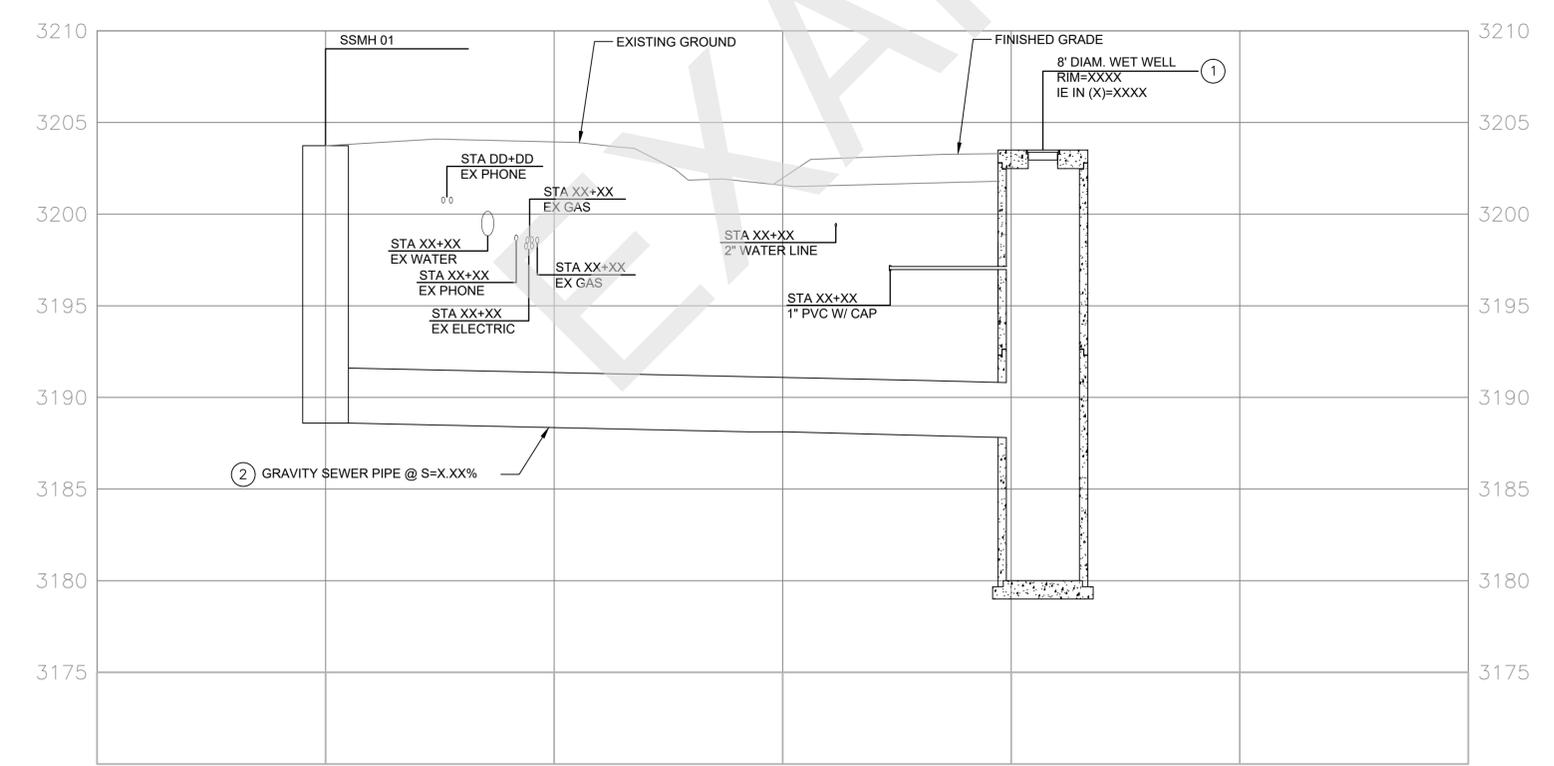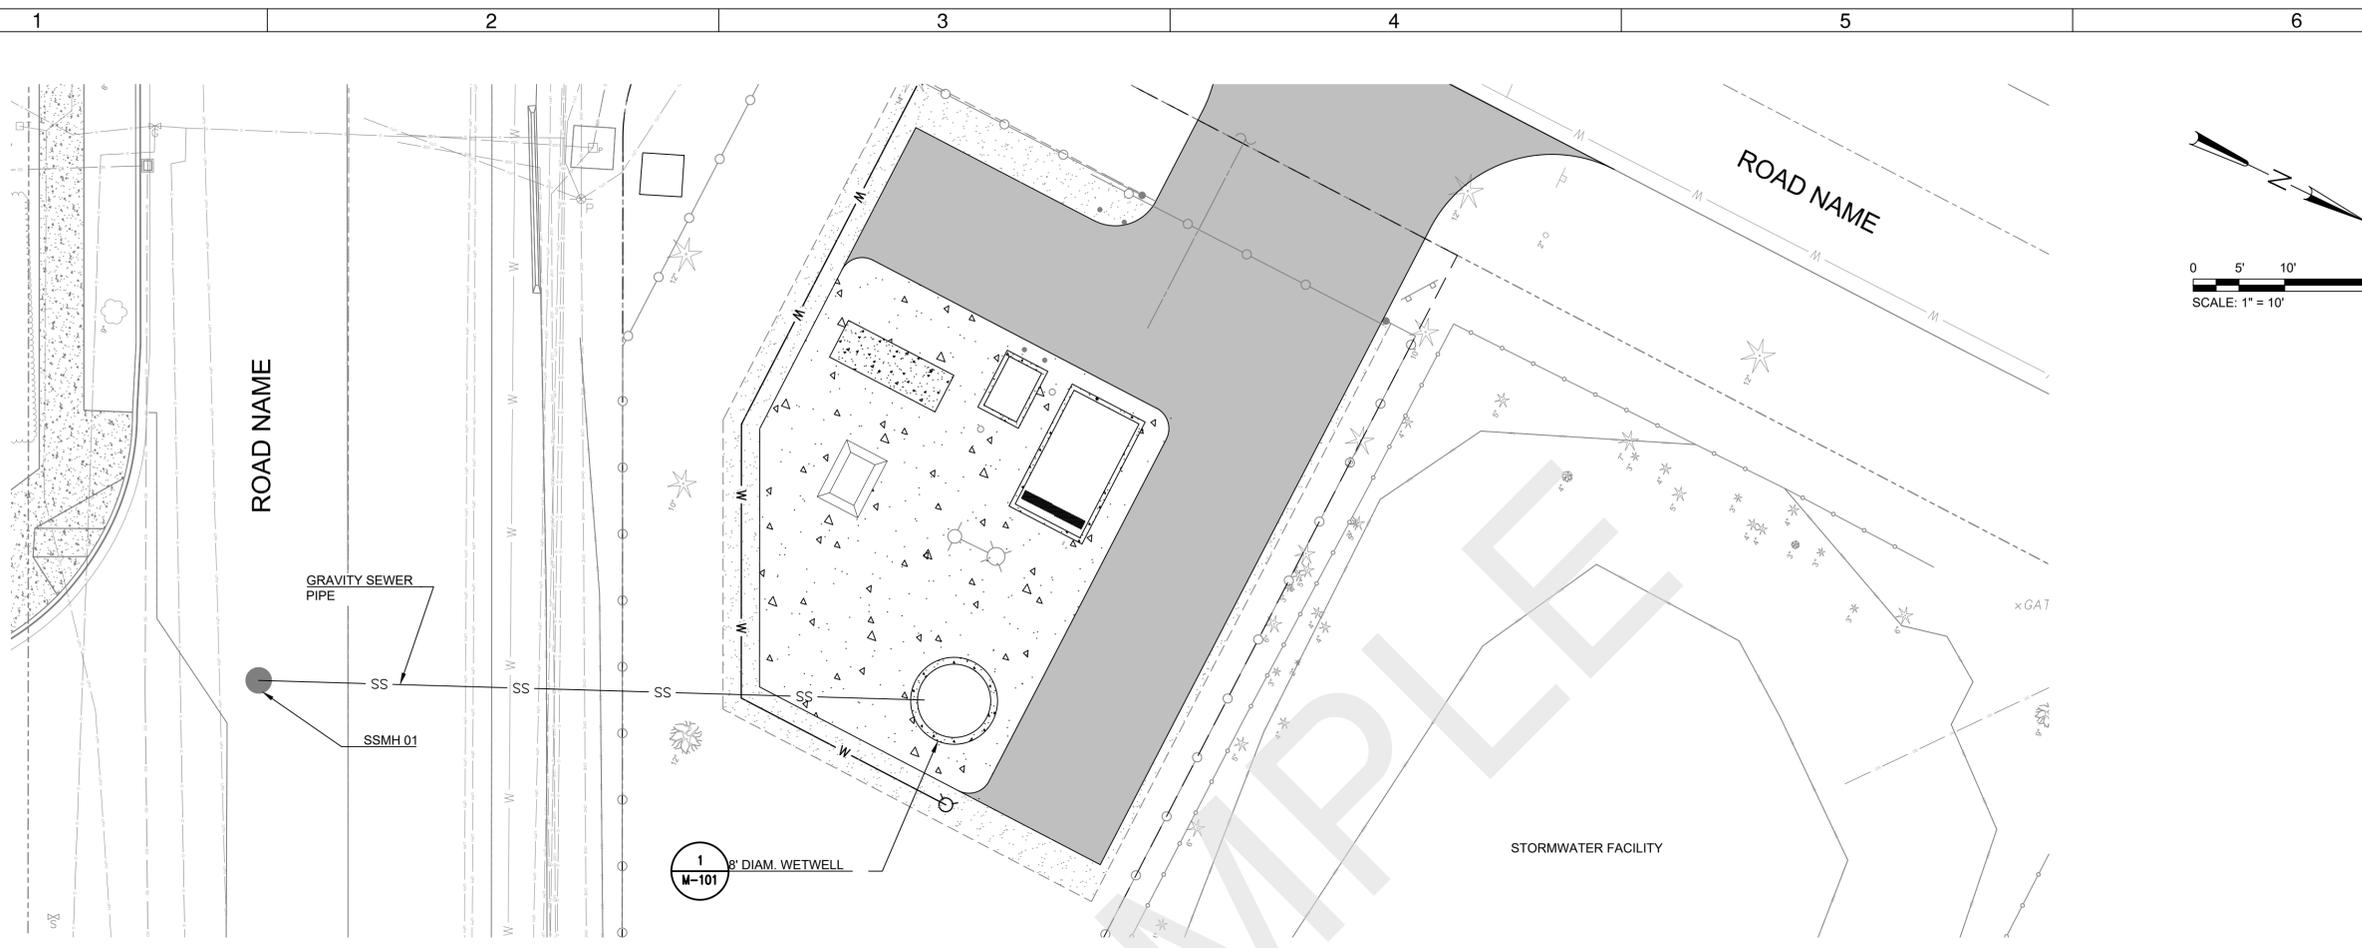

- KEY NOTES:**
- ① RIM ELEVATION TO BE 6" ABOVE FINISH GRADE AND 12" ABOVE 100 YEAR FLOOD ELEVATION.
 - ② NOTE MAXIMUM SLOPE PER HYDRAULIC INSTITUTE STANDARD 9.8, ARTICLE C.4.2

PROFILE SCALE: HORIZONTAL 1" = 10'
 VERTICAL 1" = 5'

FOR SAMPLE ONLY

RECORD DRAWINGS

REVISIONS DRAWN BY: XX DATE: XX/XX/XX
 THESE RECORD DRAWINGS HAVE BEEN PREPARED, IN PART, ON THE BASIS OF INFORMATION COMPILED BY OTHERS. THEY ARE NOT INTENDED TO REPRESENT IN DETAIL THE EXACT LOCATION, TYPE OF COMPONENT NOR MANNER OF CONSTRUCTION. THE ENGINEER WILL NOT BE RESPONSIBLE FOR ANY ERRORS OR OMISSIONS WHICH HAVE BEEN INCORPORATED INTO THE RECORD DRAWINGS.

[STAMP]
[ENGINEERS]

(PROJECT NAME)
CIVIL

GRAVITY SEWER PLAN AND PROFILE
DESCHUTES COUNTY, OREGON



[COMPANY NAME]
[COMPANY ADDRESS
AND PHONE NUMBER]

DESIGNED BY: _____
 DRAWN BY: _____
 SCALE: _____
 FILE: _____
 DATE: _____

VERIFY SCALES
 0 1"
 BAR EQUALS ONE INCH
 ON ORIGINAL DRAWING

SHEET:
C-004

COB # (XXXXXX)

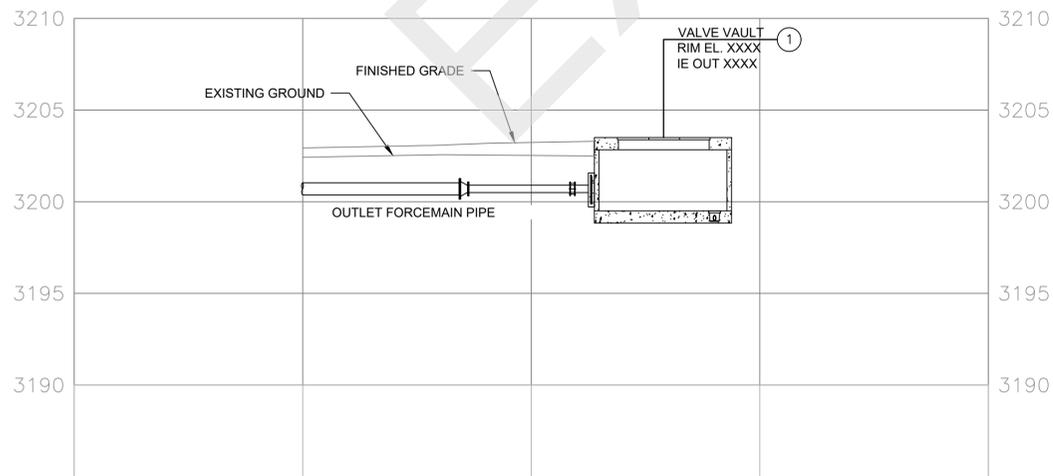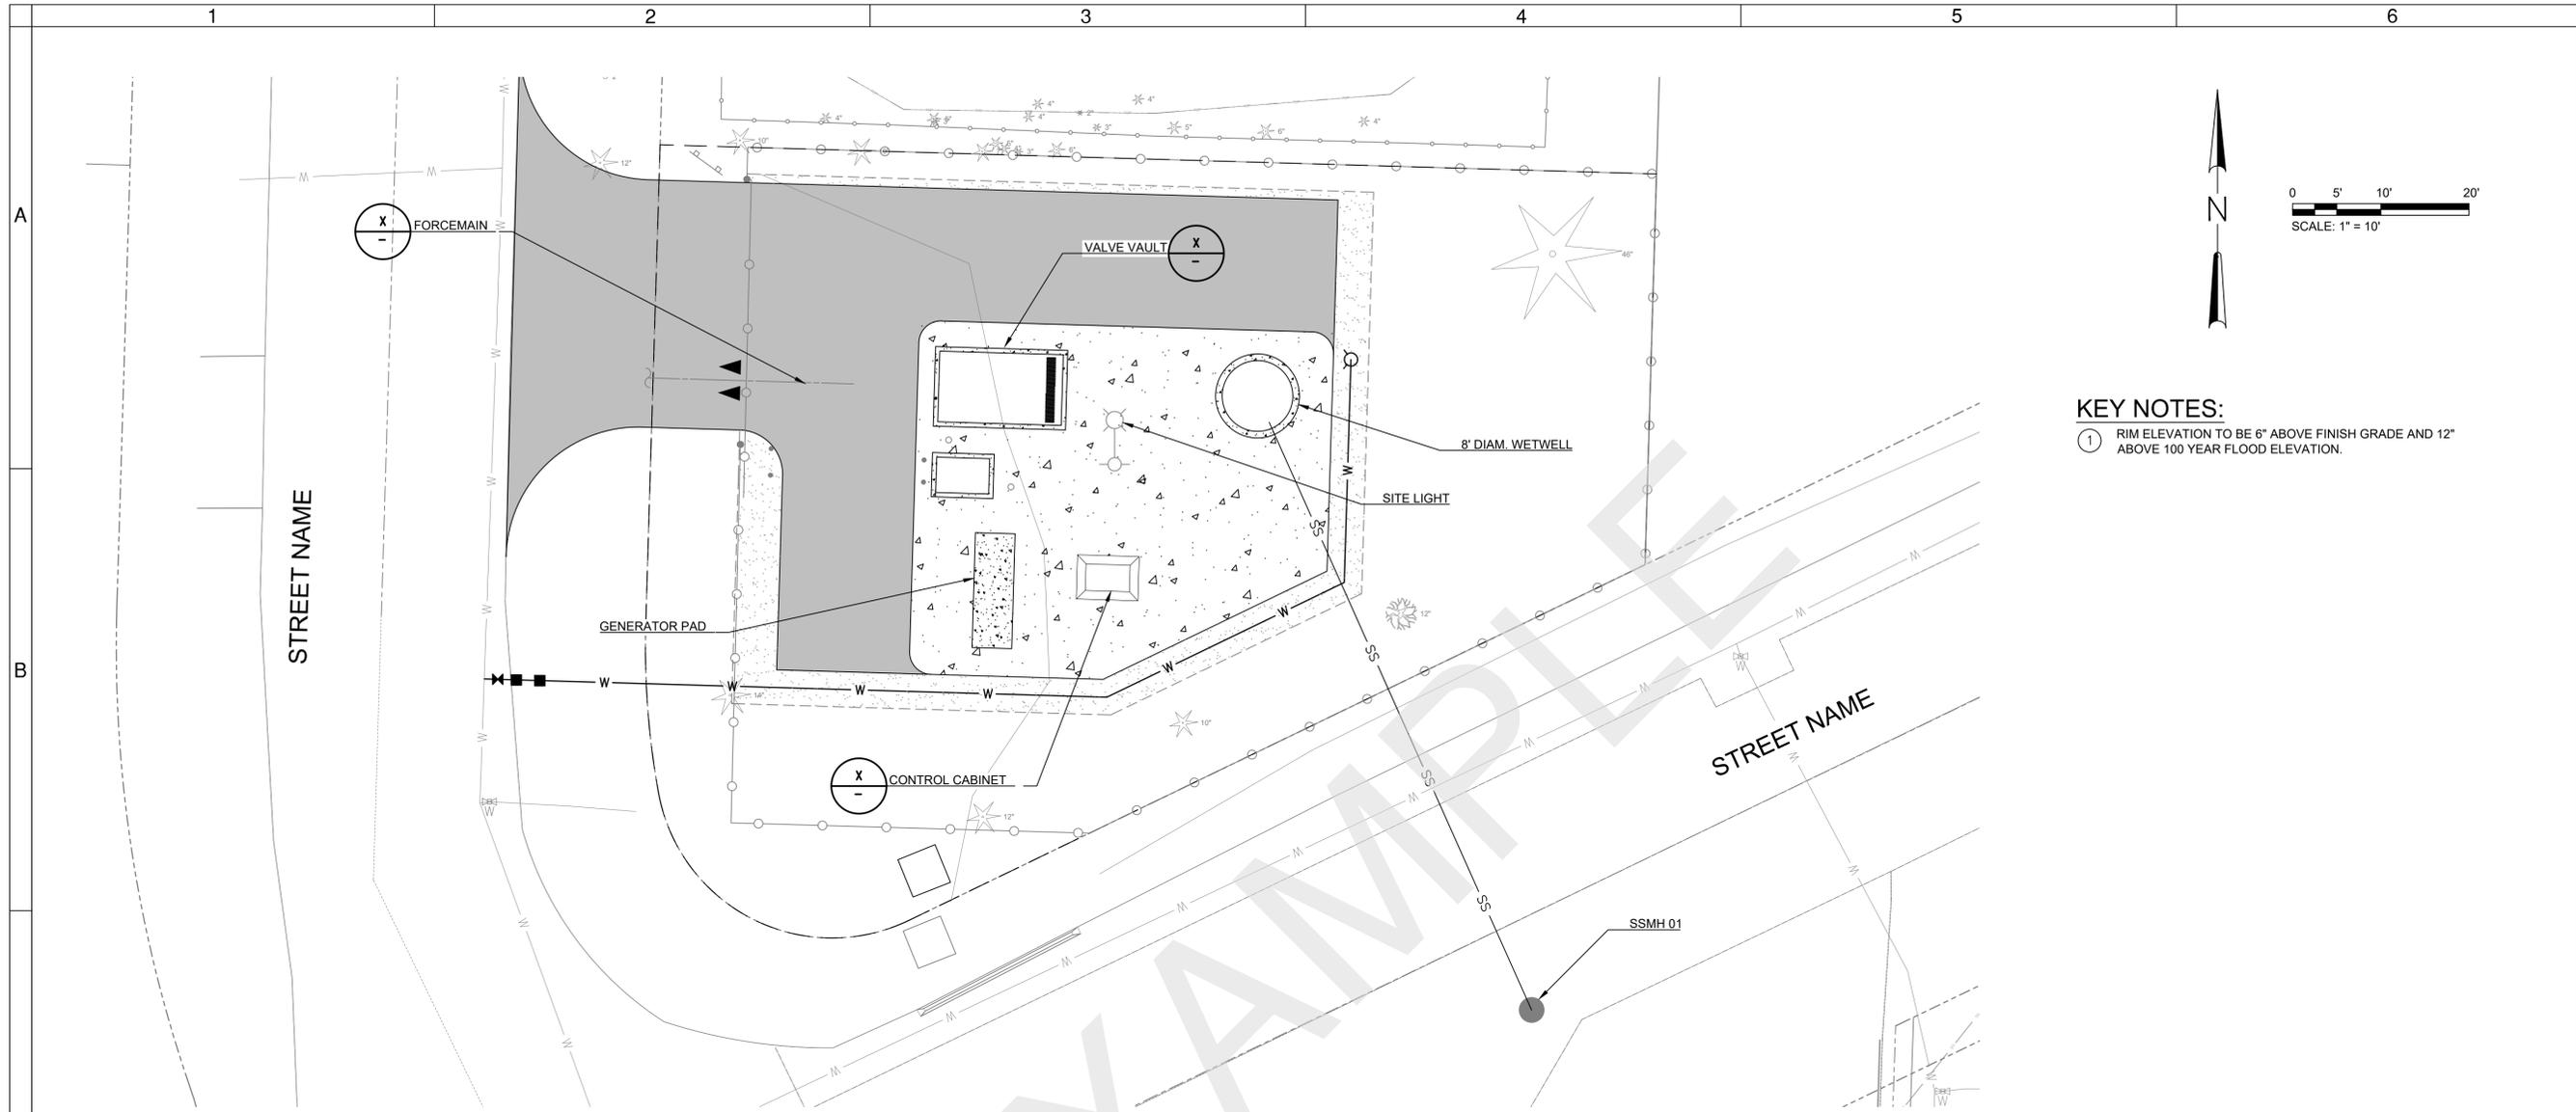

KEY NOTES:
 ① RIM ELEVATION TO BE 6" ABOVE FINISH GRADE AND 12" ABOVE 100 YEAR FLOOD ELEVATION.

FOR SAMPLE ONLY
 RECORD DRAWINGS
 REVISIONS DRAWN BY: XX DATE: XX/XX/XX
 THESE RECORD DRAWINGS HAVE BEEN PREPARED, IN PART, ON THE BASIS OF INFORMATION COMPILED BY OTHERS. THEY ARE NOT INTENDED TO REPRESENT IN DETAIL THE EXACT LOCATION, TYPE OF COMPONENT NOR MANNER OF CONSTRUCTION. THE ENGINEER WILL NOT BE RESPONSIBLE FOR ANY ERRORS OR OMISSIONS WHICH HAVE BEEN INCORPORATED INTO THE RECORD DRAWINGS.

STAMP
 [ENGINEERS]

(PROJECT NAME)
 CIVIL
 FORCE MAIN SEWER PLAN AND PROFILE
 DESCHUTES COUNTY, OREGON



REVISIONS:









[COMPANY NAME]
 [COMPANY ADDRESS AND PHONE NUMBER]

DESIGNED BY:
 DRAWN BY:
 SCALE:
 FILE:
 DATE:

VERIFY SCALES
 0 1"
 BAR EQUALS ONE INCH ON ORIGINAL DRAWING

SHEET:
C-005

COB # (XXXXXX)

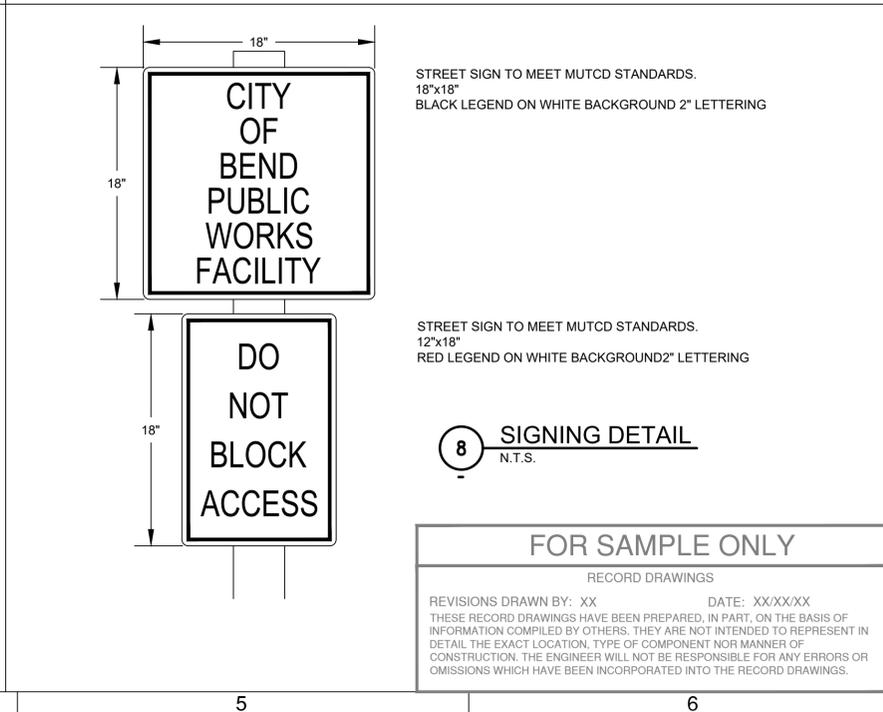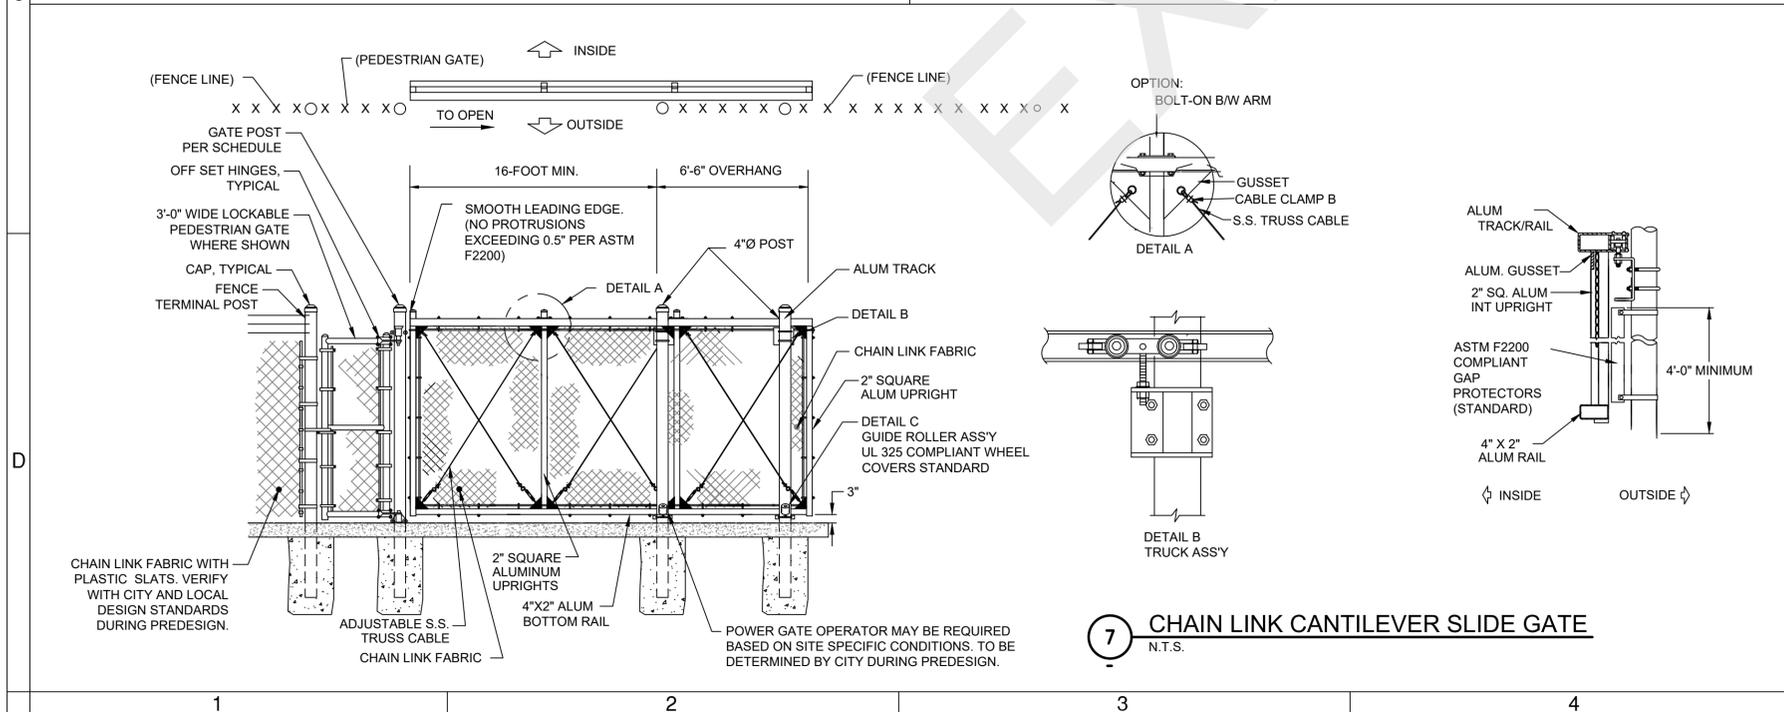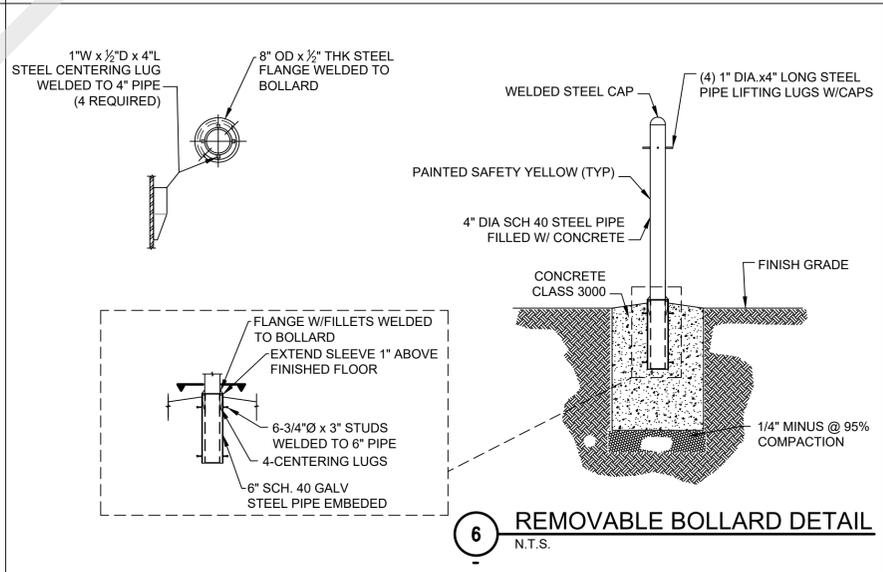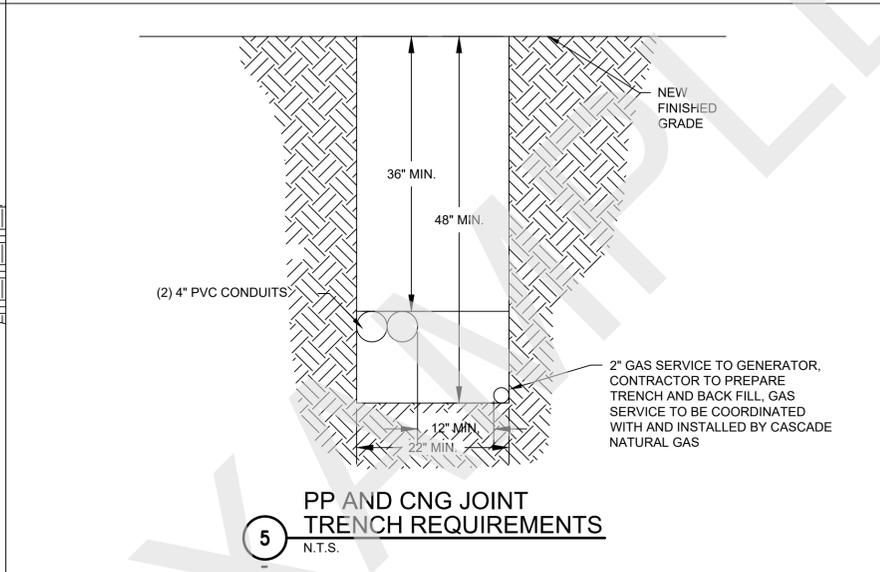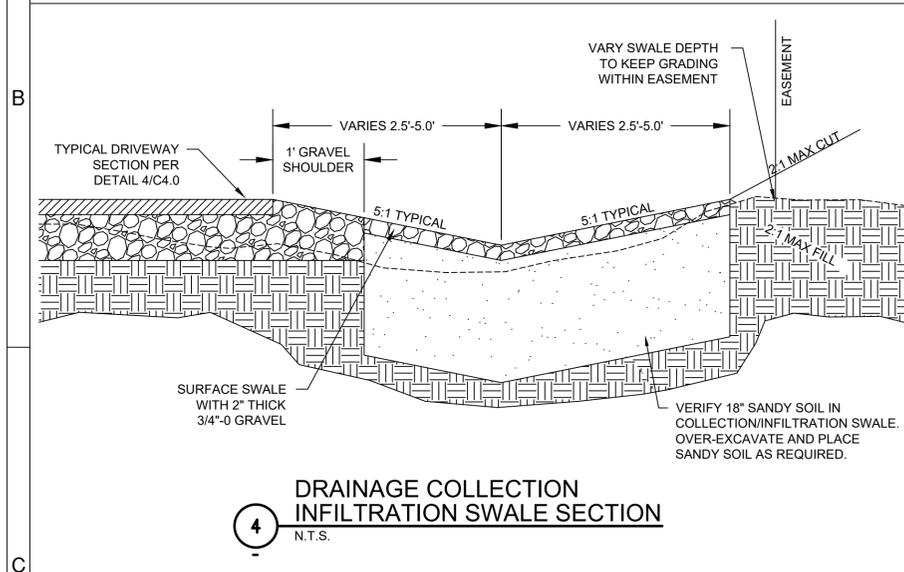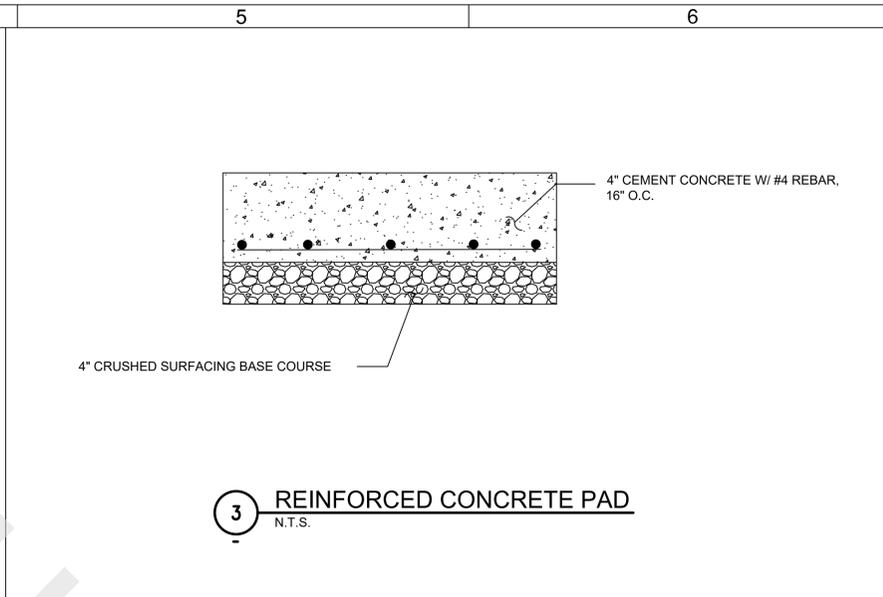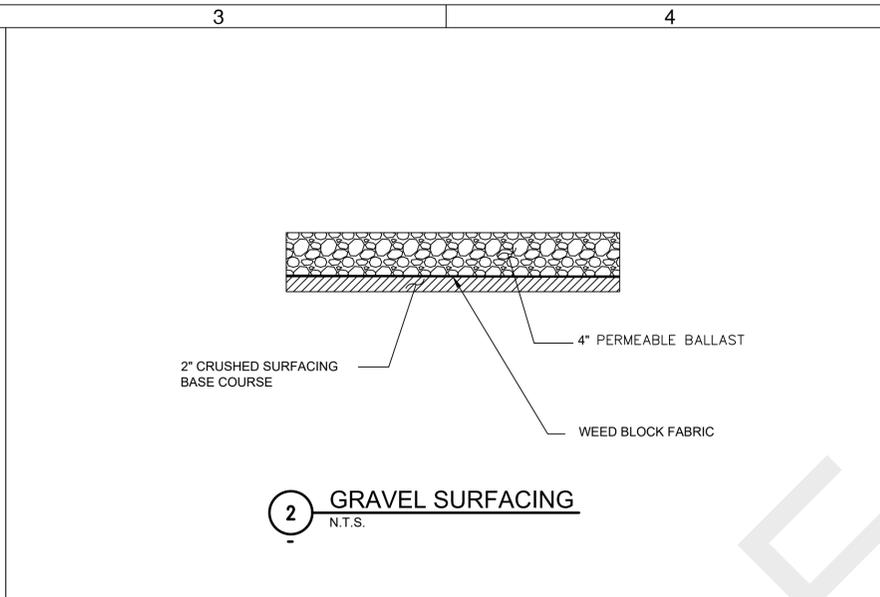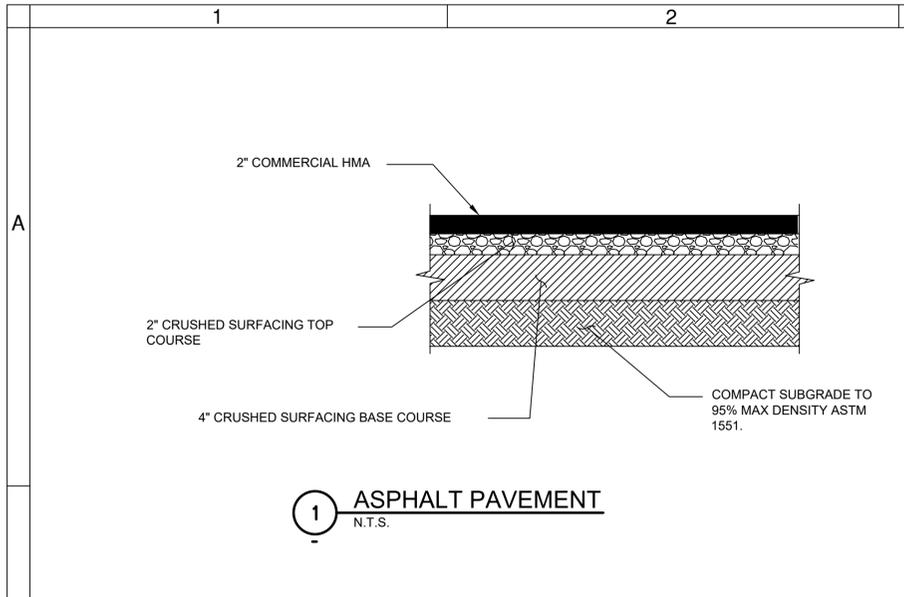

STAMP
[ENGINEERS]

(PROJECT NAME)
CIVIL
CIVIL DETAILS
DESCHUTES COUNTY, OREGON

ENGINEERING

[COMPANY NAME]
[COMPANY ADDRESS AND PHONE NUMBER]

DESIGNED BY: _____
DRAWN BY: _____
SCALE: _____
FILE: _____
DATE: _____


VERIFY SCALES
0 1"
BAR EQUALS ONE INCH ON ORIGINAL DRAWING

SHEET: **C-006**

COB # (XXXXXX)

REVISIONS:

RECORD DRAWINGS
DESIGNED BY: XX DATE: XX/XX/XX
THESE RECORD DRAWINGS HAVE BEEN PREPARED, IN PART, ON THE BASIS OF INFORMATION COMPILED BY OTHERS. THEY ARE NOT INTENDED TO REPRESENT IN DETAIL THE EXACT LOCATION, TYPE OF COMPONENT NOR MANNER OF CONSTRUCTION. THE ENGINEER WILL NOT BE RESPONSIBLE FOR ANY ERRORS OR OMISSIONS WHICH HAVE BEEN INCORPORATED INTO THE RECORD DRAWINGS.

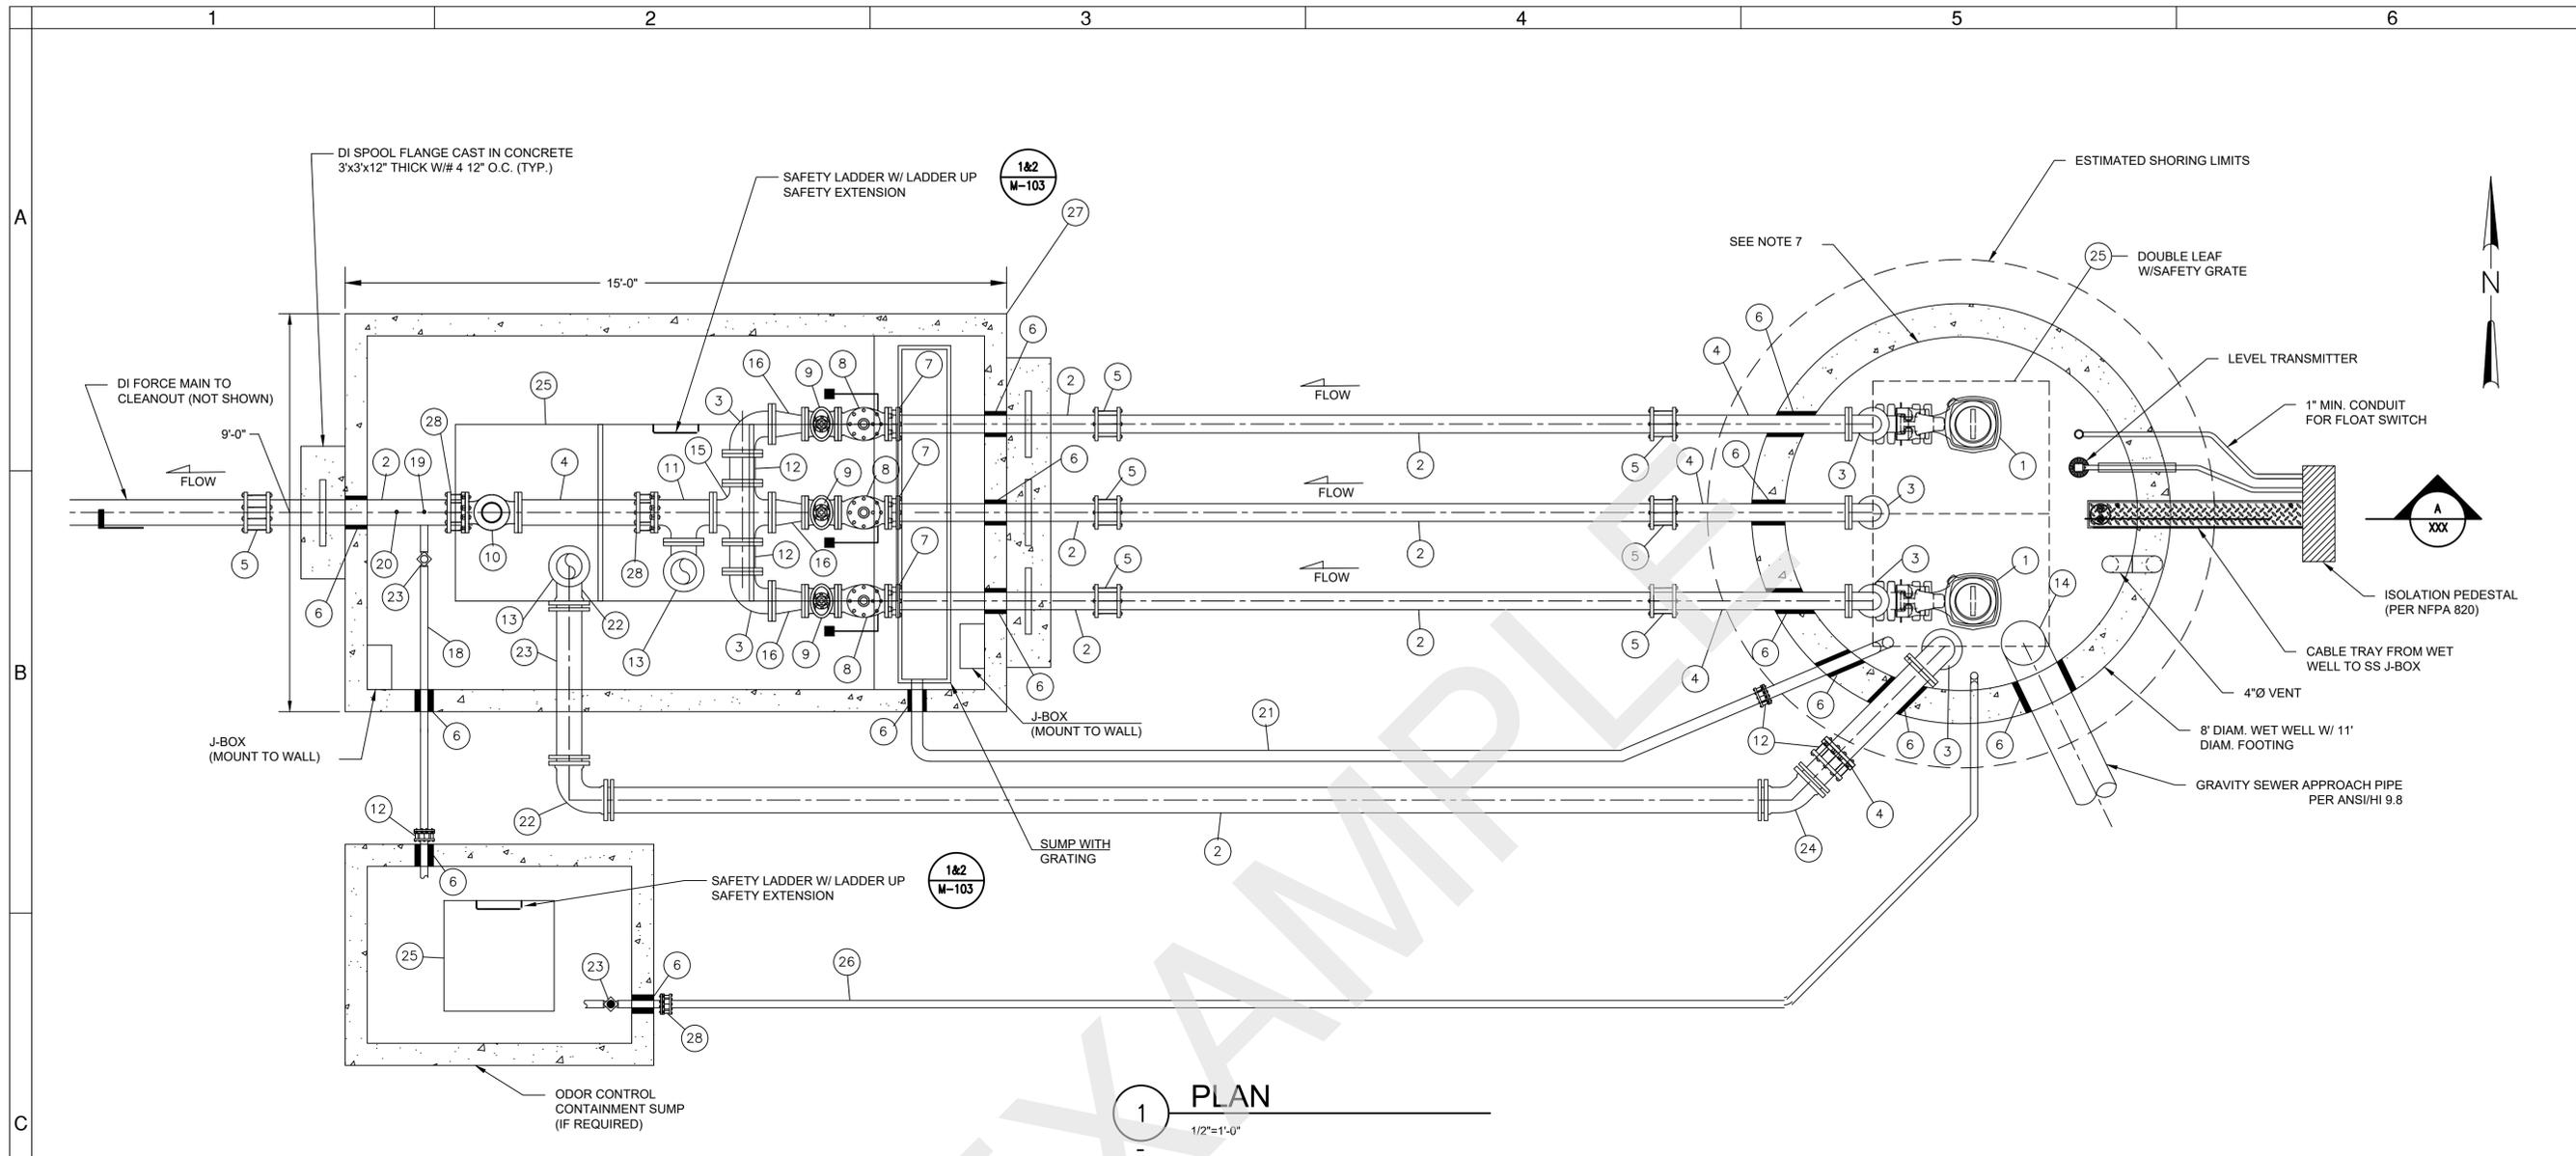

1 PLAN
1/2"=1'-0"

KEY NOTES:

- | | |
|---|--|
| 1 SUBMERSIBLE PUMPS, NOTE 6 | 17 NOT USED THIS SHEET |
| 2 DUCTILE IRON, PLAIN END | 18 PIPE FOR FUTURE ODOR CONTROL CHEMICAL FEED PENETRATION WITH CAP, NOTE 5 |
| 3 DUCTILE IRON 90° BEND, FL | 19 TAPPING SADDLE WITH 1" BALL VALVE |
| 4 DUCTILE IRON PIPE, FLANGE X PLAIN END | 20 PRESSURE TRANSMITTER ASSEMBLY WITH SADDLE TAP |
| 5 FLEXIBLE COUPLING | 21 PVC SDR 35 DRAIN LINE |
| 6 LINK SEAL | 22 90° BEND, MJ |
| 7 DISMANTLING JOINT | 23 ISOLATION BALL VALVE IN VALVE BOX |
| 8 SWING CHECK VALVE W/ SPRING AND LEVER, FLANGED | 24 45° BEND, MJ |
| 9 PLUG VALVE, FLANGED | 25 ALUMINUM, H20 LOAD RATED ACCESS HATCH |
| 10 FLOW METER, FLANGED | 26 4" DUCTILE IRON DRAIN LINE |
| 11 TEE, FLANGED | 27 PRECAST VALVE VAULT, SEE NOTE 1 |
| 12 PROVIDE FLANGED COUPLING ADAPTER FOR DIFFERENTIAL SETTLEMENT | 28 FLANGED COUPLING ADAPTER |
| 13 PUMPER PORT WITH ALUMINUM CAM LOCK FITTINGS (2 TYP.) MALE W/ CAP | |
| 14 DOWN TURNED TEE | |
| 15 CROSS, FLANGED | |
| 16 REDUCER, FLANGED | |

GENERAL NOTES:

- VALVE VAULT SHALL BE PRECAST. (4' MAX DEPTH RIM TO FLOOR)
- ALL PIPE AND FITTINGS IN WETWELL SHALL BE DUCTILE IRON CLASS 52 WITH FLANGED JOINTS AND EPOXY COATED.
- ALL PENETRATIONS SHALL BE CORE DRILLED AND SECURED/SEALED WITH LINK SEAL.
- ALL HARDWARE AND FASTENERS TO BE 316 STAINLESS STEEL.
- CITY OF BEND RESERVES THE RIGHT TO REQUIRE ODOR CONTROL SECONDARY CONTAINMENT SUMP AND ODOR CONTROL CHEMICAL FEED BASED ON LOCAL SITE REQUIREMENTS.
- SUBMERSIBLE PUMPS TO BE FLYGT WITH WITH N-IMPELLER OR APPROVED EQUAL. SEE G-008 FOR ADDITIONAL DESIGN DETAIL INFORMATION.
- PROVIDE THERMOPLASTIC LINER SYSTEM PER CITY STANDARDS SPECIFICATION SECTION 44 42 73.01, PREDL SYSTEMS, OR EQUAL.
- CONTRACTOR TO INSTALL SST GUIDE RAILS AND PUMP DISCHARGE PIPING FOR FUTURE THIRD PUMP.
- BYPASS SUCTION END OF PIPE TO BE 2'-0" BELOW GRAVITY APPROACH SEWER INVERT.
- ALL PIPE AND FITTING SIZES TO BE DETERMINED BASED ON SITE SPECIFIC REQUIREMENTS.

FOR SAMPLE ONLY
RECORD DRAWINGS

DESIGNED BY: _____ DATE: XX/XX/XX
DRAWN BY: _____
SCALE: _____ FILE: _____
DATE: _____

VERIFY SCALES
0 1"
BAR EQUALS ONE INCH ON ORIGINAL DRAWING

REVISIONS DRAWN BY: XX DATE: XX/XX/XX
THESE RECORD DRAWINGS HAVE BEEN PREPARED, IN PART, ON THE BASIS OF INFORMATION COMPILED BY OTHERS. THEY ARE NOT INTENDED TO REPRESENT IN DETAIL THE EXACT LOCATION, TYPE OF COMPONENT NOR MANNER OF CONSTRUCTION. THE ENGINEER WILL NOT BE RESPONSIBLE FOR ANY ERRORS OR OMISSIONS WHICH HAVE BEEN INCORPORATED INTO THE RECORD DRAWINGS.

[STAMP]
[ENGINEERS]

(PROJECT NAME)
MECHANICAL
LIFT STATION MECHANICAL PLAN
DESCHUTES COUNTY, OREGON


[COMPANY NAME]
[COMPANY ADDRESS AND PHONE NUMBER]

DESIGNED BY: _____ DATE: XX/XX/XX
DRAWN BY: _____
SCALE: _____ FILE: _____
DATE: _____

VERIFY SCALES
0 1"
BAR EQUALS ONE INCH ON ORIGINAL DRAWING

SHEET:
M-101

COB # (XXXXXX)

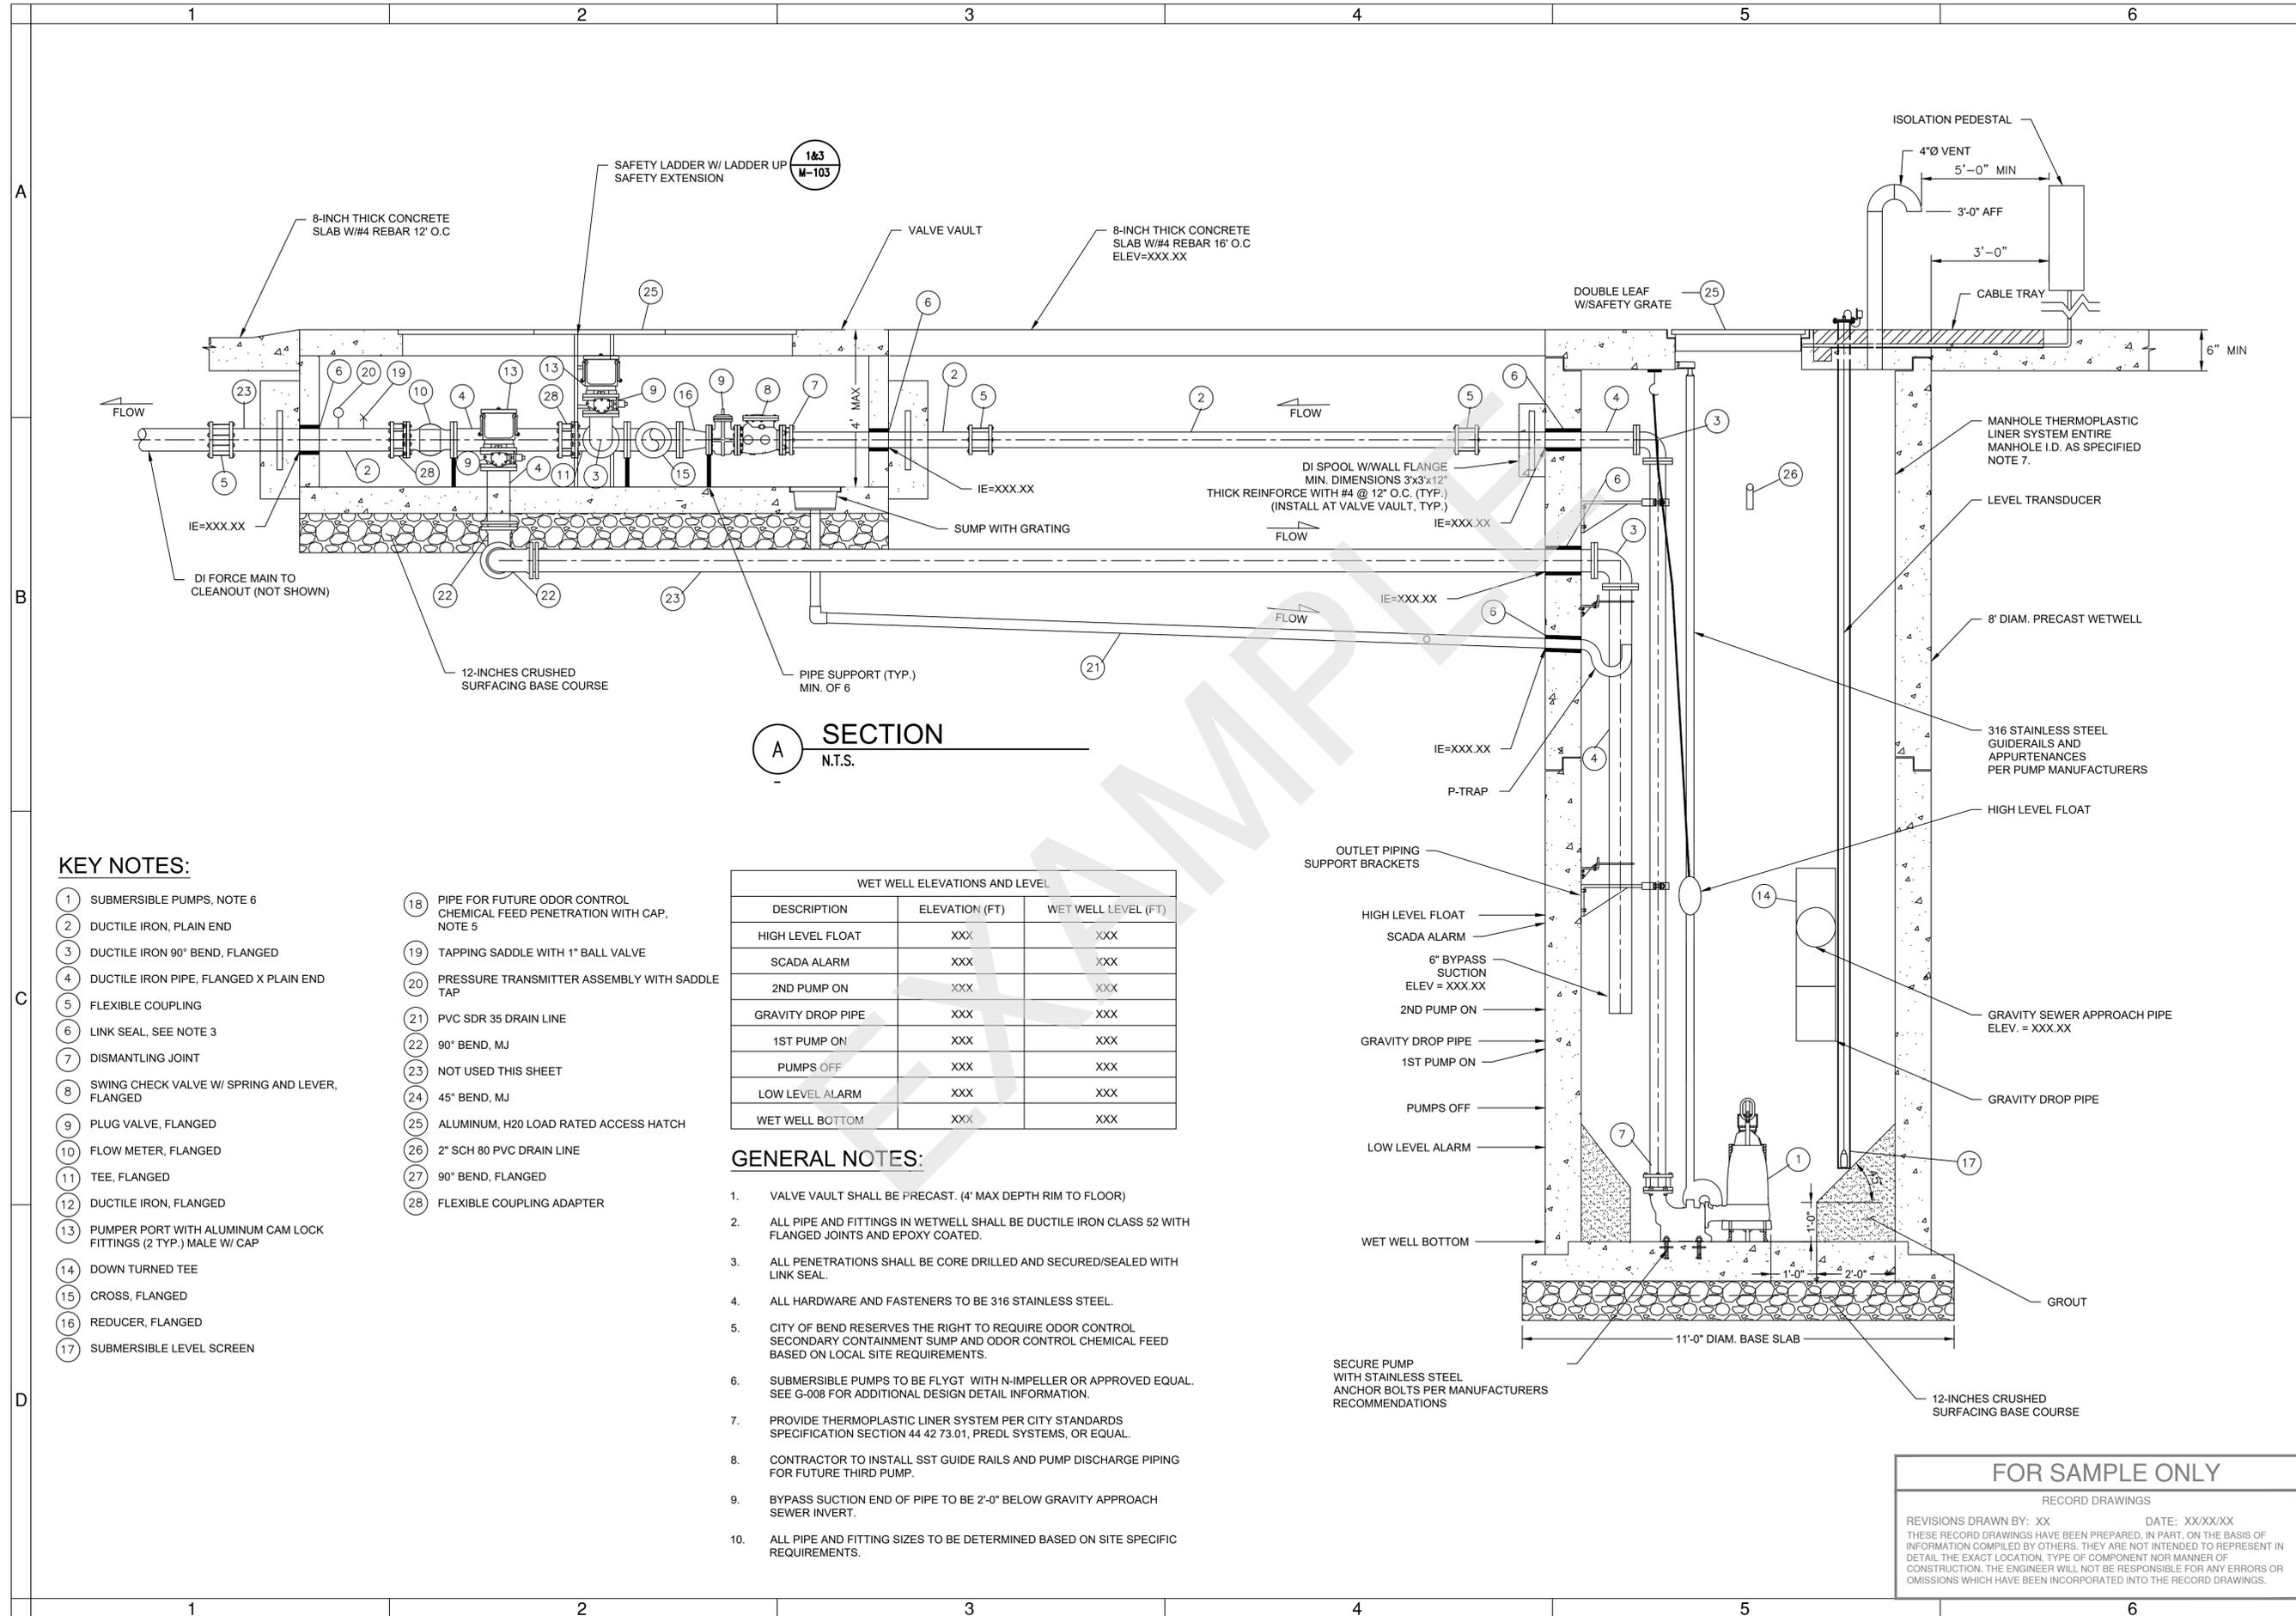

A SECTION
N.T.S.

KEY NOTES:

- | | |
|---|--|
| 1 SUBMERSIBLE PUMPS, NOTE 6 | 18 PIPE FOR FUTURE ODOR CONTROL CHEMICAL FEED PENETRATION WITH CAP, NOTE 5 |
| 2 DUCTILE IRON, PLAIN END | 19 TAPPING SADDLE WITH 1" BALL VALVE |
| 3 DUCTILE IRON 90° BEND, FLANGED | 20 PRESSURE TRANSMITTER ASSEMBLY WITH SADDLE TAP |
| 4 DUCTILE IRON PIPE, FLANGED X PLAIN END | 21 PVC SDR 35 DRAIN LINE |
| 5 FLEXIBLE COUPLING | 22 90° BEND, MJ |
| 6 LINK SEAL, SEE NOTE 3 | 23 NOT USED THIS SHEET |
| 7 DISMANTLING JOINT | 24 45° BEND, MJ |
| 8 SWING CHECK VALVE W/ SPRING AND LEVER, FLANGED | 25 ALUMINUM, H20 LOAD RATED ACCESS HATCH |
| 9 PLUG VALVE, FLANGED | 26 2" SCH 80 PVC DRAIN LINE |
| 10 FLOW METER, FLANGED | 27 90° BEND, FLANGED |
| 11 TEE, FLANGED | 28 FLEXIBLE COUPLING ADAPTER |
| 12 DUCTILE IRON, FLANGED | |
| 13 PUMPER PORT WITH ALUMINUM CAM LOCK FITTINGS (2 TYP.) MALE W/ CAP | |
| 14 DOWN TURNED TEE | |
| 15 CROSS, FLANGED | |
| 16 REDUCER, FLANGED | |
| 17 SUBMERSIBLE LEVEL SCREEN | |


WET WELL ELEVATIONS AND LEVEL		
DESCRIPTION	ELEVATION (FT)	WET WELL LEVEL (FT)
HIGH LEVEL FLOAT	XXX	XXX
SCADA ALARM	XXX	XXX
2ND PUMP ON	XXX	XXX
GRAVITY DROP PIPE	XXX	XXX
1ST PUMP ON	XXX	XXX
PUMPS OFF	XXX	XXX
LOW LEVEL ALARM	XXX	XXX
WET WELL BOTTOM	XXX	XXX

GENERAL NOTES:

- VALVE VAULT SHALL BE PRECAST. (4' MAX DEPTH RIM TO FLOOR)
- ALL PIPE AND FITTINGS IN WETWELL SHALL BE DUCTILE IRON CLASS 52 WITH FLANGED JOINTS AND EPOXY COATED.
- ALL PENETRATIONS SHALL BE CORE DRILLED AND SECURED/SEALED WITH LINK SEAL.
- ALL HARDWARE AND FASTENERS TO BE 316 STAINLESS STEEL.
- CITY OF BEND RESERVES THE RIGHT TO REQUIRE ODOR CONTROL SECONDARY CONTAINMENT SUMP AND ODOR CONTROL CHEMICAL FEED BASED ON LOCAL SITE REQUIREMENTS.
- SUBMERSIBLE PUMPS TO BE FLYGT WITH N-IMPELLER OR APPROVED EQUAL. SEE G-008 FOR ADDITIONAL DESIGN DETAIL INFORMATION.
- PROVIDE THERMOPLASTIC LINER SYSTEM PER CITY STANDARDS SPECIFICATION SECTION 44 42 73.01, PREDL SYSTEMS, OR EQUAL.
- CONTRACTOR TO INSTALL SST GUIDE RAILS AND PUMP DISCHARGE PIPING FOR FUTURE THIRD PUMP.
- BYPASS SUCTION END OF PIPE TO BE 2'-0" BELOW GRAVITY APPROACH SEWER INVERT.
- ALL PIPE AND FITTING SIZES TO BE DETERMINED BASED ON SITE SPECIFIC REQUIREMENTS.

STAMP
[ENGINEERS]

(PROJECT NAME)
MECHANICAL
LIFT STATION MECHANICAL SECTION
DESCHUTES COUNTY, OREGON

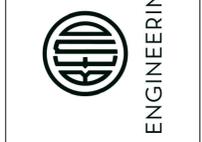

REVISIONS:

[COMPANY NAME]
[COMPANY ADDRESS AND PHONE NUMBER]



DESIGNED BY:
DRAWN BY:
SCALE:
FILE:
DATE:

VERIFY SCALES
0 1"
BAR EQUALS ONE INCH ON ORIGINAL DRAWING

SHEET:
M-102
COB # (XXXXXX)


FOR SAMPLE ONLY
RECORD DRAWINGS
REVISIONS DRAWN BY: XX DATE: XX/XX/XX
THESE RECORD DRAWINGS HAVE BEEN PREPARED, IN PART, ON THE BASIS OF INFORMATION COMPILED BY OTHERS. THEY ARE NOT INTENDED TO REPRESENT IN DETAIL THE EXACT LOCATION, TYPE OF COMPONENT NOR MANNER OF CONSTRUCTION. THE ENGINEER WILL NOT BE RESPONSIBLE FOR ANY ERRORS OR OMISSIONS WHICH HAVE BEEN INCORPORATED INTO THE RECORD DRAWINGS.

CLAMP BRACKET MAY BE REVERSED TO ACCOMMODATE RUNG SIZES OF 3/4" TO 1-1/4" WITH STANDARD 2" BOLTS FURNISHED. LARGER RUNGS WILL REQUIRE LONGER BOLTS.

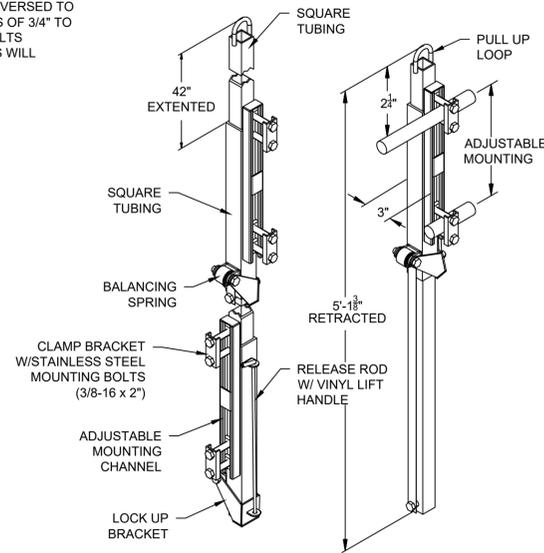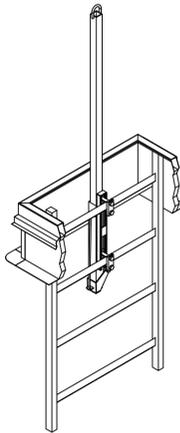


NOTES:
1. LADDER UP SAFETY EXTENSION SHALL BE STAINLESS STEEL



1 LADDER UP SAFETY EXTENSION
N.T.S.

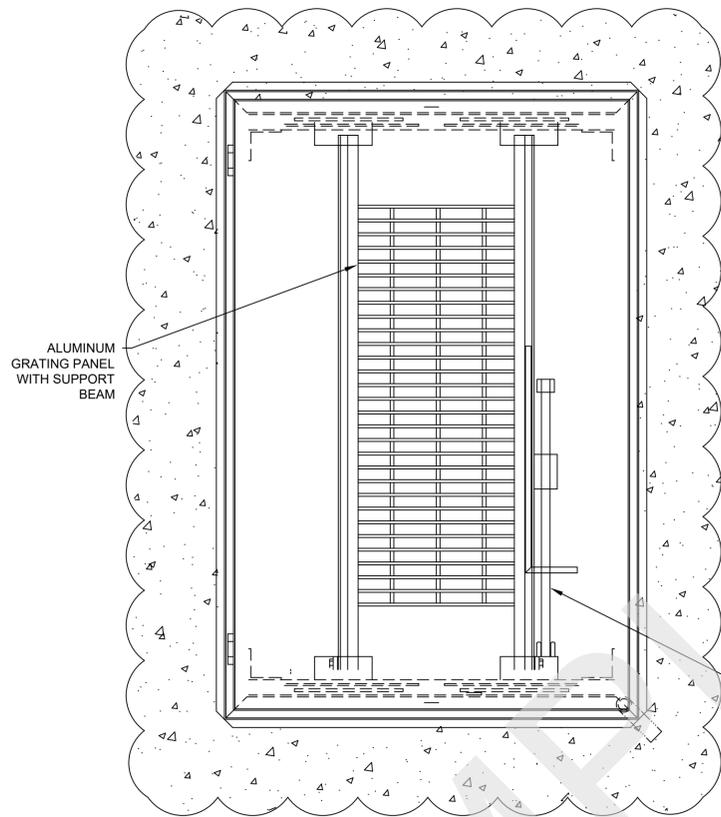

2 SAFETY GRATE DETAIL
N.T.S.

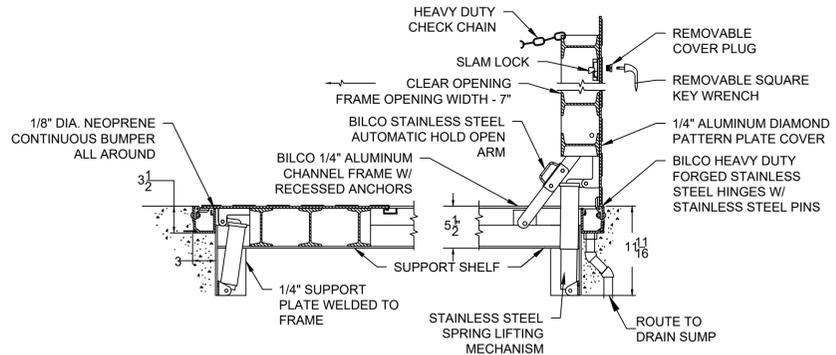


A SECTION
N.T.S.

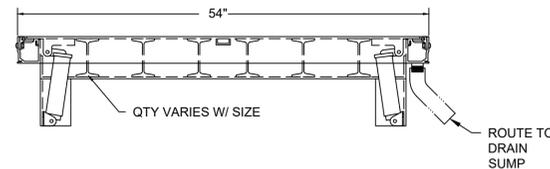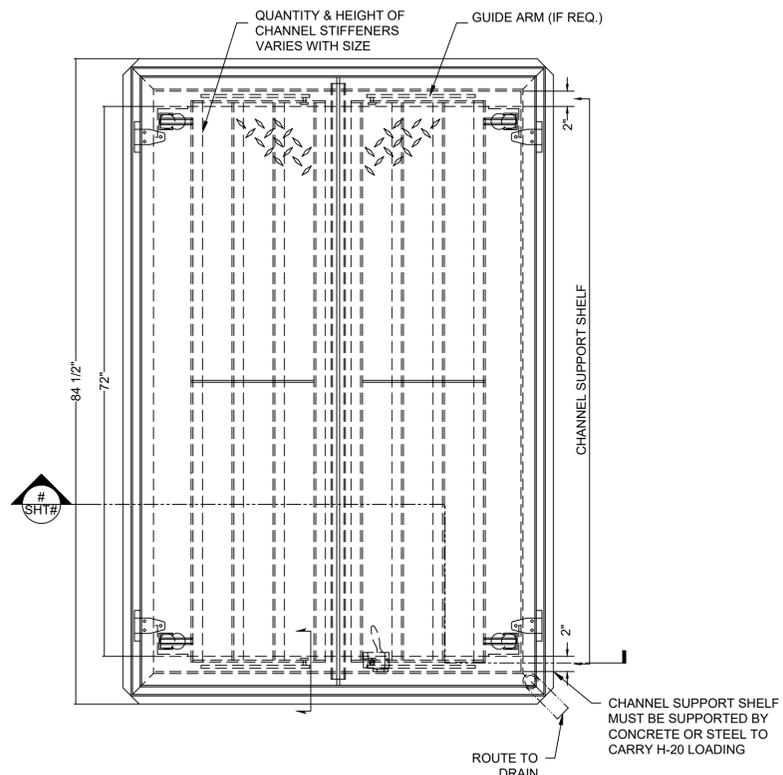

4 ACCESS DOOR DETAIL
N.T.S.

NOTES:
1. ALL ACCESS DOORS AND HATCHES TO BE H-20 RATED.

FOR SAMPLE ONLY
RECORD DRAWINGS
REVISIONS DRAWN BY: XX DATE: XX/XX/XX
THESE RECORD DRAWINGS HAVE BEEN PREPARED, IN PART, ON THE BASIS OF INFORMATION COMPILED BY OTHERS. THEY ARE NOT INTENDED TO REPRESENT IN DETAIL THE EXACT LOCATION, TYPE OF COMPONENT NOR MANNER OF CONSTRUCTION. THE ENGINEER WILL NOT BE RESPONSIBLE FOR ANY ERRORS OR OMISSIONS WHICH HAVE BEEN INCORPORATED INTO THE RECORD DRAWINGS.

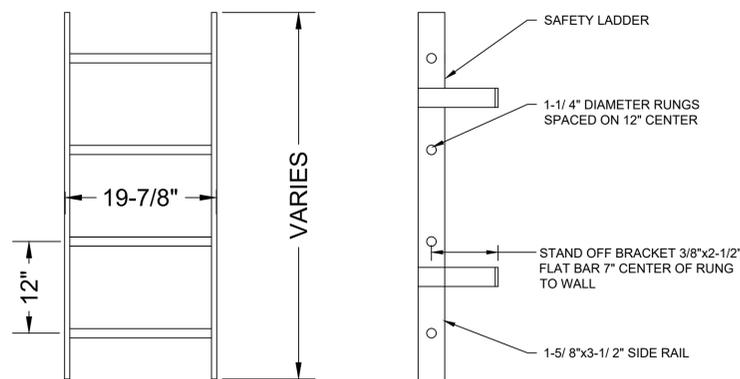

NOTES:
1. RUNGS SHOULD BE NONSKID.

3 LADDER DETAIL
N.T.S.

STAMP
[ENGINEERS]

(PROJECT NAME)
MECHANICAL
MECHANICAL DETAILS
DESCHUTES COUNTY, OREGON

ENGINEERING

DESIGNED BY: _____
DRAWN BY: _____
SCALE: _____
FILE: _____
DATE: _____

REVISIONS:

[COMPANY NAME]
[COMPANY ADDRESS AND PHONE NUMBER]

VERIFY SCALES
0 1"
BAR EQUALS ONE INCH ON ORIGINAL DRAWING

SHEET: **M-103**


COB # (XXXXXX)

A

B


C

D

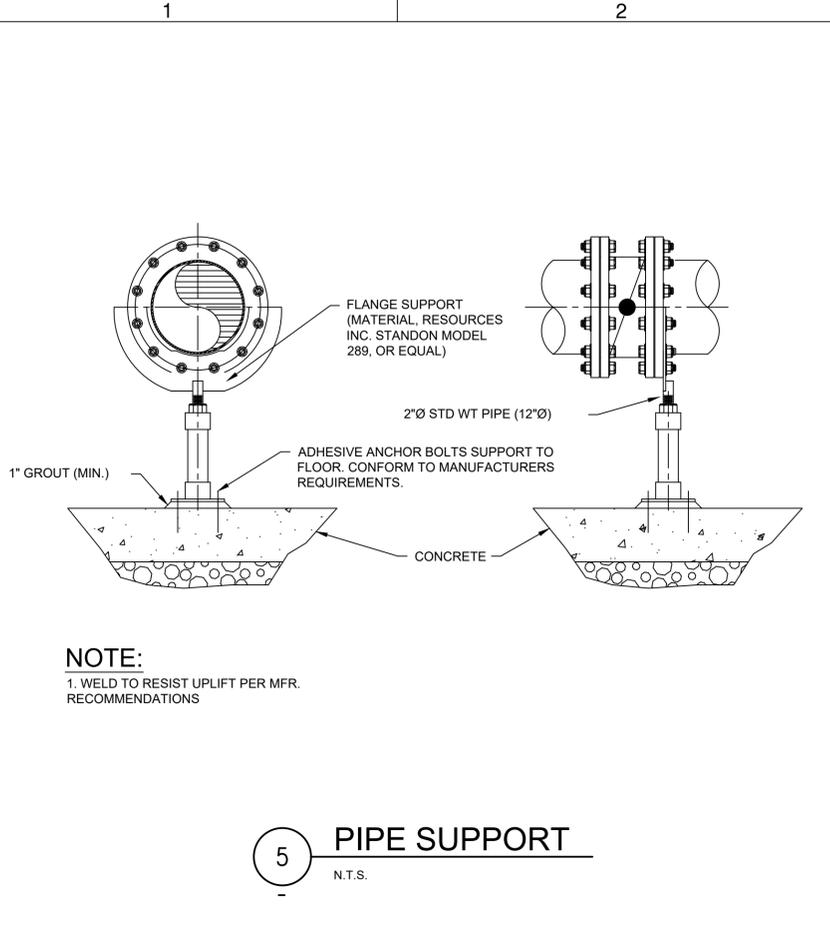


NOTE:
1. WELD TO RESIST UPLIFT PER MFR. RECOMMENDATIONS

5 PIPE SUPPORT
N.T.S.

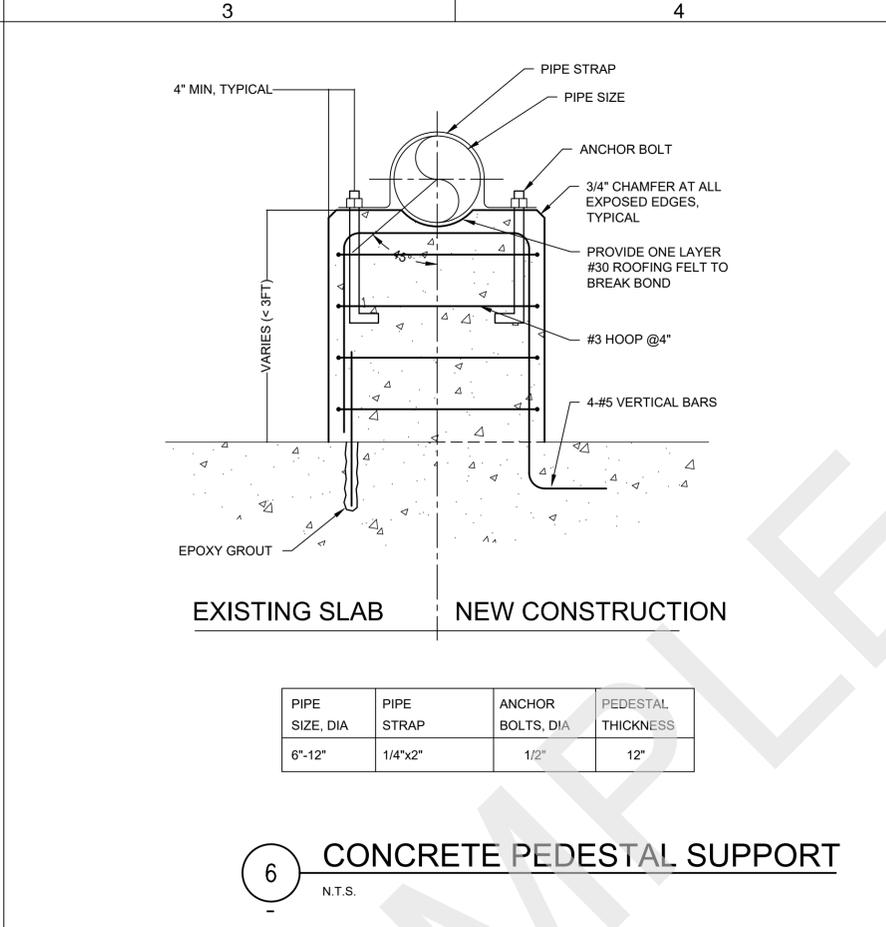


PIPE SIZE, DIA	PIPE STRAP	ANCHOR BOLTS, DIA	PEDESTAL THICKNESS
6"-12"	1/4"x2"	1/2"	12"

6 CONCRETE PEDESTAL SUPPORT
N.T.S.

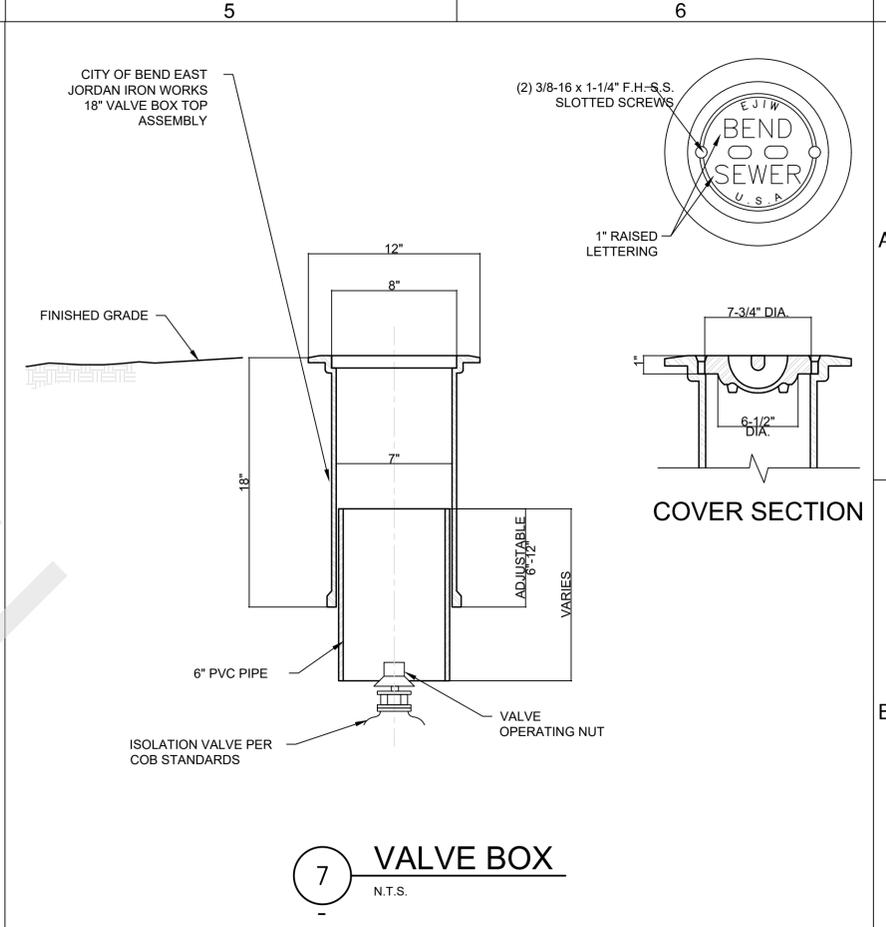

7 VALVE BOX
N.T.S.

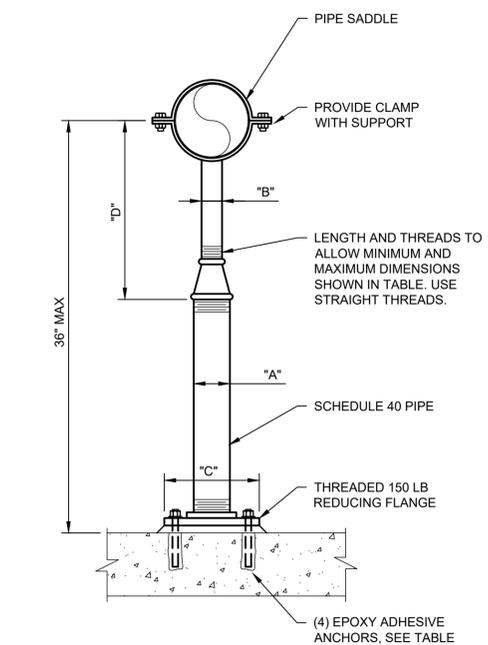

PIPE SIZE	FLOOR PIPE SUPPORT SCHEDULE DIMENSIONS IN INCHES							
	"A"	"B"	"C"	"D"		ANCHORS		
				MINIMUM	MAXIMUM	DIA	EMBED	
≤ 2 1/2	2 1/2	1 1/2	9	8	13	5/8	5	
3	2 1/2	1 1/2	9	8 1/2	13 1/2	5/8	5	
3 1/2	2 1/2	1 1/2	9	8 1/2	13 1/2	5/8	5	
4	3	2 1/2	9	9 1/2	14	5/8	5	
6	3	2 1/2	9	10 1/2	15 1/2	5/8	5	
8	3	2 1/2	9	11 1/2	16 1/2	5/8	5	
10	3	2 1/2	9	13 1/2	18 1/2	5/8	5	
12	3	2 1/2	9	15	19 1/2	5/8	5	

8 FLOOR PIPE SUPPORT
N.T.S.

STAMP
[ENGINEERS]

(PROJECT NAME)
MECHANICAL
MECHANICAL DETAILS
DESCHUTES COUNTY, OREGON



REVISIONS:


[COMPANY NAME]
[COMPANY ADDRESS AND PHONE NUMBER]

DESIGNED BY:
DRAWN BY:
SCALE:
FILE:
DATE:

VERIFY SCALES
0 1"
BAR EQUALS ONE INCH ON ORIGINAL DRAWING

SHEET:
M-104
COB # (XXXXXX)

FOR SAMPLE ONLY
RECORD DRAWINGS
REVISIONS DRAWN BY: XX DATE: XX/XX/XX
THESE RECORD DRAWINGS HAVE BEEN PREPARED, IN PART, ON THE BASIS OF INFORMATION COMPILED BY OTHERS. THEY ARE NOT INTENDED TO REPRESENT IN DETAIL THE EXACT LOCATION, TYPE OF COMPONENT NOR MANNER OF CONSTRUCTION. THE ENGINEER WILL NOT BE RESPONSIBLE FOR ANY ERRORS OR OMISSIONS WHICH HAVE BEEN INCORPORATED INTO THE RECORD DRAWINGS.

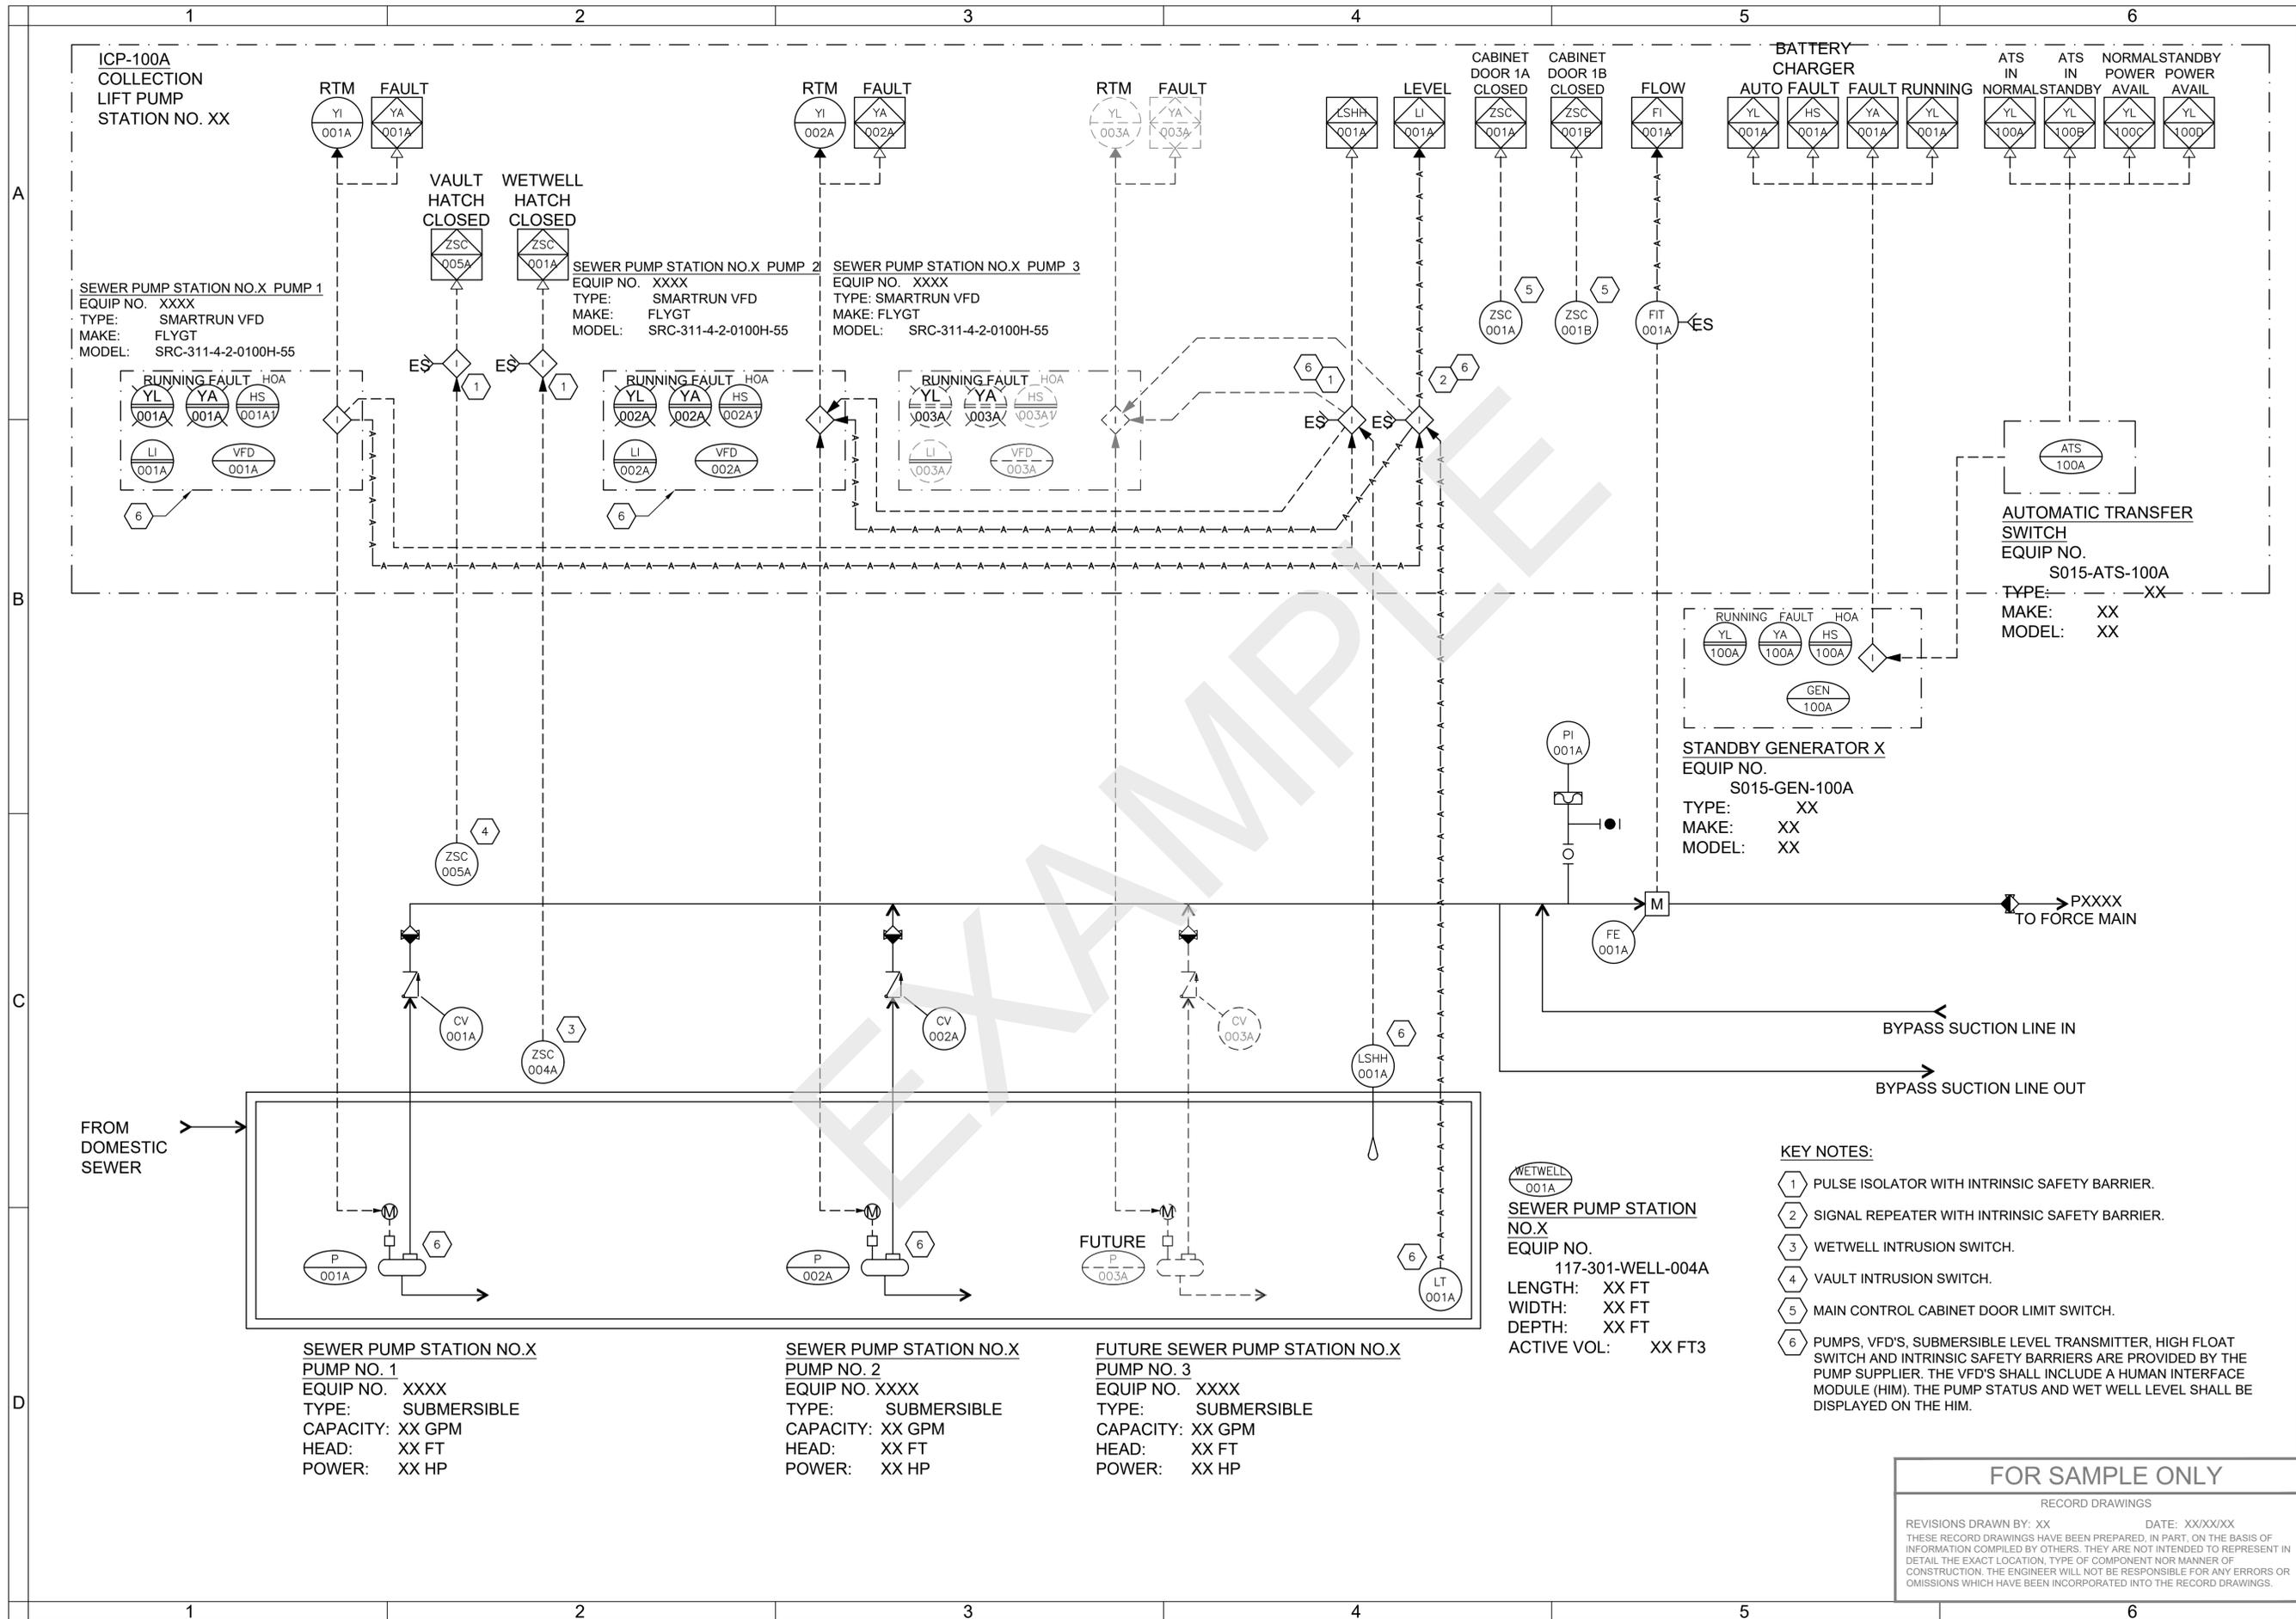

ICP-100A
COLLECTION
LIFT PUMP
STATION NO. XX

SEWER PUMP STATION NO.X PUMP 1
EQUIP NO. XXXX
TYPE: SMARTRUN VFD
MAKE: FLYGT
MODEL: SRC-311-4-2-0100H-55

SEWER PUMP STATION NO.X PUMP 2
EQUIP NO. XXXX
TYPE: SMARTRUN VFD
MAKE: FLYGT
MODEL: SRC-311-4-2-0100H-55

SEWER PUMP STATION NO.X PUMP 3
EQUIP NO. XXXX
TYPE: SMARTRUN VFD
MAKE: FLYGT
MODEL: SRC-311-4-2-0100H-55

STANDBY GENERATOR X
EQUIP NO.
S015-GEN-100A
TYPE: XX
MAKE: XX
MODEL: XX

AUTOMATIC TRANSFER
SWITCH
EQUIP NO.
S015-ATS-100A
TYPE: XX
MAKE: XX
MODEL: XX

FROM
DOMESTIC
SEWER

SEWER PUMP STATION NO.X
PUMP NO. 1
EQUIP NO. XXXX
TYPE: SUBMERSIBLE
CAPACITY: XX GPM
HEAD: XX FT
POWER: XX HP

SEWER PUMP STATION NO.X
PUMP NO. 2
EQUIP NO. XXXX
TYPE: SUBMERSIBLE
CAPACITY: XX GPM
HEAD: XX FT
POWER: XX HP

FUTURE SEWER PUMP STATION NO.X
PUMP NO. 3
EQUIP NO. XXXX
TYPE: SUBMERSIBLE
CAPACITY: XX GPM
HEAD: XX FT
POWER: XX HP

SEWER PUMP STATION
NO.X
EQUIP NO.
117-301-WELL-004A
LENGTH: XX FT
WIDTH: XX FT
DEPTH: XX FT
ACTIVE VOL: XX FT3

KEY NOTES:

- 1 PULSE ISOLATOR WITH INTRINSIC SAFETY BARRIER.
- 2 SIGNAL REPEATER WITH INTRINSIC SAFETY BARRIER.
- 3 WETWELL INTRUSION SWITCH.
- 4 VAULT INTRUSION SWITCH.
- 5 MAIN CONTROL CABINET DOOR LIMIT SWITCH.
- 6 PUMPS, VFD'S, SUBMERSIBLE LEVEL TRANSMITTER, HIGH FLOAT SWITCH AND INTRINSIC SAFETY BARRIERS ARE PROVIDED BY THE PUMP SUPPLIER. THE VFD'S SHALL INCLUDE A HUMAN INTERFACE MODULE (HIM). THE PUMP STATUS AND WET WELL LEVEL SHALL BE DISPLAYED ON THE HIM.

FOR SAMPLE ONLY
RECORD DRAWINGS
DESIGNED BY: XX DATE: XX/XX/XX
DRAWN BY: XX
SCALE: 1" = 100'
FILE: XX
DATE: XX/XX/XX
THESE RECORD DRAWINGS HAVE BEEN PREPARED, IN PART, ON THE BASIS OF INFORMATION COMPILED BY OTHERS. THEY ARE NOT INTENDED TO REPRESENT IN DETAIL THE EXACT LOCATION, TYPE OF COMPONENT NOR MANNER OF CONSTRUCTION. THE ENGINEER WILL NOT BE RESPONSIBLE FOR ANY ERRORS OR OMISSIONS WHICH HAVE BEEN INCORPORATED INTO THE RECORD DRAWINGS.

(PROJECT NAME)

INSTRUMENTATION & CONTROLS

STANDARD P&ID CONSTANT

DESCHUTES COUNTY, OREGON

ENGINEERING


DESIGNED BY: _____
DRAWN BY: _____
SCALE: _____
FILE: _____
DATE: _____

REVISIONS:


VERIFY SCALES
0 1" BAR EQUALS ONE INCH ON ORIGINAL DRAWING

SHEET: **I-001**

COB # (XXXXXX)

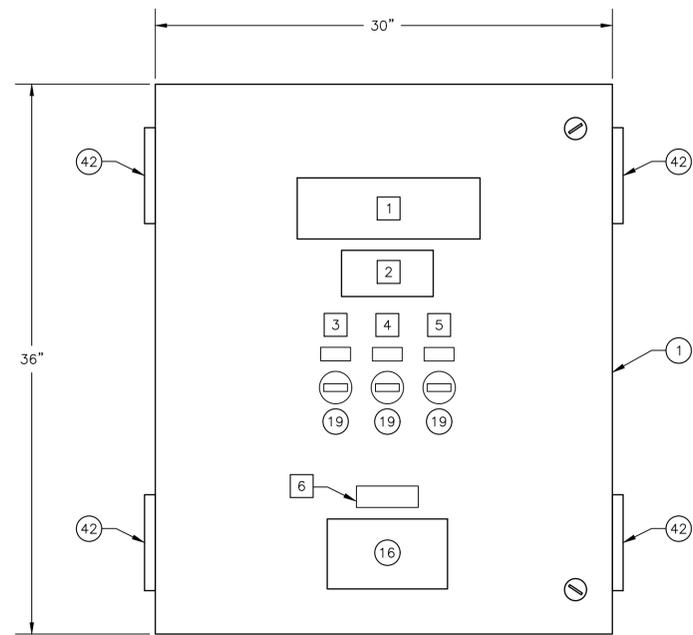

EXTERIOR FRONT ELEVATION

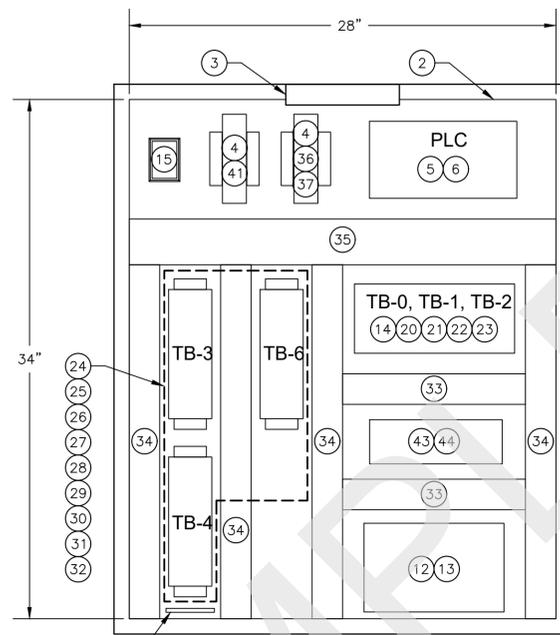

INTERIOR ELEVATION

**CONTROL PANEL
PANEL LAYOUT ELEVATION**

1
N.T.S.

GENERAL NOTES:


1. PANEL CONSTRUCTION PER NEC 2014, UL 508A REQUIREMENTS, FOLLOW NFPA 79 WHERE APPLICABLE.
2. PANEL WIRING EXCEPT WHERE OTHER SPECIFIED:
 - SINGLE WIRES SHALL BE THHN 16AWG, EXCEPT WHERE INTENDED FOR POWER OR MOTOR CIRCUITS WHICH SHALL BE 12AWG, MIN.
 - COLOR CODE SHALL FOLLOW UL 508A.
 - TWISTED PAIR ANALOG SIGNAL CABLE SHALL BE BELDEN 8760 OR EQUAL.
 - EACH WIRE SHALL BE IDENTIFIED WITH A PERMANENT WIRE LABEL, P/N BRADY LAT-18-361.
3. PANEL FABRICATOR SHALL PROVIDE ENGRAVED NAMEPLATES AS INDICATED AND LOCATED ON THIS DRAWING. REFERENCE OWNER'S ELECTRICAL SPECIFICATIONS FOR MATERIAL, FABRICATION, AND INSTALLATION DETAILS.
4. PANEL FABRICATOR TO LABEL ALL FUSES, TERMINAL BLOCKS, CIRCUIT BREAKERS WITH DEVICE DESIGNATION OR WIRE NUMBER AS SHOWN USING MANUFACTURER APPROPRIATE LABELING SYSTEM.
5. CONTROL PANEL SHALL NOT BE FABRICATED WITH A FALSE FRONT.
6. PROVIDE A MINIMUM OF 10% AVAILABLE TERMINAL BLOCKS.
7. PANEL LAYOUT SHALL RESERVE SPACE TO ADD A MINIMUM OF TWO PLC EXPANSION MODULES.

LEGEND:

- [X] INDICATES BILL OF MATERIALS (BOM) ITEM; REFERENCE SHEET I-003
- (X) INDICATES NAMEPLATE ITEM; REFERENCE SHEET I-003

STAMP
[ENGINEERS]

(PROJECT NAME)
CONTROL PANEL TYPE B
TEMPLATE (50 I/Os) PANEL LAYOUT

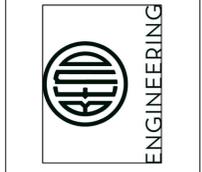

REVISIONS:

[COMPANY NAME]
[COMPANY ADDRESS AND PHONE NUMBER]

DESIGNED BY: _____
DRAWN BY: _____
SCALE: _____
FILE: _____
DATE: _____

VERIFY SCALES
0 1"
BAR EQUALS ONE INCH ON ORIGINAL DRAWING

SHEET:
I-002

COB # (XXXXXX)

FOR SAMPLE ONLY
RECORD DRAWINGS
REVISIONS DRAWN BY: XX DATE: XX/XX/XX
THESE RECORD DRAWINGS HAVE BEEN PREPARED, IN PART, ON THE BASIS OF INFORMATION COMPILED BY OTHERS. THEY ARE NOT INTENDED TO REPRESENT IN DETAIL THE EXACT LOCATION, TYPE OF COMPONENT NOR MANNER OF CONSTRUCTION. THE ENGINEER WILL NOT BE RESPONSIBLE FOR ANY ERRORS OR OMISSIONS WHICH HAVE BEEN INCORPORATED INTO THE RECORD DRAWINGS.

BILL OF MATERIALS					
ITEM	QTY	DESCRIPTION	MANUFACTURE	MODEL/CAT #	SUPPLIER
①	1	ENCLOSURE	HOFFMAN	CSD363010 OR APPROVED EQUAL	PF
②	1	BACK PANEL	HOFFMAN	CP3630	PF
③	1	LIGHTING KIT	HOFFMAN	ALF16D12R	PF
④	AR	MOUNTING ALUMINUM BRACKETS	SHOP SUPPLY	SHOP SUPPLY	PF
⑤	1	MICROLOGIX 1400 WITH ETHERNET PORT	ALLEN-BRADLEY	1766-L32BXB	PF
⑥	1	1762 AI MODULE	ALLEN-BRADLEY	1762-IF4	PF
⑦	-	-	-	-	-
⑧	-	-	-	-	-
⑨	-	-	-	-	-
⑩	-	-	-	-	-
⑪	-	-	-	-	-
⑫	1	24VDC POWER SUPPLY	PULS	QS10.241	PF
⑬	1	24VDC UPS WITH INTEGRATED BATTERY	PULS	UBC10-241	PF
⑭	2	15A CIRCUIT BREAKER	ALLEN-BRADLEY	1492-SP1C150	PF
⑮	1	SURGE SUPPRESSOR	CONTROL CONCEPT	SLATROL IE-120	PF
⑯	1	DATA INTERFACE PORT	HOFFMAN	HGF5CN	PF
⑰	-	-	-	-	-
⑱	-	-	-	-	-
⑲	3	ELECTROMECHANICAL HOUR METER	REDINGTON	732-0014	PF
⑳	AR	10A CB4200 SERIES CIRCUIT BREAKER	WEIDMULLER	910 190 3500	PF
㉑	AR	0.5A CB4200 SERIES CIRCUIT BREAKER	WEIDMULLER	910 100 3500	PF
㉒	AR	3A CB4200 SERIES CIRCUIT BREAKER	WEIDMULLER	910 170 3500	PF
㉓	AR	2A CB4200 SERIES CIRCUIT BREAKER	WEIDMULLER	910 150 3500	PF
㉔	AR	0.1A CB4200 SERIES CIRCUIT BREAKER	WEIDMULLER	910 417 3500	PF
㉕	AR	FEED THROUGH TERMINAL WDU 2.5 (BEIGE)	WEIDMULLER	-	PF
㉖	AR	FEED THROUGH TERMINAL WDU 2.5 BL (BLUE)	WEIDMULLER	-	PF
㉗	AR	GROUNDING TERMINAL WPE 2.5	WEIDMULLER	-	PF
㉘	AR	END PLATE WAP 2.5-10 (BEIGE)	WEIDMULLER	-	PF
㉙	AR	END PLATE WAP 2.5-10 BL (BLUE)	WEIDMULLER	-	PF
㉚	AR	PARTITION WTW EN (DARK BEIGE)	WEIDMULLER	-	PF
㉛	AR	END BRACKET WEW 35/2 (DARK BEIGE)	WEIDMULLER	-	PF
㉜	AR	ZINC PLATED YELLOW-CHROMATE STEEL T-35 DIN RAIL	SHOP SUPPLY	SHOP SUPPLY	PF
㉝	AR	1.5" W X 3" D WIREWAY W/ COVER	PANDUIT	F1.5X3LG6 & C1.5LG6	PF
㉞	AR	2" W X 3" D WIREWAY W/ COVER	PANDUIT	F2X3LG6 & C2LG6	PF
㉟	AR	3" W X 3" D WIREWAY W/ COVER	PANDUIT	F3X3LG6 & C3LG6	PF
㊱	1	8 PORT NETWORK SWITCH	SIXNET	SLX-8MS	PF
㊲	1	6FT CAT6 PATCH CABLE	SHOP SUPPLY	SHOP SUPPLY	PF
㊳	2	GROUND BUS	SHOP SUPPLY	SHOP SUPPLY	PF
㊴	-	-	-	-	-
㊵	-	-	-	-	-
㊶	1	LONG RANGE IP/ETHERNET RADIO	GE MDS	TO BE DETERMINED BY CITY STAFF	PF
㊷	4	LOUVER WITH FILTER	HOFFMAN	AVK44 / AFLT44	PF
㊸	1	4-POLE ICE CUBE RELAY / SOCKET	ALLEN-BRADLEY	700-HF34Z24-4 / 700-HN139	PF
㊹	5	2-POLE ICE CUBE RELAY / SOCKET	ALLEN-BRADLEY	700-HF32Z24-4 / 700-HN116	PF


NOTE: ALL MATERIALS SHOWN ARE THE MINIMUM REQUIREMENTS AND SHALL BE REVIEWED AND APPROVED BY THE CITY OF BEND DURING PRELIMINARY DESIGN

PF = PANEL FABRICATOR
COB = CITY OF BEND

NAMEPLATE SCHEDULE				
NAMEPLATE	LINE	NAMEPLATE	PLATE SIZE	LETTERING SIZE
①	1	LIFT STATION XX LOCAL CONTROL PANEL		1/2"
	2	WXXX-ICP-XXXB	4" X 10"	1"
	-	-	-	-
②	1	120VAC POWER FROM PANELS	3" X 6"	1/4"
	2	XXXXXX & XXXXXX		1/4"
	3			
③	1	PUMP 1 RTM	1/2" X 1"	3/16"
	-	-	-	-
	-	-	-	-
④	1	PUMP 2 RTM	1/2" X 1"	3/16"
	-	-	-	-
	-	-	-	-
⑤	1	PUMP 3 RTM	1/2" X 1"	3/16"
	-	-	-	-
	-	-	-	-
⑥	1	PORTABLE PROGRAMMING TERMINAL POWER ONLY	1" X 3"	3/16"
	2			3/16"
	3			3/16"

STAMP
[ENGINEERS]

(PROJECT NAME)
CNTRL PNL TYPE B TEMPLATE
(50 I/Os) BILL OF MATERIALS

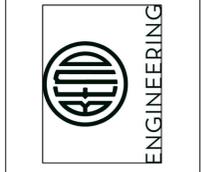

REVISIONS:


[COMPANY NAME]
[COMPANY ADDRESS AND PHONE NUMBER]

DESIGNED BY: _____
DRAWN BY: _____
SCALE: _____
FILE: _____
DATE: _____

VERIFY SCALES
0 1"
BAR EQUALS ONE INCH ON ORIGINAL DRAWING

SHEET:
I-003
COB # (XXXXXX)

FOR SAMPLE ONLY
RECORD DRAWINGS
REVISIONS DRAWN BY: XX DATE: XX/XX/XX
THESE RECORD DRAWINGS HAVE BEEN PREPARED, IN PART, ON THE BASIS OF INFORMATION COMPILED BY OTHERS. THEY ARE NOT INTENDED TO REPRESENT IN DETAIL THE EXACT LOCATION, TYPE OF COMPONENT NOR MANNER OF CONSTRUCTION. THE ENGINEER WILL NOT BE RESPONSIBLE FOR ANY ERRORS OR OMISSIONS WHICH HAVE BEEN INCORPORATED INTO THE RECORD DRAWINGS.

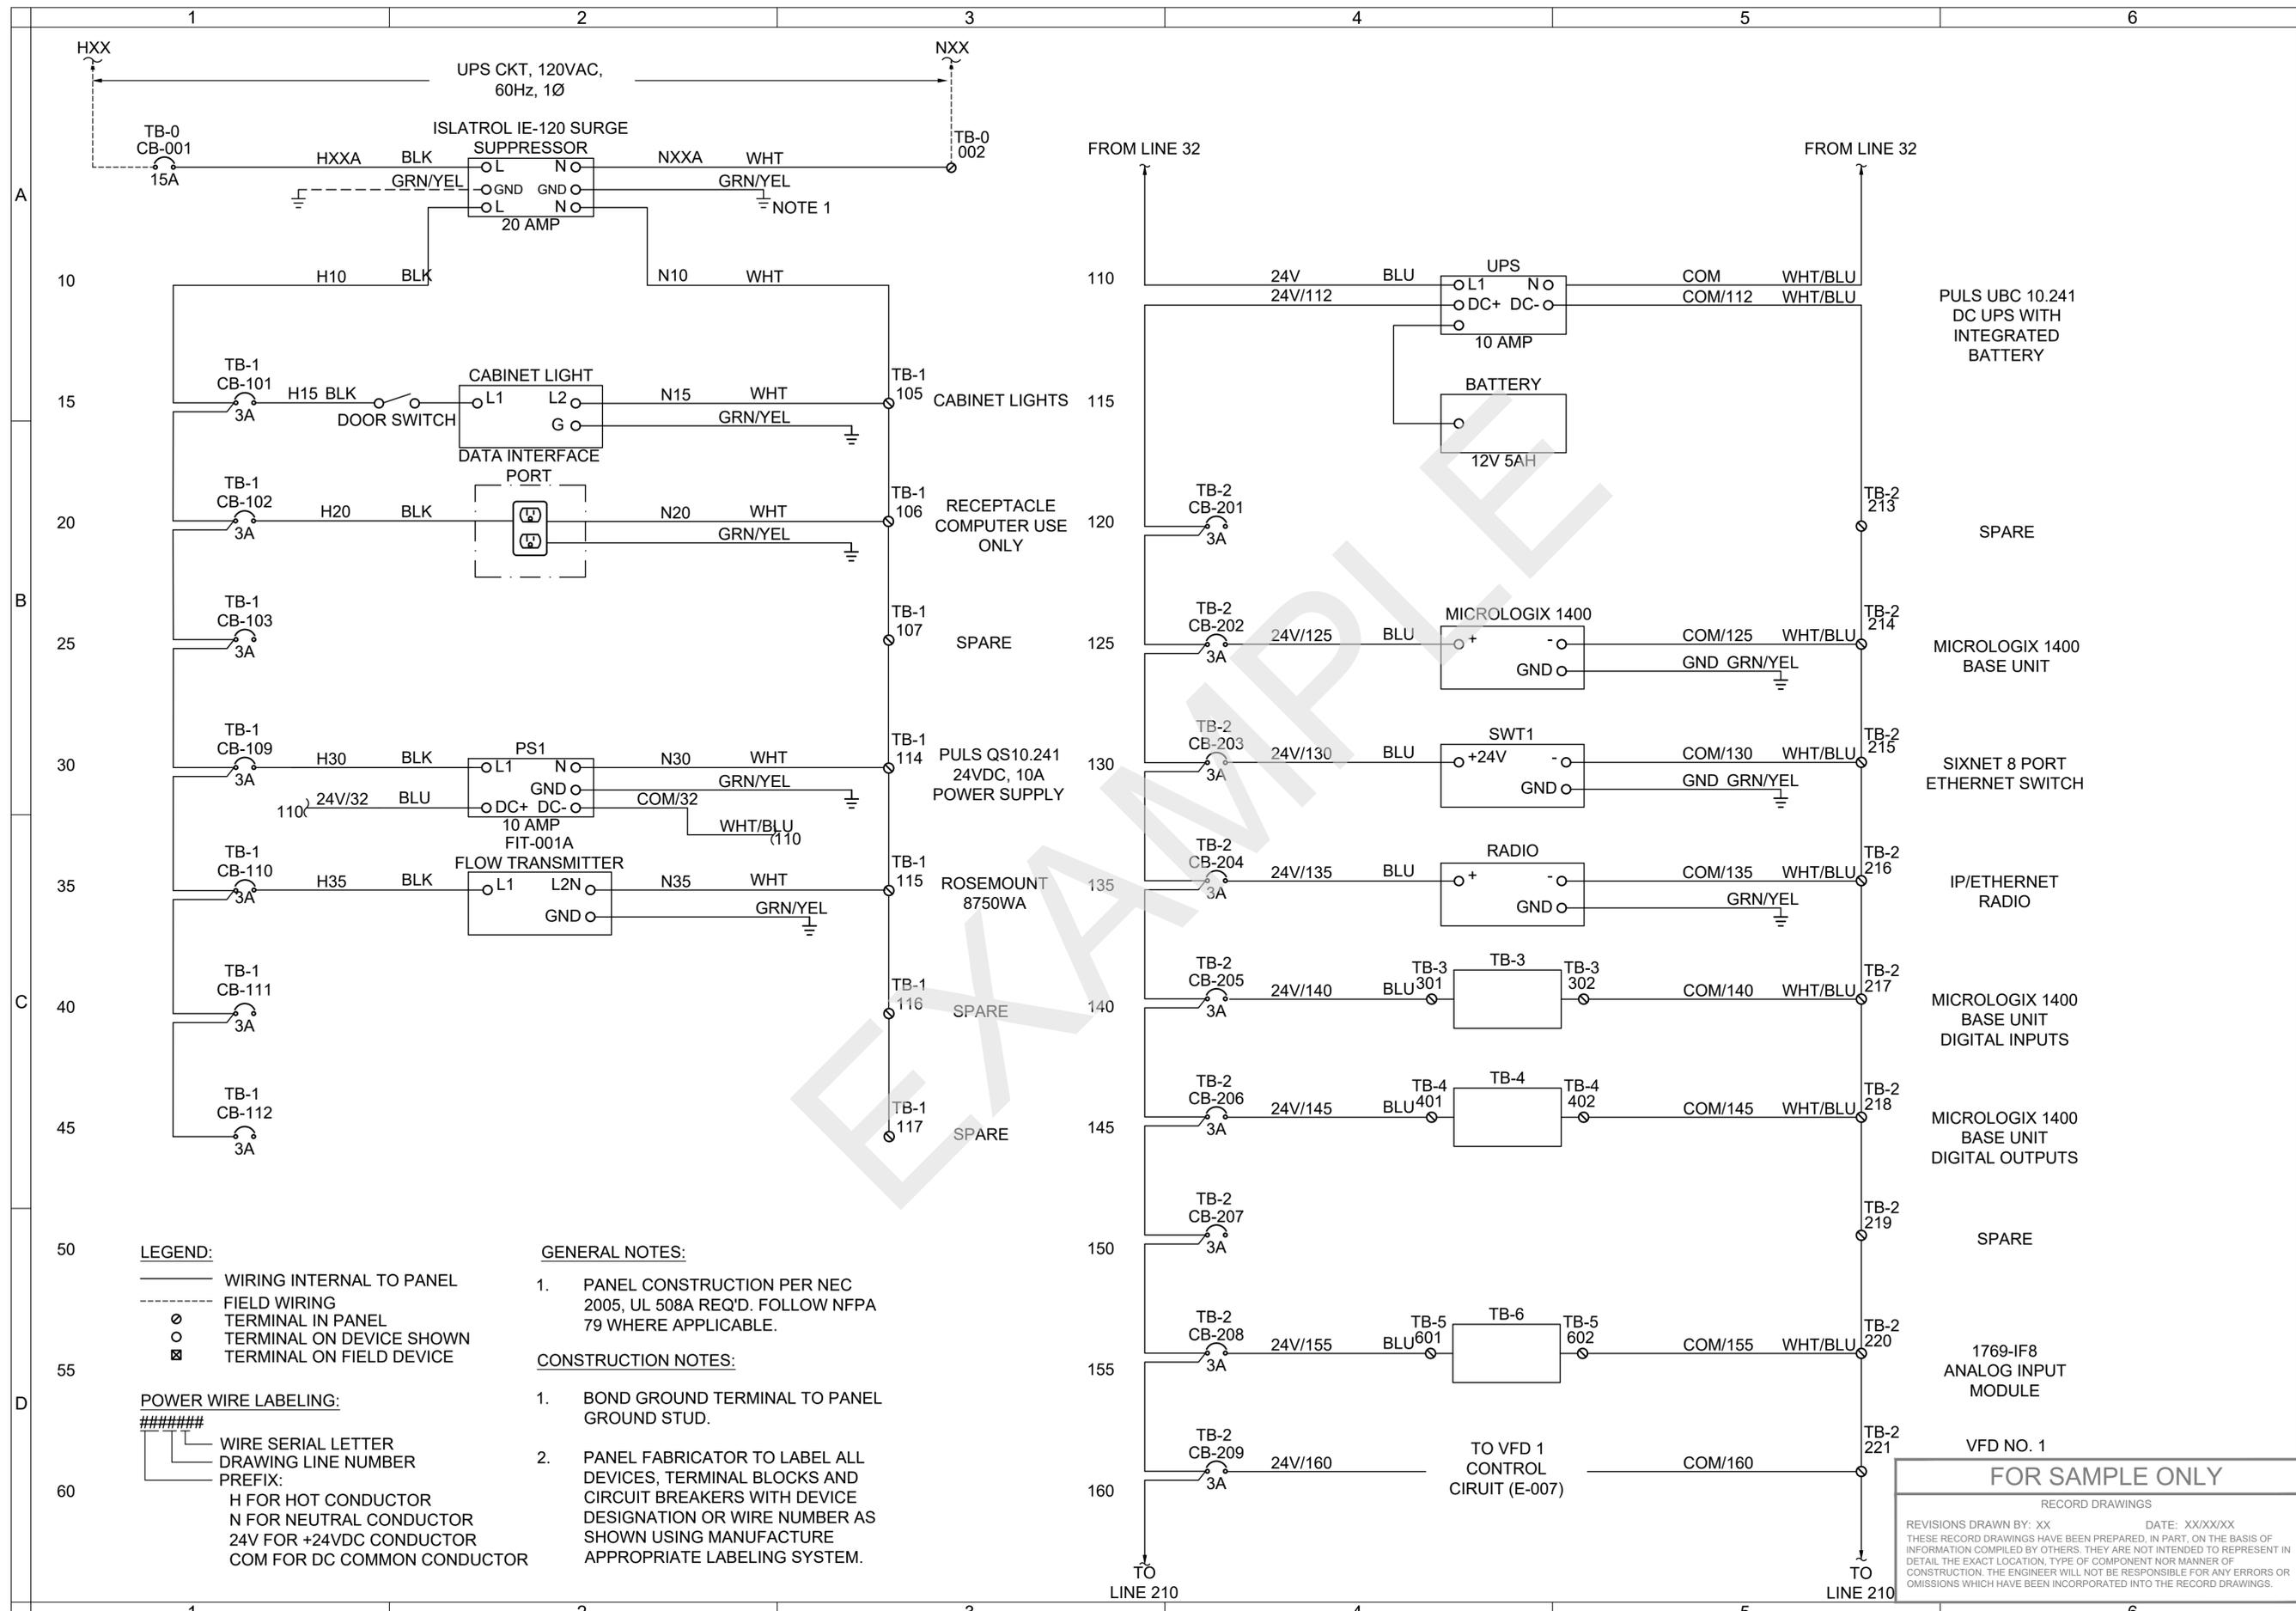

(PROJECT NAME)

CNTRL PNL TYPE B TEMPLATE
(50 I/Os) PWR WIRING SCHEMATIC

DESCHUTES COUNTY, OREGON

STAMP
[ENGINEERS]

REVISIONS:

DESIGNED BY:	VERIFIED BY:
DRAWN BY:	SCALE:
FILE:	DATE:

[COMPANY NAME]
[COMPANY ADDRESS AND PHONE NUMBER]


0 1" BAR EQUALS ONE INCH ON ORIGINAL DRAWING

SHEET: **I-004**

RECORD DRAWINGS

DESIGNED BY: XX DATE: XXXX/XX
THESE RECORD DRAWINGS HAVE BEEN PREPARED, IN PART, ON THE BASIS OF INFORMATION COMPILED BY OTHERS. THEY ARE NOT INTENDED TO REPRESENT IN DETAIL THE EXACT LOCATION, TYPE OF COMPONENT NOR MANNER OF CONSTRUCTION. THE ENGINEER WILL NOT BE RESPONSIBLE FOR ANY ERRORS OR OMISSIONS WHICH HAVE BEEN INCORPORATED INTO THE RECORD DRAWINGS.

COB # (XXXXXX)

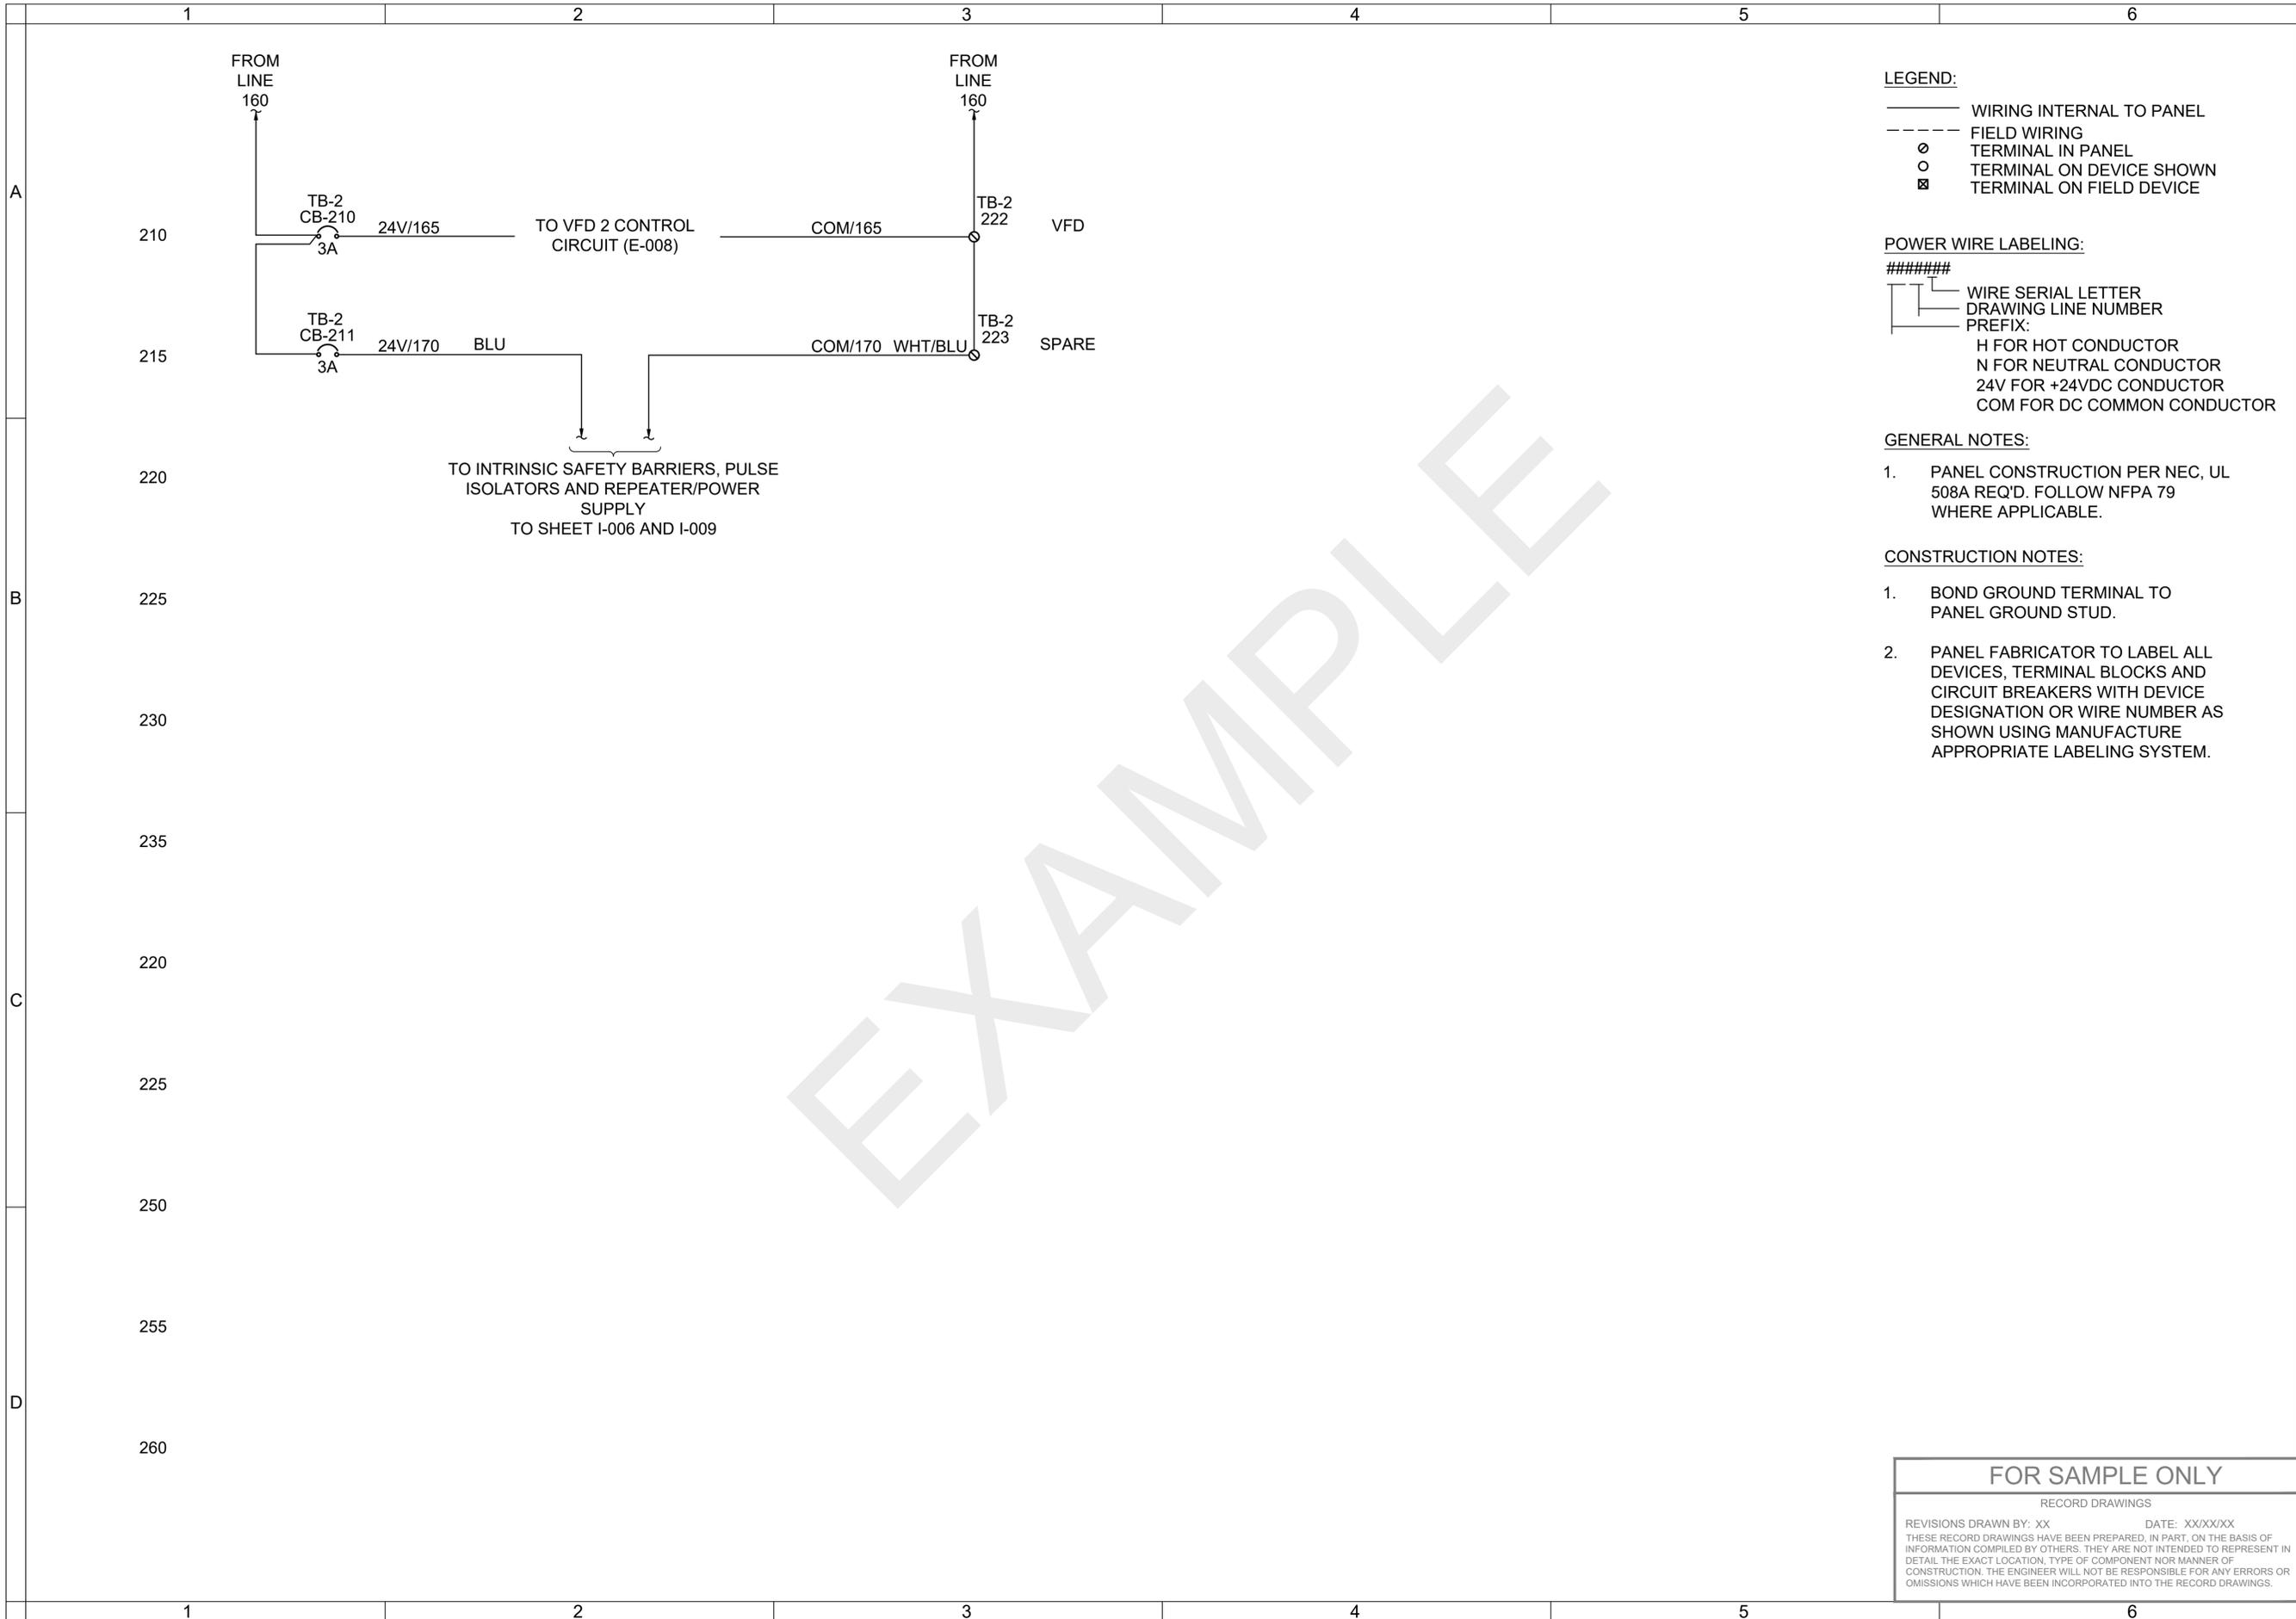

LEGEND:

—— WIRING INTERNAL TO PANEL

- - - - FIELD WIRING

○ TERMINAL IN PANEL

○ TERMINAL ON DEVICE SHOWN

⊠ TERMINAL ON FIELD DEVICE

POWER WIRE LABELING:

#####

WIRE SERIAL LETTER
DRAWING LINE NUMBER
PREFIX:
H FOR HOT CONDUCTOR
N FOR NEUTRAL CONDUCTOR
24V FOR +24VDC CONDUCTOR
COM FOR DC COMMON CONDUCTOR

GENERAL NOTES:


- PANEL CONSTRUCTION PER NEC, UL 508A REQ'D. FOLLOW NFPA 79 WHERE APPLICABLE.

CONSTRUCTION NOTES:

- BOND GROUND TERMINAL TO PANEL GROUND STUD.
- PANEL FABRICATOR TO LABEL ALL DEVICES, TERMINAL BLOCKS AND CIRCUIT BREAKERS WITH DEVICE DESIGNATION OR WIRE NUMBER AS SHOWN USING MANUFACTURE APPROPRIATE LABELING SYSTEM.

STAMP
[ENGINEERS]


(PROJECT NAME)
CNTRL PNL TYPE B TEMPLATE
(50 I/Os) PWR WIRING SCHEMATIC
DESCHUTES COUNTY, OREGON

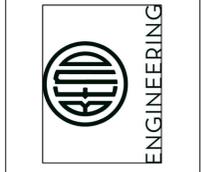

REVISIONS:

[COMPANY NAME]
[COMPANY ADDRESS AND PHONE NUMBER]

DESIGNED BY: _____
DRAWN BY: _____
SCALE: _____
FILE: _____
DATE: _____

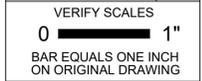


SHEET:
I-005
COB # (XXXXXX)

FOR SAMPLE ONLY

RECORD DRAWINGS

REVISIONS DRAWN BY: XX DATE: XX/XX/XX

THESE RECORD DRAWINGS HAVE BEEN PREPARED, IN PART, ON THE BASIS OF INFORMATION COMPILED BY OTHERS. THEY ARE NOT INTENDED TO REPRESENT IN DETAIL THE EXACT LOCATION, TYPE OF COMPONENT NOR MANNER OF CONSTRUCTION. THE ENGINEER WILL NOT BE RESPONSIBLE FOR ANY ERRORS OR OMISSIONS WHICH HAVE BEEN INCORPORATED INTO THE RECORD DRAWINGS.

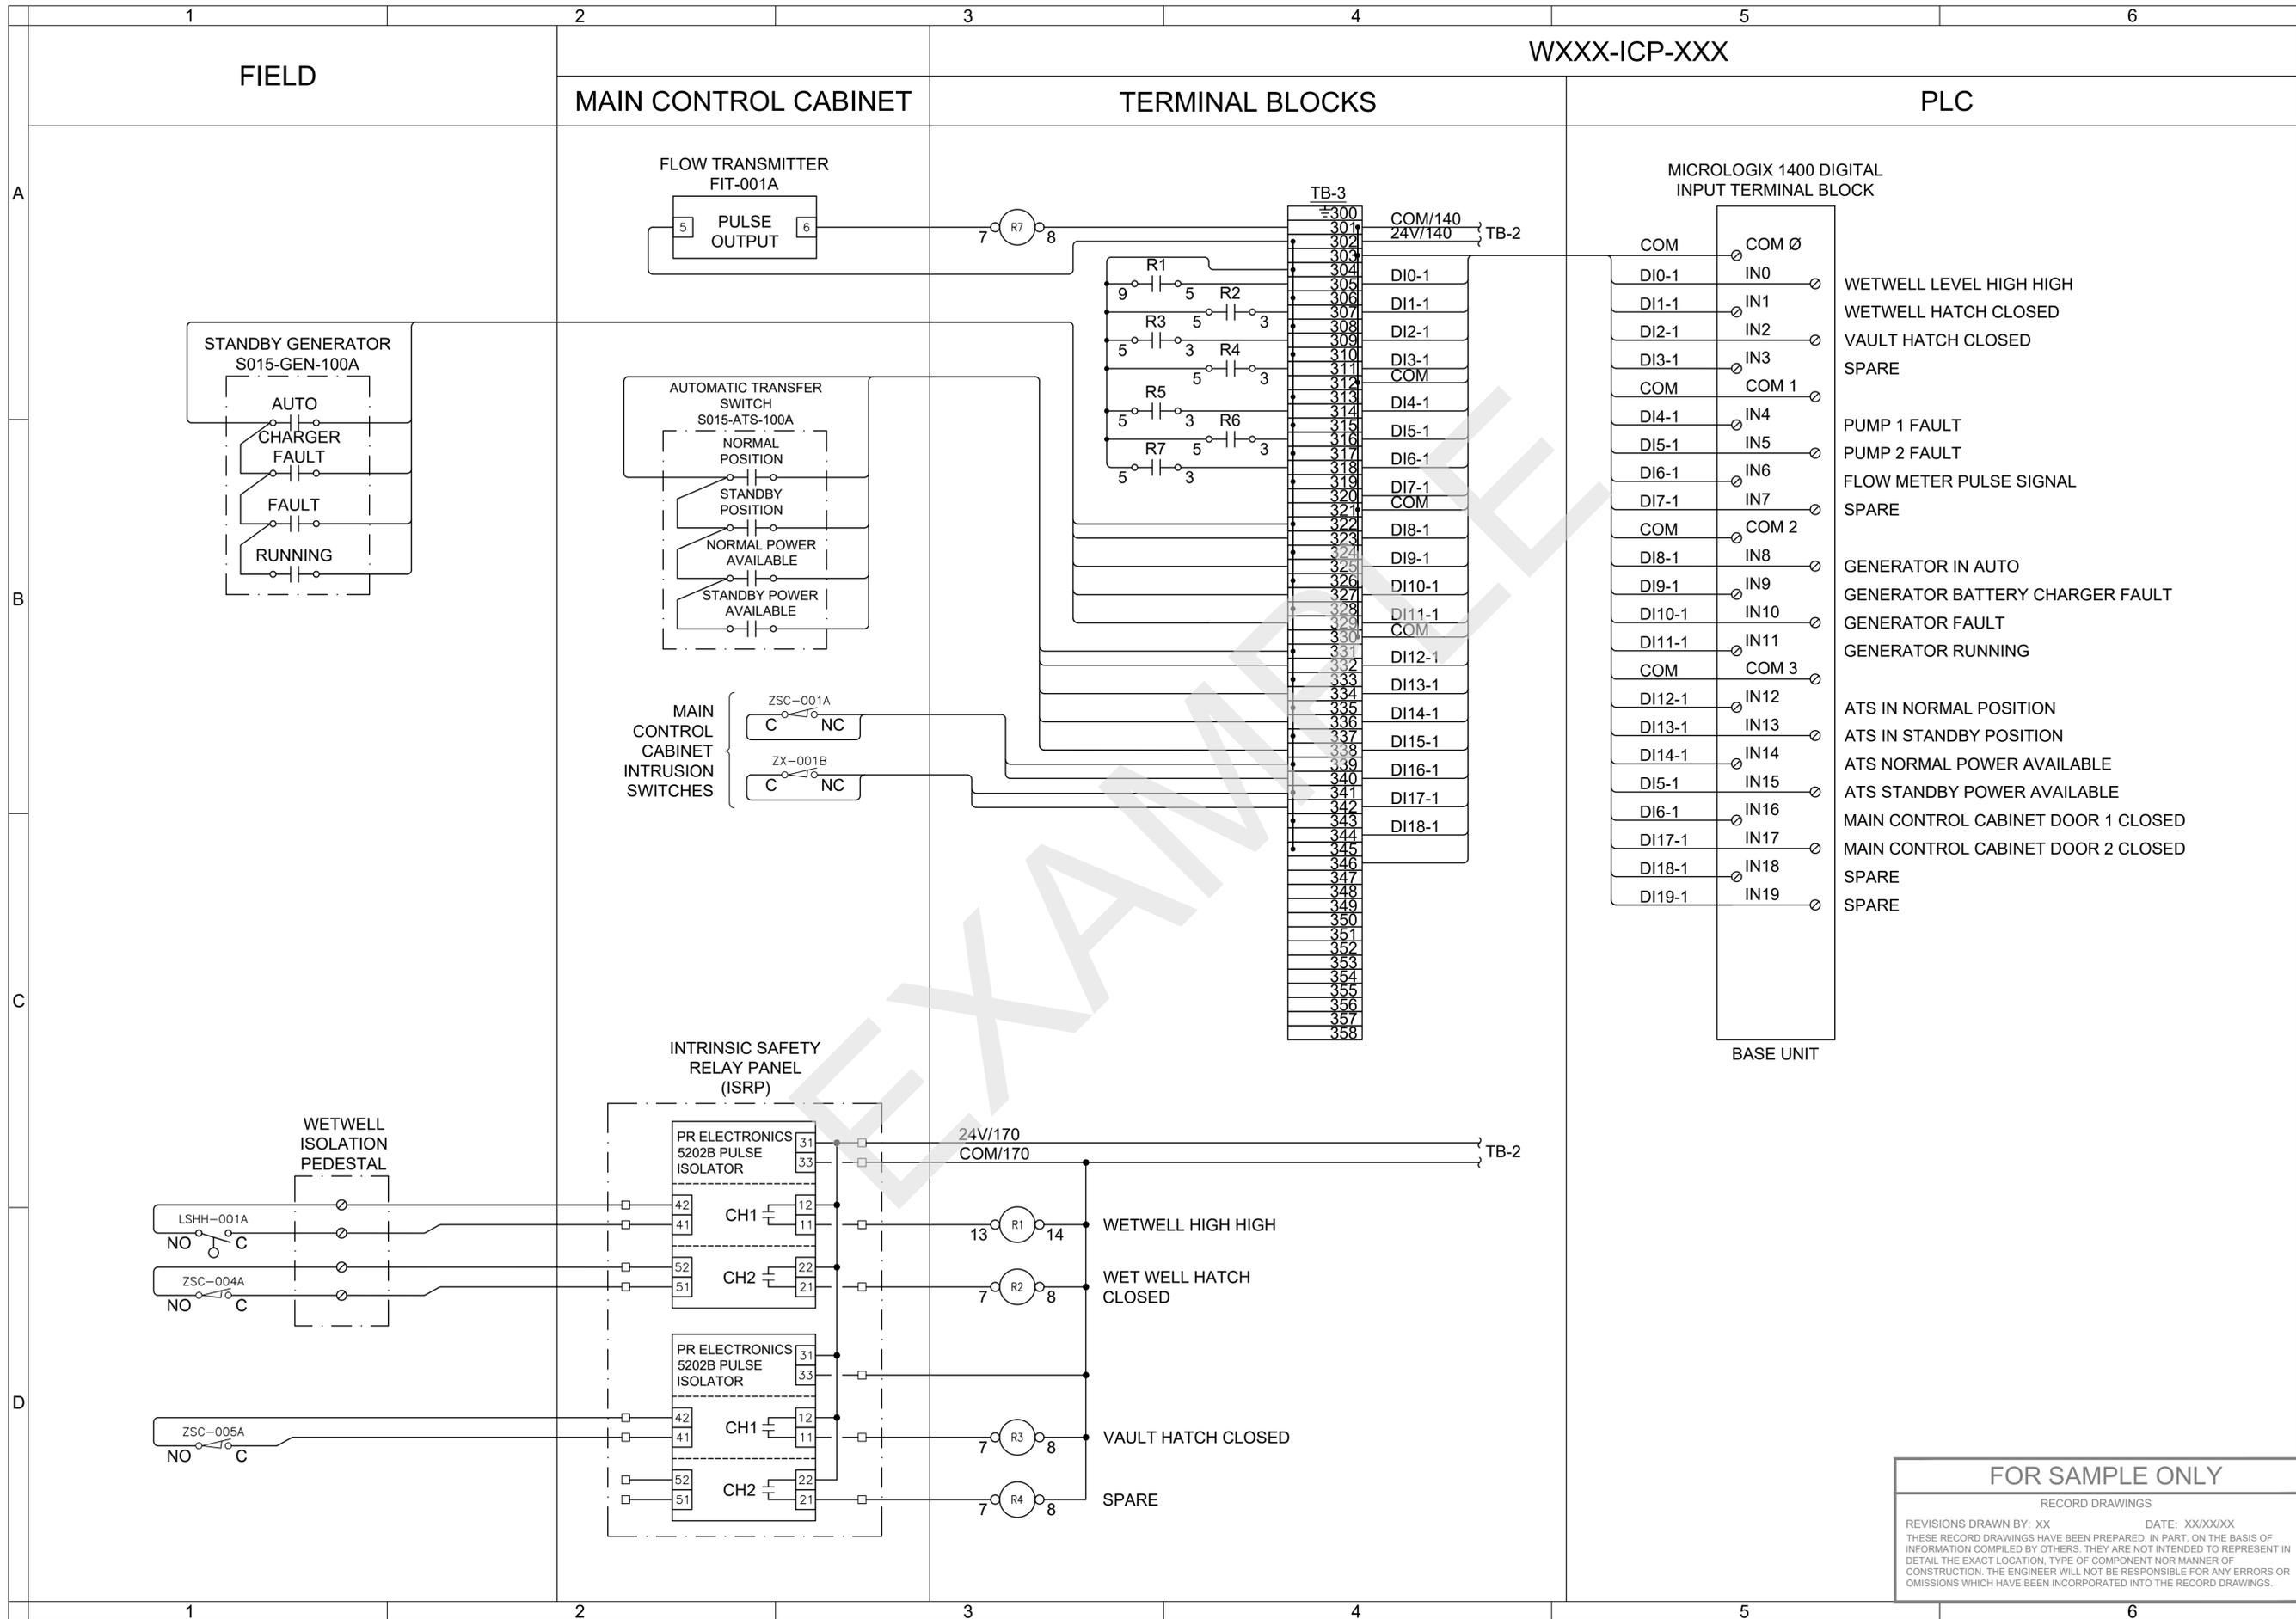

(PROJECT NAME)

CNTRL PNL TYPE B TEMPLATE

(50 I/Os) DIGITAL INPUT MODULE 1

DESCHUTES COUNTY, OREGON

ENGINEERING

DESIGNED BY: _____
 DRAWN BY: _____
 SCALE: _____
 FILE: _____
 DATE: _____

VERIFY SCALES
 0 1"
 BAR EQUALS ONE INCH ON ORIGINAL DRAWING


SHEET: **I-006**

COB # (XXXXXX)

FOR SAMPLE ONLY


RECORD DRAWINGS

REVISIONS DRAWN BY: XX DATE: XXXX/XX
 THESE RECORD DRAWINGS HAVE BEEN PREPARED, IN PART, ON THE BASIS OF INFORMATION COMPILED BY OTHERS. THEY ARE NOT INTENDED TO REPRESENT IN DETAIL THE EXACT LOCATION, TYPE OF COMPONENT NOR MANNER OF CONSTRUCTION. THE ENGINEER WILL NOT BE RESPONSIBLE FOR ANY ERRORS OR OMISSIONS WHICH HAVE BEEN INCORPORATED INTO THE RECORD DRAWINGS.

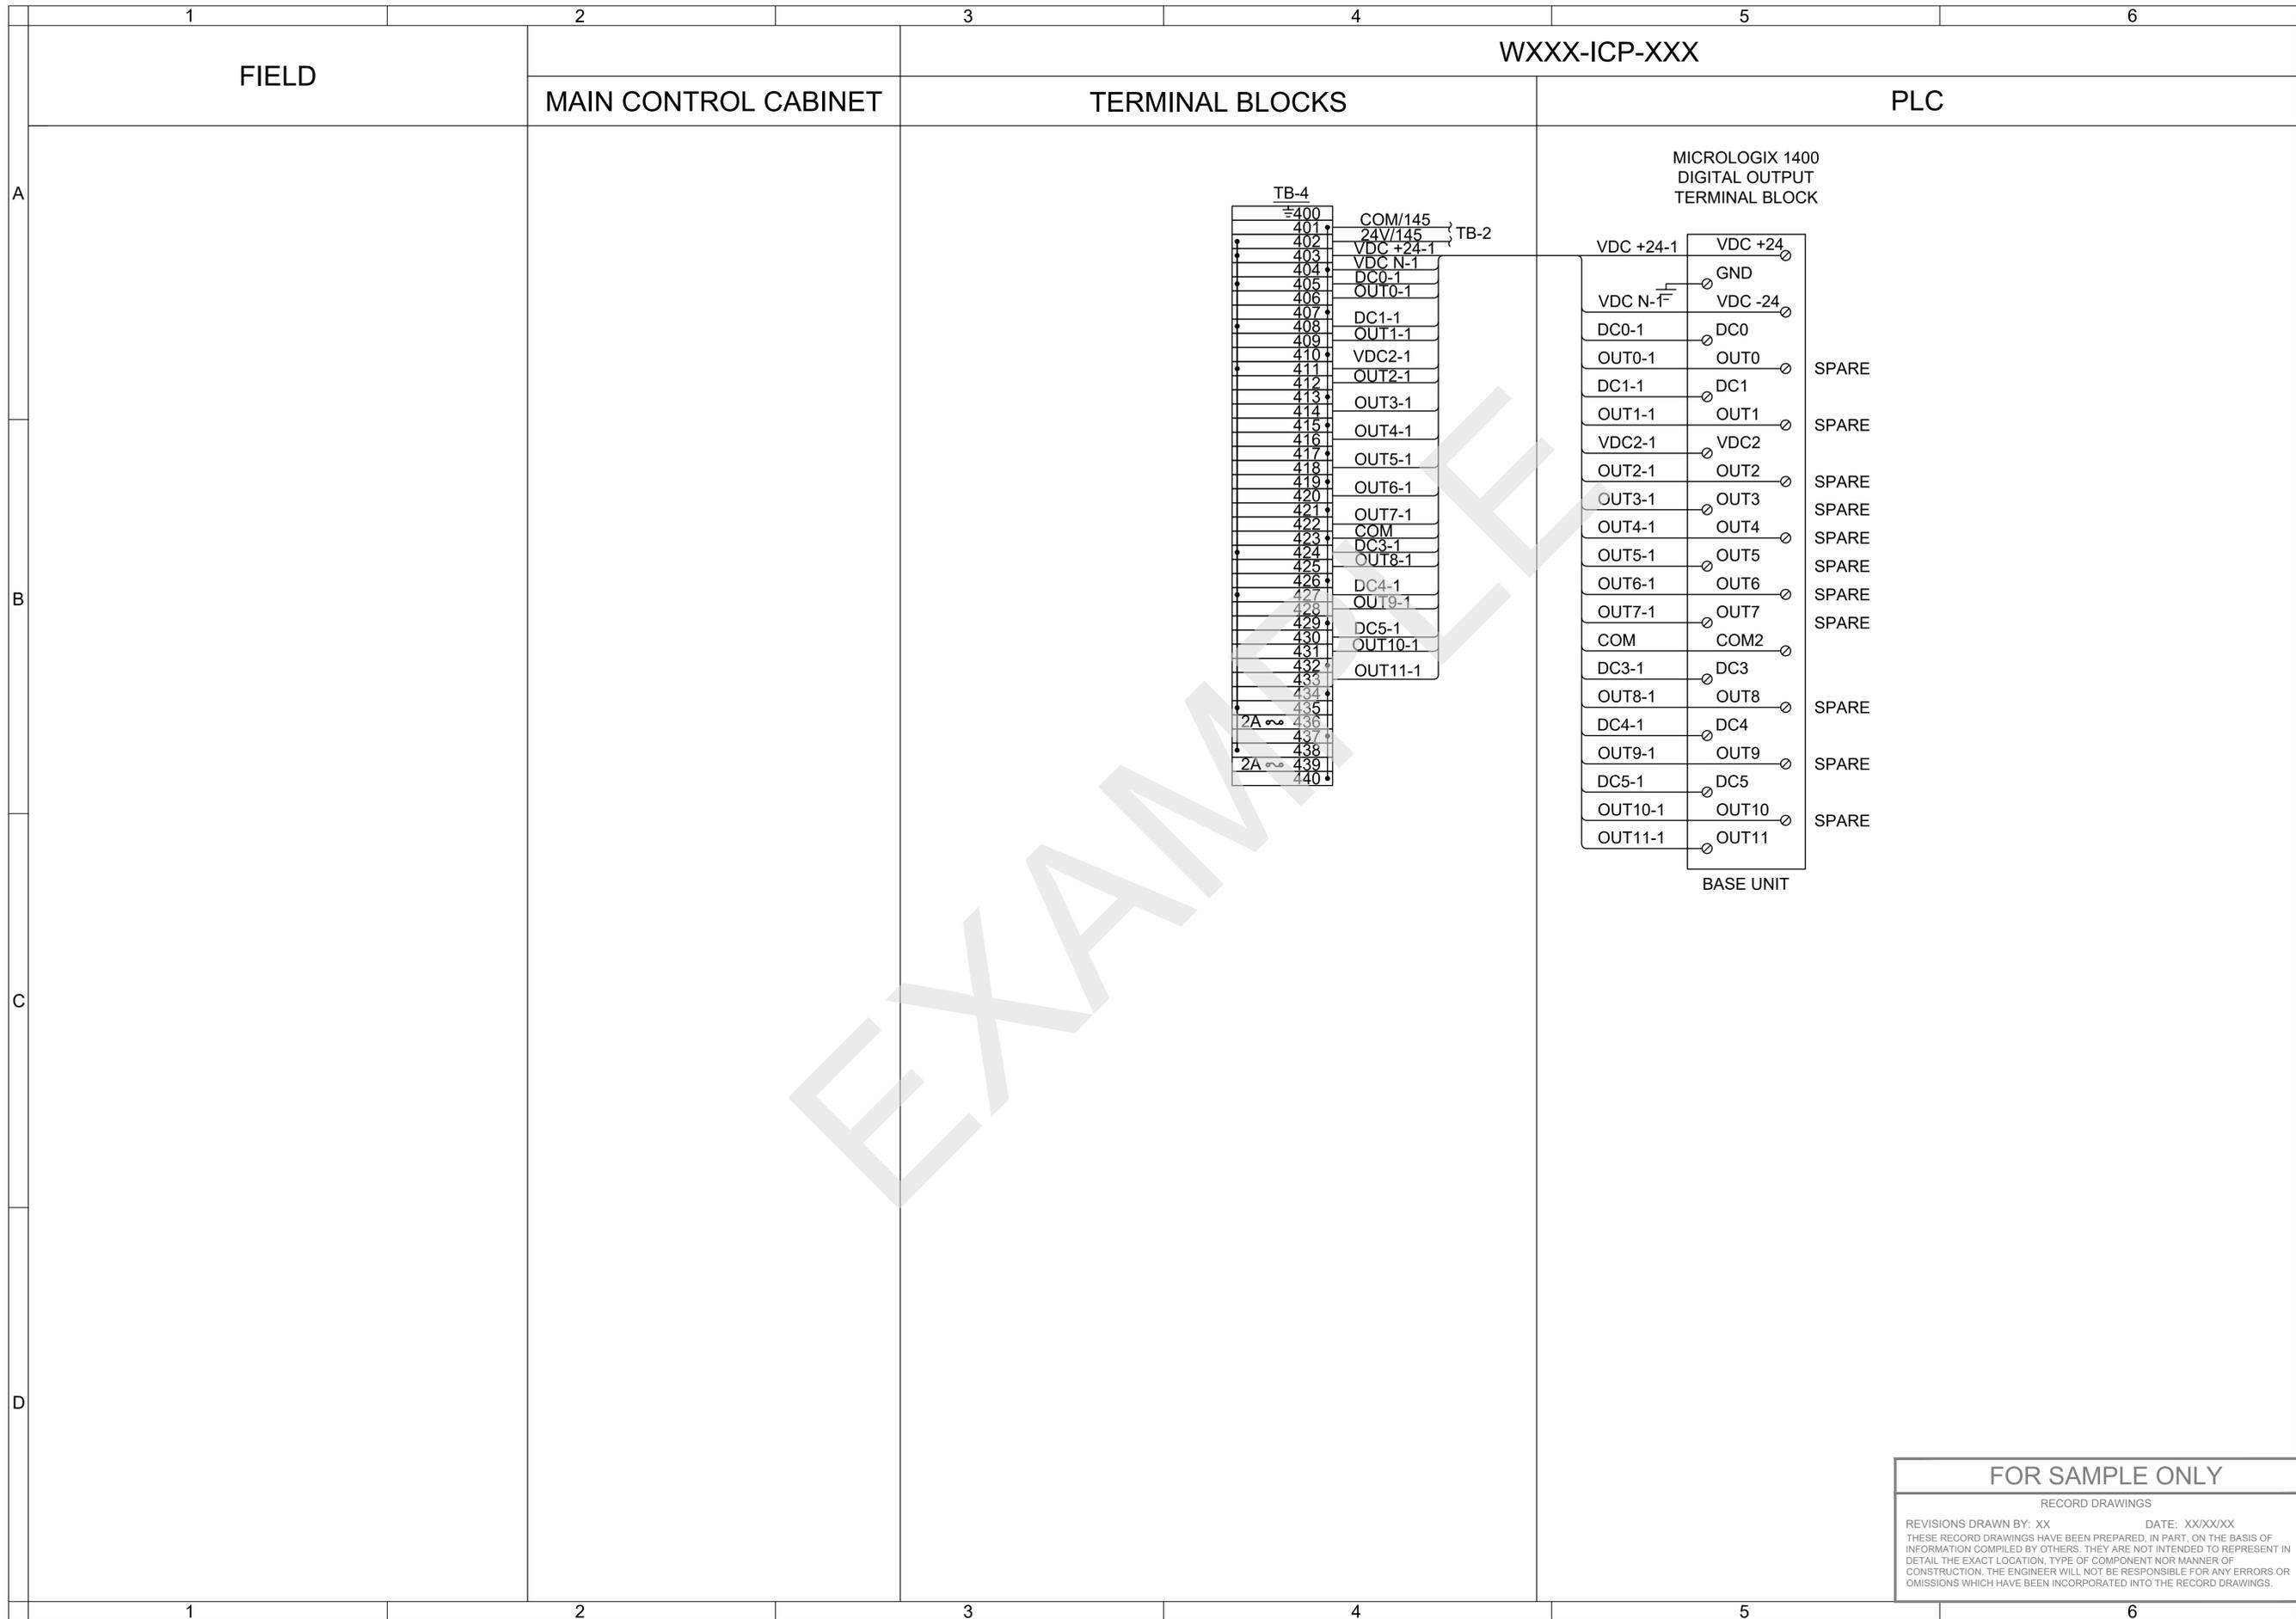

STAMP
[ENGINEERS]

(PROJECT NAME)
 CNTRL PNL TYPE B TEMPLATE
 (50 I/Os) DIGITAL INPUT MODULE 2

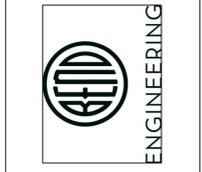

REVISIONS:


[COMPANY NAME]
 [COMPANY ADDRESS AND PHONE NUMBER]

DESIGNED BY: _____
 DRAWN BY: _____
 SCALE: _____
 FILE: _____
 DATE: _____

VERIFY SCALES
 0 1"
 BAR EQUALS ONE INCH ON ORIGINAL DRAWING


SHEET:
I-007
 COB # (XXXXXX)

FOR SAMPLE ONLY
 RECORD DRAWINGS
 THESE RECORD DRAWINGS HAVE BEEN PREPARED, IN PART, ON THE BASIS OF INFORMATION COMPILED BY OTHERS. THEY ARE NOT INTENDED TO REPRESENT IN DETAIL THE EXACT LOCATION, TYPE OF COMPONENT NOR MANNER OF CONSTRUCTION. THE ENGINEER WILL NOT BE RESPONSIBLE FOR ANY ERRORS OR OMISSIONS WHICH HAVE BEEN INCORPORATED INTO THE RECORD DRAWINGS.

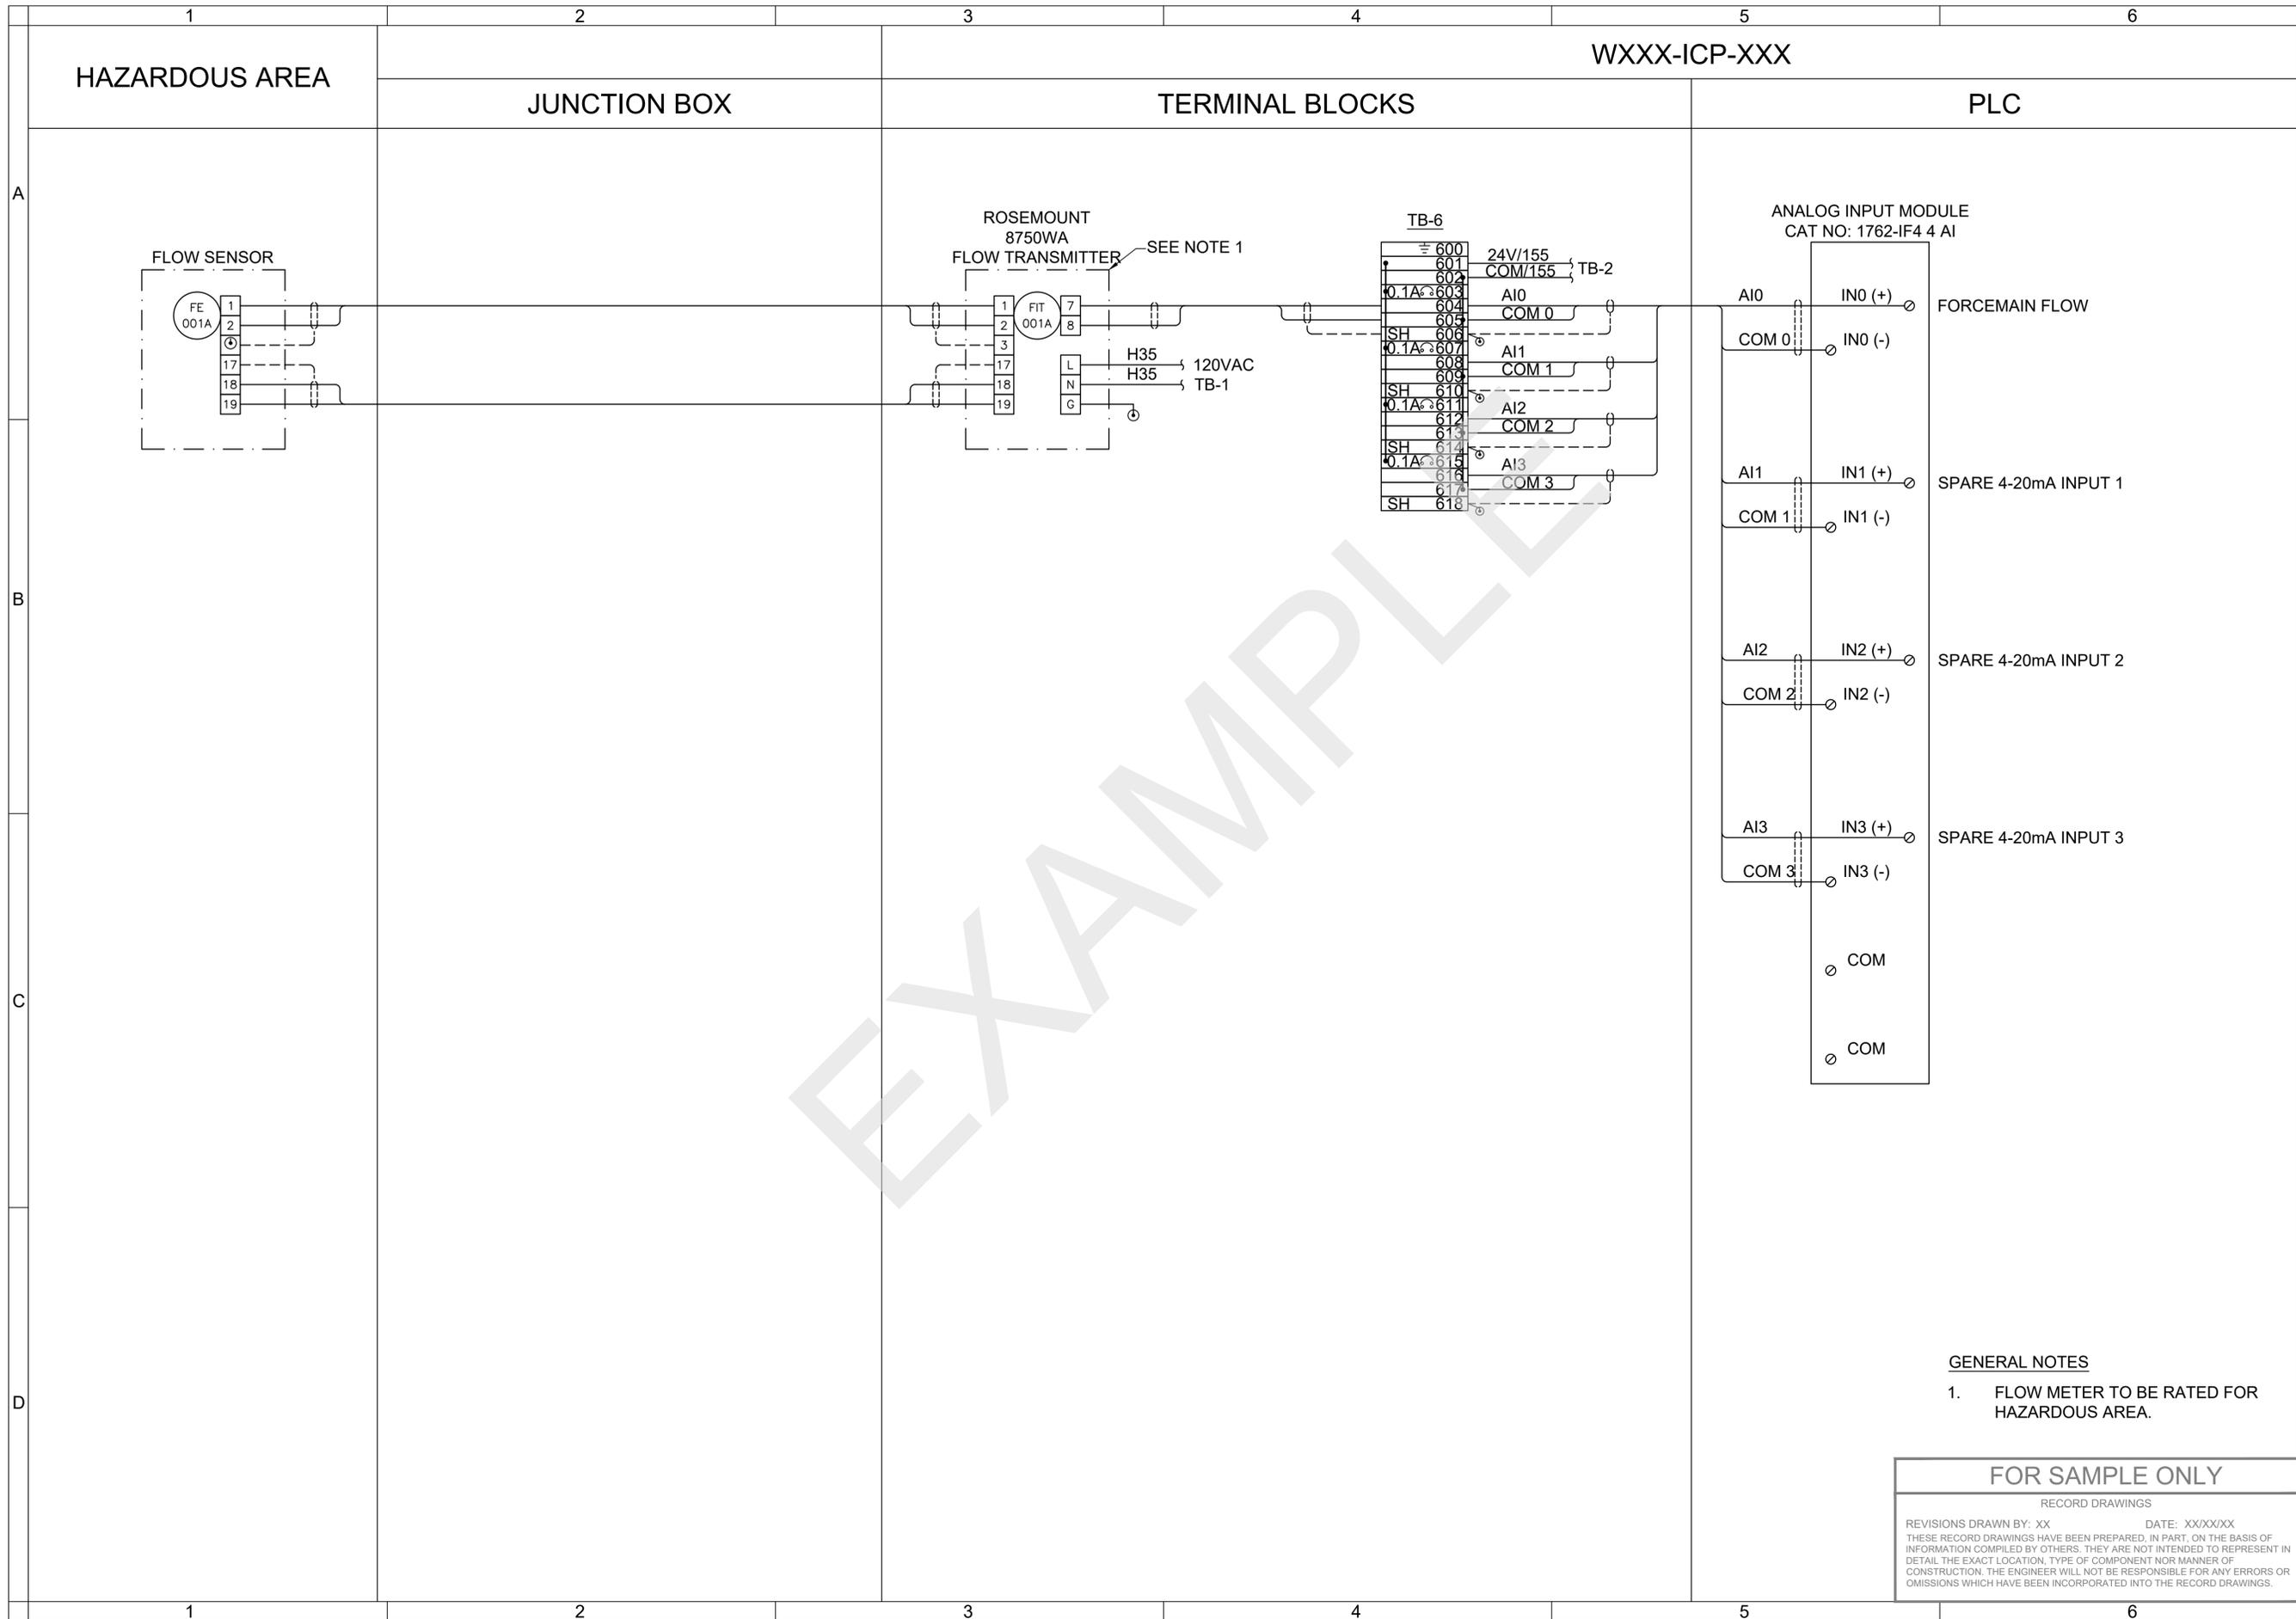

STAMP
[ENGINEERS]

(PROJECT NAME)
CNTRL PNL TYPE B TEMPLATE
(50 I/Os) ANALOG INPUT MODULE

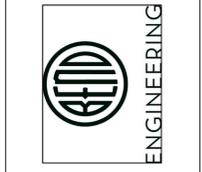

REVISIONS:

[COMPANY NAME]
[COMPANY ADDRESS AND PHONE NUMBER]


DESIGNED BY: _____
DRAWN BY: _____
SCALE: _____
FILE: _____
DATE: _____

VERIFY SCALES
0 1"
BAR EQUALS ONE INCH ON ORIGINAL DRAWING

SHEET:
1-008
COB # (XXXXXX)

GENERAL NOTES
1. FLOW METER TO BE RATED FOR HAZARDOUS AREA.

FOR SAMPLE ONLY
RECORD DRAWINGS
REVISIONS DRAWN BY: XX DATE: XX/XX/XX
THESE RECORD DRAWINGS HAVE BEEN PREPARED, IN PART, ON THE BASIS OF INFORMATION COMPILED BY OTHERS. THEY ARE NOT INTENDED TO REPRESENT IN DETAIL THE EXACT LOCATION, TYPE OF COMPONENT NOR MANNER OF CONSTRUCTION. THE ENGINEER WILL NOT BE RESPONSIBLE FOR ANY ERRORS OR OMISSIONS WHICH HAVE BEEN INCORPORATED INTO THE RECORD DRAWINGS.

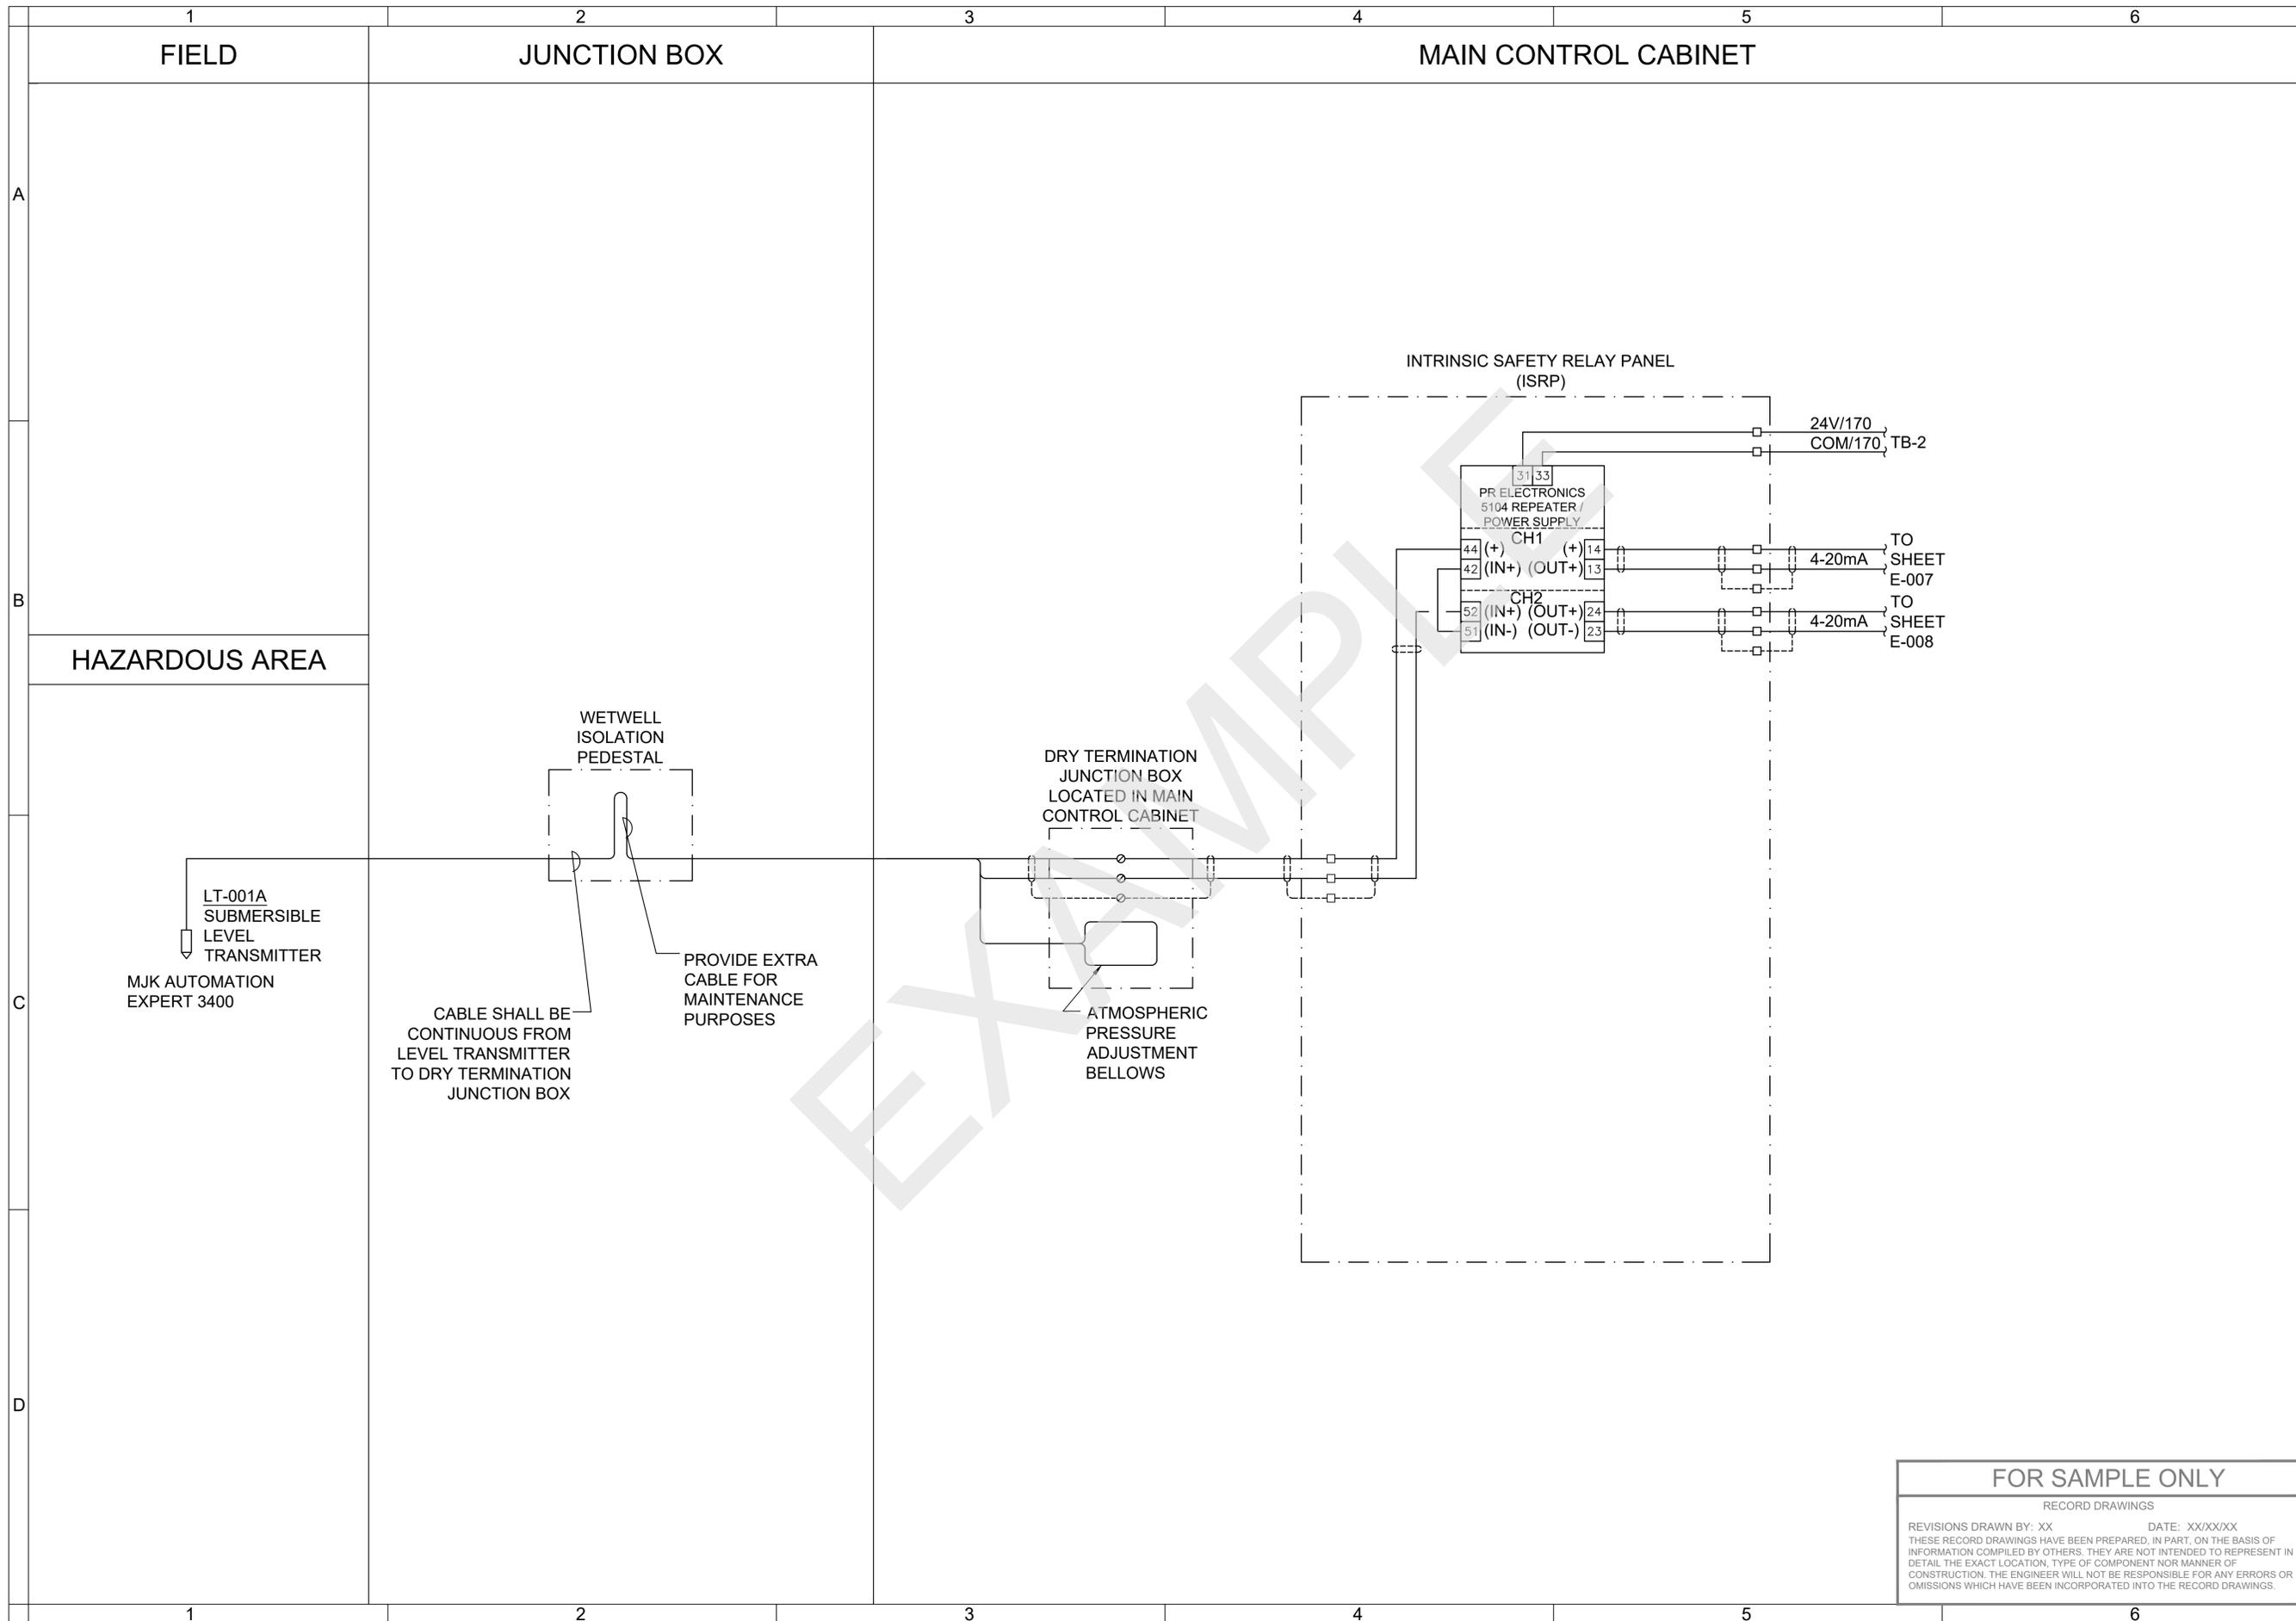

STAMP
[ENGINEERS]

(PROJECT NAME)
INSTRUMENTATION & CONTROLS
INTRINSIC SAFETY RELAY PANEL (ISRP)
DESCHUTES COUNTY, OREGON

ENGINEERING

REVISIONS:

DESIGNED BY: _____
DRAWN BY: _____
SCALE: _____
FILE: _____
DATE: _____

VERIFY SCALES
0 1"
BAR EQUALS ONE INCH ON ORIGINAL DRAWING

SHEET: **I-009**


COB # (XXXXXX)

FOR SAMPLE ONLY

RECORD DRAWINGS

REVISIONS DRAWN BY: XX DATE: XX/XX/XX

THESE RECORD DRAWINGS HAVE BEEN PREPARED, IN PART, ON THE BASIS OF INFORMATION COMPILED BY OTHERS. THEY ARE NOT INTENDED TO REPRESENT IN DETAIL THE EXACT LOCATION, TYPE OF COMPONENT NOR MANNER OF CONSTRUCTION. THE ENGINEER WILL NOT BE RESPONSIBLE FOR ANY ERRORS OR OMISSIONS WHICH HAVE BEEN INCORPORATED INTO THE RECORD DRAWINGS.

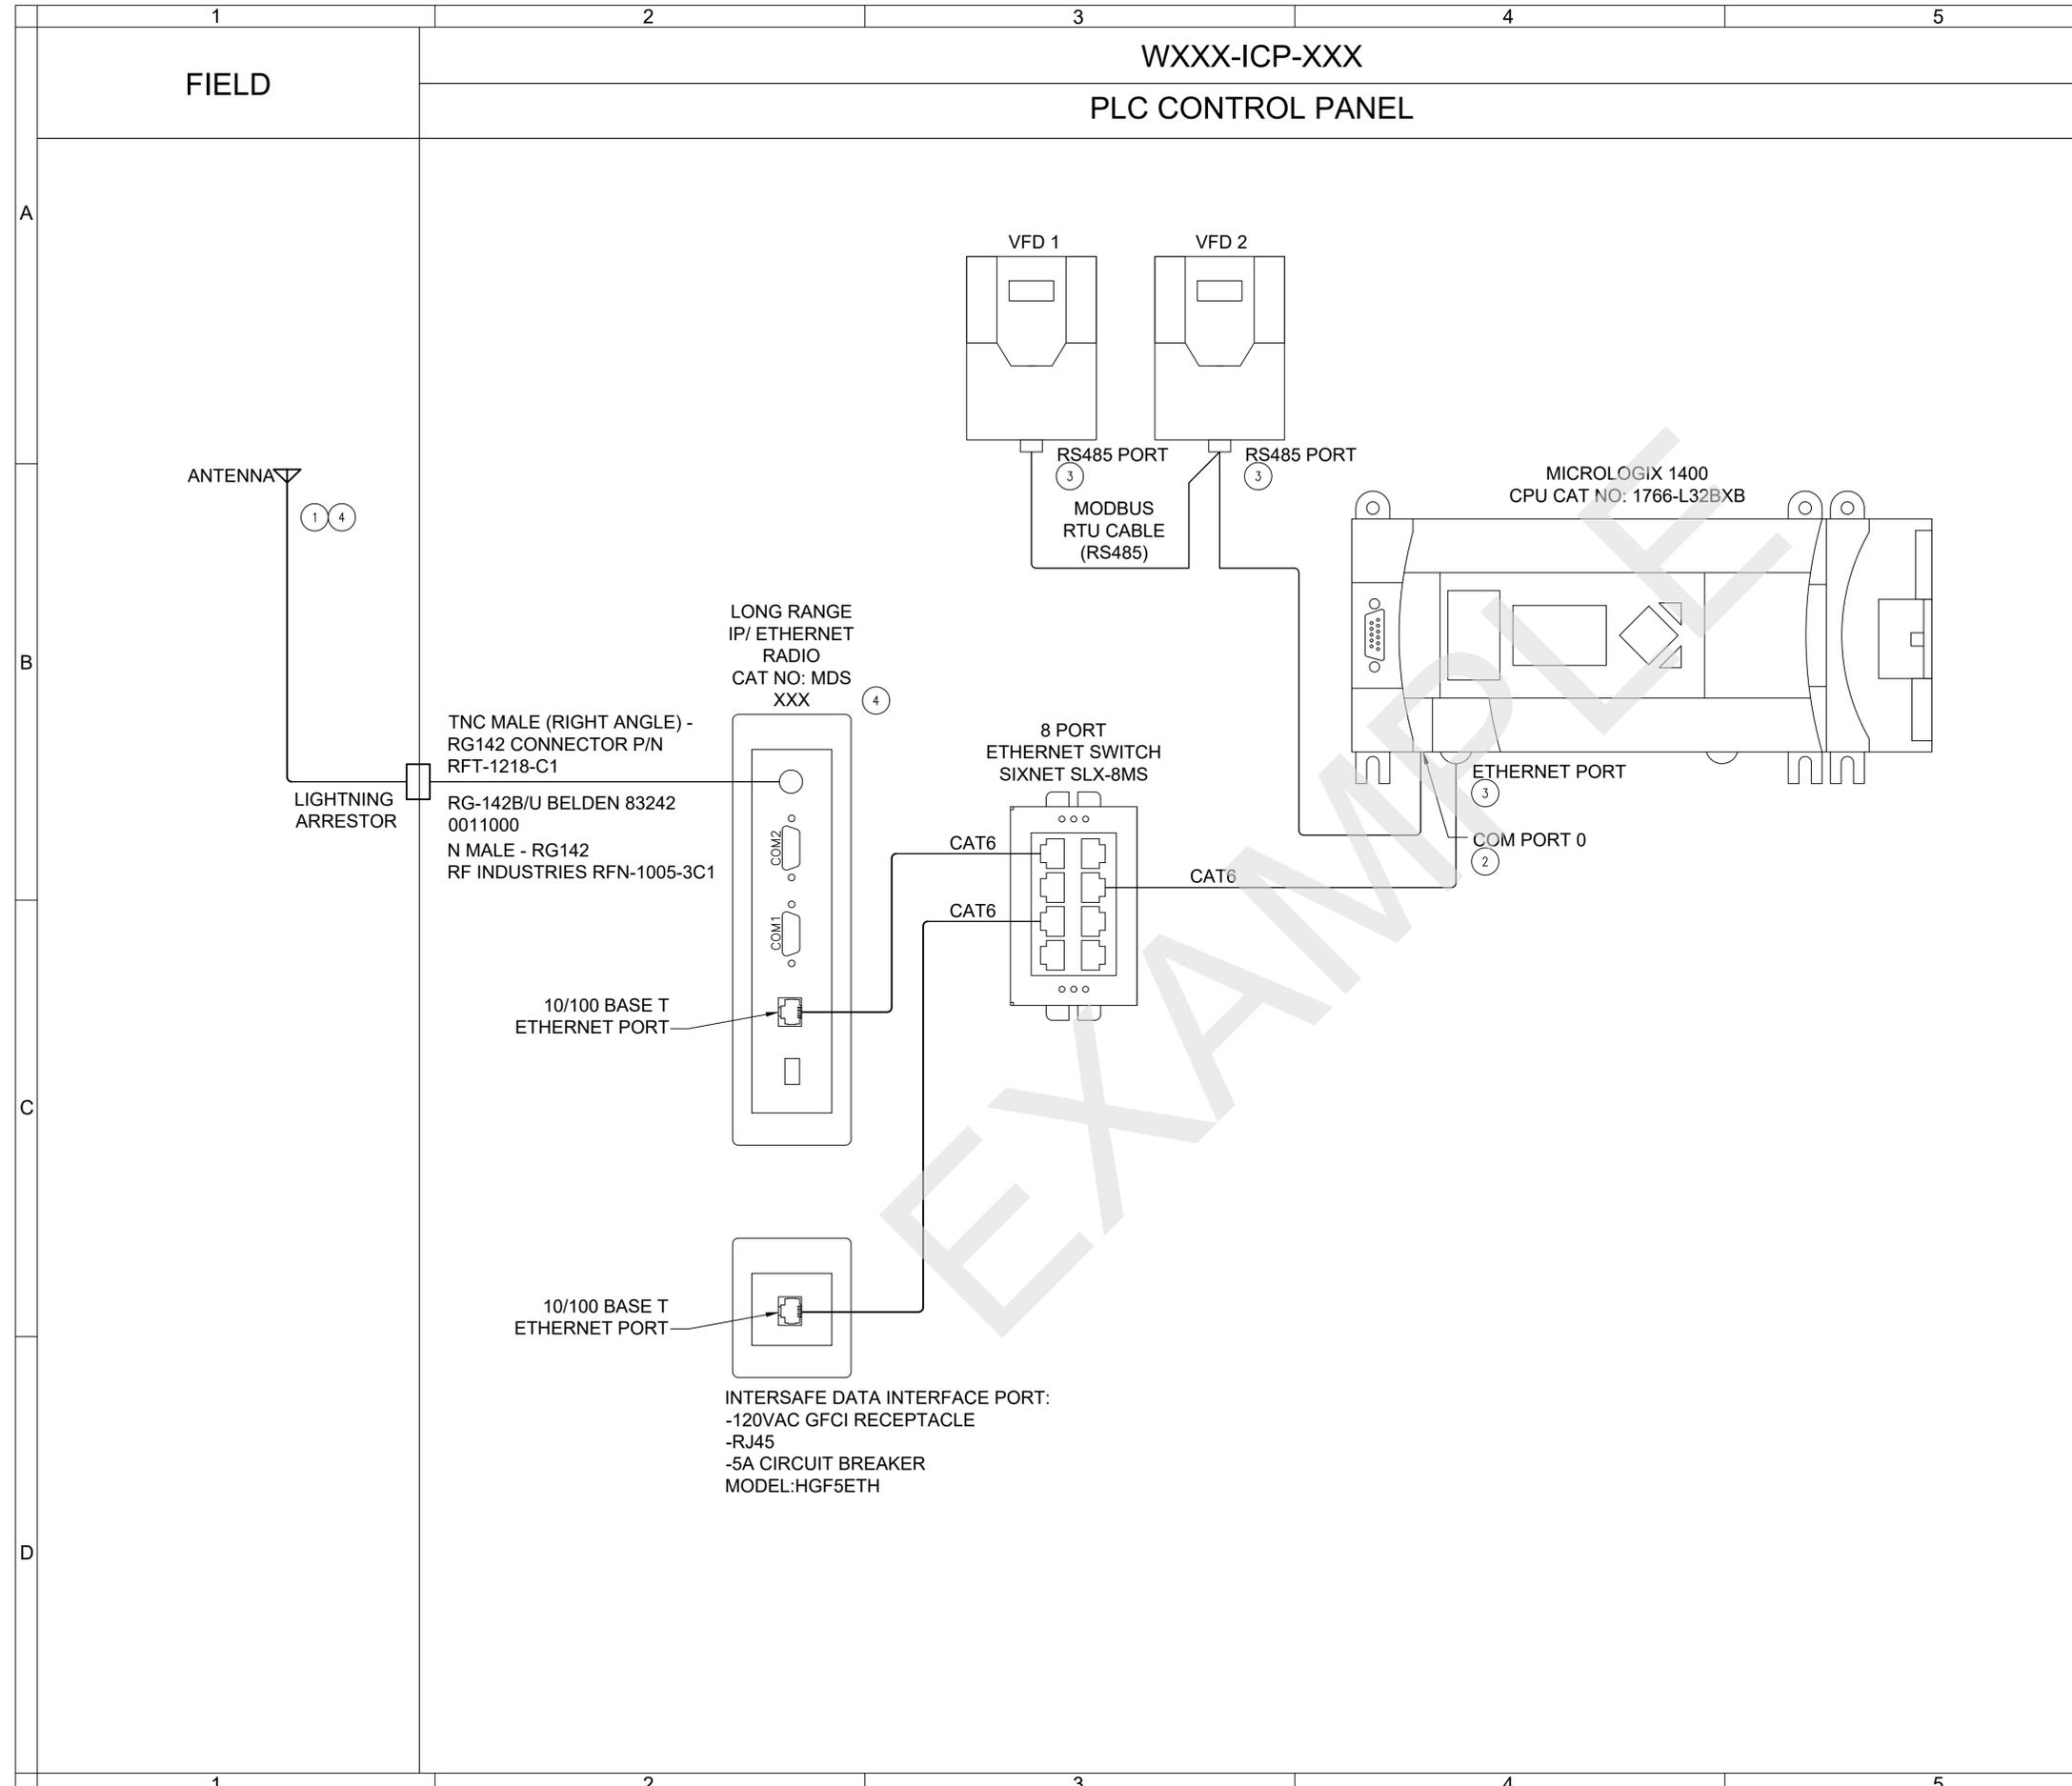


LEGEND:
 — COMMUNICATION WIRING

- GENERAL NOTES:**
- PANEL FABRICATOR TO PROVIDE AND INSTALL ALL CABLES AS SHOWN ON DIAGRAM.
 - FOR DRAWING INDEX, SEE DRAWING X-XXX.
 - FOR GENERAL NOTES, ABBREVIATIONS, AND SYMBOL LEGENDS, SEE DRAWINGS X-XXX.

- KEY NOTES:**
- PULL ANTENNA GROUND WIRE IN MAST WITH ANTENNA COAX CABLE. TERMINATE ANTENNA GROUND ON MAIN CONTROL CABINET GROUND BUS.
 - 8-PIN MINI DIN RS-232C/RS-485 CONNECTOR.
 - RJ485 CONNECTOR. COMMUNICATIONS CABLE INTERCONNECTIONS SHALL BE AS REQUIRED TO MEET MANUFACTURER REQUIREMENTS.
 - RADIO MAKE, MODEL, ANTENNA TYPE, AND ANTENNA CABLES TO BE DETERMINED BY CITY STAFF AND IS DEPENDENT ON SITE CONDITIONS AND LOCATION.

STAMP
 [ENGINEERS]

(PROJECT NAME)
CONTROL PANEL
 COMMUNICATION NETWORK DIAGRAM
 DESCHUTES COUNTY, OREGON

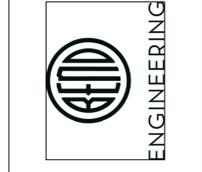

REVISIONS:



[COMPANY NAME]
 [COMPANY ADDRESS AND PHONE NUMBER]

DESIGNED BY: _____
 DRAWN BY: _____
 SCALE: _____
 FILE: _____
 DATE: _____

VERIFY SCALES
 0 1"
 BAR EQUALS ONE INCH ON ORIGINAL DRAWING

SHEET:
I-010
 COB# (XXXXXX)

FOR SAMPLE ONLY
 RECORD DRAWINGS
 THESE RECORD DRAWINGS HAVE BEEN PREPARED, IN PART, ON THE BASIS OF INFORMATION COMPILED BY OTHERS. THEY ARE NOT INTENDED TO REPRESENT IN DETAIL THE EXACT LOCATION, TYPE OF COMPONENT NOR MANNER OF CONSTRUCTION. THE ENGINEER WILL NOT BE RESPONSIBLE FOR ANY ERRORS OR OMISSIONS WHICH HAVE BEEN INCORPORATED INTO THE RECORD DRAWINGS.

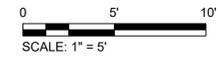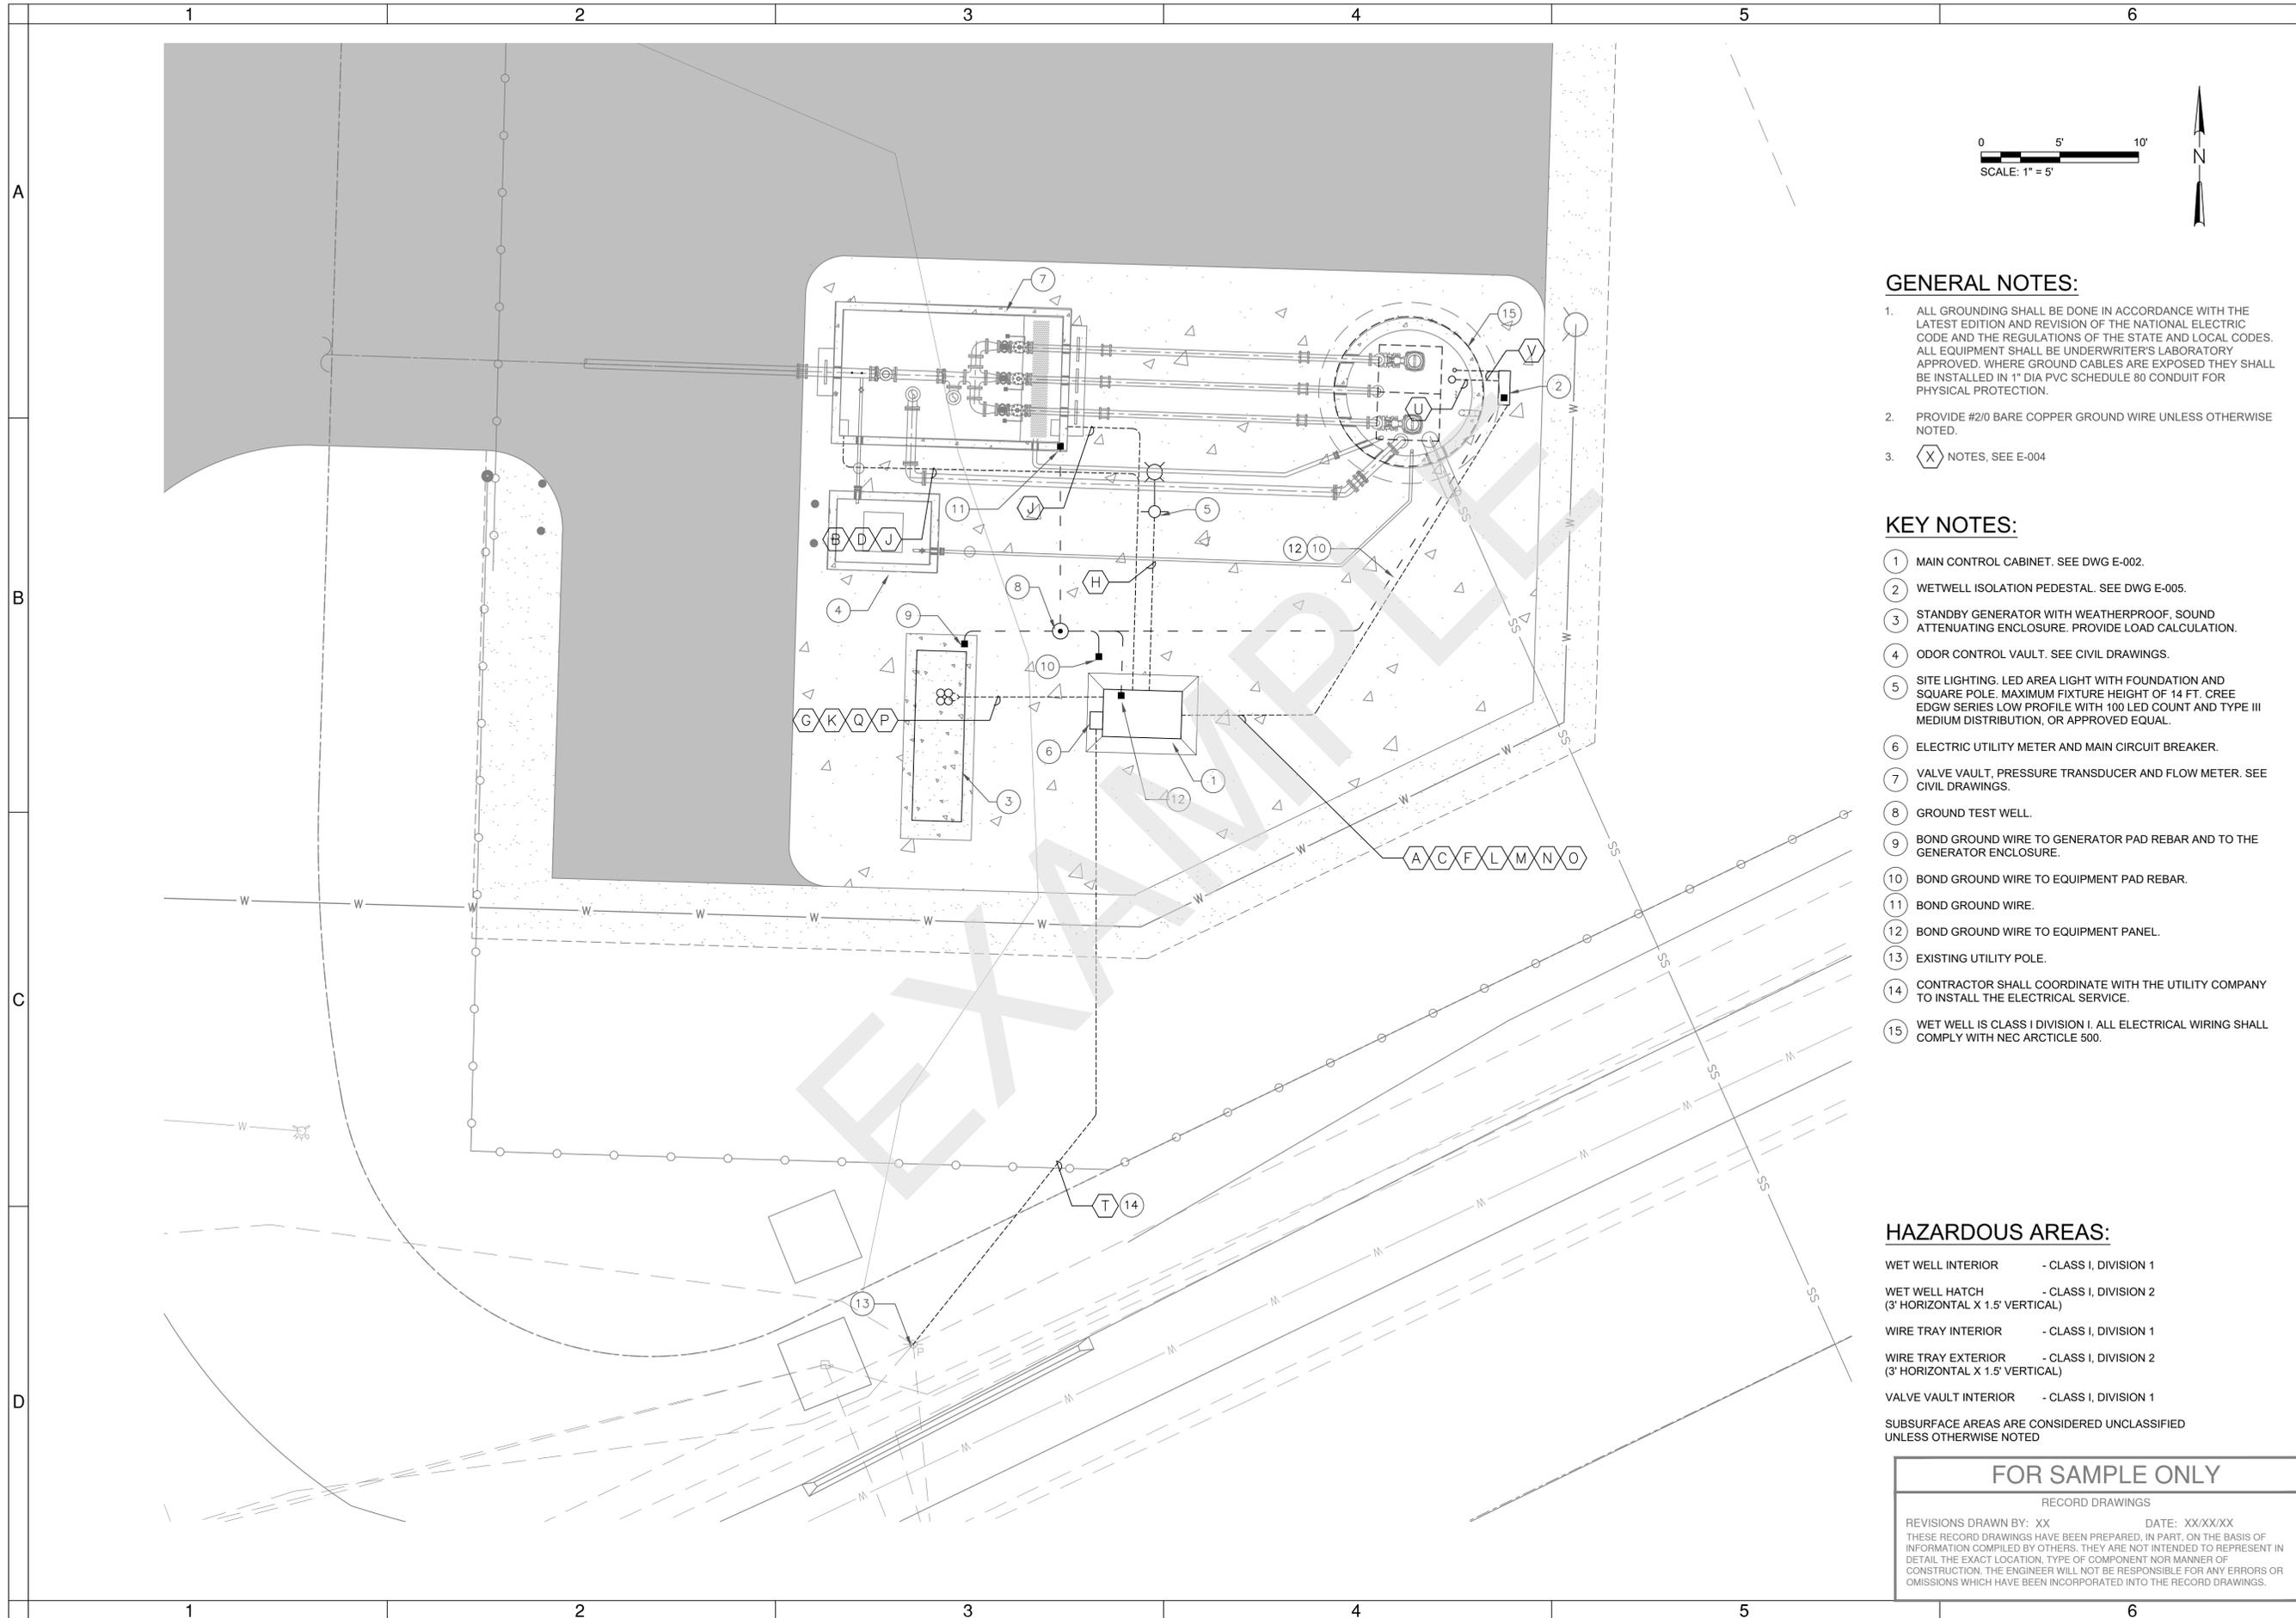

GENERAL NOTES:

1. ALL GROUNDING SHALL BE DONE IN ACCORDANCE WITH THE LATEST EDITION AND REVISION OF THE NATIONAL ELECTRIC CODE AND THE REGULATIONS OF THE STATE AND LOCAL CODES. ALL EQUIPMENT SHALL BE UNDERWRITER'S LABORATORY APPROVED. WHERE GROUND CABLES ARE EXPOSED THEY SHALL BE INSTALLED IN 1" DIA PVC SCHEDULE 80 CONDUIT FOR PHYSICAL PROTECTION.
2. PROVIDE #2/0 BARE COPPER GROUND WIRE UNLESS OTHERWISE NOTED.
3. (X) NOTES, SEE E-004

KEY NOTES:

- (1) MAIN CONTROL CABINET. SEE DWG E-002.
- (2) WETWELL ISOLATION PEDESTAL. SEE DWG E-005.
- (3) STANDBY GENERATOR WITH WEATHERPROOF, SOUND ATTENUATING ENCLOSURE. PROVIDE LOAD CALCULATION.
- (4) ODOR CONTROL VAULT. SEE CIVIL DRAWINGS.
- (5) SITE LIGHTING. LED AREA LIGHT WITH FOUNDATION AND SQUARE POLE. MAXIMUM FIXTURE HEIGHT OF 14 FT. CREE EDGW SERIES LOW PROFILE WITH 100 LED COUNT AND TYPE III MEDIUM DISTRIBUTION, OR APPROVED EQUAL.
- (6) ELECTRIC UTILITY METER AND MAIN CIRCUIT BREAKER.
- (7) VALVE VAULT, PRESSURE TRANSDUCER AND FLOW METER. SEE CIVIL DRAWINGS.
- (8) GROUND TEST WELL.
- (9) BOND GROUND WIRE TO GENERATOR PAD REBAR AND TO THE GENERATOR ENCLOSURE.
- (10) BOND GROUND WIRE TO EQUIPMENT PAD REBAR.
- (11) BOND GROUND WIRE.
- (12) BOND GROUND WIRE TO EQUIPMENT PANEL.
- (13) EXISTING UTILITY POLE.
- (14) CONTRACTOR SHALL COORDINATE WITH THE UTILITY COMPANY TO INSTALL THE ELECTRICAL SERVICE.
- (15) WET WELL IS CLASS I DIVISION I. ALL ELECTRICAL WIRING SHALL COMPLY WITH NEC ARTICLE 500.

HAZARDOUS AREAS:

- WET WELL INTERIOR - CLASS I, DIVISION 1
 - WET WELL HATCH (3' HORIZONTAL X 1.5' VERTICAL) - CLASS I, DIVISION 2
 - WIRE TRAY INTERIOR - CLASS I, DIVISION 1
 - WIRE TRAY EXTERIOR (3' HORIZONTAL X 1.5' VERTICAL) - CLASS I, DIVISION 2
 - VALVE VAULT INTERIOR - CLASS I, DIVISION 1
- SUBSURFACE AREAS ARE CONSIDERED UNCLASSIFIED UNLESS OTHERWISE NOTED

FOR SAMPLE ONLY

RECORD DRAWINGS

DESIGNED BY: _____ DATE: XX/XX/XX
 DRAWN BY: _____
 SCALE: _____
 FILE: _____
 DATE: _____

THESE RECORD DRAWINGS HAVE BEEN PREPARED, IN PART, ON THE BASIS OF INFORMATION COMPILED BY OTHERS. THEY ARE NOT INTENDED TO REPRESENT IN DETAIL THE EXACT LOCATION, TYPE OF COMPONENT NOR MANNER OF CONSTRUCTION. THE ENGINEER WILL NOT BE RESPONSIBLE FOR ANY ERRORS OR OMISSIONS WHICH HAVE BEEN INCORPORATED INTO THE RECORD DRAWINGS.

STAMP
[ENGINEERS]

(PROJECT NAME)
ELECTRICAL
ELECTRICAL SITE PLAN
DESCHUTES COUNTY, OREGON

[COMPANY NAME]
[COMPANY ADDRESS
AND PHONE NUMBER]


DESIGNED BY: _____
 DRAWN BY: _____
 SCALE: _____
 FILE: _____
 DATE: _____

REVISIONS:


VERIFY SCALES
0 1"
BAR EQUALS ONE INCH
ON ORIGINAL DRAWING

SHEET:
E-001


COB # (XXXXXX)

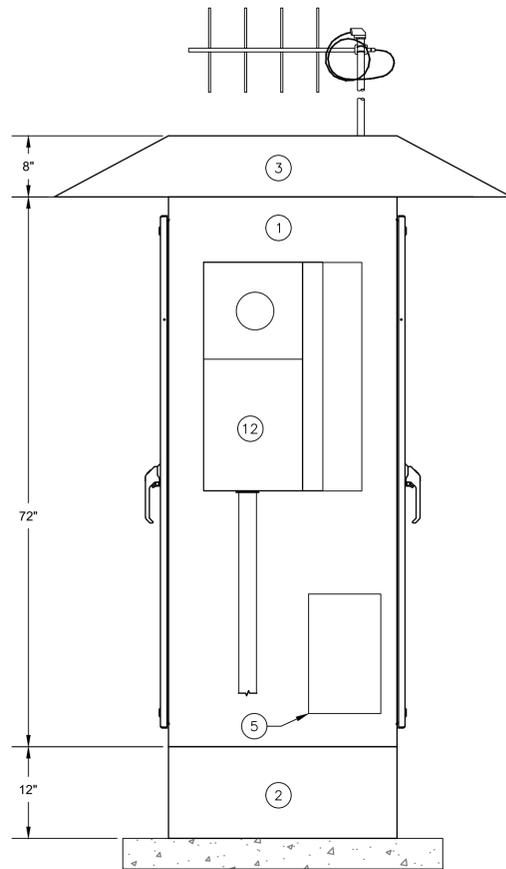


**CABINET
LEFT EXTERIOR
ELEVATION**

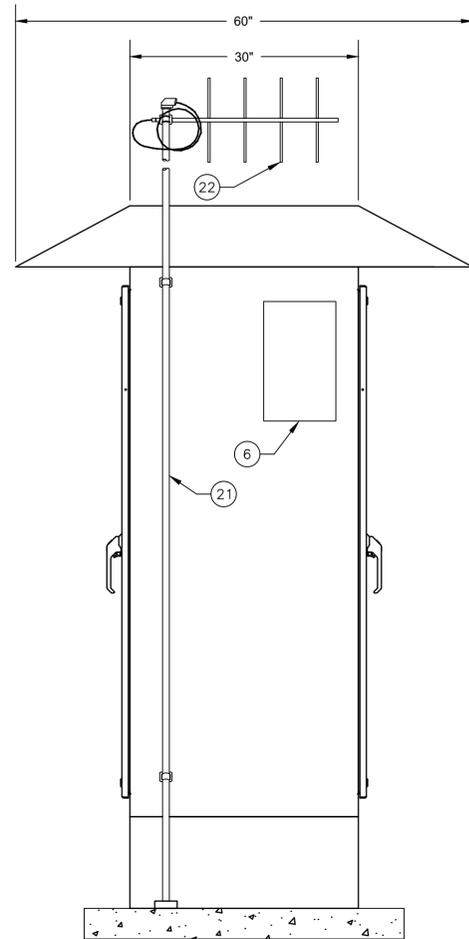

**CABINET
RIGHT EXTERIOR
ELEVATION**

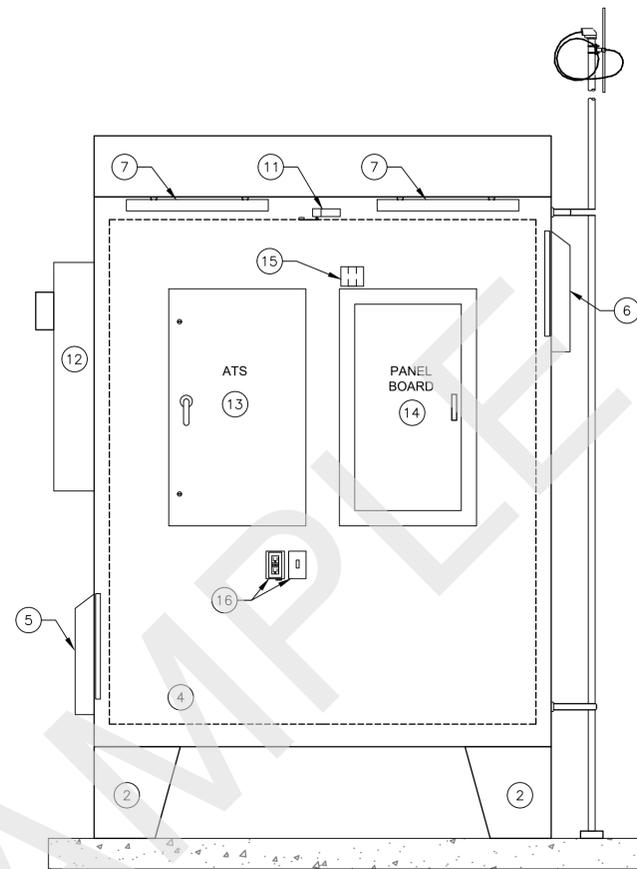

**CABINET
FRONT INTERIOR
ELEVATION**

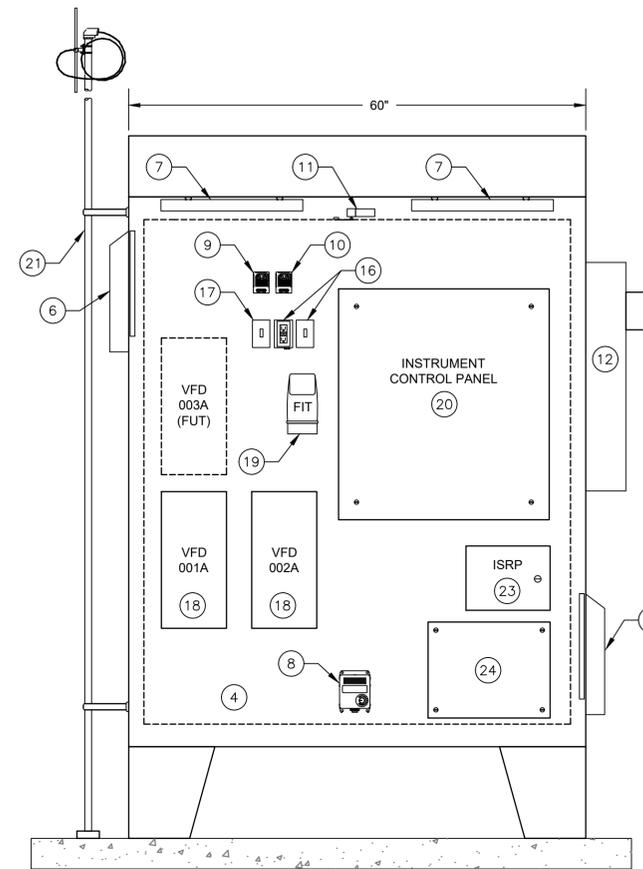

**CABINET
BACK INTERIOR
ELEVATION**

KEY NOTES:

- ① ENCLOSURE, 2-DOOR DUAL ACCESS
- ② FLOOR STAND
- ③ RAINHOOD / SUNHOOD
- ④ MOUNTING PAN
- ⑤ COOLING FAN WITH FILTER
- ⑥ LOUVER WITH FILTER
- ⑦ CABINET LIGHT
- ⑧ CABINET HEATER
- ⑨ THERMOSTAT, COOLING
- ⑩ THERMOSTAT, HEATING
- ⑪ INTRUSION SWITCH
- ⑫ ELECTRIC SERVICE METER WITH MAIN BREAKER
- ⑬ AUTOMATIC TRANSFER SWITCH
- ⑭ PANEL BOARD
- ⑮ SURGE PROTECTION DEVICE
- ⑯ DUPLEX RECEPTACLE AND CABINET LIGHT SWITCH
- ⑰ LIGHT SWITCH, SITE LIGHT
- ⑱ SMARTRUN VFD

- ⑲ FLOW TRANSMITTER
- ⑳ INSTRUMENT CONTROL PANEL (ICP)
- ㉑ ANTENNA MAST, THREADED AT TOP WITH WEATHERHEAD
- ㉒ ANTENNA, NOTE 5
- ㉓ INTRINSIC SAFETY RELAY PANEL
- ㉔ LEVEL TRANSMITTER DRY TERMINATION J-BOX

CONSTRUCTION NOTES:

1. MAIN CONTROL CABINET SHALL BE NEMA 12 RATED, PAINTED STEEL WITH FLOOR STAND. CABINET DOORS SHALL BE FITTED WITH GASKETS, PADLOCKABLE HASPS, AND DOORS THAT LATCH OPEN. RAINHOOD/SUNHOOD SHALL BE CUSTOM FABRICATED FROM 12 GAUGE STEEL PAINTED WITH ANSI 61 LIGHT GREY POLYESTER POWDER FINISH TO MATCH ENCLOSURE.
2. PANEL CONSTRUCTION PER NEC AND UL508A REQUIREMENTS. FOLLOW NFPA 79 WHERE APPLICABLE. THE INTERIOR OF THE MAIN CONTROL CABINET SHALL BE DESIGNED AND FABRICATED TO MEET IP20 "FINGER-SAFE" REQUIREMENTS IN ACCORDANCE WITH IEC 60529; THERE SHALL BE NO EXPOSED LIVE PARTS AS DEFINED BY NFPA 70E. ALL INTERCONNECTIONS BETWEEN PANEL COMPONENTS INSIDE THE LARGER ELECTRICAL ENCLOSURE SHALL BE INSTALLED IN EMT, RGS, METAL WIREWAY, OR LIQUID TIGHT METALLIC FLEXIBLE CONDUIT.
3. NO PENETRATIONS THROUGH THE TOP OF THE ENCLOSURE ARE ALLOWED. ALL PENETRATIONS SHALL BE MADE WITH AN APPROVED FITTING AND GASKET.
4. DO NOT ROUTE 120VAC WIRING WITHIN THE SAME RACEWAY AS DC ANALOG SIGNAL CABLES.
5. THE CITY OF BEND WILL DETERMINE THE RADIO TYPE, ANTENNA TYPE, MOUNTING HEIGHT, AND CABLE TYPE TO BE PROVIDED AND INSTALLED BY THE DEVELOPER. AT THE PRE-DESIGN STAGE, THE DEVELOPER SHALL COORDINATE FOR A TELEMETRY SIGNAL SURVEY TO BE PERFORMED WITH THE CITY OF BEND UTILITY DEPARTMENT AS REQUIRED TO DETERMINE RADIO COMMUNICATION EQUIPMENT REQUIREMENTS.
6. ALL UTILIZATION AND DISTRIBUTION EQUIPMENT, INCLUDING LIGHTING AND HEATING, SHALL BE WIRED FROM OR TO A SOURCE OTHER THAN THE PLC CONTROL PANEL. THIS REQUIRES A LOAD CENTER INSIDE THE MAIN CONTROL CABINET FOR POWER DISTRIBUTION.
7. EXCEPT AS OTHERWISE NOTED, PANEL WIRING SHALL BE AS FOLLOWS:
 - SINGLE WIRES SHALL BE THHN #16 AWG, EXCEPT WHERE INTENDED FOR POWER OR MOTOR CIRCUITS WHICH SHALL BE #14 AWG, MINIMUM.
 - COLOR CODE SHALL FOLLOW UL508A.
 - TWISTED PAIR ANALOG SIGNAL CABLE SHALL BE BELDEN 8760, OR EQUAL.
 - EACH WIRE SHALL BE IDENTIFIED WITH A PERMANENT WIRE LABEL, BRADY LAT-18-361.

**MAIN CONTROL CABINET
LAYOUT ELEVATION**

N.T.S.

FOR SAMPLE ONLY

RECORD DRAWINGS

DESIGNED BY: XX DATE: XX/XX/XX
 DRAWN BY: XX
 SCALE: 1" = 1'-0"
 FILE: THESE RECORD DRAWINGS HAVE BEEN PREPARED, IN PART, ON THE BASIS OF INFORMATION COMPILED BY OTHERS. THEY ARE NOT INTENDED TO REPRESENT IN DETAIL THE EXACT LOCATION, TYPE OF COMPONENT NOR MANNER OF CONSTRUCTION. THE ENGINEER WILL NOT BE RESPONSIBLE FOR ANY ERRORS OR OMISSIONS WHICH HAVE BEEN INCORPORATED INTO THE RECORD DRAWINGS.

STAMP
[ENGINEERS]

(PROJECT NAME)
**INSTRUMENTATION & CONTROLS
 MAIN CONTROL CABINET LAYOUT**
 DESCHUTES COUNTY, OREGON




REVISIONS:

[COMPANY NAME]
 [COMPANY ADDRESS
 AND PHONE NUMBER]

DESIGNED BY: []
 DRAWN BY: []
 SCALE: []
 FILE: []
 DATE: []

VERIFY SCALES
 0 1"
 BAR EQUALS ONE INCH
 ON ORIGINAL DRAWING

SHEET:
E-002
 COB # (XXXXXX)

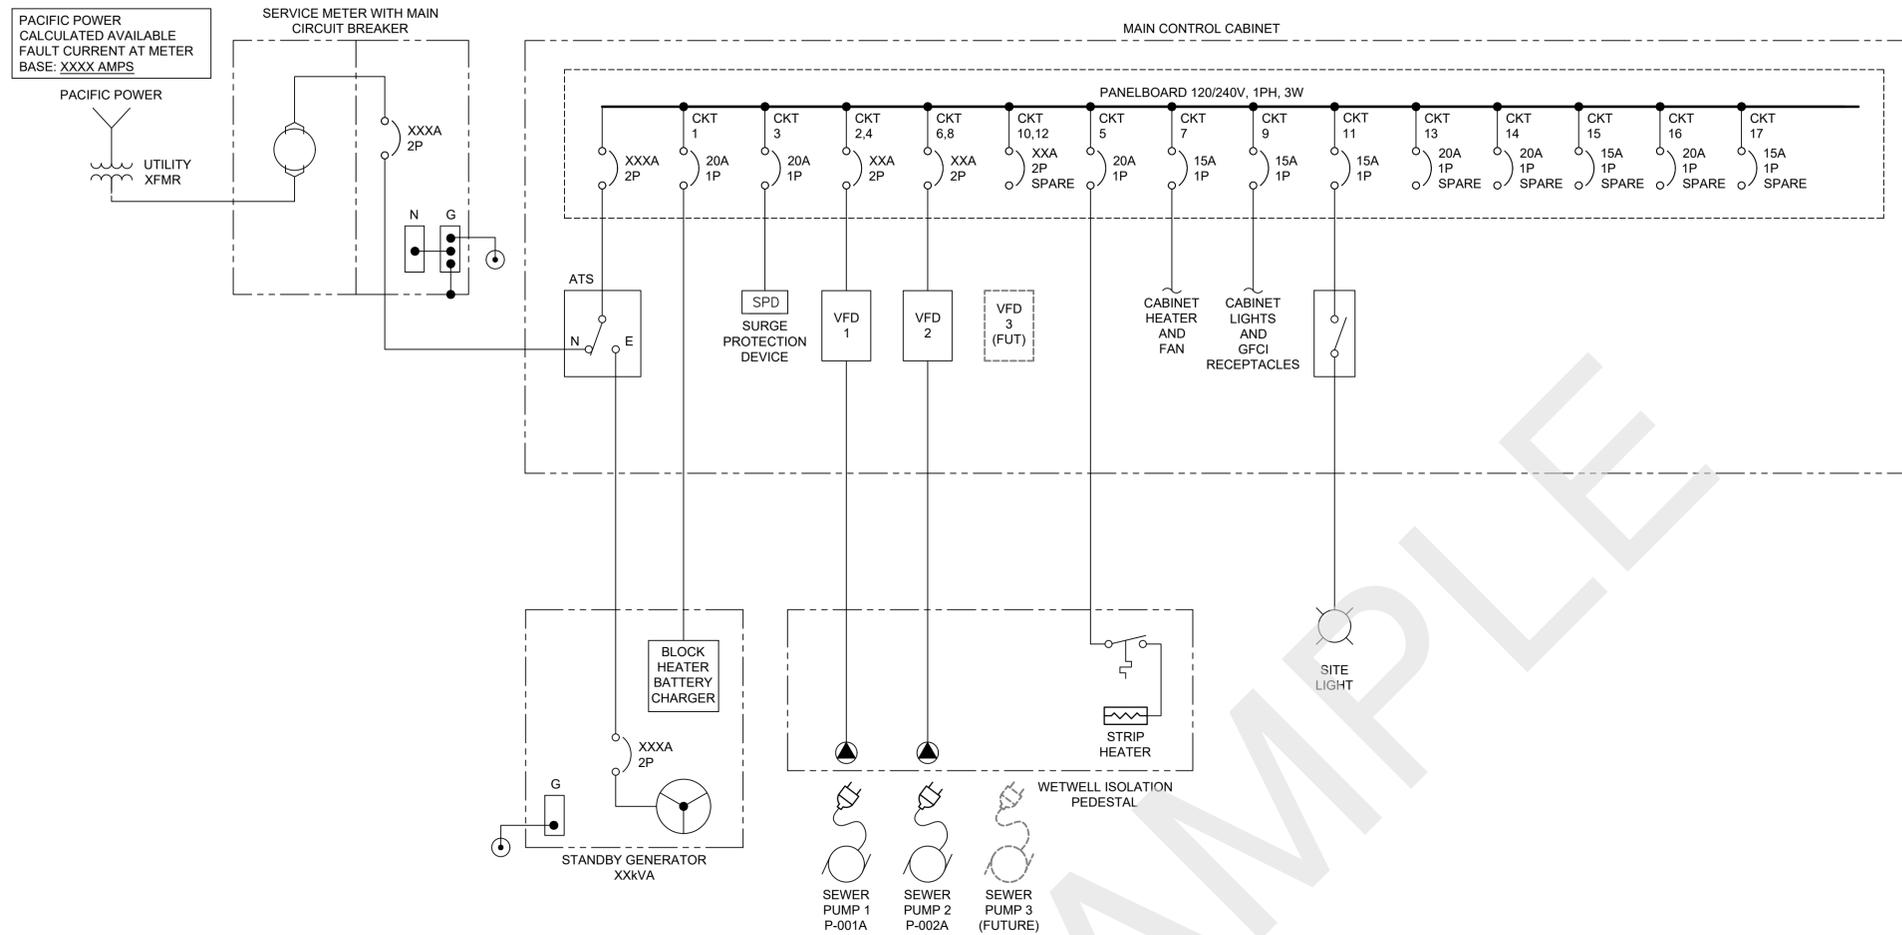

GENERAL NOTES:

- ELECTRICAL SERVICE AND ELECTRICAL EQUIPMENT SHALL HAVE A MINIMUM OF 25% SPARE CAPACITY FOR FUTURE LOADS.
- PANEL BOARD SHALL HAVE A MINIMUM OF 25% PREPARED CIRCUIT BREAKER SPACE FOR FUTURE LOADS.
- POWER SUPPLY VOLTAGE AND PHASE SHALL BE SITE SPECIFIC AND BE APPROVED BY CITY STAFF.
- VFD'S TO PROVIDE 3-PHASE POWER TO THE MOTOR FROM A SINGLE PHASE SOURCE.

LOAD DESCRIPTION	DUTY NO.	HP EACH	kVA EACH	TOTAL DUTY kVA	PLANT LOAD NO. kVA
PUMP 1	1	XX	XXX	XXX	XXX
PUMP 2	1	XX	XXX	XXX	XXX
PUMP 3 (FUTURE)		XX	XXX	XXX	XXX
GENERATOR BLOCK HEATER			XXX	XXX	XXX
CONTROL CABINET HEATER			XXX	XXX	XXX
ISOLATION HEAT			XXX	XXX	XXX
LOAD BANK HEAT			XXX	XXX	XXX
MISC LOAD			XXX	XXX	XXX
				TOTAL DUTY	DESIGN TOTAL
kVA SUBTOTAL				XXX	XXX
AMPS @240V, 3PH				XXX	XXX

LOAD REQUIREMENTS		PERFORMANCE REQUIREMENTS	
RUNNING kW	XXX	120/240V, 1PH, 3W	
RUNNING kVA	XXX	MAX VOLTAGE DIP	10%
RUNNING P.F.	XXX	MAX FREQUENCY DIP	2%
MAX START kW	XXX	MAX VOLTAGE HARMONIC DISTORTION	5%
MAX START kVA	XXX	MIN GENERATOR LOADED	30%
		MAX GENERATOR LOADED	100%
		TOTAL kW REQUIRED	XXX
		TOTAL AMPS REQUIRED	XXX

STAMP
[ENGINEERS]

(PROJECT NAME)
INSTRUMENTATION & CONTROLS
ELECTRICAL ONE LINE DIAGRAM
DESCHUTES COUNTY, OREGON



REVISIONS:

[COMPANY NAME]
[COMPANY ADDRESS AND PHONE NUMBER]

DESIGNED BY:
DRAWN BY:
SCALE:
FILE:
DATE:

VERIFY SCALES
0 1"
BAR EQUALS ONE INCH ON ORIGINAL DRAWING

SHEET:
E-003
COB # (XXXXXX)

FOR SAMPLE ONLY
RECORD DRAWINGS
REVISIONS DRAWN BY: XX DATE: XX/XX/XX
THESE RECORD DRAWINGS HAVE BEEN PREPARED, IN PART, ON THE BASIS OF INFORMATION COMPILED BY OTHERS. THEY ARE NOT INTENDED TO REPRESENT IN DETAIL THE EXACT LOCATION, TYPE OF COMPONENT NOR MANNER OF CONSTRUCTION. THE ENGINEER WILL NOT BE RESPONSIBLE FOR ANY ERRORS OR OMISSIONS WHICH HAVE BEEN INCORPORATED INTO THE RECORD DRAWINGS.

1

2

3

4

5

6

A

B

C

D

A

B

C

D

CONDUIT AND WIRE SCHEDULE

CONDUIT USE	CONDUIT DESIGNATION	CONDUIT SIZE	CONDUIT TYPE	CONDUCTOR SIZE AND NUMBER OF CONDUCTORS	CONDUIT FROM	CONDUIT TO
FLOAT SWITCH LSHH WETWELL HATCH LIMIT SWITCH	(A)	1 INCH	PVC	6#14	THE MAIN CONTROL CABINET	THE ISOLATION PEDESTAL
FLOW SENSOR	(B)	1 INCH	PVC	MANUFACTURER CABLE	THE MAIN CONTROL CABINET	THE FLOW METER VAULT
SUBMERSIBLE LEVEL TRANSMITTER	(C)	3/4 INCH	PVC	MANUFACTURER CABLE	THE MAIN CONTROL CABINET	THE ISOLATION PEDESTAL
VALVE VAULT HATCH LIMIT SWITCH	(D)	1 INCH	PVC	3#14	THE MAIN CONTROL CABINET	THE FLOW METER VAULT
SEAL FAIL / OVER TEMP	(E)	1 INCH	PVC	8#14	THE MAIN CONTROL CABINET	THE ISOLATION PEDESTAL
GENERATOR CONTROL SIGNALS (ATS)	(F)	1 INCH	PVC	8#14	THE MAIN CONTROL CABINET	THE GENERATOR
OUTSIDE AREA LIGHT	(G)	1 INCH	PVC	2#12, 1#12G	THE MAIN CONTROL CABINET	THE LIGHT POLE
VALVE VAULT SPARE	(H)	1 INCH	PVC	PULL CORD	THE MAIN CONTROL CABINET	THE VALVE VAULT
GENERATOR BATTERY CHARGER / BLOCK HEATER	(I)	1 INCH	PVC	4#10, 2#10G	THE MAIN CONTROL CABINET	THE GENERATOR
ISOLATION PEDESTAL HEATER	(J)	1 INCH	PVC	2#12, 1#12G	THE MAIN CONTROL CABINET	THE ISOLATION PEDESTAL
PUMP #1	(K)	1 INCH	PVC	3#8, 1#10G	THE MAIN CONTROL CABINET	THE ISOLATION PEDESTAL
PUMP #2	(L)	1 INCH	PVC	3#8, 1#10G	THE MAIN CONTROL CABINET	THE ISOLATION PEDESTAL
PUMP #3 (FUTURE)	(M)	1 INCH	PVC	3#8, 1#10G	THE MAIN CONTROL CABINET	THE ISOLATION PEDESTAL
GENERATOR MONITORING SIGNALS (PLC)	(N)	1 INCH	PVC	8#14	THE MAIN CONTROL CABINET	THE GENERATOR
GENERATOR POWER	(O)	2 INCH	PVC	3#1/0, 1#6G	THE MAIN CONTROL CABINET	THE GENERATOR
UNDERGROUND SERVICE	(P)	3 INCH	PVC	PULL ROPE	UNDERGROUND SERVICE	MAIN CONTROL ENCLOSURE PAD
SUBMERSIBLE LEVEL TRANSMITTER	(Q)	1 INCH	PGRC	MANUFACTURER CABLE	THE WET WELL	THE ISOLATION PEDESTAL
FLOAT SWITCH LSHH	(R)	3/4 INCH	PGRC	MANUFACTURER CABLE	THE WET WELL	THE ISOLATION PEDESTAL
ANTENNA SUPPORT	(W)	2 INCH	PGRC	MANUFACTURER CABLE	THE MAIN CONTROL CABINET	WEATHER HEAD

GENERAL NOTES: (CONDUIT INSTALLATION)

- ALL STRUT AND MOUNTING HARDWARE MUST BE STAINLESS STEEL.
- MYERS HUB FITTING MUST BE USED ON ALL CONDUIT PENETRATIONS.
- ALL CONDUIT MUST BE SCHEDULE 80 PVC.
- THE PROPER TOOLS MUST BE USED WHILE CUTTING, THREADING, BENDING, AND TIGHTENING ANY PVC COATED CONDUIT.
- THE PVE COATING MUST REMAIN INTACT ONLY 1 INCH OF THE COATING MAY BE REMOVED AT THE END OF THE CONDUIT TO ALLOW FOR THE THREAD.
- ANY CONDUIT WITH THE DAMAGED COATING MUST BE REPLACED.
- THE COATING TOUCH UP PAINT IS ONLY TO BE USED FOR COSMETIC BLEMISHES.
- ALL THREADED CONNECTIONS MUST BE COPPER COATED AND TIGHTENED APPROPRIATELY.
- ALL UNDERGROUND CONDUIT RUNS MUST BE INSPECTED PRIOR TO BACKFILL.

STAMP
[ENGINEERS]

(PROJECT NAME)
INSTRUMENTATION & CONTROLS
CONDUIT AND WIRE SCHEDULE
DESCHUTES COUNTY, OREGON



REVISIONS:

[COMPANY NAME]
[COMPANY ADDRESS
AND PHONE NUMBER]

DESIGNED BY: _____
DRAWN BY: _____
SCALE: _____
FILE: _____
DATE: _____

VERIFY SCALES
0 1"
BAR EQUALS ONE INCH
ON ORIGINAL DRAWING

SHEET:

E-004

COB # (XXXXXX)

FOR SAMPLE ONLY
RECORD DRAWINGS
REVISIONS DRAWN BY: XX DATE: XX/XX/XX
THESE RECORD DRAWINGS HAVE BEEN PREPARED, IN PART, ON THE BASIS OF INFORMATION COMPILED BY OTHERS. THEY ARE NOT INTENDED TO REPRESENT IN DETAIL THE EXACT LOCATION, TYPE OF COMPONENT NOR MANNER OF CONSTRUCTION. THE ENGINEER WILL NOT BE RESPONSIBLE FOR ANY ERRORS OR OMISSIONS WHICH HAVE BEEN INCORPORATED INTO THE RECORD DRAWINGS.

1 2 3 4 5 6

A


B

C

D

SEAL FAIL / OVER TEMP WIRES TO BE DARK BLUE

LEVEL TRANSMITTER CABLE SHALL BE CONTINUOUS FROM LEVEL TRANSMITTER TO DRY TERMINATION JUNCTION BOX LOCATED IN THE MAIN CONTROL CABINET

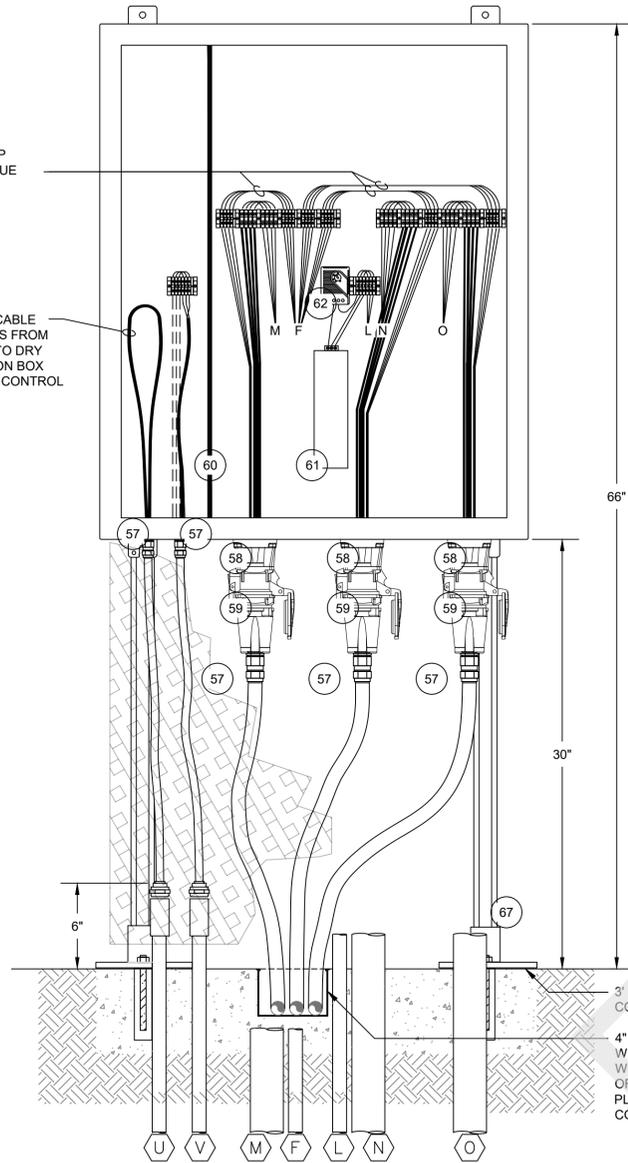


PEDESTAL ELEVATION

THE ENTIRE SHROUD MUST BE 12 GAUGE 316 STAINLESS STEEL EXPANDED METAL ON ALL 4 SIDES INCLUDING THE DOOR TO MAINTAIN CLASS 1 DIVISION 2 RATING THE DOOR MUST HAVE A SS HINGE AND SS LOCK HASP

MAINTAIN A 3/4" GAP BETWEEN THE SHROUD AND THE PAD


3' x 3' x 8" CONCRETE PAD
4" DEEP x 8" WIDE WIRE TRAY TO WET WELL WITH 10 GA AL OR SST DIAMOND PLATE REMOVABLE COVER

SIDE PEDESTAL FOOT MOUNTING

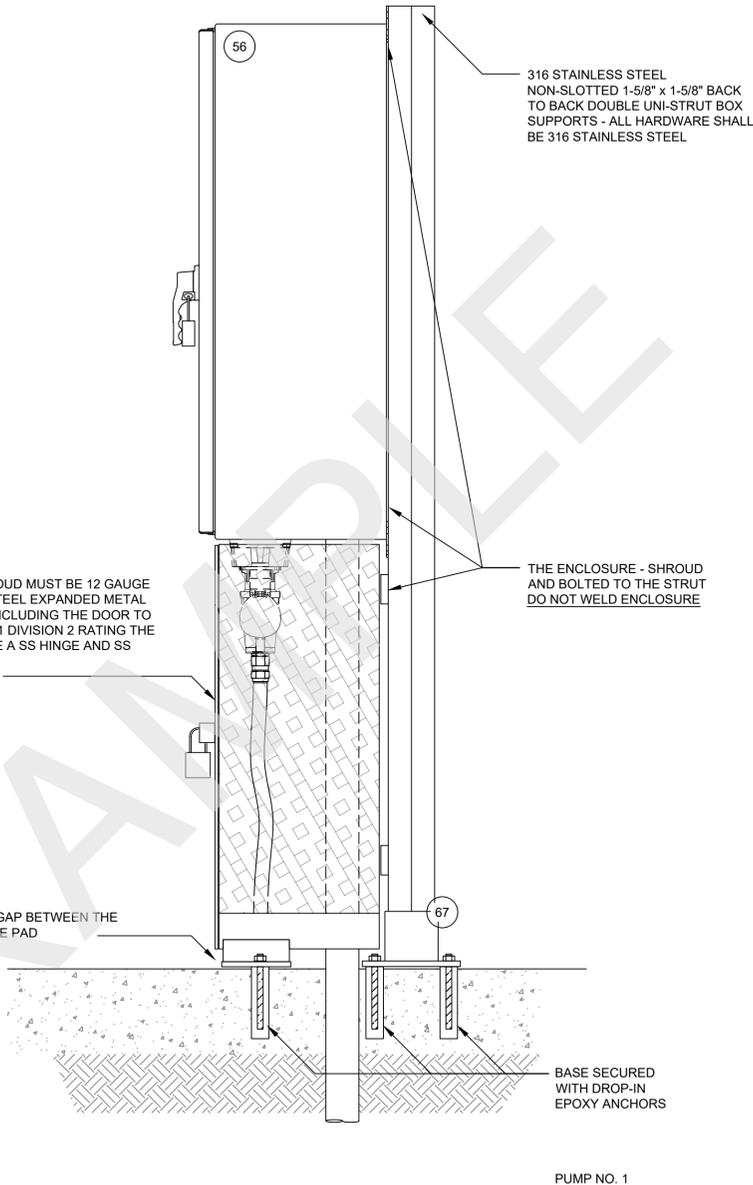

PUMP NO. 1

- KEY NOTES:**
- 56 ISOLATION PEDESTAL ENCLOSURE
 - 57 CABLE SEAL
 - 58 PUMP POWER RECEPTACLE
 - 59 PUMP CORD CONNECTOR
 - 60 ISOLATION PEDESTAL BARRIER
 - 61 ISOLATION PEDESTAL HEATER
 - 62 ISOLATION PEDESTAL HYGROSTAT
 - 67 ISOLATION PEDESTAL POST BASE
- X CONDUIT PENETRATIONS. SEE CONDUIT SCHEDULE SHEET E-004

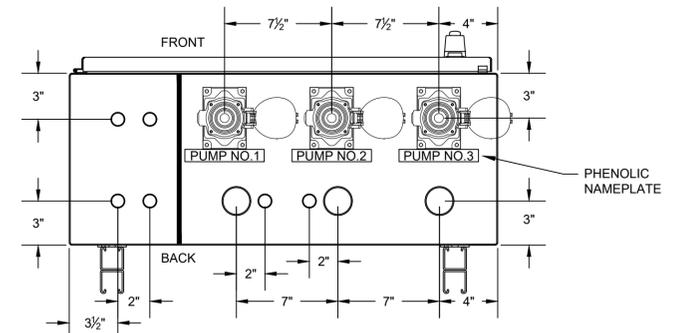

BOTTOM ENCLOSURE

1 WET WELL ISOLATION PEDESTAL ELEVATION
N.T.S.

FOR SAMPLE ONLY

RECORD DRAWINGS

DESIGNED BY: XX DATE: XX/XX/XX
 DRAWN BY: XX
 SCALE: 1" = 1'-0"
 FILE: E-005
 DATE: XX/XX/XX

REVISIONS DRAWN BY: XX DATE: XX/XX/XX
 THESE RECORD DRAWINGS HAVE BEEN PREPARED, IN PART, ON THE BASIS OF INFORMATION COMPILED BY OTHERS. THEY ARE NOT INTENDED TO REPRESENT IN DETAIL THE EXACT LOCATION, TYPE OF COMPONENT NOR MANNER OF CONSTRUCTION. THE ENGINEER WILL NOT BE RESPONSIBLE FOR ANY ERRORS OR OMISSIONS WHICH HAVE BEEN INCORPORATED INTO THE RECORD DRAWINGS.

STAMP
[ENGINEERS]

(PROJECT NAME)
INSTRUMENTATION & CONTROLS
WETWELL ISOLATION PEDESTAL
DESCHUTES COUNTY, OREGON



REVISIONS:

[COMPANY NAME]
[COMPANY ADDRESS AND PHONE NUMBER]


DESIGNED BY:
DRAWN BY:
SCALE:
FILE:
DATE:

VERIFY SCALES
0 1"
BAR EQUALS ONE INCH ON ORIGINAL DRAWING

SHEET:
E-005


COB # (XXXXXX)

1 2 3 4 5 6

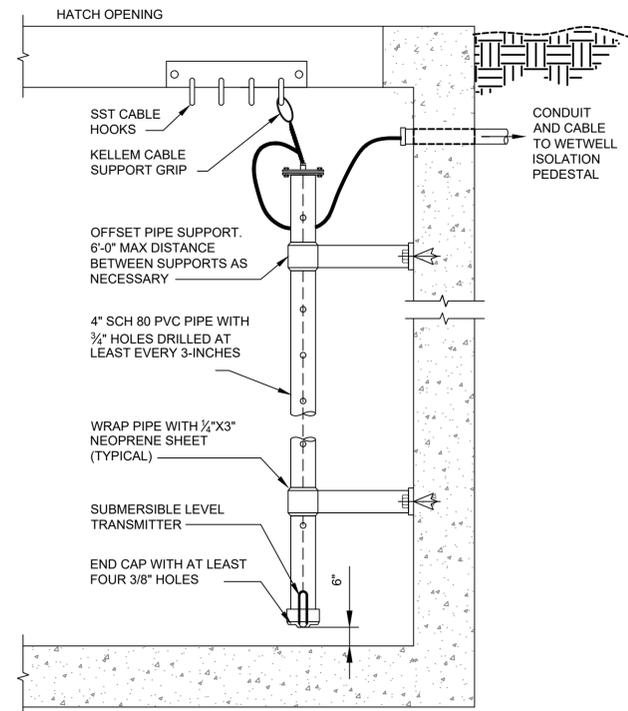

1 SUBMERSIBLE LEVEL TRANSMITTER

1 N.T.S.

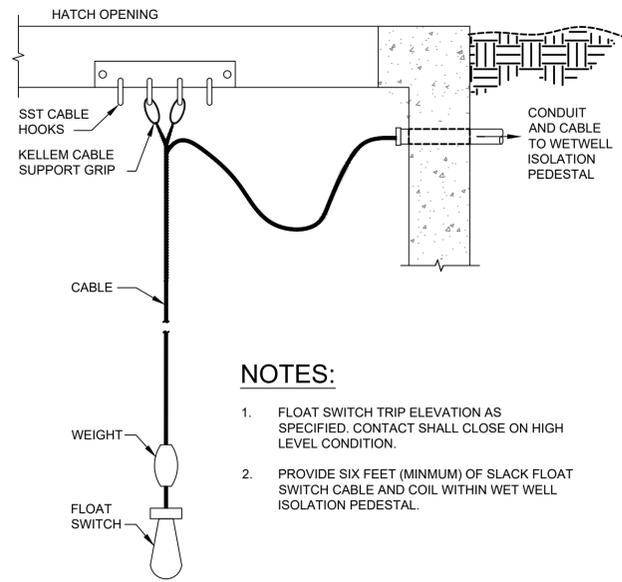


NOTES:

1. FLOAT SWITCH TRIP ELEVATION AS SPECIFIED. CONTACT SHALL CLOSE ON HIGH LEVEL CONDITION.
2. PROVIDE SIX FEET (MINIMUM) OF SLACK FLOAT SWITCH CABLE AND COIL WITHIN WET WELL ISOLATION PEDESTAL.

2 SUSPENDED FLOAT SWITCH

2 N.T.S.

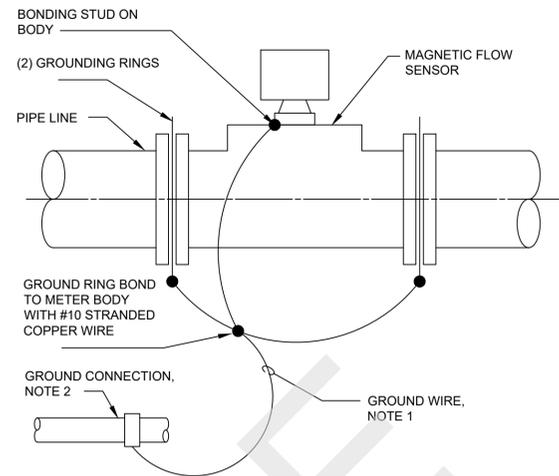


NOTES:

1. NO. 10 AWG INSULATED IF LENGTH IS LESS THAN 6'. IF MORE THAN 6', INSTALL CONDUCTOR IN 3/4" CONDUIT.
2. BOND MAGMETER TO ONE OF THE FOLLOWING ACCEPTABLE GROUNDS:
 - A. POWER CIRCUIT GROUND CONDUCTOR AT TRANSMITTER.
 - B. NEAREST AVAILABLE EQUIPMENT GROUND CONNECTION POINT.
 - C. SEPARATE TAIL FROM EMBEDDED GROUND MAT.

3 MAGNETIC FLOW METER GROUNDING RING BONDING

3 N.T.S.

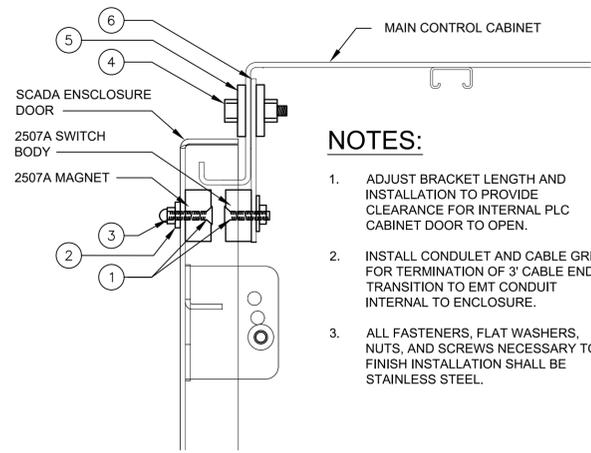

NOTES:


1. ADJUST BRACKET LENGTH AND INSTALLATION TO PROVIDE CLEARANCE FOR INTERNAL PLC CABINET DOOR TO OPEN.
2. INSTALL CONDULET AND CABLE GRIP FOR TERMINATION OF 3' CABLE END TRANSITION TO EMT CONDUIT INTERNAL TO ENCLOSURE.
3. ALL FASTENERS, FLAT WASHERS, NUTS, AND SCREWS NECESSARY TO FINISH INSTALLATION SHALL BE STAINLESS STEEL.

BILL OF MATERIALS

ITEM	DESCRIPTION
1	8-32 3/8" FLATHEAD MACHINE SCREW, STAINLESS STEEL
2	#8 BONDED SEALING WASHER, STAINLESS STEEL
3	8-32 ACORN NUT, STAINLESS STEEL
4	1/4"-28 x 3/4" HEX CAP SCREW, STAINLESS STEEL
5	1/4" BONDED SEALING WASHER, STAINLESS STEEL
6	ALUMINUM BRACKET, SHOP SUPPLIED

4 MAIN CONTROL CABINET INTRUSION SWITCH

4 N.T.S.

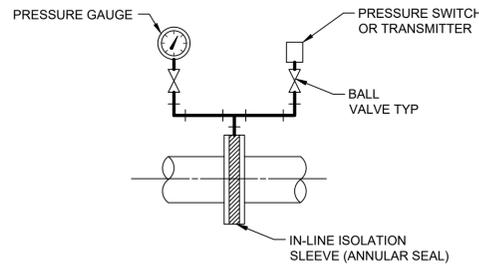


NOTES:

1. MOUNT PRESSURE GAUGE IN VERTICAL FOR VIEWING.
2. INDICATOR AND PRESSURE SWITCH INSTALLATION AS SPECIFIED FOR SINGLE INSTRUMENT INSTALLATIONS. MOUNT DEVICE DIRECTLY TO ANNULAR SEAL.

5 IN-LINE ISOLATION SLEEVE PRESSURE SWITCH/TRANSMITTER

5 N.T.S.

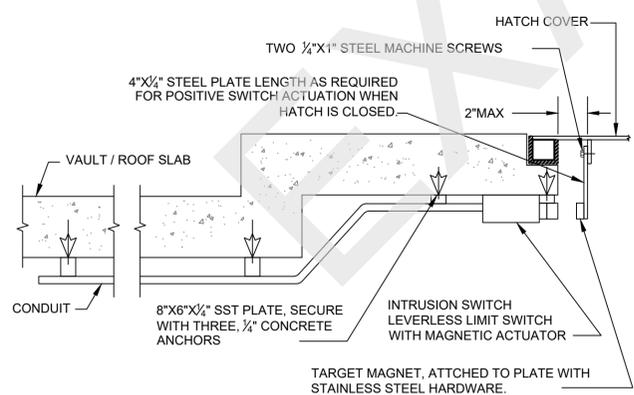


NOTES:

1. THE INSTALLATION DETAIL SHOWN IS GENERIC. ACTUAL INSTALLATIONS MAY VARY.

6 HATCH INTRUSION SWITCH INSTALLATION


6 N.T.S.

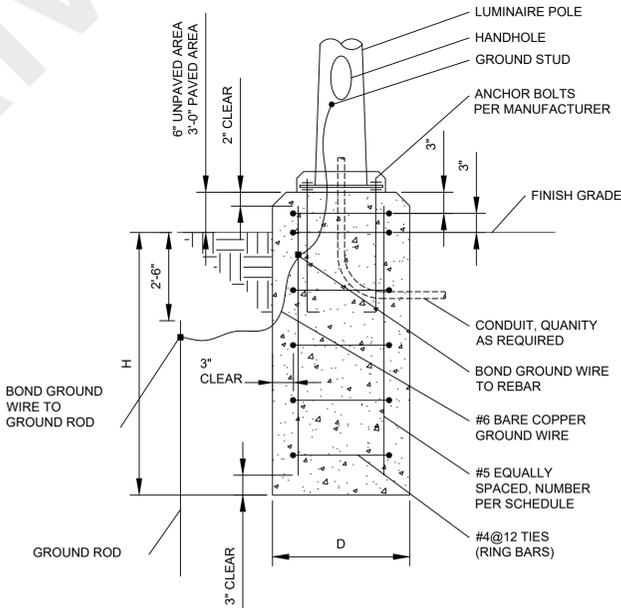

DIMENSION SCHEDULE			
POLE HEIGHT	MINIMUM D	MINIMUM H	VERTICAL REBAR EACH
UP TO 10'	2'-0"	4'-6"	6
11' TO 20'	2'-0"	6'-6"	6

7 LIGHT STANDARD BASE

7 N.T.S.

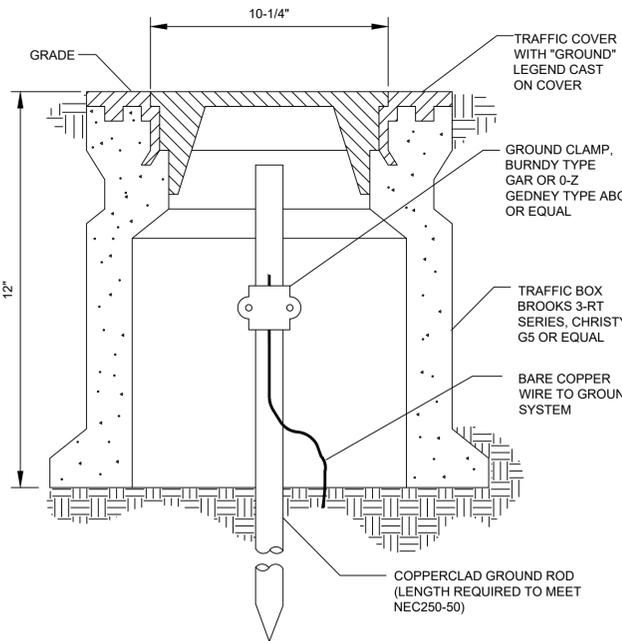

8 GROUND WELL AND ROD DETAIL

8 N.T.S.

FOR SAMPLE ONLY

RECORD DRAWINGS

DESIGNED BY: XX DATE: XX/XX/XX
 DRAWN BY: THESE RECORD DRAWINGS HAVE BEEN PREPARED, IN PART, ON THE BASIS OF INFORMATION COMPILED BY OTHERS. THEY ARE NOT INTENDED TO REPRESENT IN DETAIL THE EXACT LOCATION, TYPE OF COMPONENT NOR MANNER OF CONSTRUCTION. THE ENGINEER WILL NOT BE RESPONSIBLE FOR ANY ERRORS OR OMISSIONS WHICH HAVE BEEN INCORPORATED INTO THE RECORD DRAWINGS.

STAMP
[ENGINEERS]

(PROJECT NAME)
INSTRUMENTATION & CONTROLS
ELECTRICAL DETAILS
DESCUTES COUNTY, OREGON

ENGINEERING

REVISIONS:


[COMPANY NAME]
[COMPANY ADDRESS AND PHONE NUMBER]

DESIGNED BY: _____
 DRAWN BY: _____
 SCALE: _____
 FILE: _____
 DATE: _____

VERIFY SCALES
0 1"
BAR EQUALS ONE INCH ON ORIGINAL DRAWING

SHEET: **E-006**

COB # (XXXXXX)

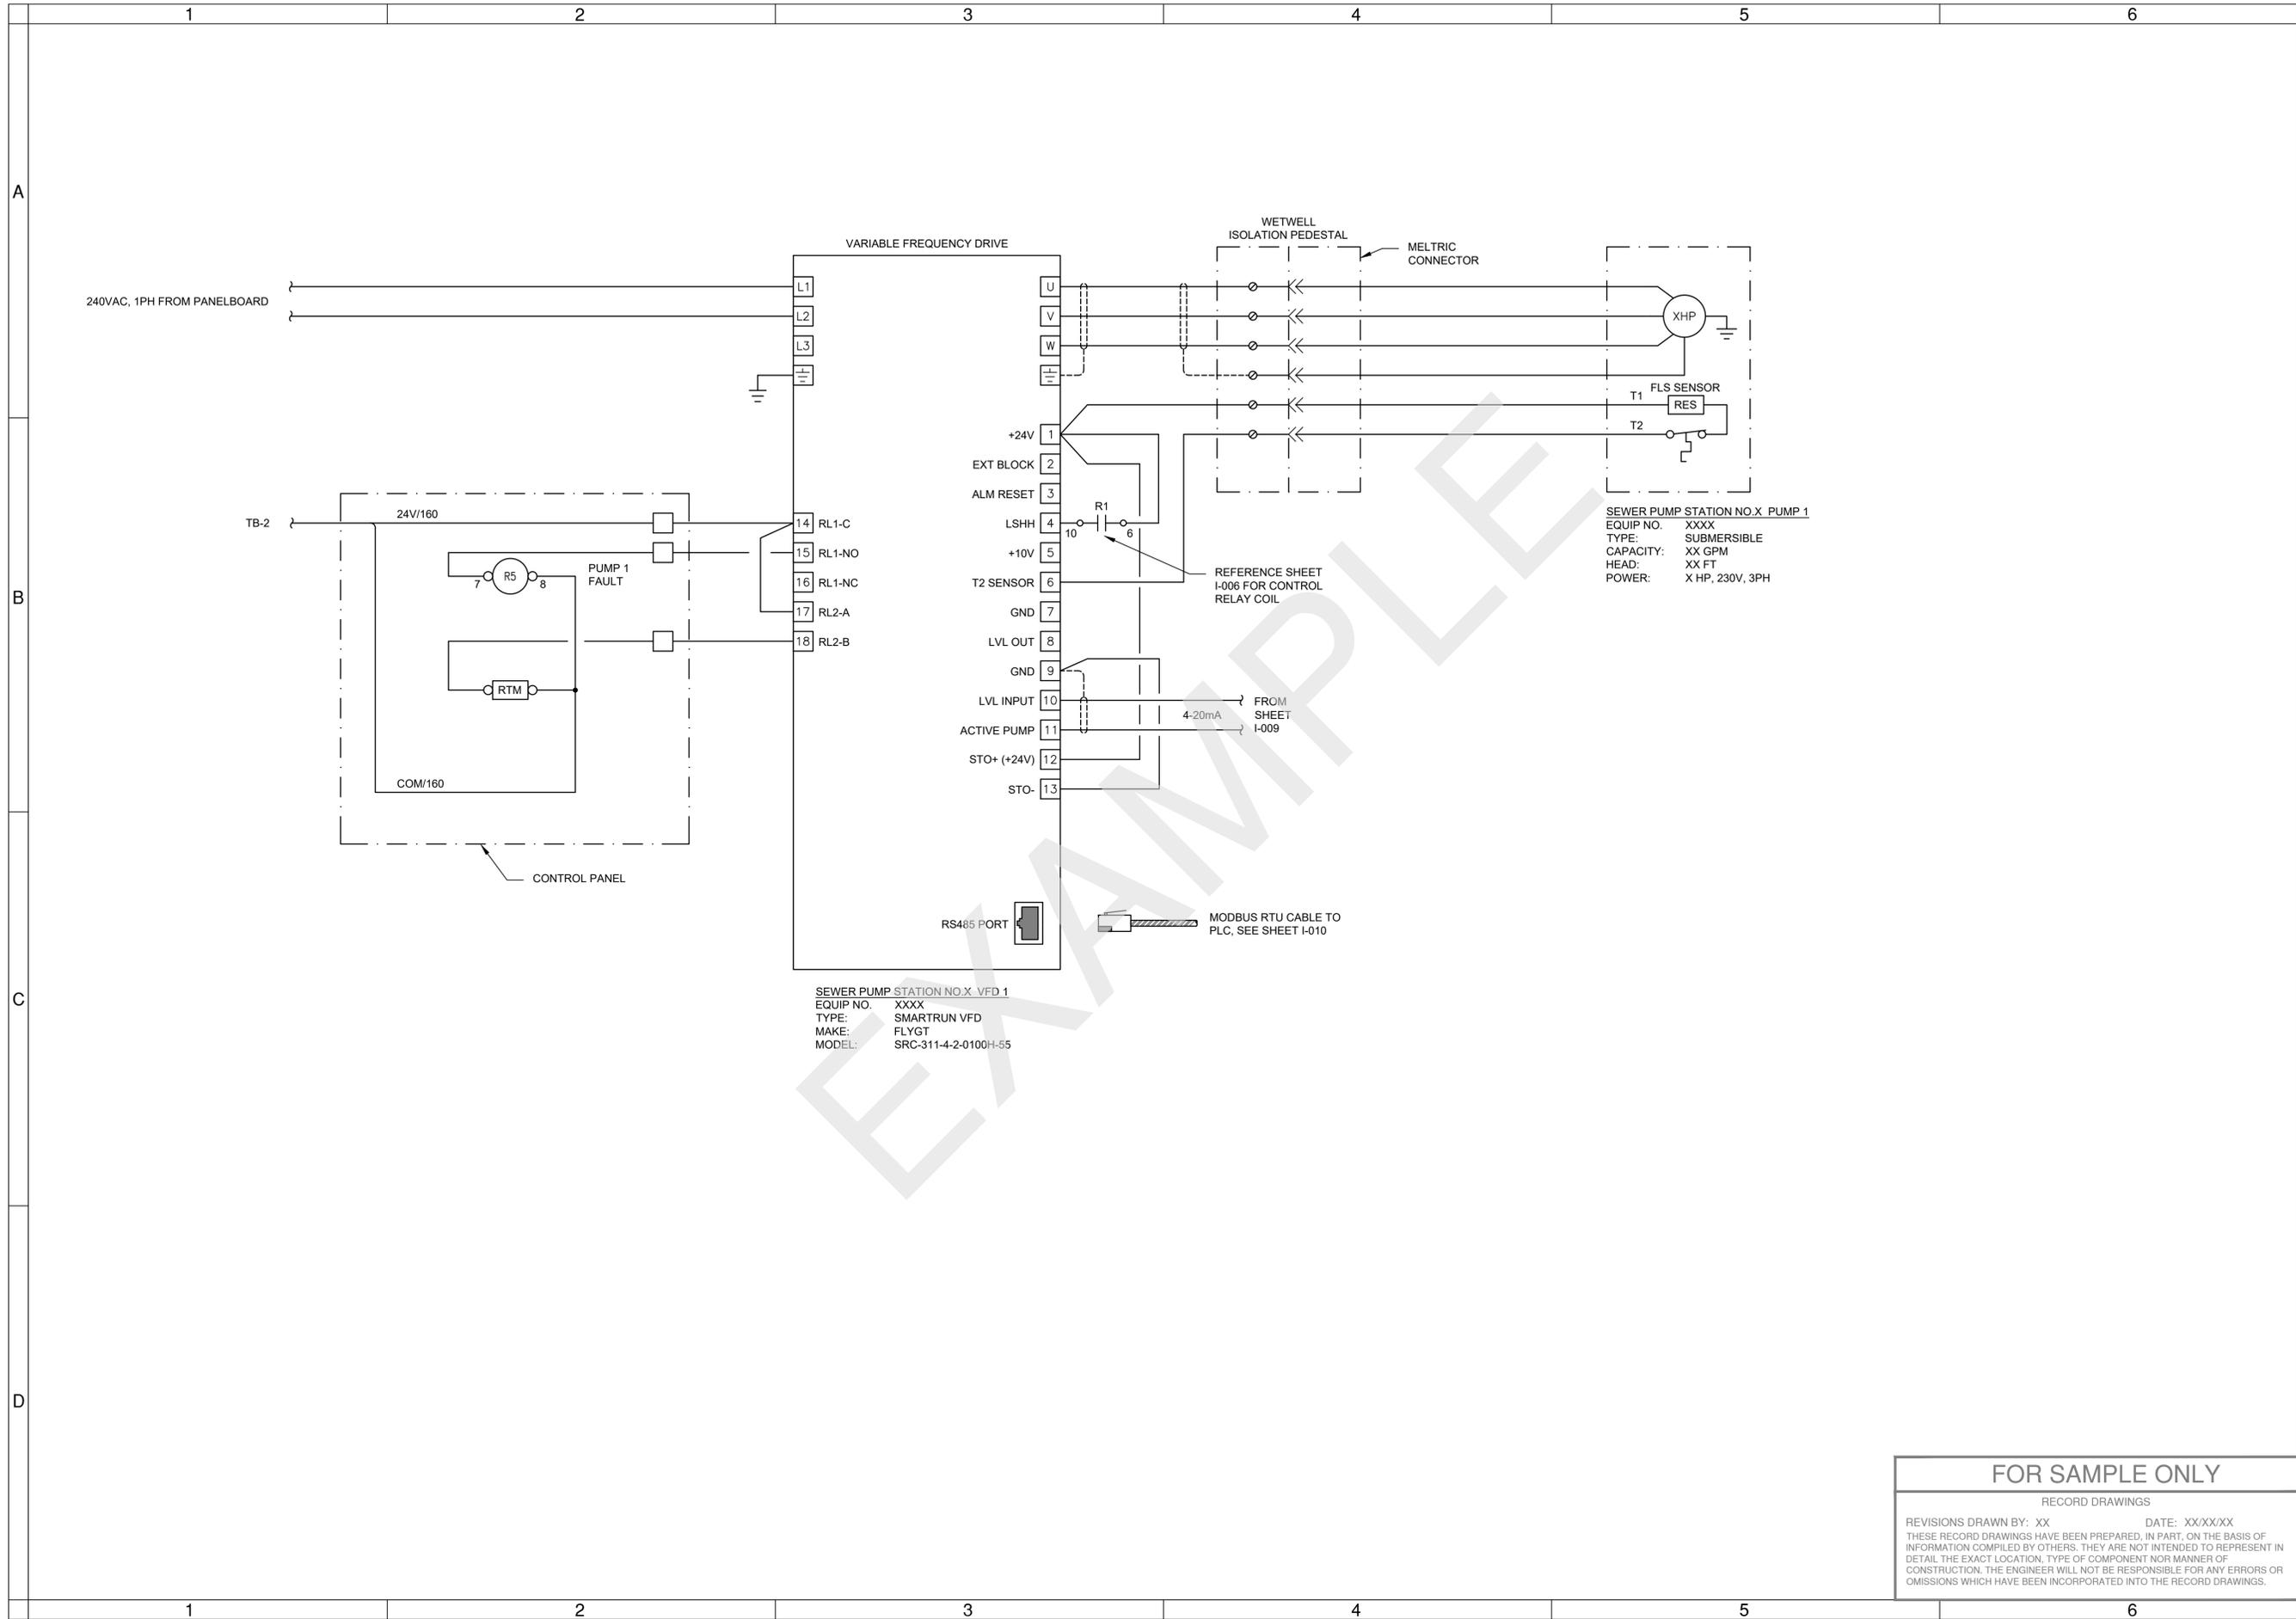


SEWER PUMP STATION NO.X PUMP 1
 EQUIP NO. XXXX
 TYPE: SUBMERSIBLE
 CAPACITY: XX GPM
 HEAD: XX FT
 POWER: X HP, 230V, 3PH

SEWER PUMP STATION NO.X VFD 1
 EQUIP NO. XXXX
 TYPE: SMARTRUN VFD
 MAKE: FLYGT
 MODEL: SRC-311-4-2-0100H-55

STAMP
 [ENGINEERS]

(PROJECT NAME)
 SEWER PUMP STATION NO. X
 PUMP 1 WIRING DIAGRAM
 DESCHUTES COUNTY, OREGON

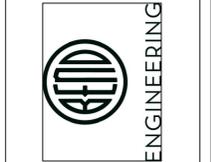

REVISIONS:


[COMPANY NAME]
 [COMPANY ADDRESS
 AND PHONE NUMBER]

DESIGNED BY: _____
 DRAWN BY: _____
 SCALE: _____
 FILE: _____
 DATE: _____

VERIFY SCALES
 0 1"
 BAR EQUALS ONE INCH
 ON ORIGINAL DRAWING

SHEET:
E-007
 COB # (XXXXXX)

FOR SAMPLE ONLY
 RECORD DRAWINGS
 REVISIONS DRAWN BY: XX DATE: XX/XX/XX
 THESE RECORD DRAWINGS HAVE BEEN PREPARED, IN PART, ON THE BASIS OF
 INFORMATION COMPILED BY OTHERS. THEY ARE NOT INTENDED TO REPRESENT IN
 DETAIL THE EXACT LOCATION, TYPE OF COMPONENT NOR MANNER OF
 CONSTRUCTION. THE ENGINEER WILL NOT BE RESPONSIBLE FOR ANY ERRORS OR
 OMISSIONS WHICH HAVE BEEN INCORPORATED INTO THE RECORD DRAWINGS.

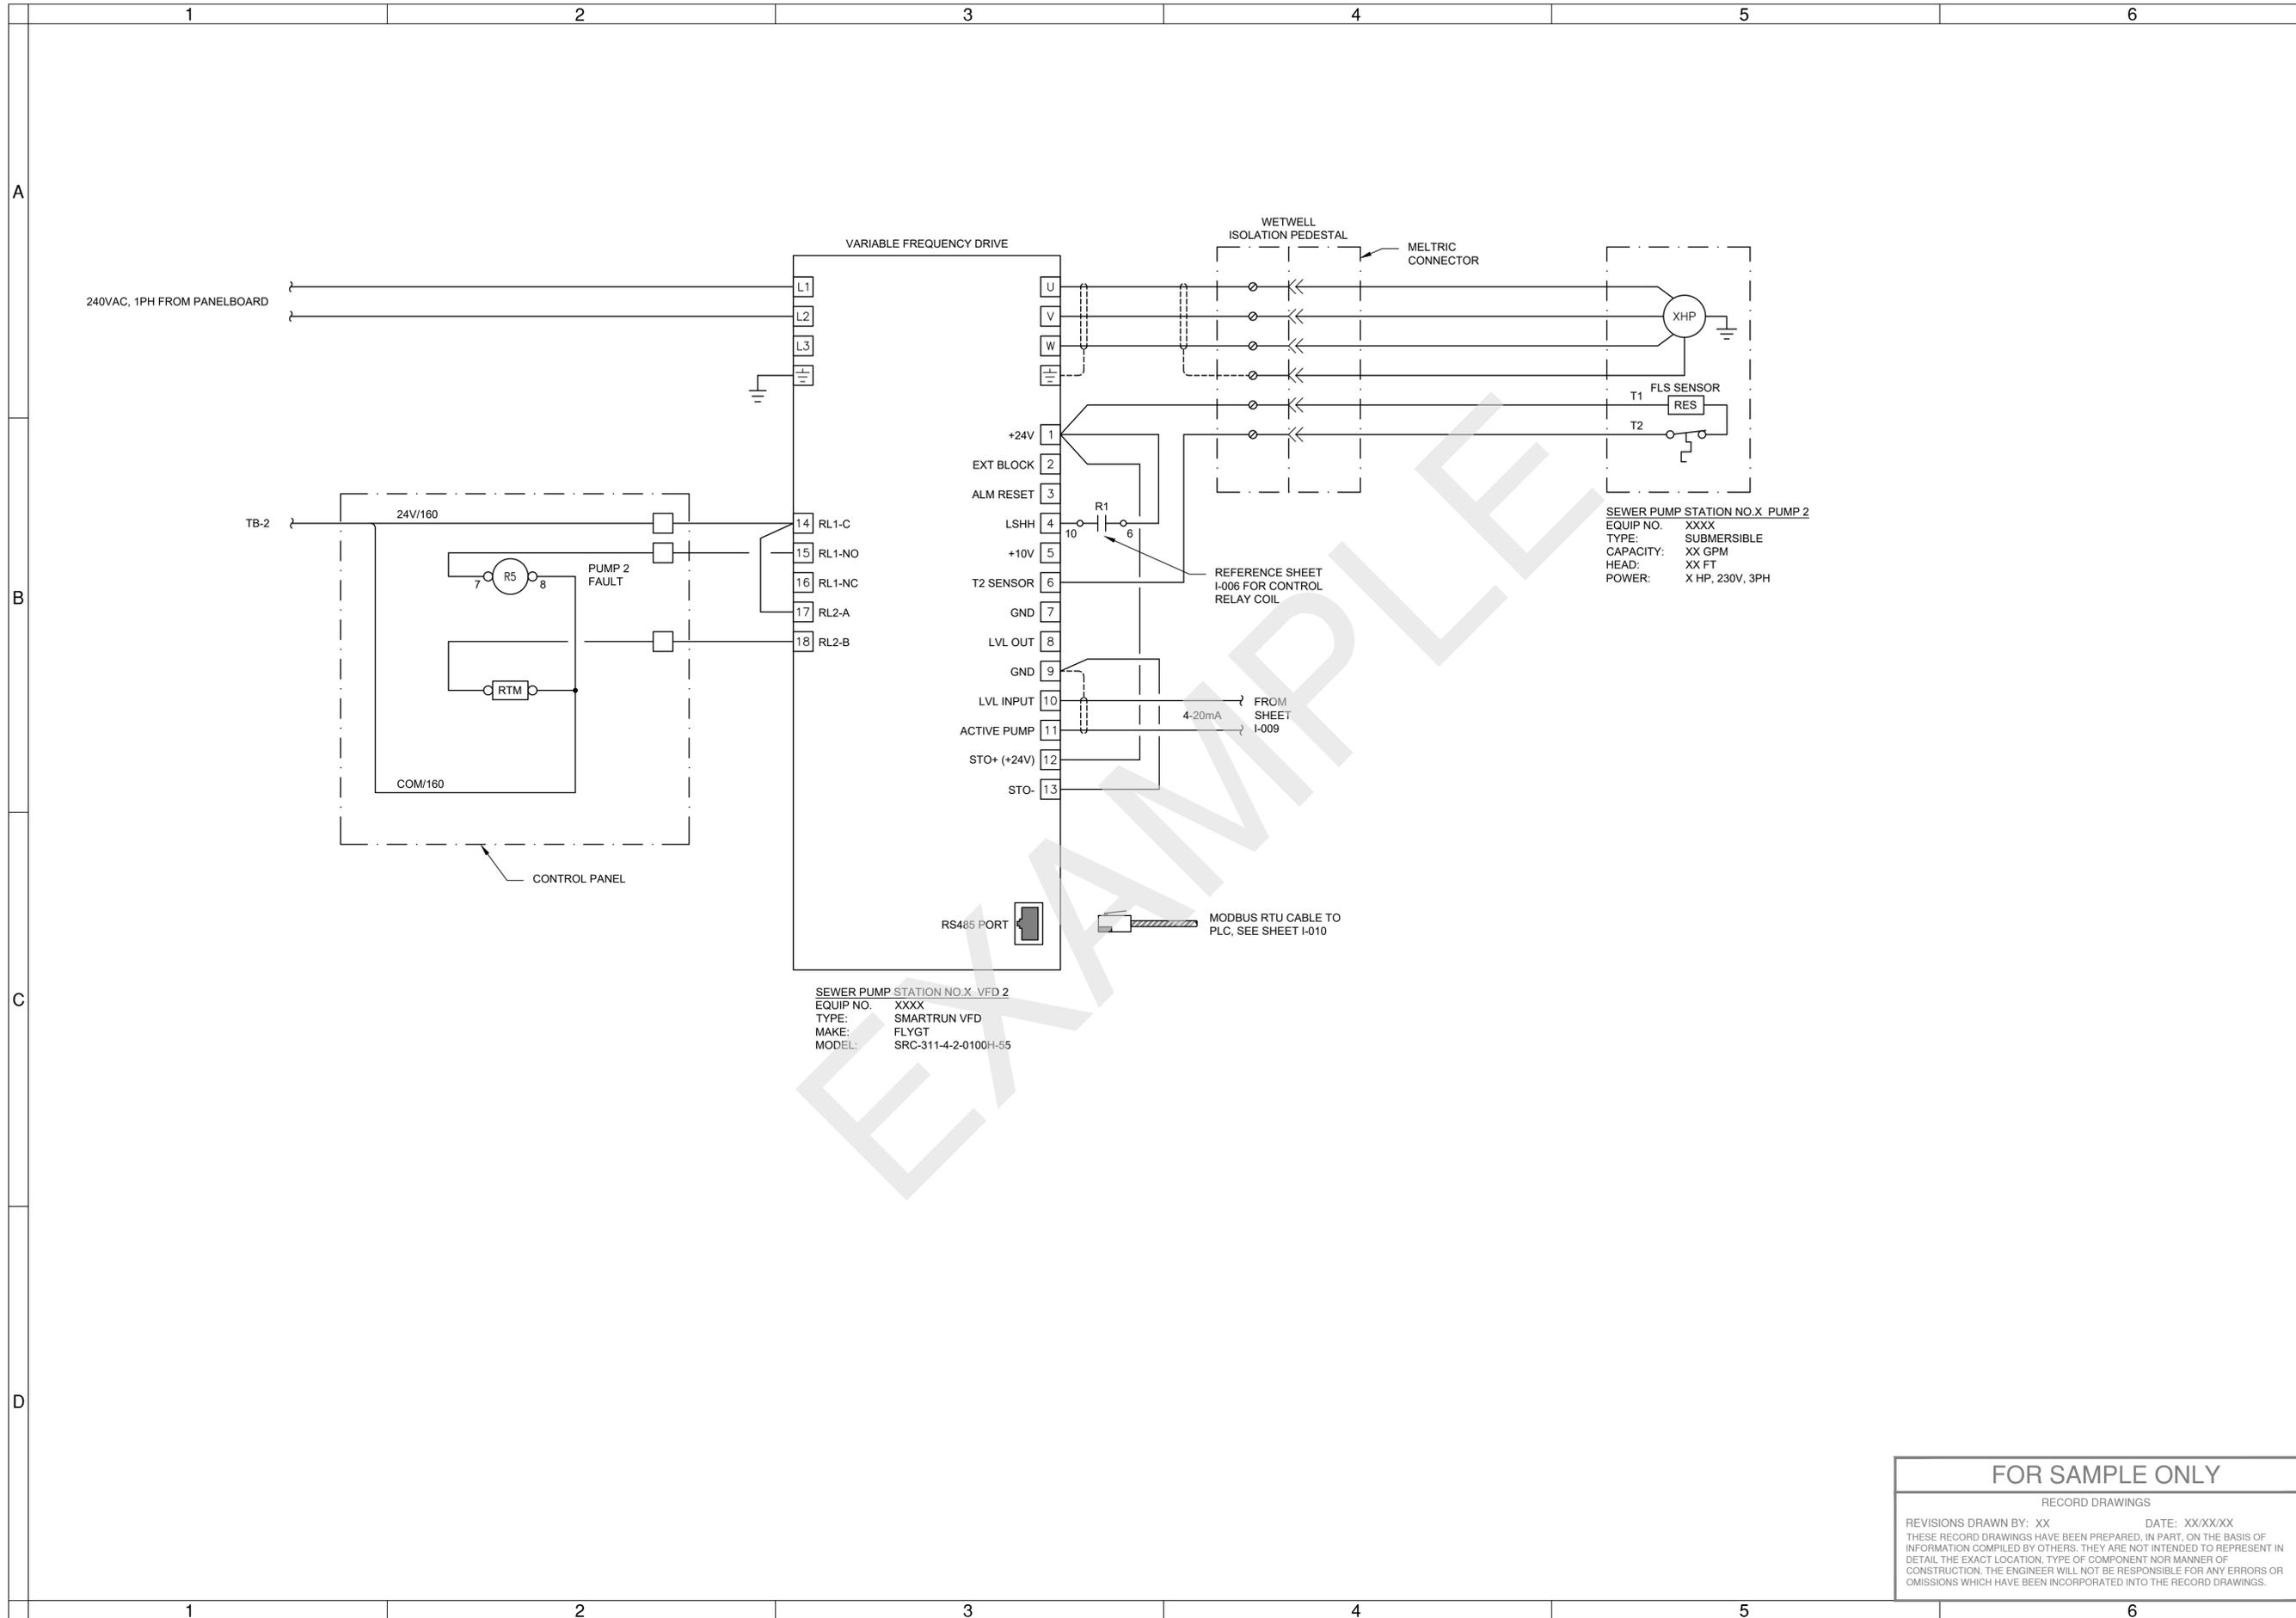


SEWER PUMP STATION NO.X VFD 2
 EQUIP NO. XXXX
 TYPE: SMARTRUN VFD
 MAKE: FLYGT
 MODEL: SRC-311-4-2-0100H-55

SEWER PUMP STATION NO.X PUMP 2
 EQUIP NO. XXXX
 TYPE: SUBMERSIBLE
 CAPACITY: XX GPM
 HEAD: XX FT
 POWER: X HP, 230V, 3PH

STAMP
 [ENGINEERS]

(PROJECT NAME)
 SEWER PUMP STATION NO. X
 PUMP 2 WIRING DIAGRAM
 DESCHUTES COUNTY, OREGON

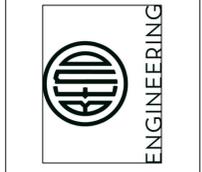

REVISIONS:

[COMPANY NAME]
 [COMPANY ADDRESS
 AND PHONE NUMBER]

DESIGNED BY: _____
 DRAWN BY: _____
 SCALE: _____
 FILE: _____
 DATE: _____

VERIFY SCALES
 0 1"
 BAR EQUALS ONE INCH
 ON ORIGINAL DRAWING



SHEET:
E-008
 COB # (XXXXXX)

FOR SAMPLE ONLY
 RECORD DRAWINGS
 REVISIONS DRAWN BY: XX DATE: XX/XX/XX
 THESE RECORD DRAWINGS HAVE BEEN PREPARED, IN PART, ON THE BASIS OF
 INFORMATION COMPILED BY OTHERS. THEY ARE NOT INTENDED TO REPRESENT IN
 DETAIL THE EXACT LOCATION, TYPE OF COMPONENT NOR MANNER OF
 CONSTRUCTION. THE ENGINEER WILL NOT BE RESPONSIBLE FOR ANY ERRORS OR
 OMISSIONS WHICH HAVE BEEN INCORPORATED INTO THE RECORD DRAWINGS.

FIELD

INSTRUMENT CONTROL PANEL
WXXX-ICP-XXX

SYSTEM CONFIGURATION

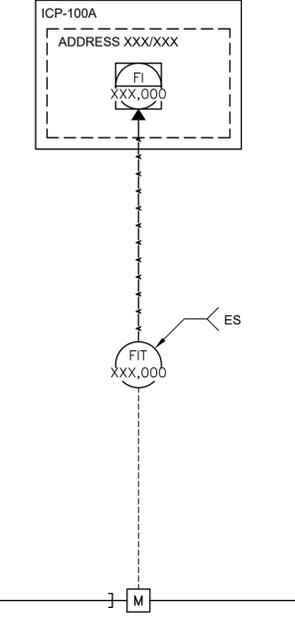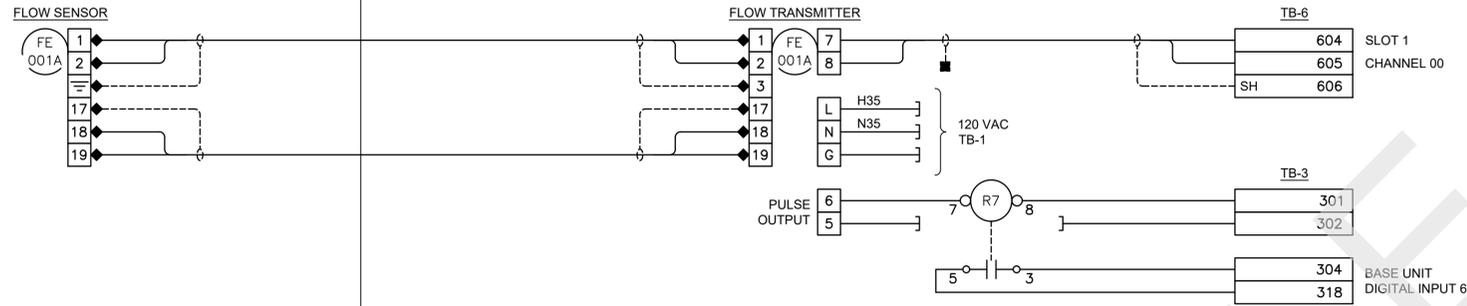

REFERENCES

GENERAL NOTES:

- USE WIRE NUT TO EXTEND SHIELD TO INSTRUMENT GROUND.

LEGEND:

- ◆ CONTRACTOR TERMINATIONS (12 TERMINATIONS)
- ISOLATION VALVE
- ⊥ CUT AND TAPE SHIELD

OPERATOR DISPLAY


TAG NAME: WXXX-XXX-XXX-XXX
 FUNCTION: PRESSURE INDICATION
 SCALE: 0-XXX PSI
 ACTION: N/A
 GRAPHIC: TBD

FOR SAMPLE ONLY

RECORD DRAWINGS
 REVISIONS DRAWN BY: XX DATE: XX/XX/XX
 THESE RECORD DRAWINGS HAVE BEEN PREPARED, IN PART, ON THE BASIS OF INFORMATION COMPILED BY OTHERS. THEY ARE NOT INTENDED TO REPRESENT IN DETAIL THE EXACT LOCATION, TYPE OF COMPONENT NOR MANNER OF CONSTRUCTION. THE ENGINEER WILL NOT BE RESPONSIBLE FOR ANY ERRORS OR OMISSIONS WHICH HAVE BEEN INCORPORATED INTO THE RECORD DRAWINGS.

STAMP
[ENGINEERS]

(PROJECT NAME)
 INSTRUMENTATION & CONTROLS
 PUMP STATION FLOW LOOP SHEET
 DESCHUTES COUNTY, OREGON

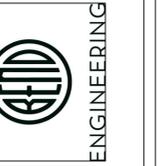

REVISIONS:


[COMPANY NAME]
 [COMPANY ADDRESS
 AND PHONE NUMBER]

DESIGNED BY:
 DRAWN BY:
 SCALE:
 FILE:
 DATE:

VERIFY SCALES
 0 1"
 BAR EQUALS ONE INCH
 ON ORIGINAL DRAWING

SHEET:
E-009

COB # (XXXXXX)

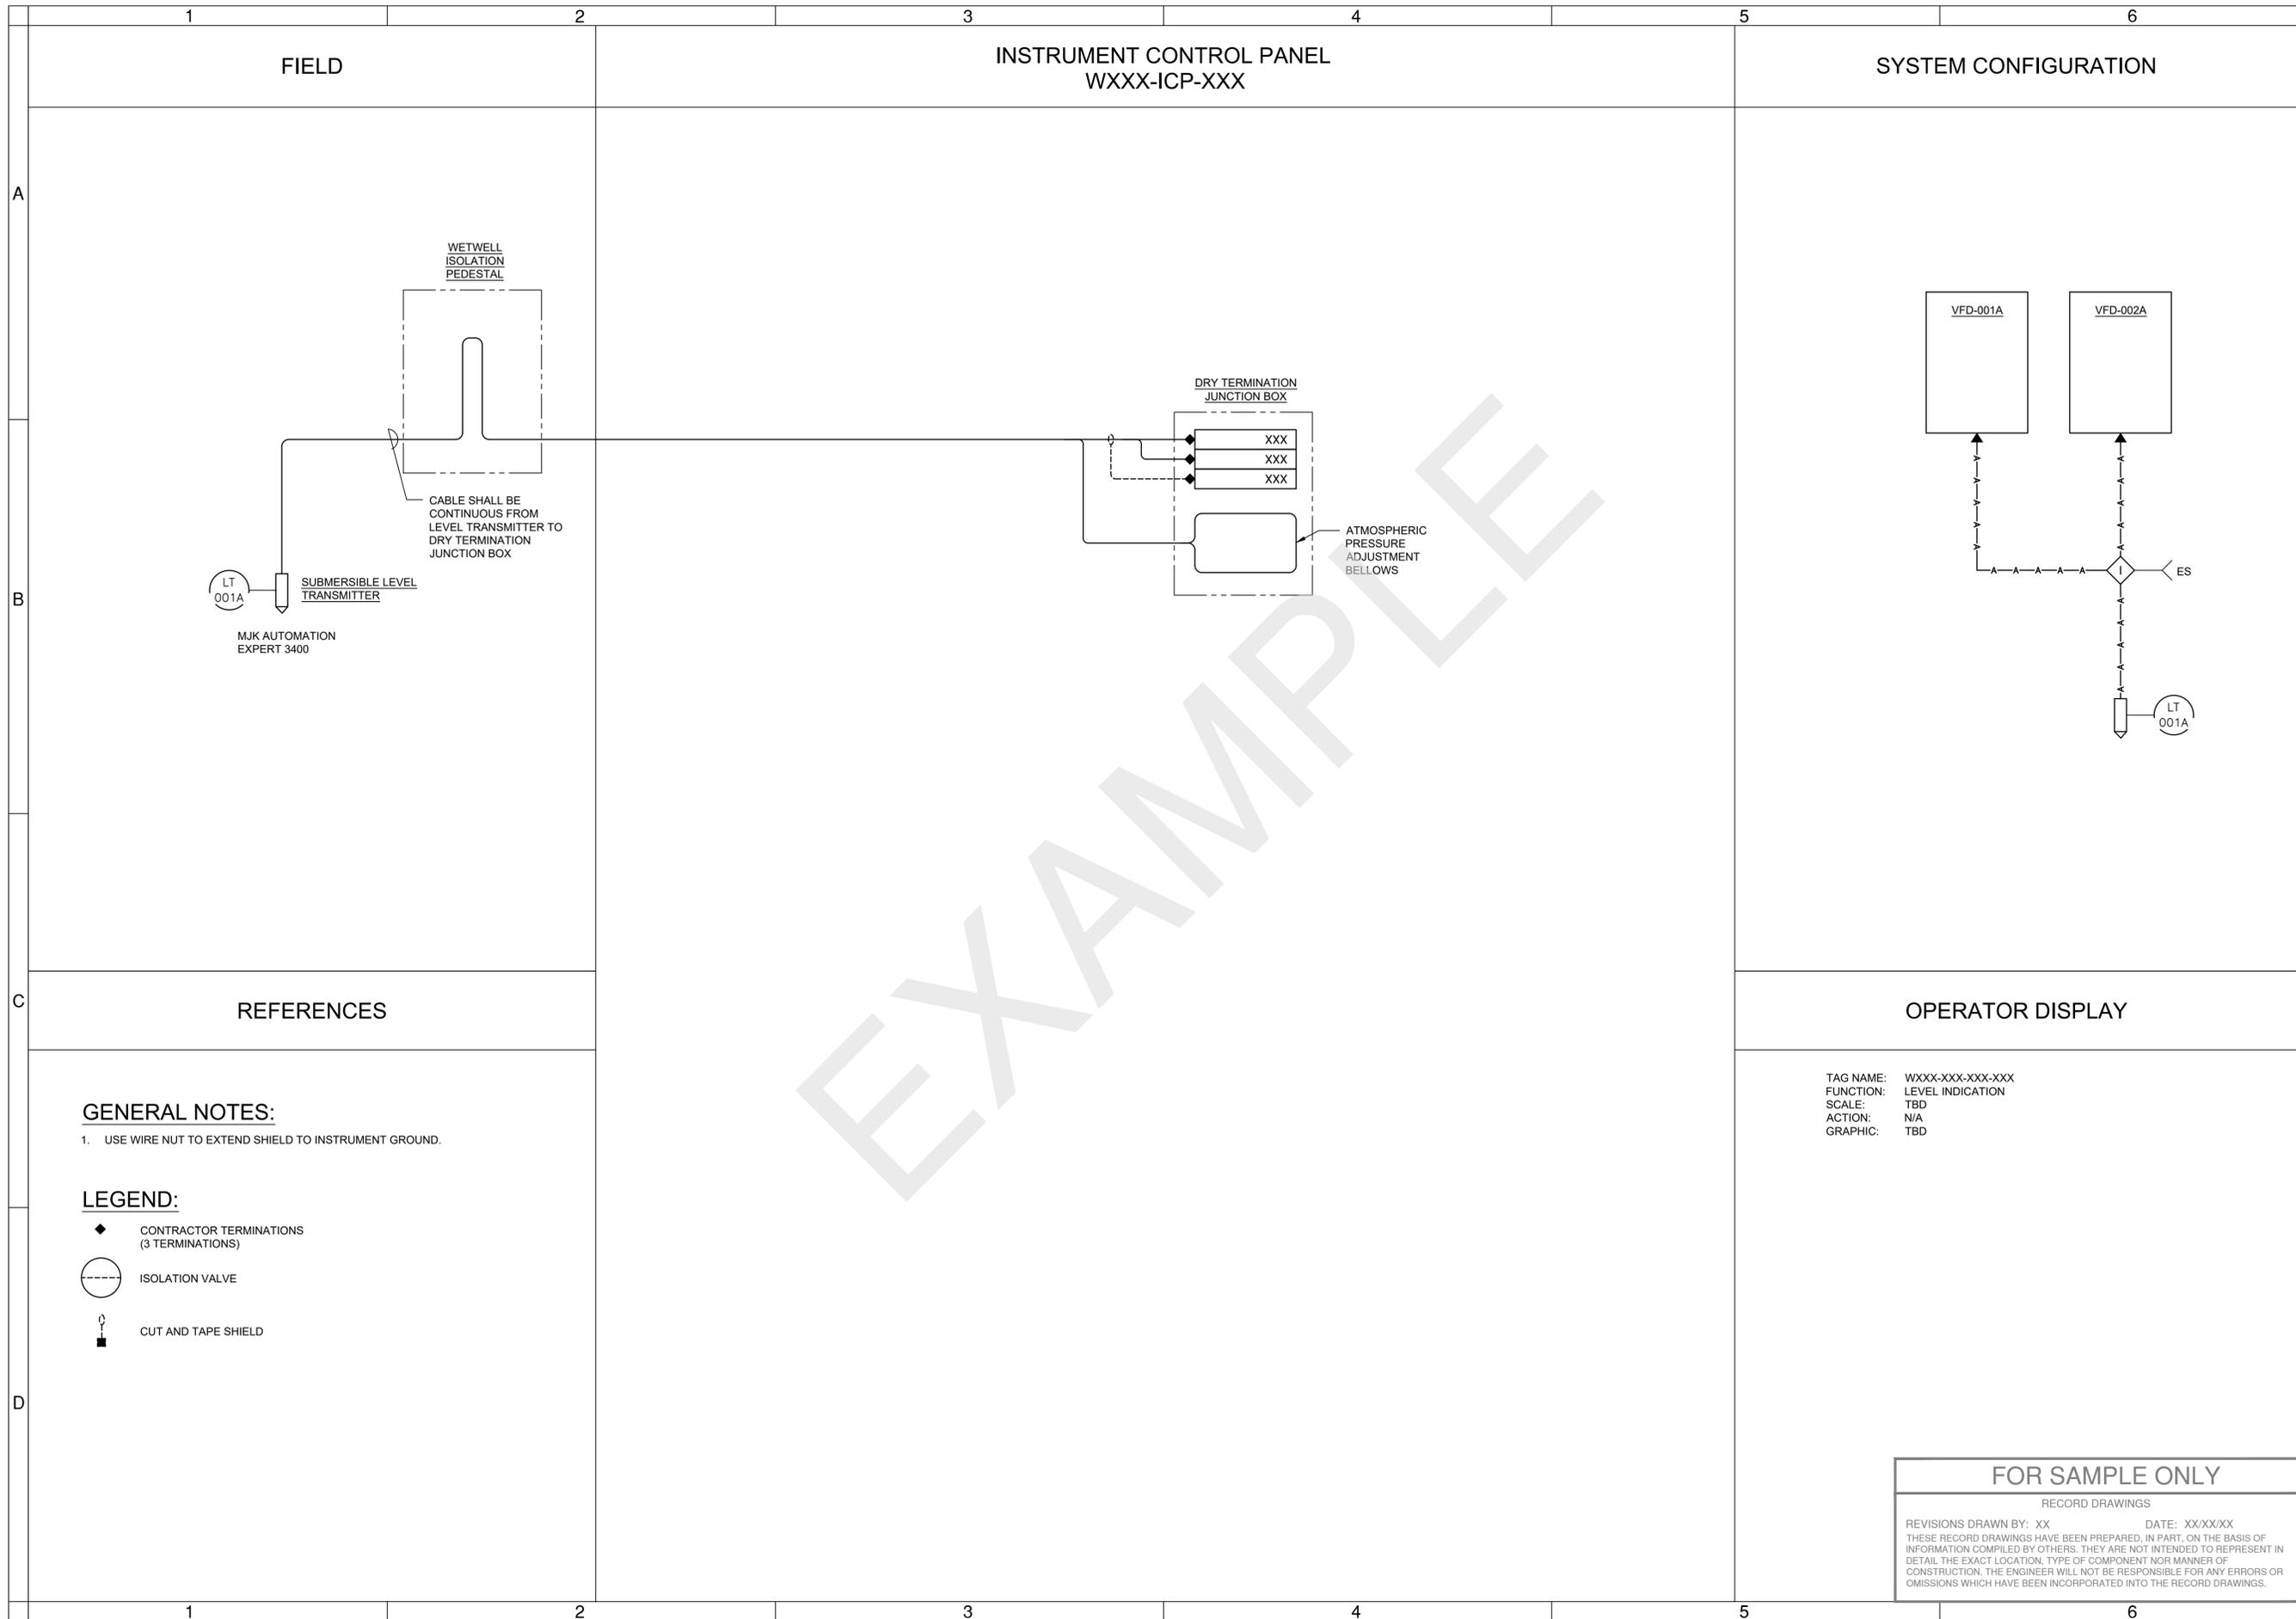

STAMP
[ENGINEERS]

(PROJECT NAME)
INSTRUMENTATION & CONTROLS
WETWELL LEVEL LOOP SHEET
DESCHUTES COUNTY, OREGON



REVISIONS:

[COMPANY NAME]
[COMPANY ADDRESS
AND PHONE NUMBER]

DESIGNED BY: _____
DRAWN BY: _____
SCALE: _____
FILE: _____
DATE: _____

VERIFY SCALES
0 1"
BAR EQUALS ONE INCH
ON ORIGINAL DRAWING

SHEET:
E-010
COB # (XXXXXX)

GENERAL NOTES:
1. USE WIRE NUT TO EXTEND SHIELD TO INSTRUMENT GROUND.


LEGEND:

- ◆ CONTRACTOR TERMINATIONS (3 TERMINATIONS)
- ISOLATION VALVE
- CUT AND TAPE SHIELD

TAG NAME: WXXX-XXX-XXX-XXX
FUNCTION: LEVEL INDICATION
SCALE: TBD
ACTION: N/A
GRAPHIC: TBD

OPERATOR DISPLAY

FOR SAMPLE ONLY
RECORD DRAWINGS
REVISIONS DRAWN BY: XX DATE: XX/XX/XX
THESE RECORD DRAWINGS HAVE BEEN PREPARED, IN PART, ON THE BASIS OF INFORMATION COMPILED BY OTHERS. THEY ARE NOT INTENDED TO REPRESENT IN DETAIL THE EXACT LOCATION, TYPE OF COMPONENT NOR MANNER OF CONSTRUCTION. THE ENGINEER WILL NOT BE RESPONSIBLE FOR ANY ERRORS OR OMISSIONS WHICH HAVE BEEN INCORPORATED INTO THE RECORD DRAWINGS.

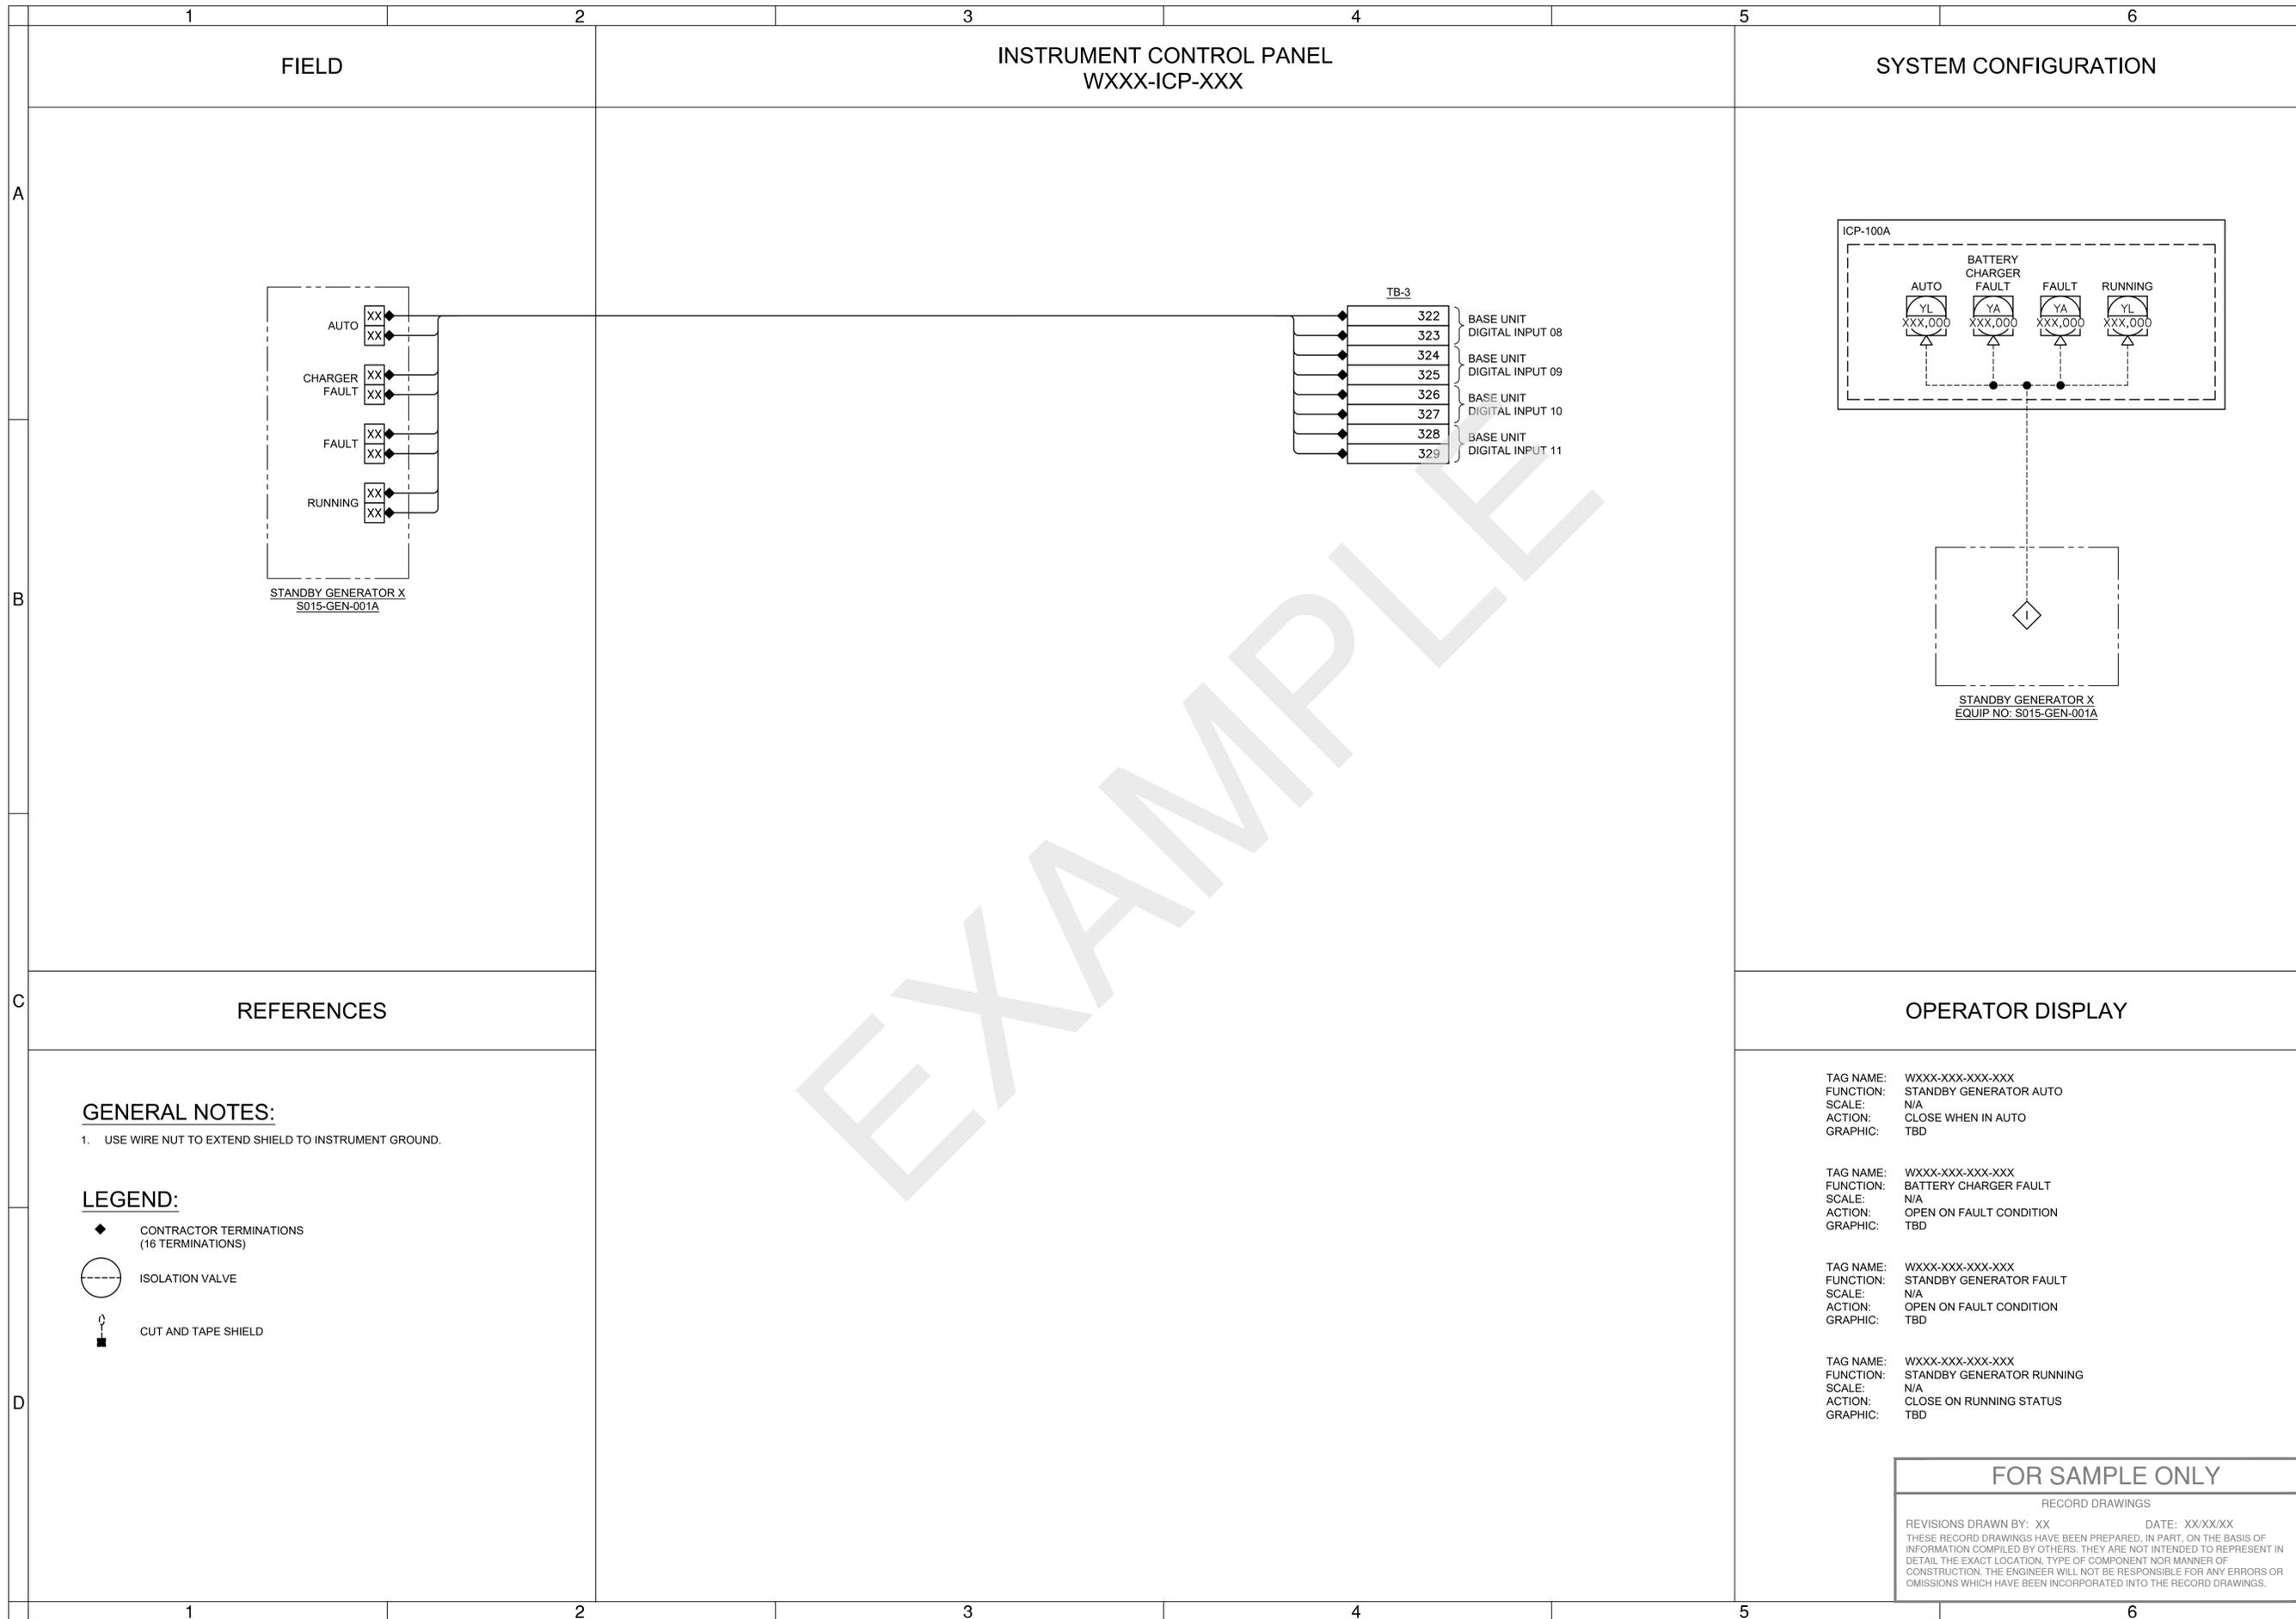

REFERENCES

GENERAL NOTES:

- 1. USE WIRE NUT TO EXTEND SHIELD TO INSTRUMENT GROUND.

LEGEND:

- ◆ CONTRACTOR TERMINATIONS (16 TERMINATIONS)
- ISOLATION VALVE
- ⊥ CUT AND TAPE SHIELD

OPERATOR DISPLAY

- TAG NAME: WXXX-XXX-XXX-XXX
FUNCTION: STANDBY GENERATOR AUTO
SCALE: N/A
ACTION: CLOSE WHEN IN AUTO
GRAPHIC: TBD
- TAG NAME: WXXX-XXX-XXX-XXX
FUNCTION: BATTERY CHARGER FAULT
SCALE: N/A
ACTION: OPEN ON FAULT CONDITION
GRAPHIC: TBD
- TAG NAME: WXXX-XXX-XXX-XXX
FUNCTION: STANDBY GENERATOR FAULT
SCALE: N/A
ACTION: OPEN ON FAULT CONDITION
GRAPHIC: TBD
- TAG NAME: WXXX-XXX-XXX-XXX
FUNCTION: STANDBY GENERATOR RUNNING
SCALE: N/A
ACTION: CLOSE ON RUNNING STATUS
GRAPHIC: TBD

FOR SAMPLE ONLY

RECORD DRAWINGS

REVISIONS DRAWN BY: XX DATE: XX/XX/XX
 THESE RECORD DRAWINGS HAVE BEEN PREPARED, IN PART, ON THE BASIS OF INFORMATION COMPILED BY OTHERS. THEY ARE NOT INTENDED TO REPRESENT IN DETAIL THE EXACT LOCATION, TYPE OF COMPONENT NOR MANNER OF CONSTRUCTION. THE ENGINEER WILL NOT BE RESPONSIBLE FOR ANY ERRORS OR OMISSIONS WHICH HAVE BEEN INCORPORATED INTO THE RECORD DRAWINGS.

STAMP
[ENGINEERS]

(PROJECT NAME)
INSTRUMENTATION & CONTROLS
STANDBY GENERATOR LOOP SHEET
DESCHUTES COUNTY, OREGON

[COMPANY NAME]
[COMPANY ADDRESS
AND PHONE NUMBER]

DESIGNED BY: _____
DRAWN BY: _____
SCALE: _____
FILE: _____
DATE: _____

VERIFY SCALES
0 1"
BAR EQUALS ONE INCH
ON ORIGINAL DRAWING




SHEET:
E-011

COB # (XXXXXX)

FIELD

INSTRUMENT CONTROL PANEL
WXXX-ICP-XXX

SYSTEM CONFIGURATION

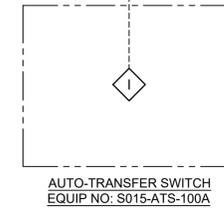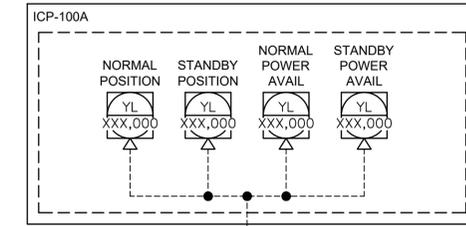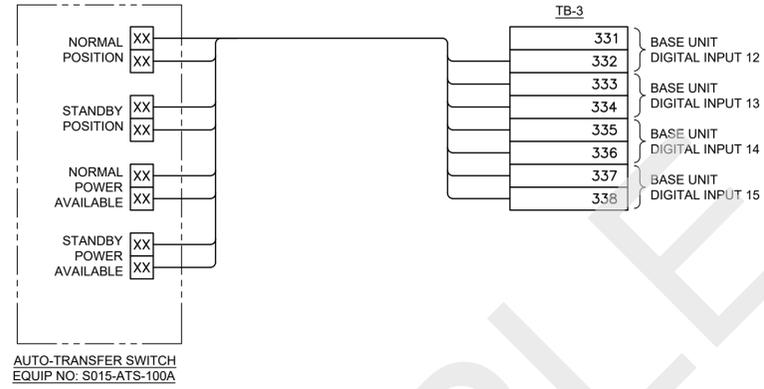

REFERENCES

GENERAL NOTES:

- USE WIRE NUT TO EXTEND SHIELD TO INSTRUMENT GROUND.

LEGEND:

- ◆ CONTRACTOR TERMINATIONS (0 TERMINATIONS)
- ISOLATION VALVE
- ⊥ CUT AND TAPE SHIELD

OPERATOR DISPLAY

- TAG NAME: WXXX-XXX-XXX-XXX
FUNCTION: ATS NORMAL POSITION
SCALE: N/A
ACTION: CLOSE WHEN IN NORMAL POSITION
GRAPHIC: TBD
- TAG NAME: WXXX-XXX-XXX-XXX
FUNCTION: ATS STANDBY POSITION
SCALE: N/A
ACTION: CLOSE WHEN IN STANDBY POSITION
GRAPHIC: TBD
- TAG NAME: WXXX-XXX-XXX-XXX
FUNCTION: NORMAL POWER AVAILABLE
SCALE: N/A
ACTION: CLOSE WHEN NORMAL POWER AVAILABLE
GRAPHIC: TBD
- TAG NAME: WXXX-XXX-XXX-XXX
FUNCTION: STANDBY POWER AVAILABLE
SCALE: N/A
ACTION: CLOSE WHEN STANDBY POWER AVAILABLE
GRAPHIC: TBD

FOR SAMPLE ONLY

RECORD DRAWINGS
REVISIONS DRAWN BY: XX DATE: XX/XX/XX
THESE RECORD DRAWINGS HAVE BEEN PREPARED, IN PART, ON THE BASIS OF INFORMATION COMPILED BY OTHERS. THEY ARE NOT INTENDED TO REPRESENT IN DETAIL THE EXACT LOCATION, TYPE OF COMPONENT NOR MANNER OF CONSTRUCTION. THE ENGINEER WILL NOT BE RESPONSIBLE FOR ANY ERRORS OR OMISSIONS WHICH HAVE BEEN INCORPORATED INTO THE RECORD DRAWINGS.

STAMP
[ENGINEERS]

(PROJECT NAME)
INSTRUMENTATION & CONTROLS
AUTO-TRANSFER SWITCH LOOP SHEET
DESCHUTES COUNTY, OREGON



ENGINEERING

REVISIONS:


[COMPANY NAME]
[COMPANY ADDRESS
AND PHONE NUMBER]

DESIGNED BY: _____
DRAWN BY: _____
SCALE: _____
FILE: _____
DATE: _____

VERIFY SCALES
0 1"
BAR EQUALS ONE INCH
ON ORIGINAL DRAWING


SHEET:
E-012

COB # (XXXXXX)

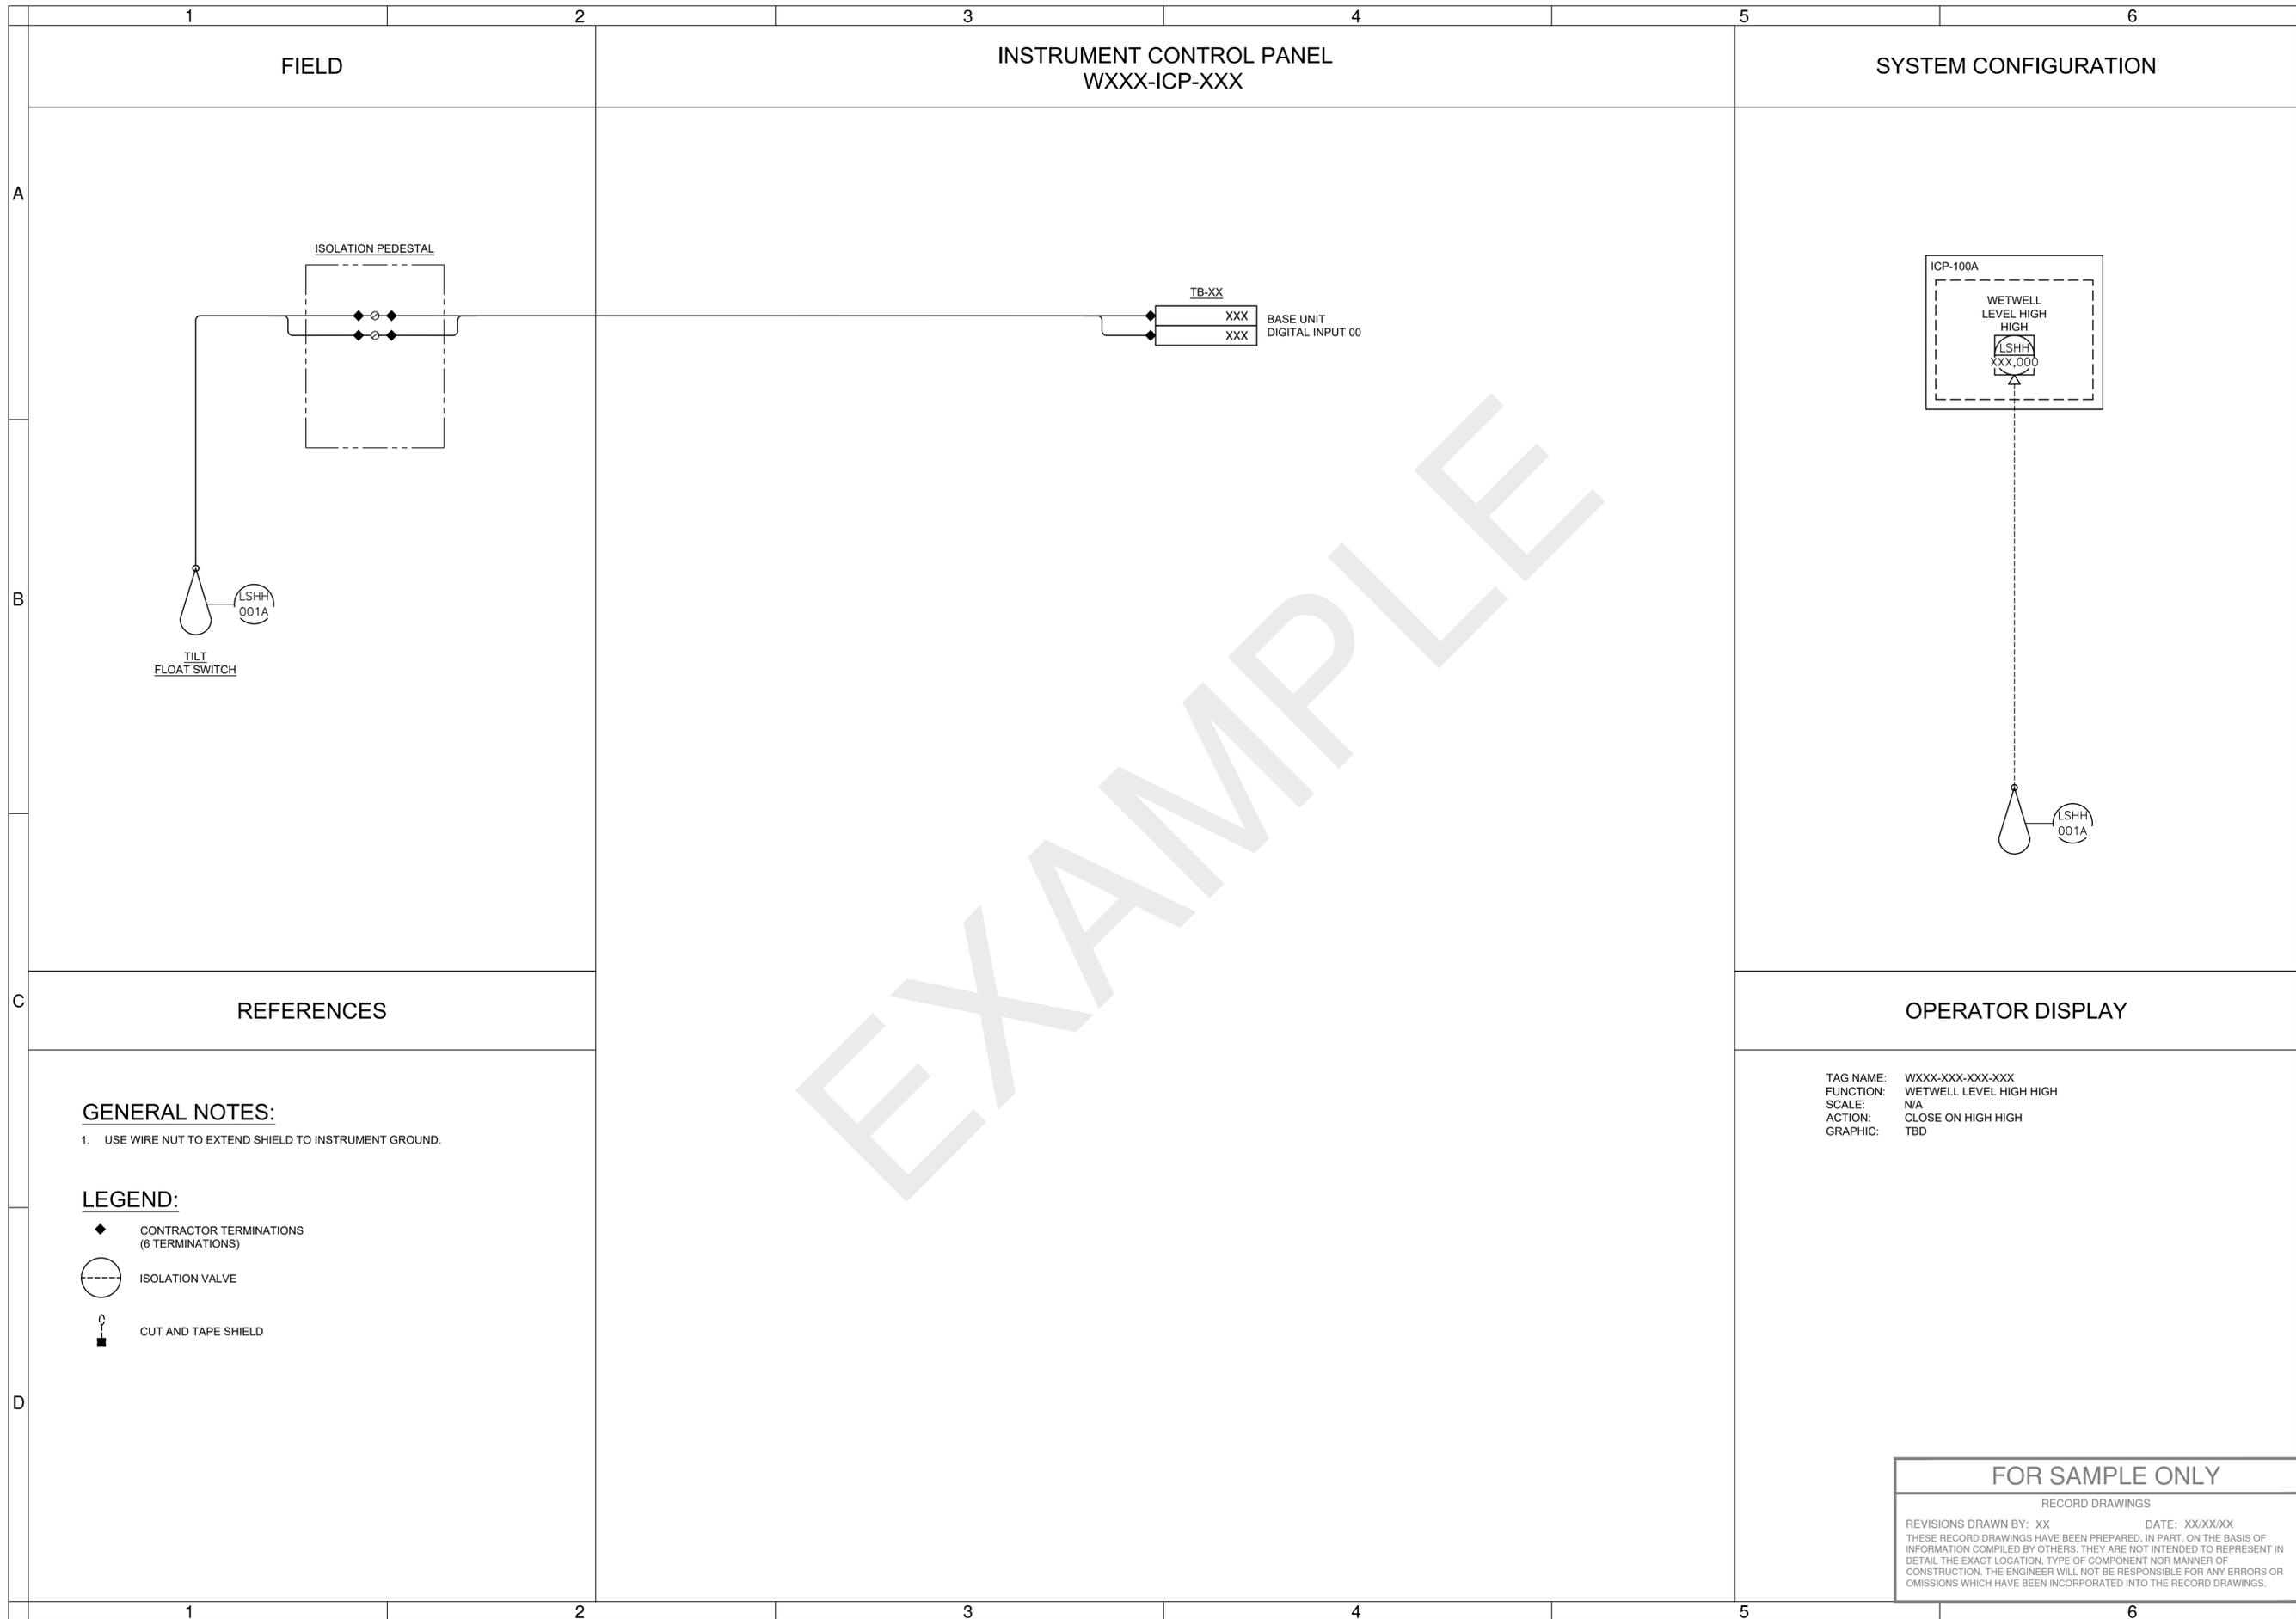

STAMP
[ENGINEERS]

(PROJECT NAME)
INSTRUMENTATION & CONTROLS
WETWELL HIGH HIGH LEVEL LOOP SHEET

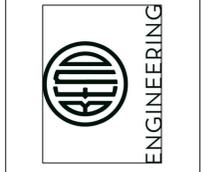

REVISIONS:

[COMPANY NAME]
[COMPANY ADDRESS
AND PHONE NUMBER]



DESIGNED BY:	
DRAWN BY:	
SCALE:	
FILE:	
DATE:	

VERIFY SCALES
0 1"
BAR EQUALS ONE INCH
ON ORIGINAL DRAWING


SHEET:
E-013
COB # (XXXXXX)

OPERATOR DISPLAY

TAG NAME: WXXX-XXX-XXX-XXX
FUNCTION: WETWELL LEVEL HIGH HIGH
SCALE: N/A
ACTION: CLOSE ON HIGH HIGH
GRAPHIC: TBD

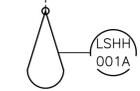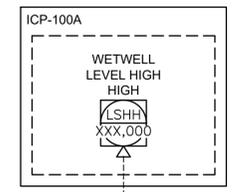

FIELD

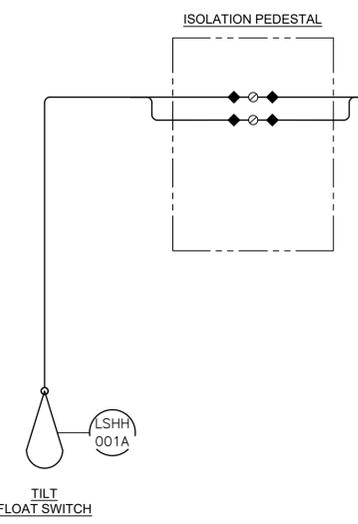

INSTRUMENT CONTROL PANEL
WXXX-ICP-XXX



SYSTEM CONFIGURATION

REFERENCES

GENERAL NOTES:


- USE WIRE NUT TO EXTEND SHIELD TO INSTRUMENT GROUND.

LEGEND:

- ◆ CONTRACTOR TERMINATIONS (6 TERMINATIONS)
- ISOLATION VALVE
- ⊥ CUT AND TAPE SHIELD


FOR SAMPLE ONLY

RECORD DRAWINGS
REVISIONS DRAWN BY: XX DATE: XX/XX/XX
THESE RECORD DRAWINGS HAVE BEEN PREPARED, IN PART, ON THE BASIS OF INFORMATION COMPILED BY OTHERS. THEY ARE NOT INTENDED TO REPRESENT IN DETAIL THE EXACT LOCATION, TYPE OF COMPONENT NOR MANNER OF CONSTRUCTION. THE ENGINEER WILL NOT BE RESPONSIBLE FOR ANY ERRORS OR OMISSIONS WHICH HAVE BEEN INCORPORATED INTO THE RECORD DRAWINGS.

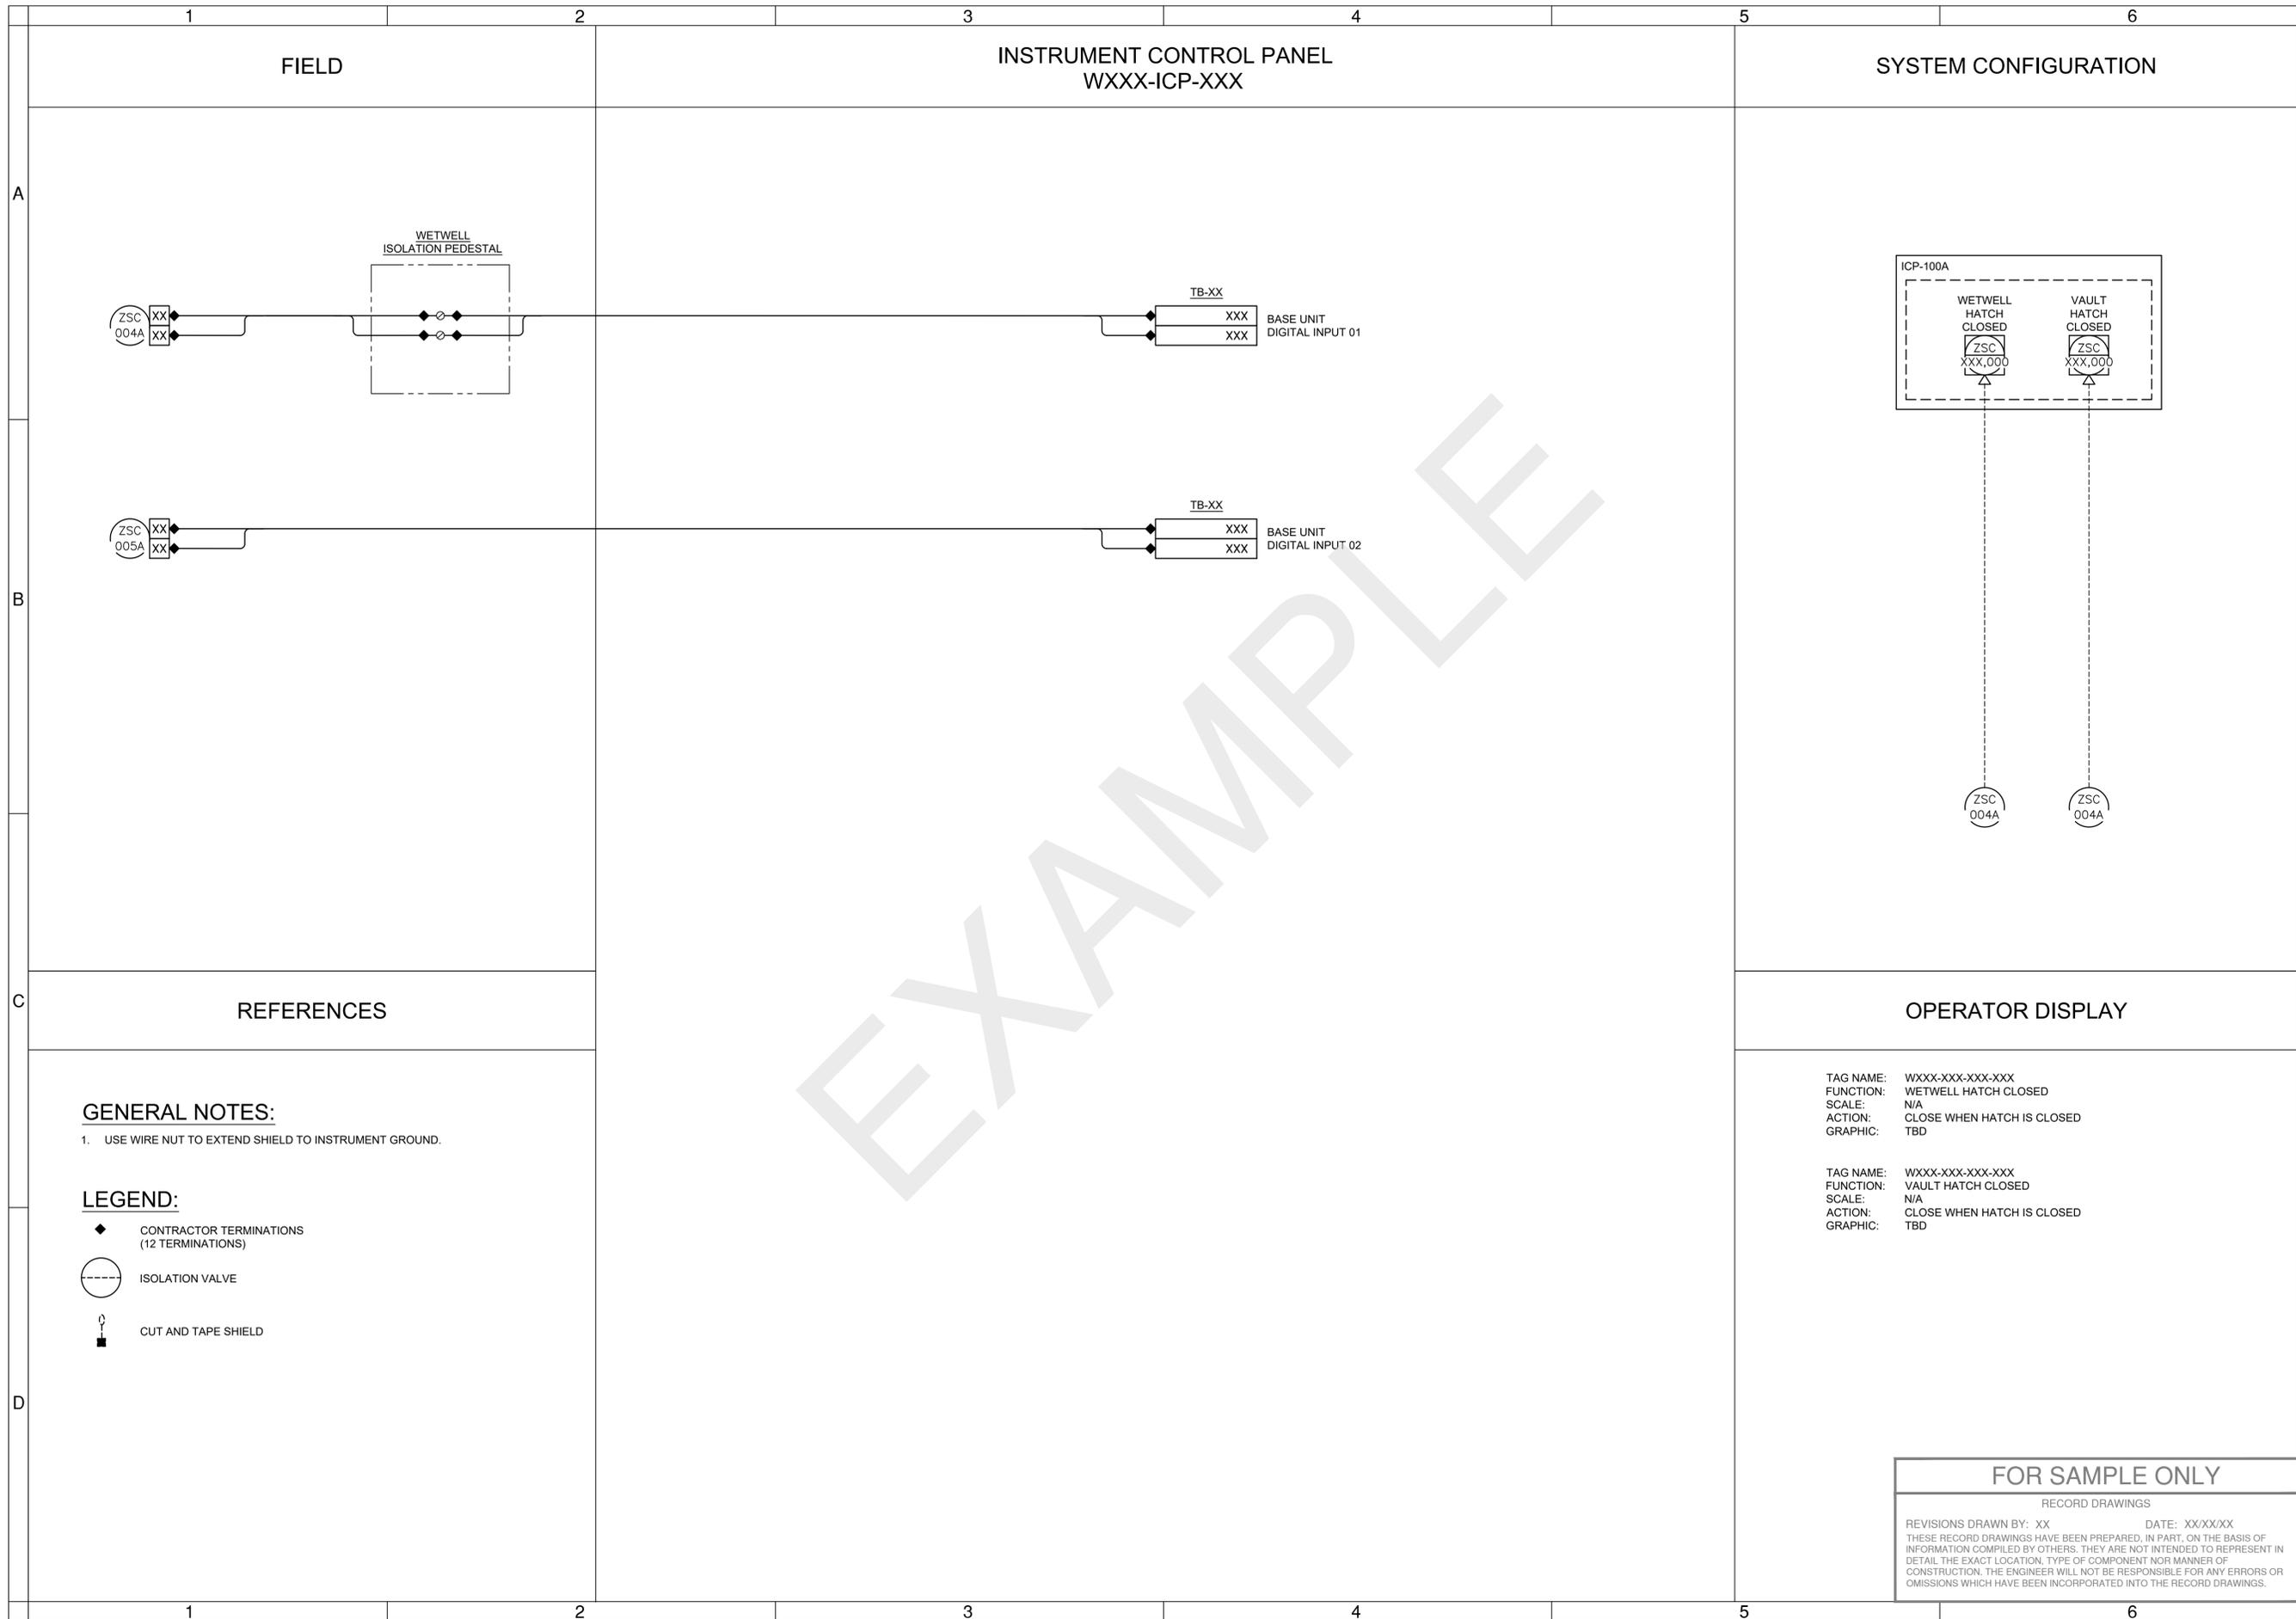

STAMP
[ENGINEERS]

(PROJECT NAME)
INSTRUMENTATION & CONTROLS
HATCH INTRUSION LOOP SHEET

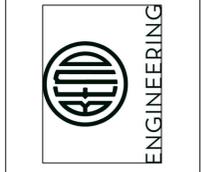

DESCHUTES COUNTY, OREGON

REVISIONS:

[COMPANY NAME]
[COMPANY ADDRESS
AND PHONE NUMBER]

DESIGNED BY: _____
DRAWN BY: _____
SCALE: _____
FILE: _____
DATE: _____

VERIFY SCALES
0 1"
BAR EQUALS ONE INCH
ON ORIGINAL DRAWING

SHEET:
E-014
COB # (XXXXXX)

GENERAL NOTES:

- USE WIRE NUT TO EXTEND SHIELD TO INSTRUMENT GROUND.


LEGEND:

- ◆ CONTRACTOR TERMINATIONS (12 TERMINATIONS)
- ISOLATION VALVE
- ⊥ CUT AND TAPE SHIELD

TAG NAME: WXXX-XXX-XXX-XXX
FUNCTION: WETWELL HATCH CLOSED
SCALE: N/A
ACTION: CLOSE WHEN HATCH IS CLOSED
GRAPHIC: TBD

TAG NAME: WXXX-XXX-XXX-XXX
FUNCTION: VAULT HATCH CLOSED
SCALE: N/A
ACTION: CLOSE WHEN HATCH IS CLOSED
GRAPHIC: TBD

FOR SAMPLE ONLY
RECORD DRAWINGS
REVISIONS DRAWN BY: XX DATE: XX/XX/XX
THESE RECORD DRAWINGS HAVE BEEN PREPARED, IN PART, ON THE BASIS OF INFORMATION COMPILED BY OTHERS. THEY ARE NOT INTENDED TO REPRESENT IN DETAIL THE EXACT LOCATION, TYPE OF COMPONENT NOR MANNER OF CONSTRUCTION. THE ENGINEER WILL NOT BE RESPONSIBLE FOR ANY ERRORS OR OMISSIONS WHICH HAVE BEEN INCORPORATED INTO THE RECORD DRAWINGS.

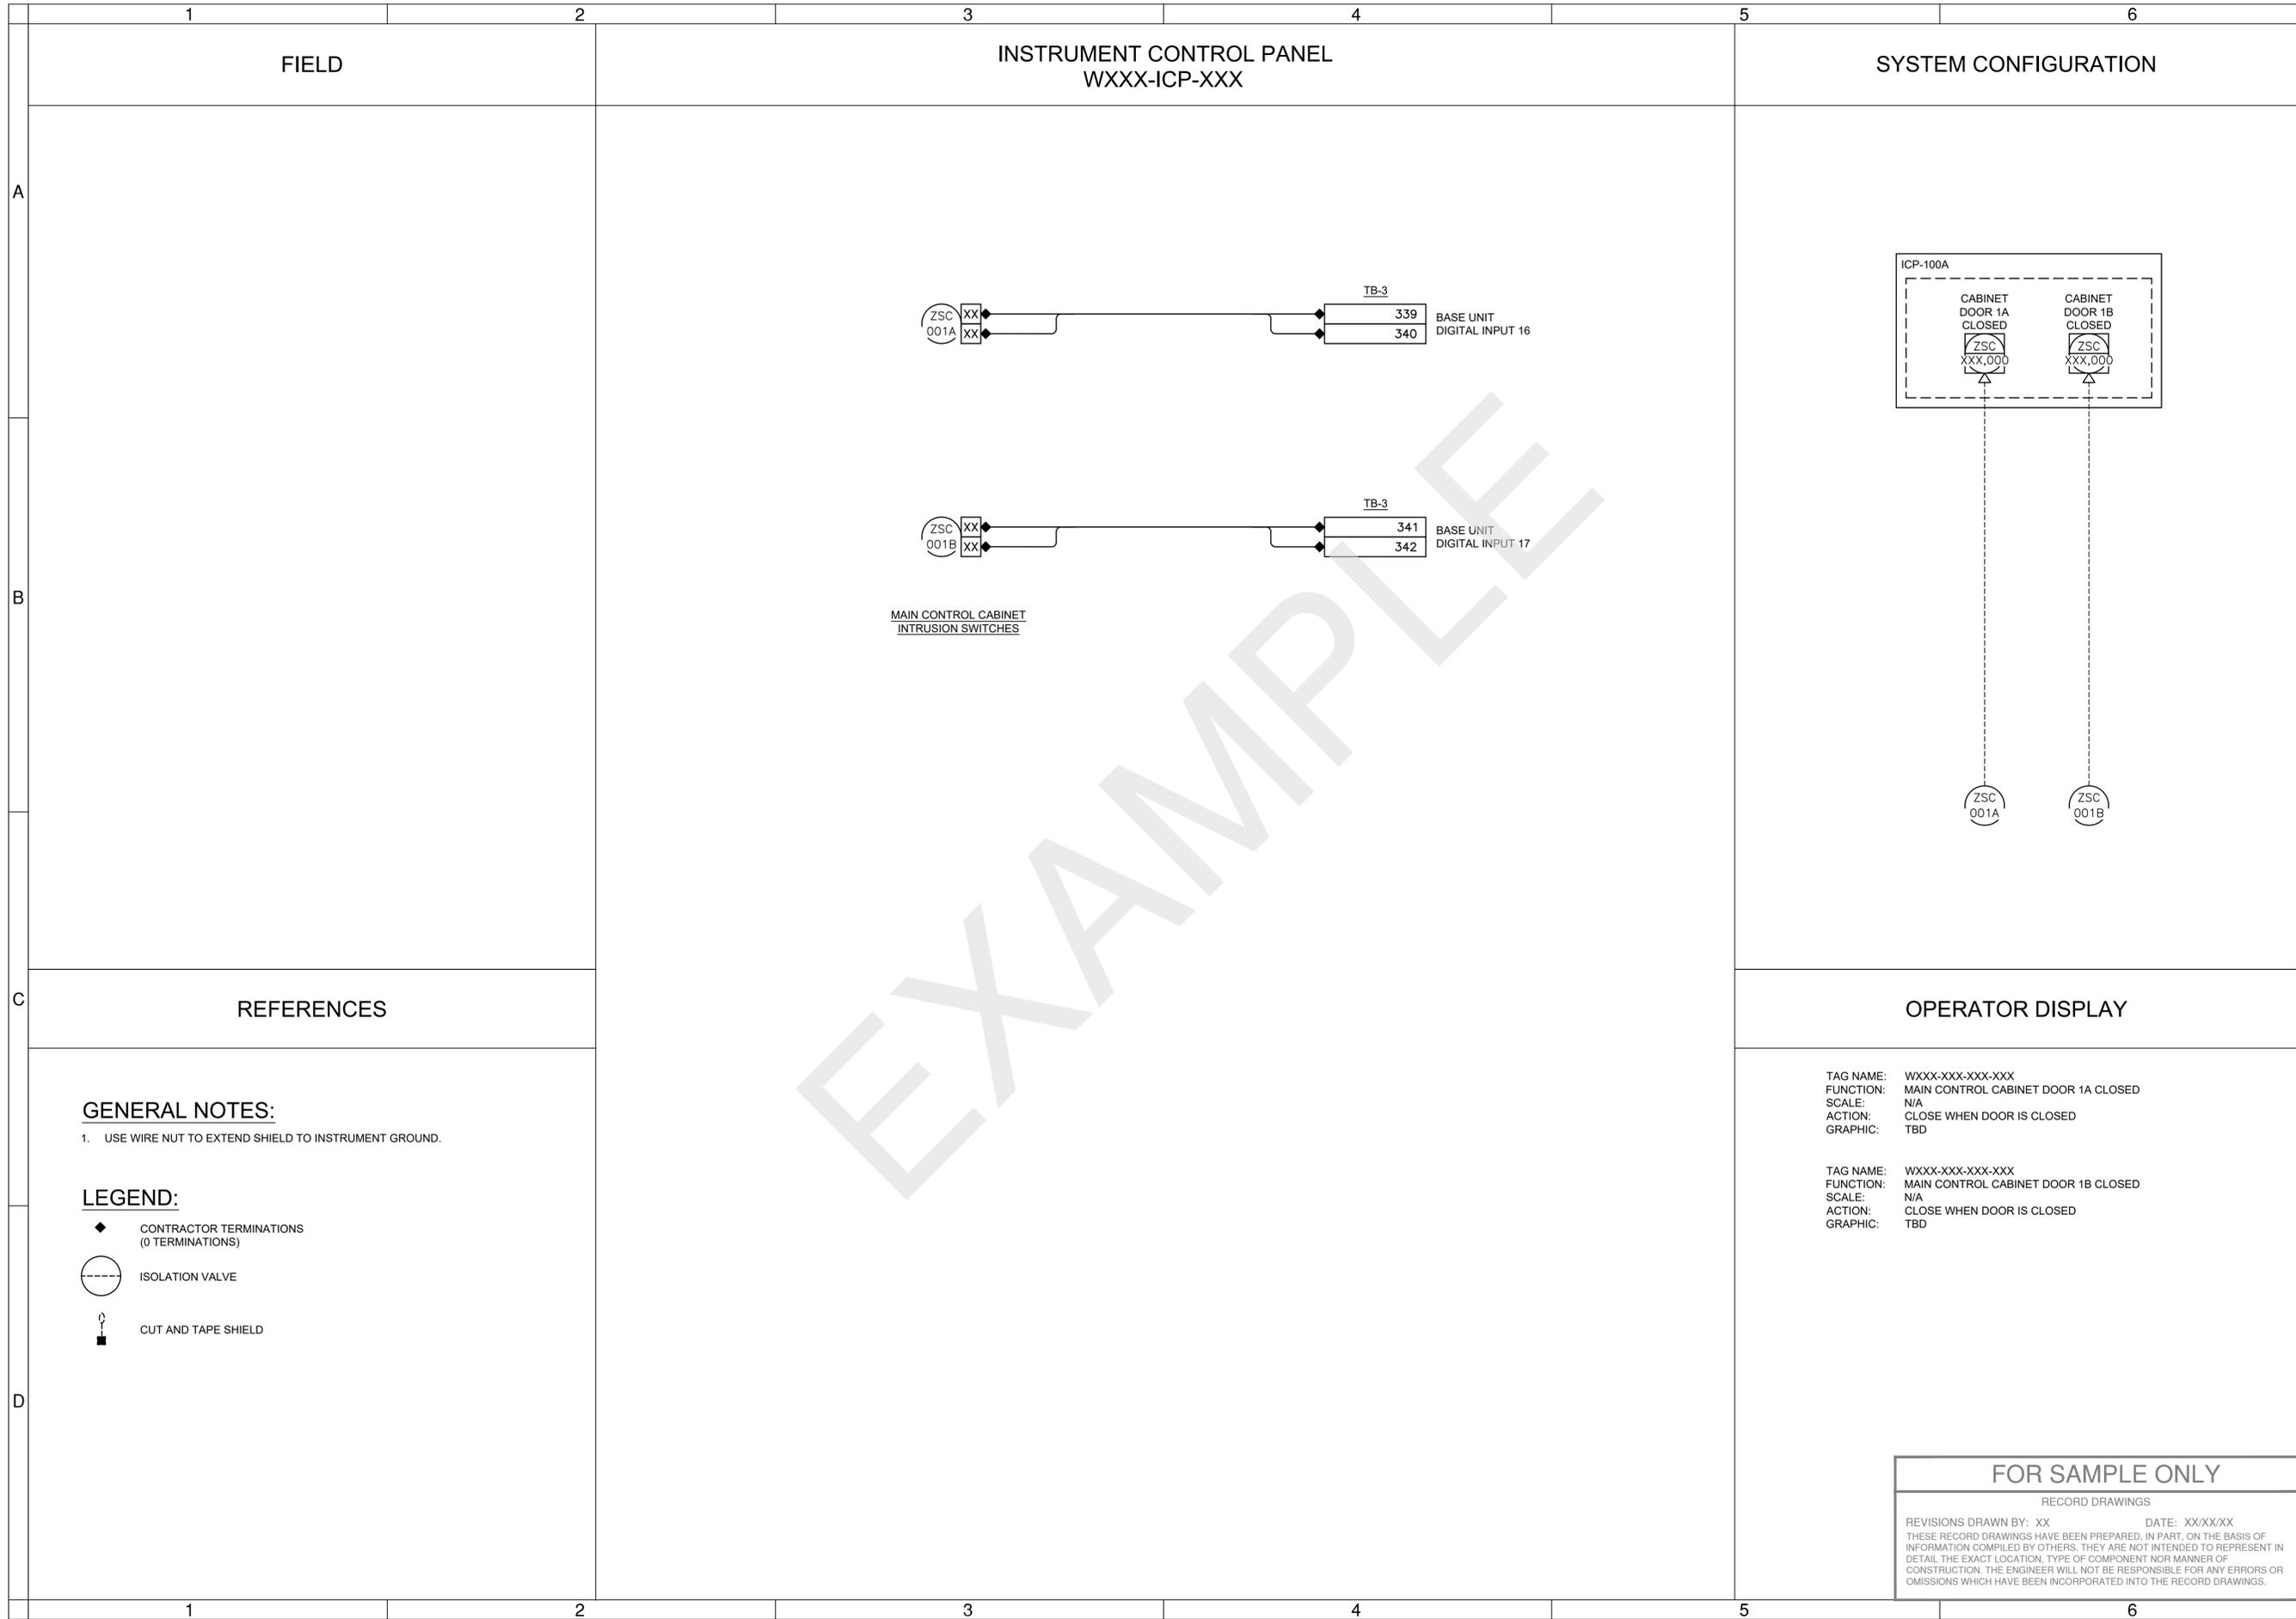

STAMP
[ENGINEERS]

(PROJECT NAME)
INSTRUMENTATION & CONTROLS
MAIN CONTROL CAB INTRUSION LOOP SHEET

DESCHUTES COUNTY, OREGON

ENGINEERING

REVISIONS:

[COMPANY NAME]
[COMPANY ADDRESS AND PHONE NUMBER]


DESIGNED BY: _____
 DRAWN BY: _____
 SCALE: _____
 FILE: _____
 DATE: _____

VERIFY SCALES
 0 1"
 BAR EQUALS ONE INCH ON ORIGINAL DRAWING

SHEET:
E-015


COB # (XXXXXX)

FOR SAMPLE ONLY
 RECORD DRAWINGS
 REVISIONS DRAWN BY: XX DATE: XX/XX/XX
 THESE RECORD DRAWINGS HAVE BEEN PREPARED, IN PART, ON THE BASIS OF INFORMATION COMPILED BY OTHERS. THEY ARE NOT INTENDED TO REPRESENT IN DETAIL THE EXACT LOCATION, TYPE OF COMPONENT NOR MANNER OF CONSTRUCTION. THE ENGINEER WILL NOT BE RESPONSIBLE FOR ANY ERRORS OR OMISSIONS WHICH HAVE BEEN INCORPORATED INTO THE RECORD DRAWINGS.

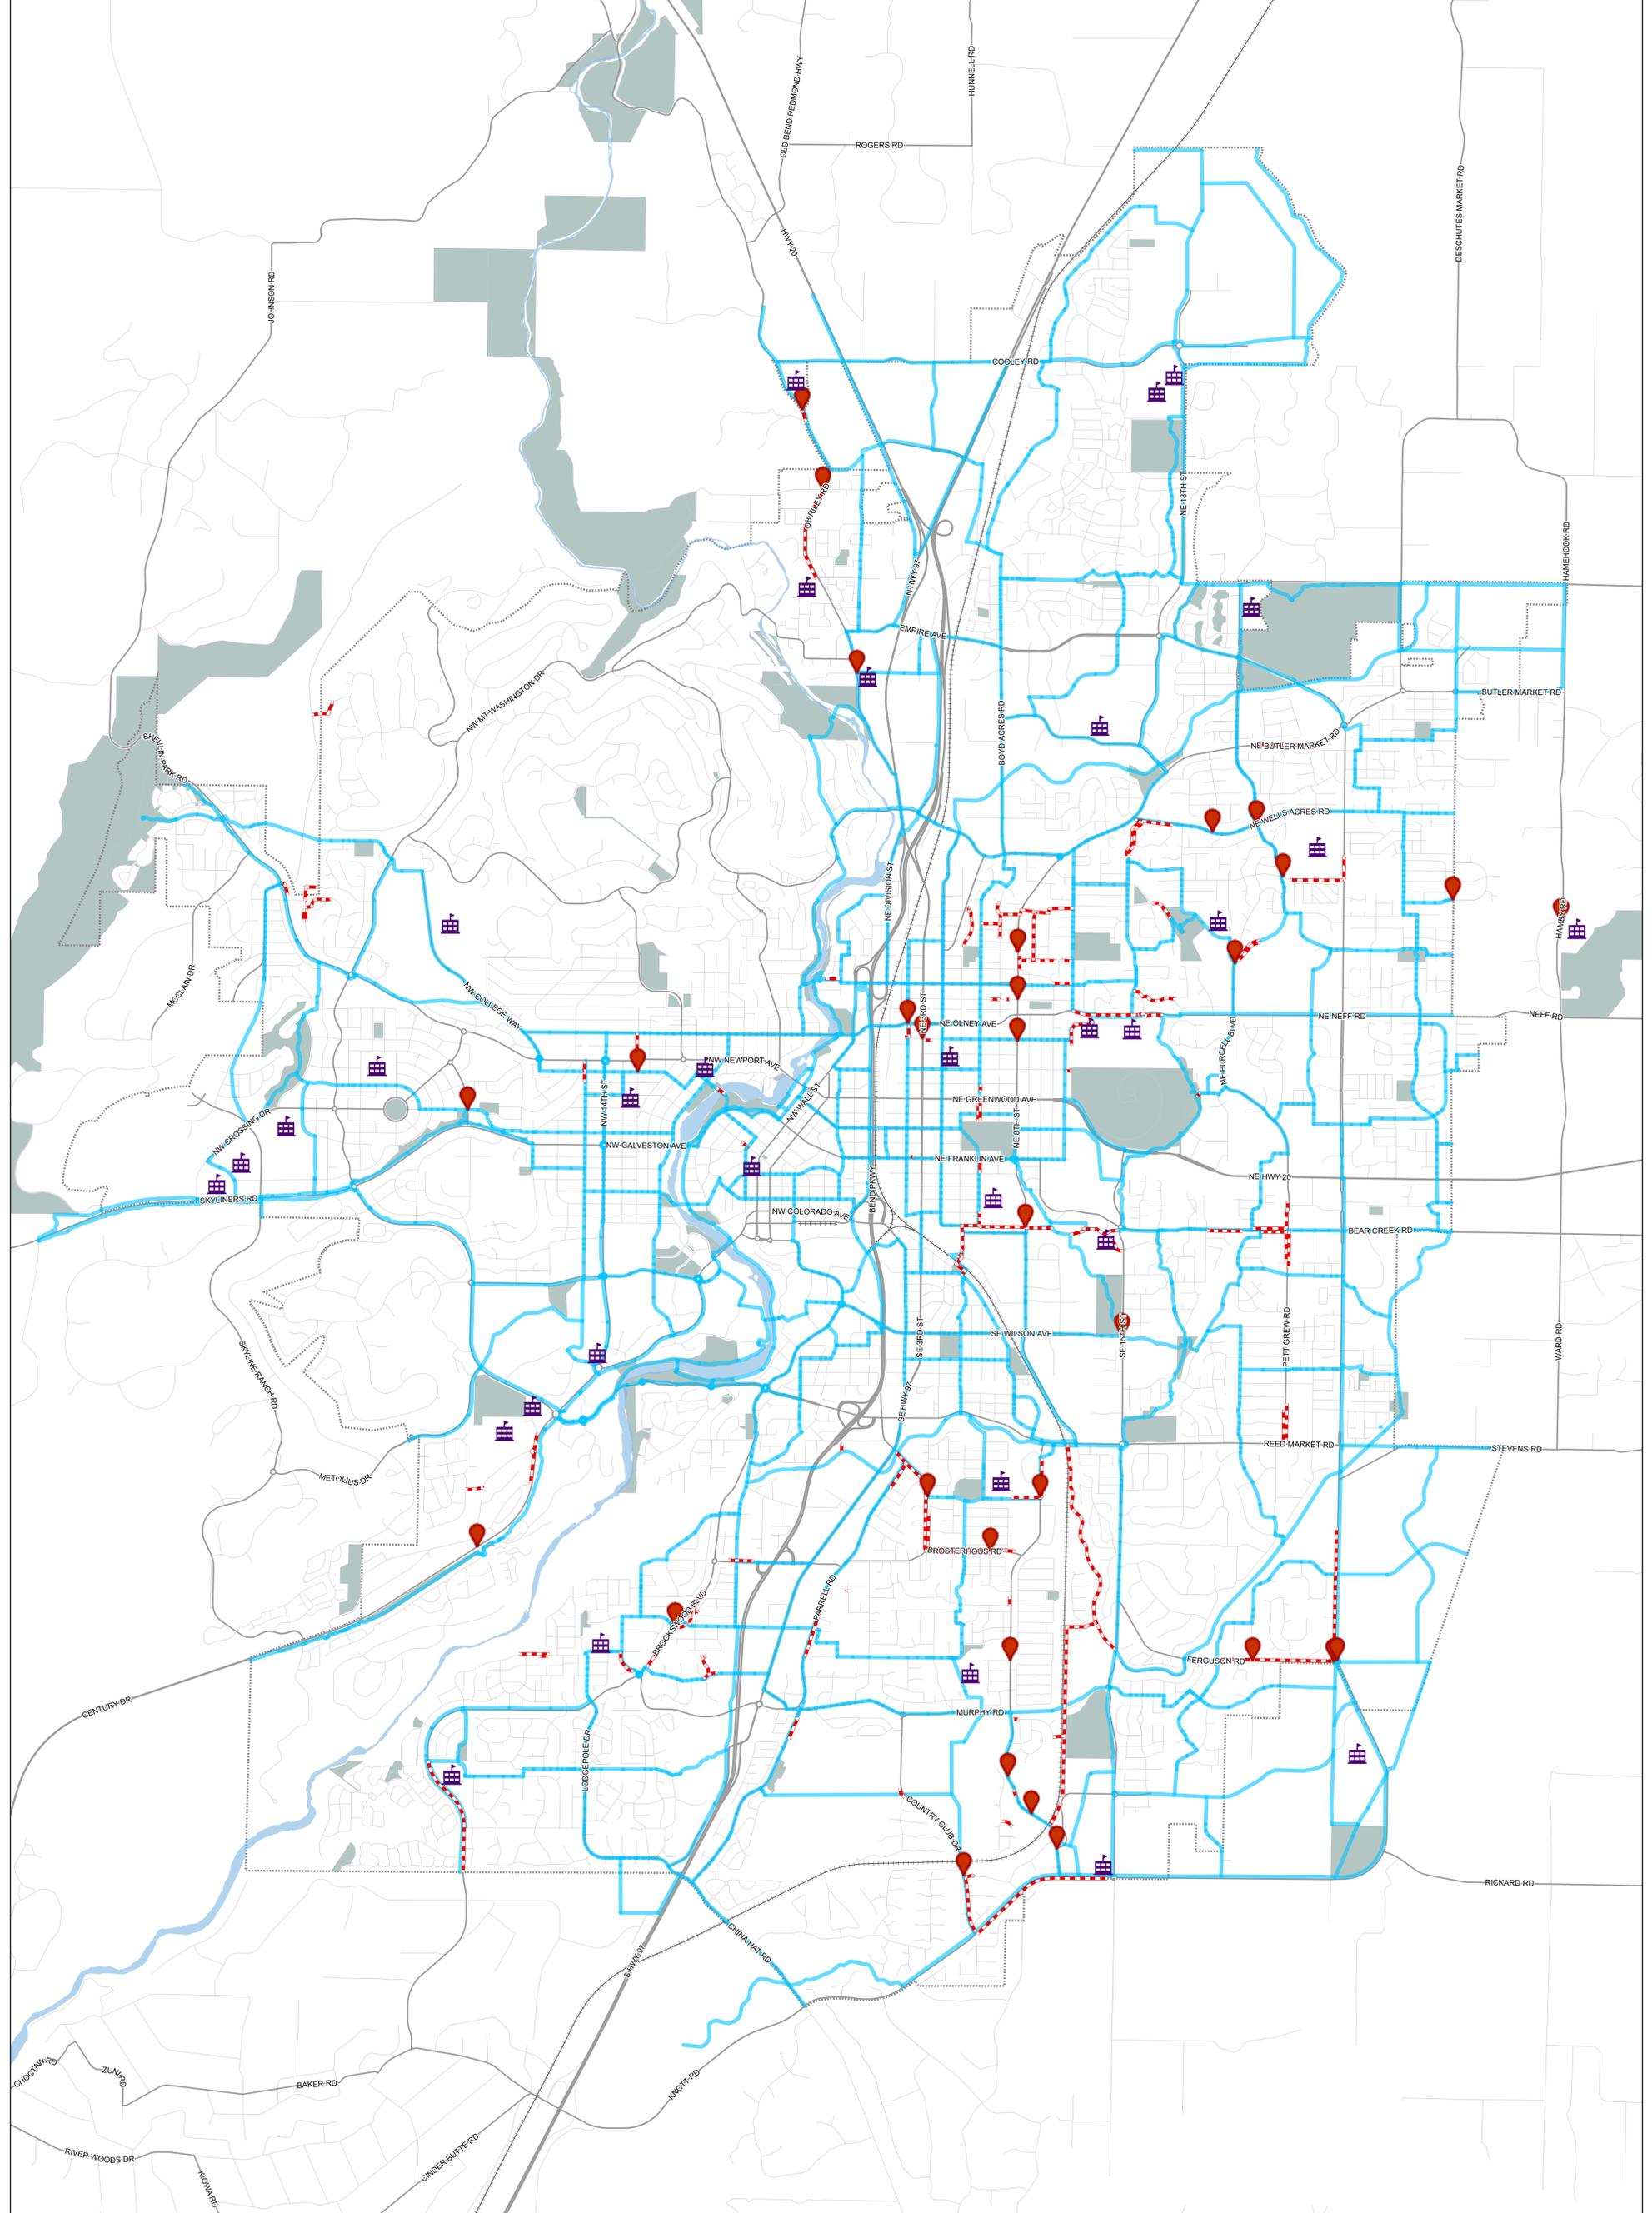

**CITY OF BEND DESIGN STANDARDS PART VI
APPENDIX C, CONNECTOR ROUTES AND CROSSINGS MAP VERSION 1**

-  Crosswalk Enhancement Needs
-  Schools
-  Low Stress Network
-  Infill Needs
-  Parks

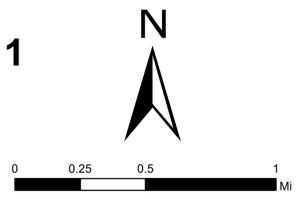

CITY OF BEND

Map prepared by S. Layne, City of Bend
Print Date: Jan 31, 2022
Sources: City of Bend, Deschutes County

This map is for reference purposes only. Care was taken in the creation of this map, but it is provided "AS IS." Please contact the City of Bend to verify map information or to report any errors.